


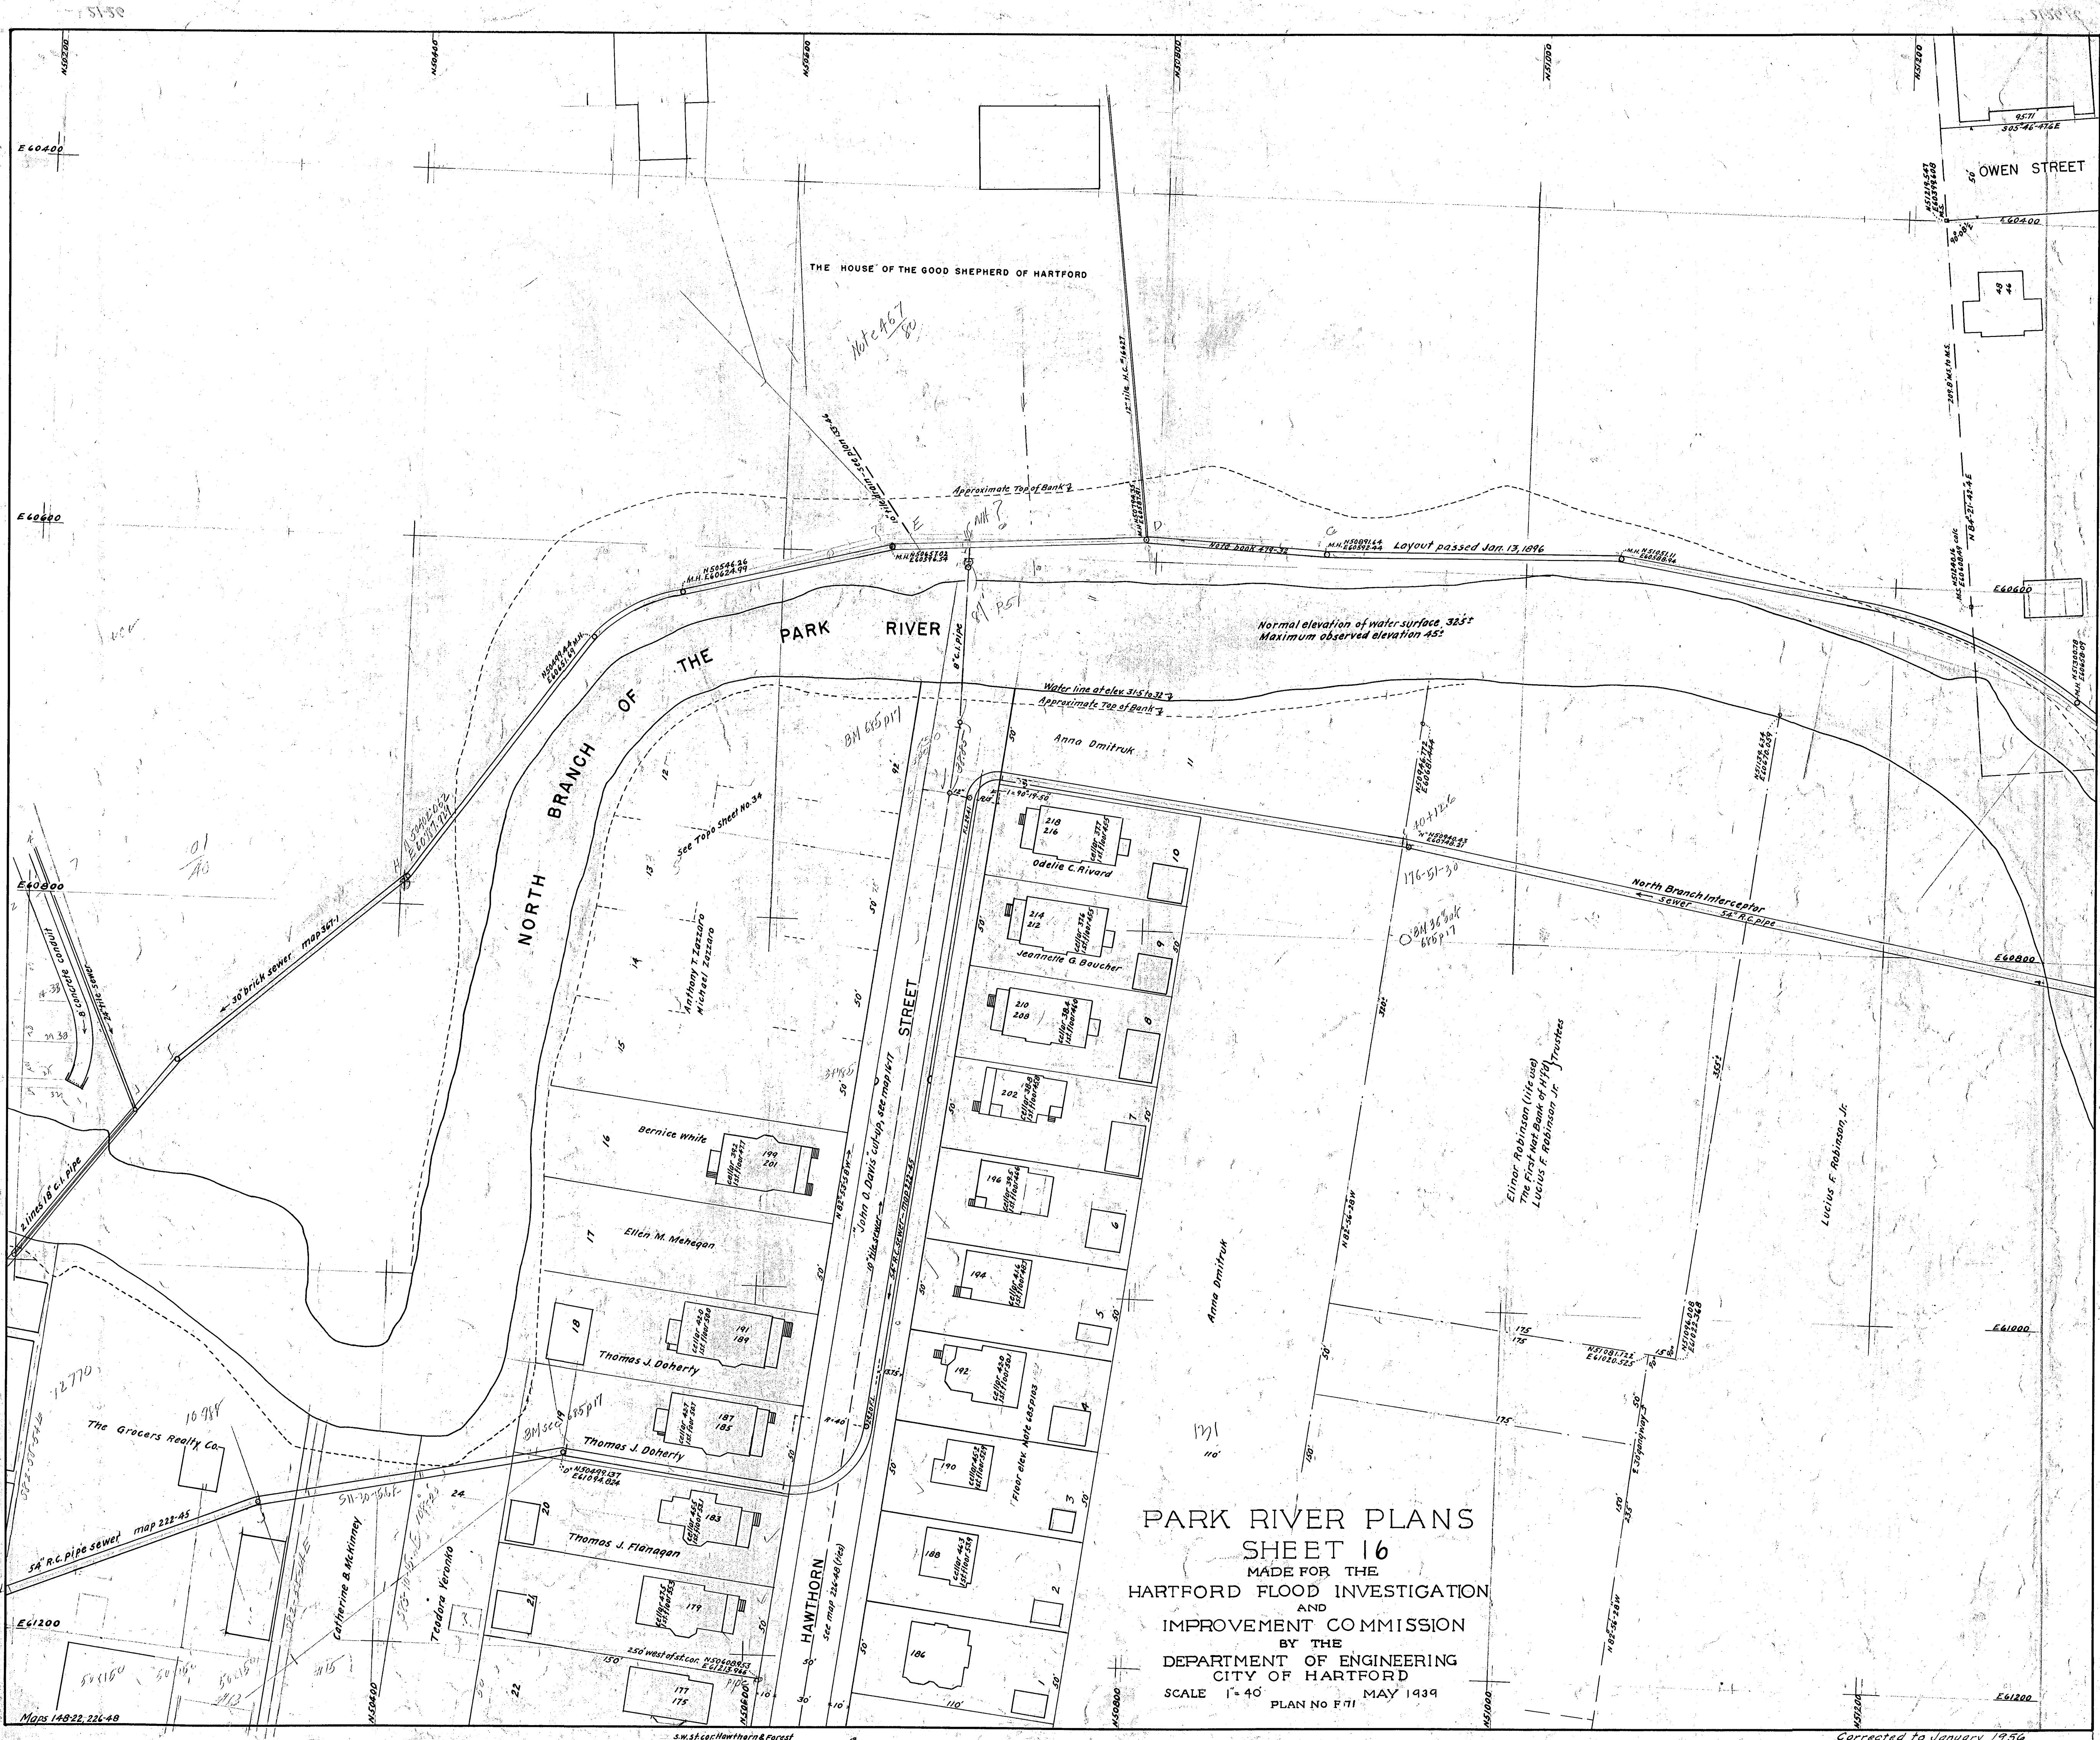

PARK RIVER PLANS
SHEET 16
MADE FOR THE
HARTFORD FLOOD INVESTIGATION
AND
IMPROVEMENT COMMISSION
BY THE
DEPARTMENT OF ENGINEERING
CITY OF HARTFORD
SCALE 1" = 40' MAY 1939
PLAN No. P-71

Corrected to January, 1956