


See Sheet 27 616

See Sheet 26 615

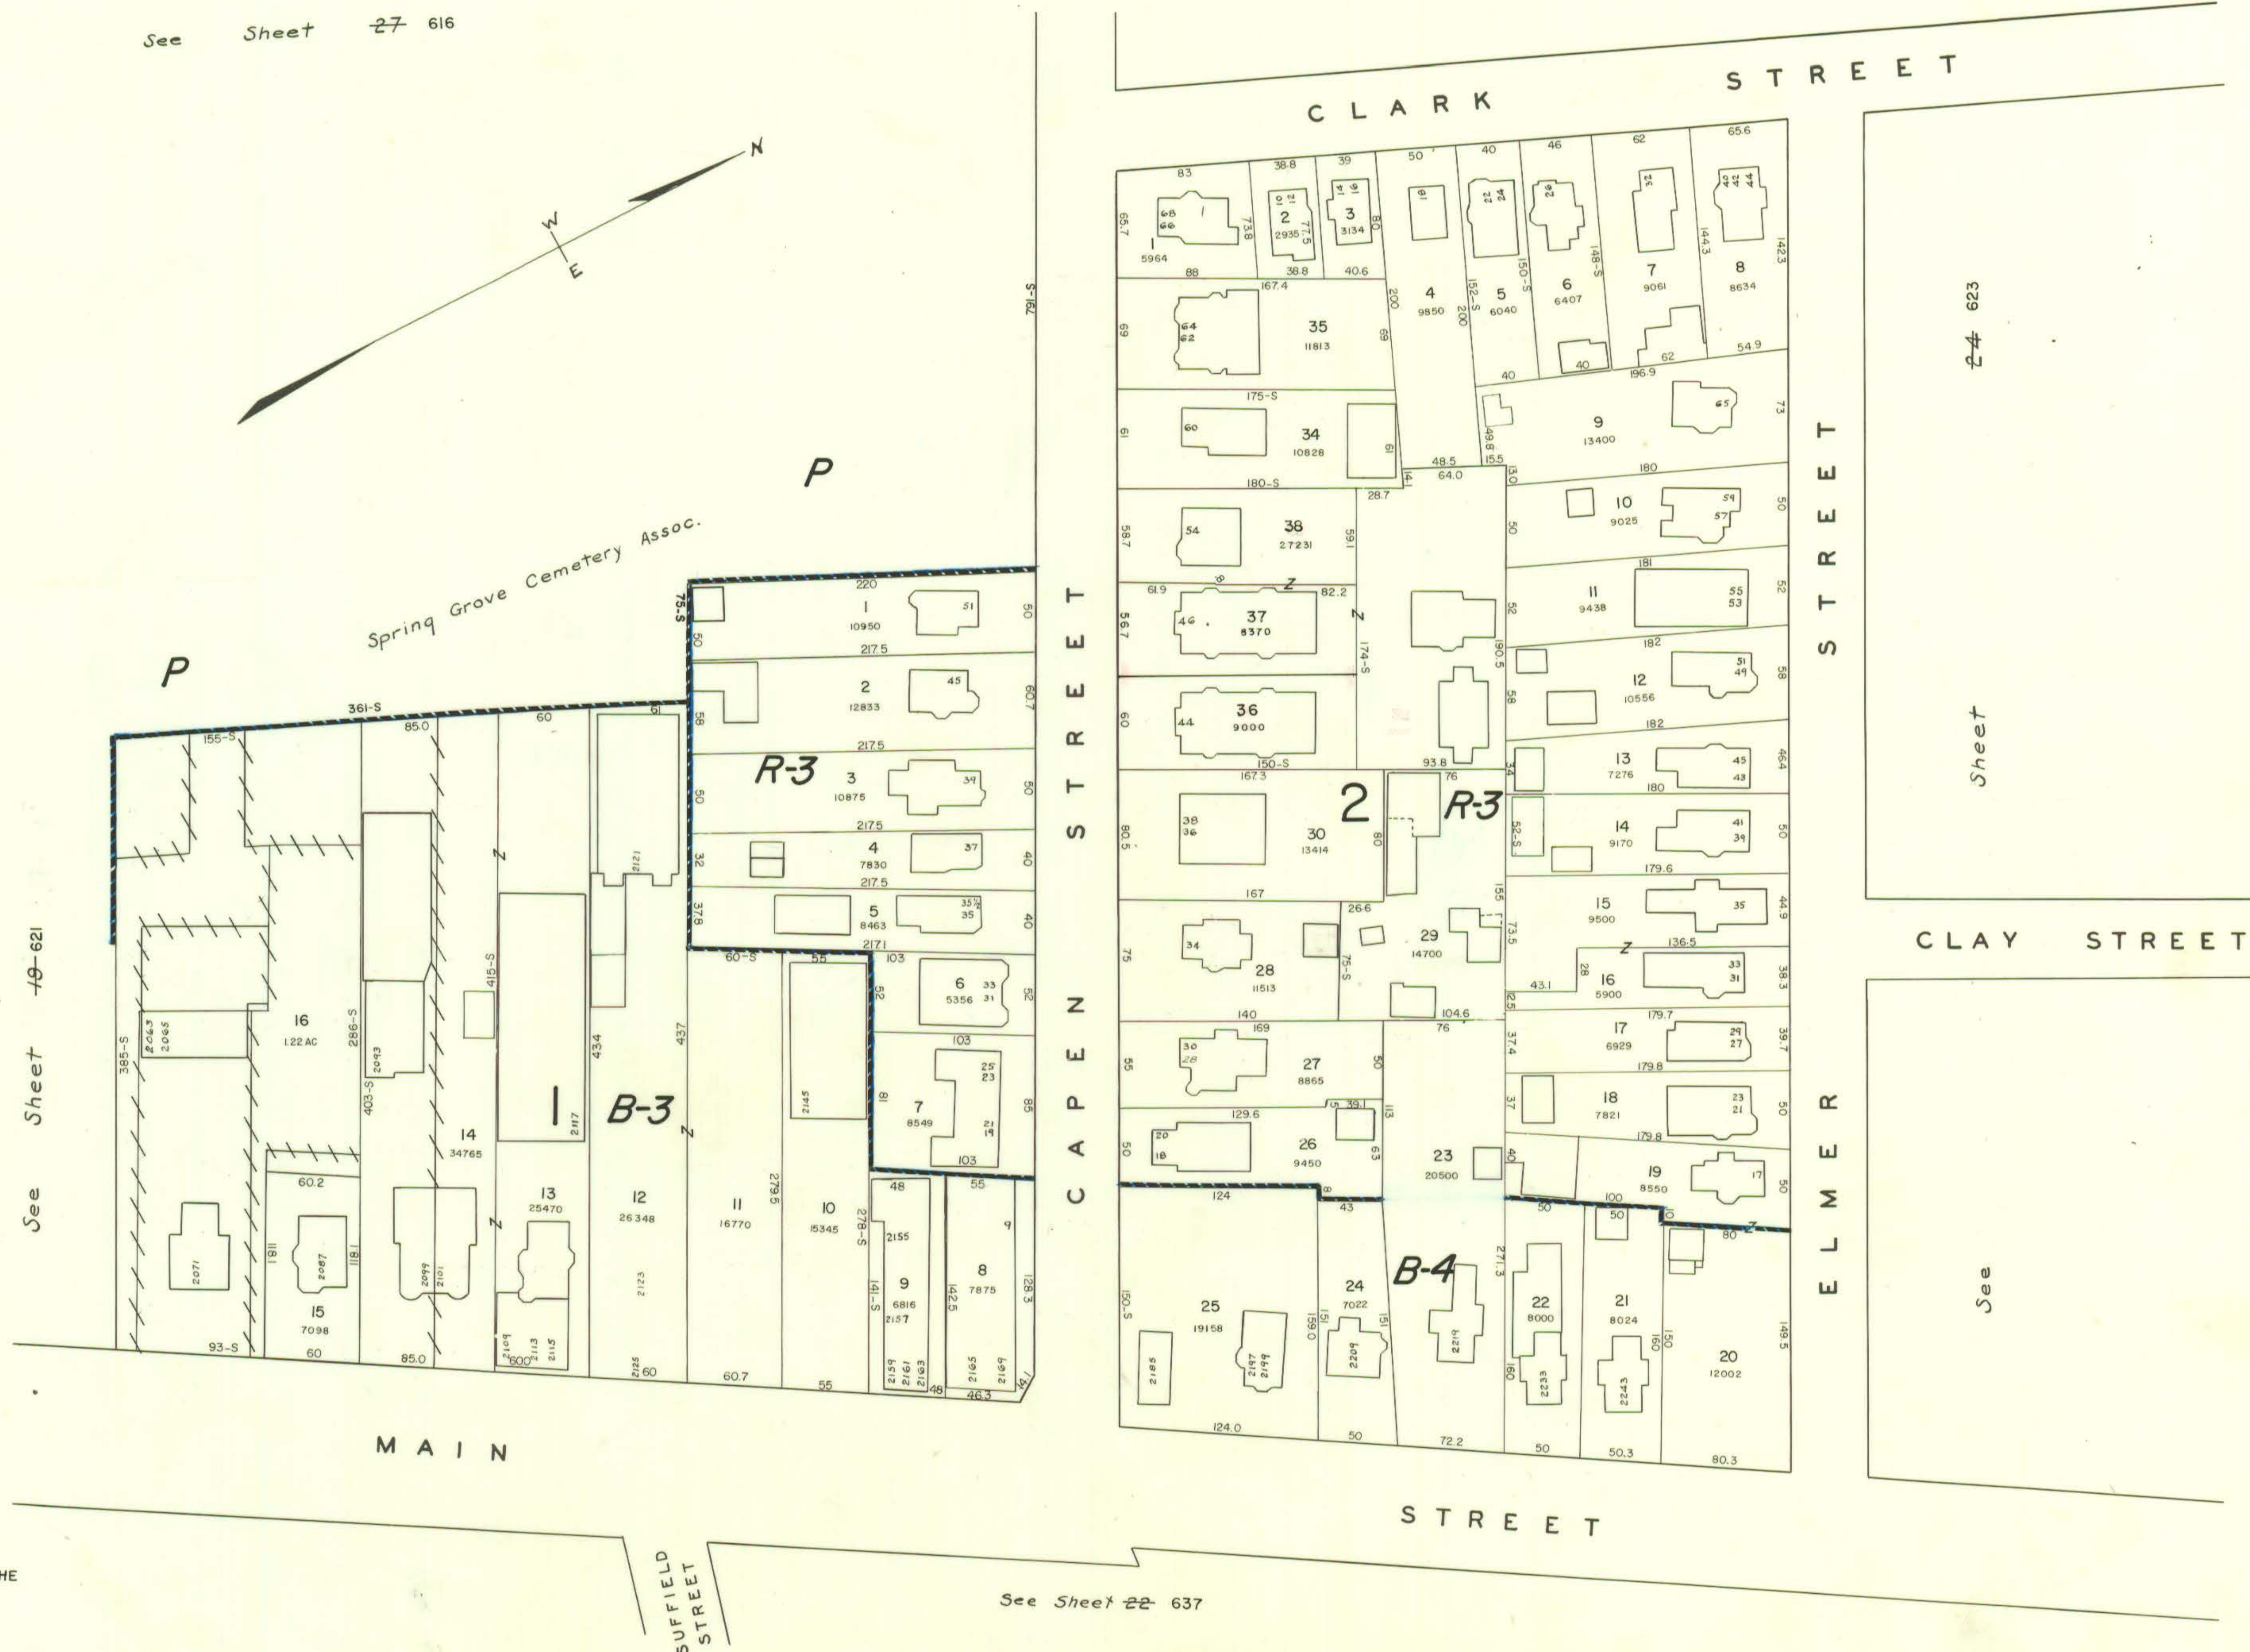

PREPARED UNDER THE DIRECTION OF THE
DEPARTMENT OF ASSESSMENT

CITY OF HARTFORD

BY

AVIS AIRMAP, INC.
BROOKLINE MASS

SCALE 1" = 50'
1971

Property lines and building outlines by the City of Hartford Engineering Department
Block, lot and zone numbers by Avis Airmap
Area calculations by Avis Airmap

CITY OF HARTFORD
Department of Engineering