


Property
of
LOUIS AND JOSEPH FEINBERG
MAIN AND TRUMBULL STS.
HARTFORD, CONN.

SCALE 1 inch = 4 feet JUNE 1921
Spencer and Washburn, Inc., Engrs.
Norman C. Spencer, Pres.

MAIN ST.

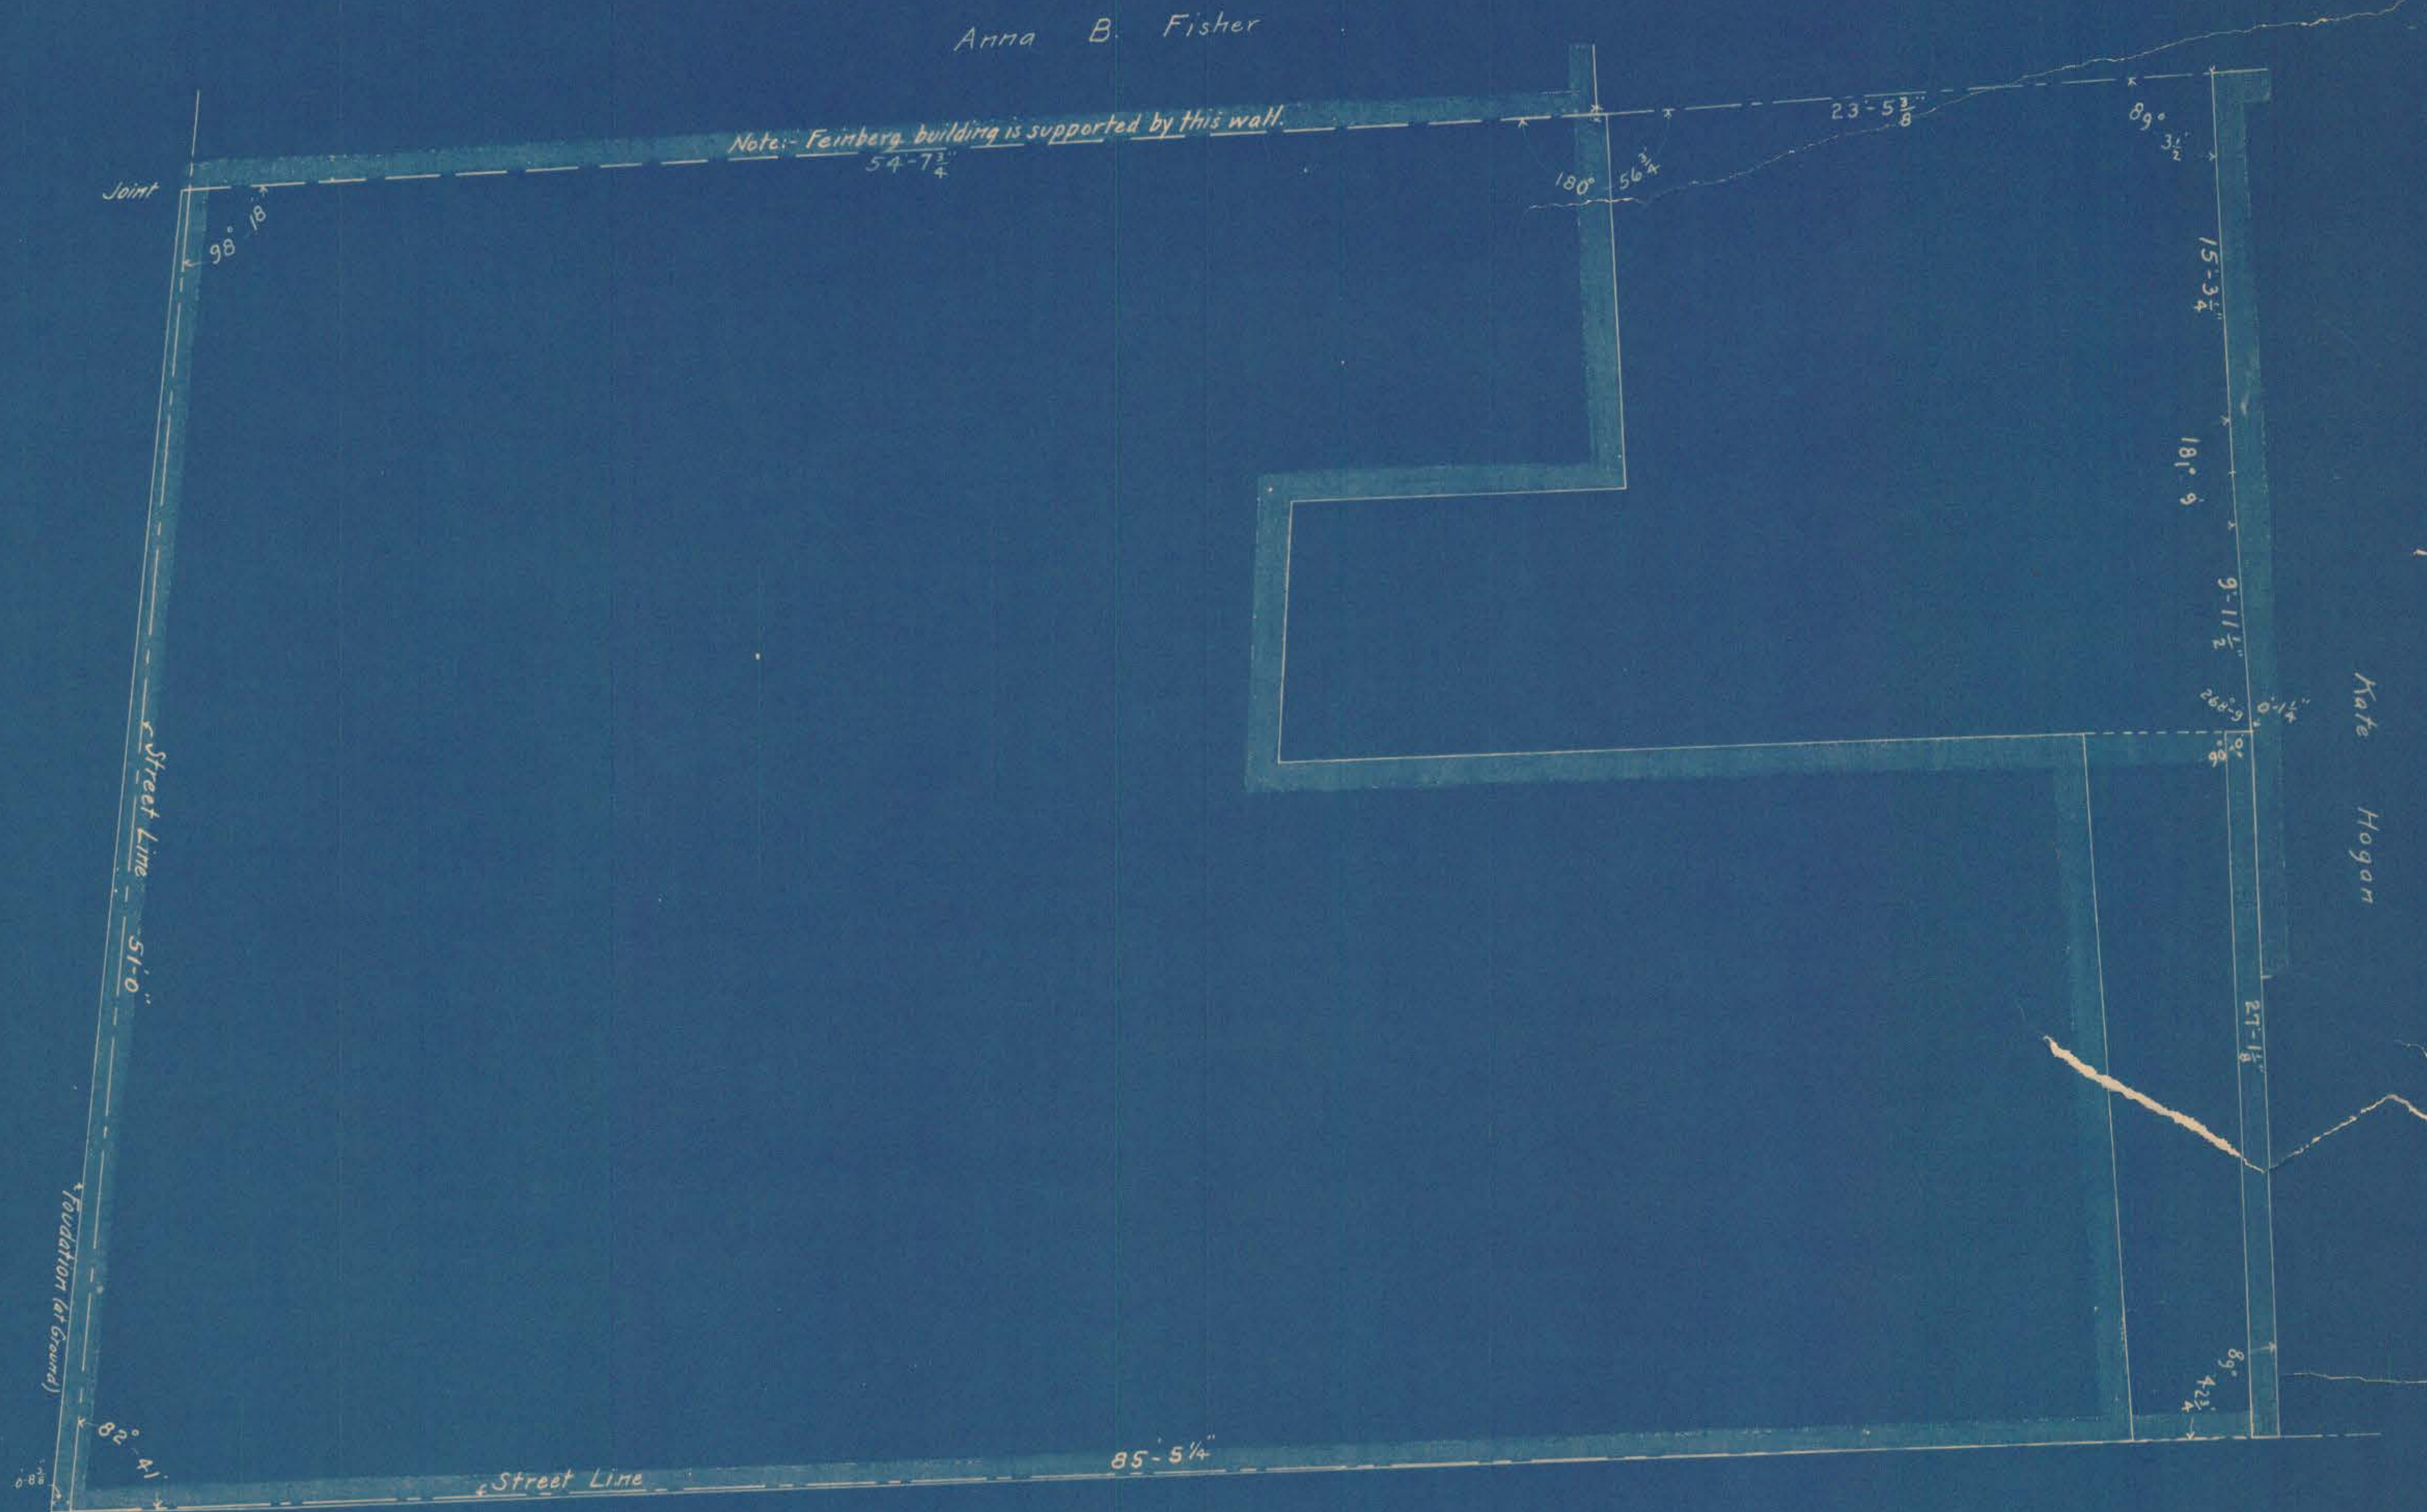

Mate Hogan

CURB
TRUMBULL ST.