

INDEX TO DRAWINGS

SHEET NO.	TITLE	FILE NO.
1	PROJECT LOCATION AND INDEX	CT-4-3218
2	HYDROGRAPH NO. 1	CT-4-1228
3	HYDROGRAPH NO. 2	CT-3-1229
4	SUBSURFACE EXPLORATIONS	CT-2-1390
5	PLOT PLAN	CT-4-3219
6	INTAKE PUMP ROOM AND OUTLET - PLAN	CT-4-3220
7	INTAKE STRUCTURE - PROFILE AND SECTIONS	CT-4-3221
8	ENGINE ROOM FLOOR PLAN - ARCHITECTURAL	CT-4-3222
9	ROOF PLAN AND DETAILS - ARCHITECTURAL	CT-4-3223
10	SOUTH ELEVATION AND CAST STONE DETAILS - ARCHITECTURAL	CT-4-3224
11	SOUTH ELEVATION DETAILS - ARCHITECTURAL	CT-4-3225
12	EAST AND WEST ELEVATIONS AND DETAILS - ARCHITECTURAL	CT-4-3226
13	NORTH ELEVATION AND DETAILS - ARCHITECTURAL	CT-4-3227
14	LONGITUDINAL SECTION - ARCHITECTURAL	CT-4-3228
15	TRANSVERSE SECTIONS - ARCHITECTURAL	CT-4-3229
16	MAIN ENTRANCE AND DETAILS - ARCHITECTURAL	CT-4-3230
17	STRUCTURAL STEEL FRAMING	CT-4-3231
18	STRUCTURAL STEEL DETAILS NO. 1	CT-4-3232
19	STRUCTURAL STEEL DETAILS NO. 2	CT-4-3233
20	ROOF SLAB STEEL REINFORCEMENT NO. 1	CT-4-3234
21	ROOF SLAB STEEL REINFORCEMENT NO. 2	CT-4-3235
22	ENGINE ROOM FLOOR SLAB STEEL REINFORCEMENT NO. 1	CT-4-3236
23	ENGINE ROOM FLOOR SLAB STEEL REINFORCEMENT NO. 2	CT-4-3237
24	ENGINE ROOM FLOOR SLAB STEEL REINFORCEMENT NO. 3	CT-4-3238
25	SLAB DETAILS OF SCREENING ROOM, BOILER ROOM AND CONDUIT ROOFS	CT-4-3239
26	BASE SLAB STEEL REINFORCEMENT NO. 1	CT-4-3240
27	BASE SLAB STEEL REINFORCEMENT NO. 2	CT-4-3241
28	NORTH WALL	CT-4-3242
29	WEST WALL	CT-4-3243
30	SOUTH WALL - SECTIONS E AND F	CT-4-3244
31	SOUTH WALL - SECTIONS G AND H	CT-4-3245
32	VERTICAL SECTIONS	CT-4-3246
33	HORIZONTAL SECTIONS	CT-4-3247
34	DIVIDING WALL AT PUMP ROOM AND SUCTION CONDUIT WALL DETAILS	CT-4-3248
35	SCREENING ROOM, INTERIOR WALL DETAILS	CT-4-3249
36	CONCRETE STAIRWAY DETAILS	CT-4-3250
37	INTAKE CONDUIT AND TANK BASE DETAILS	CT-4-3251
38	MISCELLANEOUS STEEL DETAILS NO. 1	CT-4-3252
39	MISCELLANEOUS STEEL DETAILS NO. 2	CT-4-3253
40	MISCELLANEOUS STEEL DETAILS NO. 3	CT-4-3254
41	MISCELLANEOUS STEEL DETAILS NO. 4	CT-4-3255
42	GENERAL ARRANGEMENT OF EQUIPMENT NO. 1	CT-4-3256
43	GENERAL ARRANGEMENT OF EQUIPMENT NO. 2	CT-4-3257
44	GENERAL ARRANGEMENT OF EQUIPMENT NO. 3	CT-4-3258
45	GENERAL ARRANGEMENT OF EQUIPMENT NO. 4	CT-4-3259
46	PIPING LAYOUT - GASOLINE, DIESEL AND FUEL OIL LINES	CT-4-3260
47	GENERAL INSTALLATION DETAILS	CT-4-3300
48	GASOLINE, DIESEL, FUEL OIL AND VENTILATING PIPING DETAILS	CT-4-3261
49	PIPING LAYOUT, PLUMBING AND VALVE CONTROL LINES	CT-4-3262
50	DETAILS OF AUXILIARY HYDRAULIC VALVE CONTROL AND ENGINE COOLING WATER SYSTEMS	CT-4-3263
51	PIPING LAYOUT - FIRE EXTINGUISHING SYSTEM	CT-4-3264
52	HEATING	CT-4-3265
53	ELECTRIC LIGHT AND POWER SYSTEM NO. 1	CT-4-3266
54	ELECTRIC LIGHT AND POWER SYSTEM NO. 2	CT-4-3267
55	ELECTRIC LIGHT AND POWER SYSTEM NO. 3	CT-4-3268
56	ELECTRIC LIGHT AND POWER SYSTEM NO. 4	CT-4-3269
57	PUMP PEDESTALS	CT-4-3950
58	ENGINE PADS - NO. 1	CT-4-3951
59	ENGINE PADS - NO. 2	CT-4-3952
60	ENGINE PADS - NO. 3	CT-4-3953


LEGEND

LIMITS OF DRAINAGE FOR KEENEY LANE PUMPING STATION

CONNECTICUT RIVER FLOOD CONTROL
KEENEY LANE PUMPING STATION
HARTFORD, CONN.


PROJECT LOCATION AND INDEX

CONNECTICUT RIVER	CONNECTICUT
IN 60 SHEETS	SHEET NO. 1
SCALE 1 IN. = 500 FT.	
U.S. ENGINEER OFFICE, P. PROVIDENCE, R.I., JUNE 1944	
APPROVED: <i>[Signature]</i> CHIEF ENGINEER	APPROVED: <i>[Signature]</i> DISTRICT ENGINEER
PROJECT ENGINEER: <i>[Signature]</i>	DRAWN: M. B. MO. TRACED: H. P. F.
PROJECT UNIT NO. 3	CHECKED: <i>[Signature]</i>

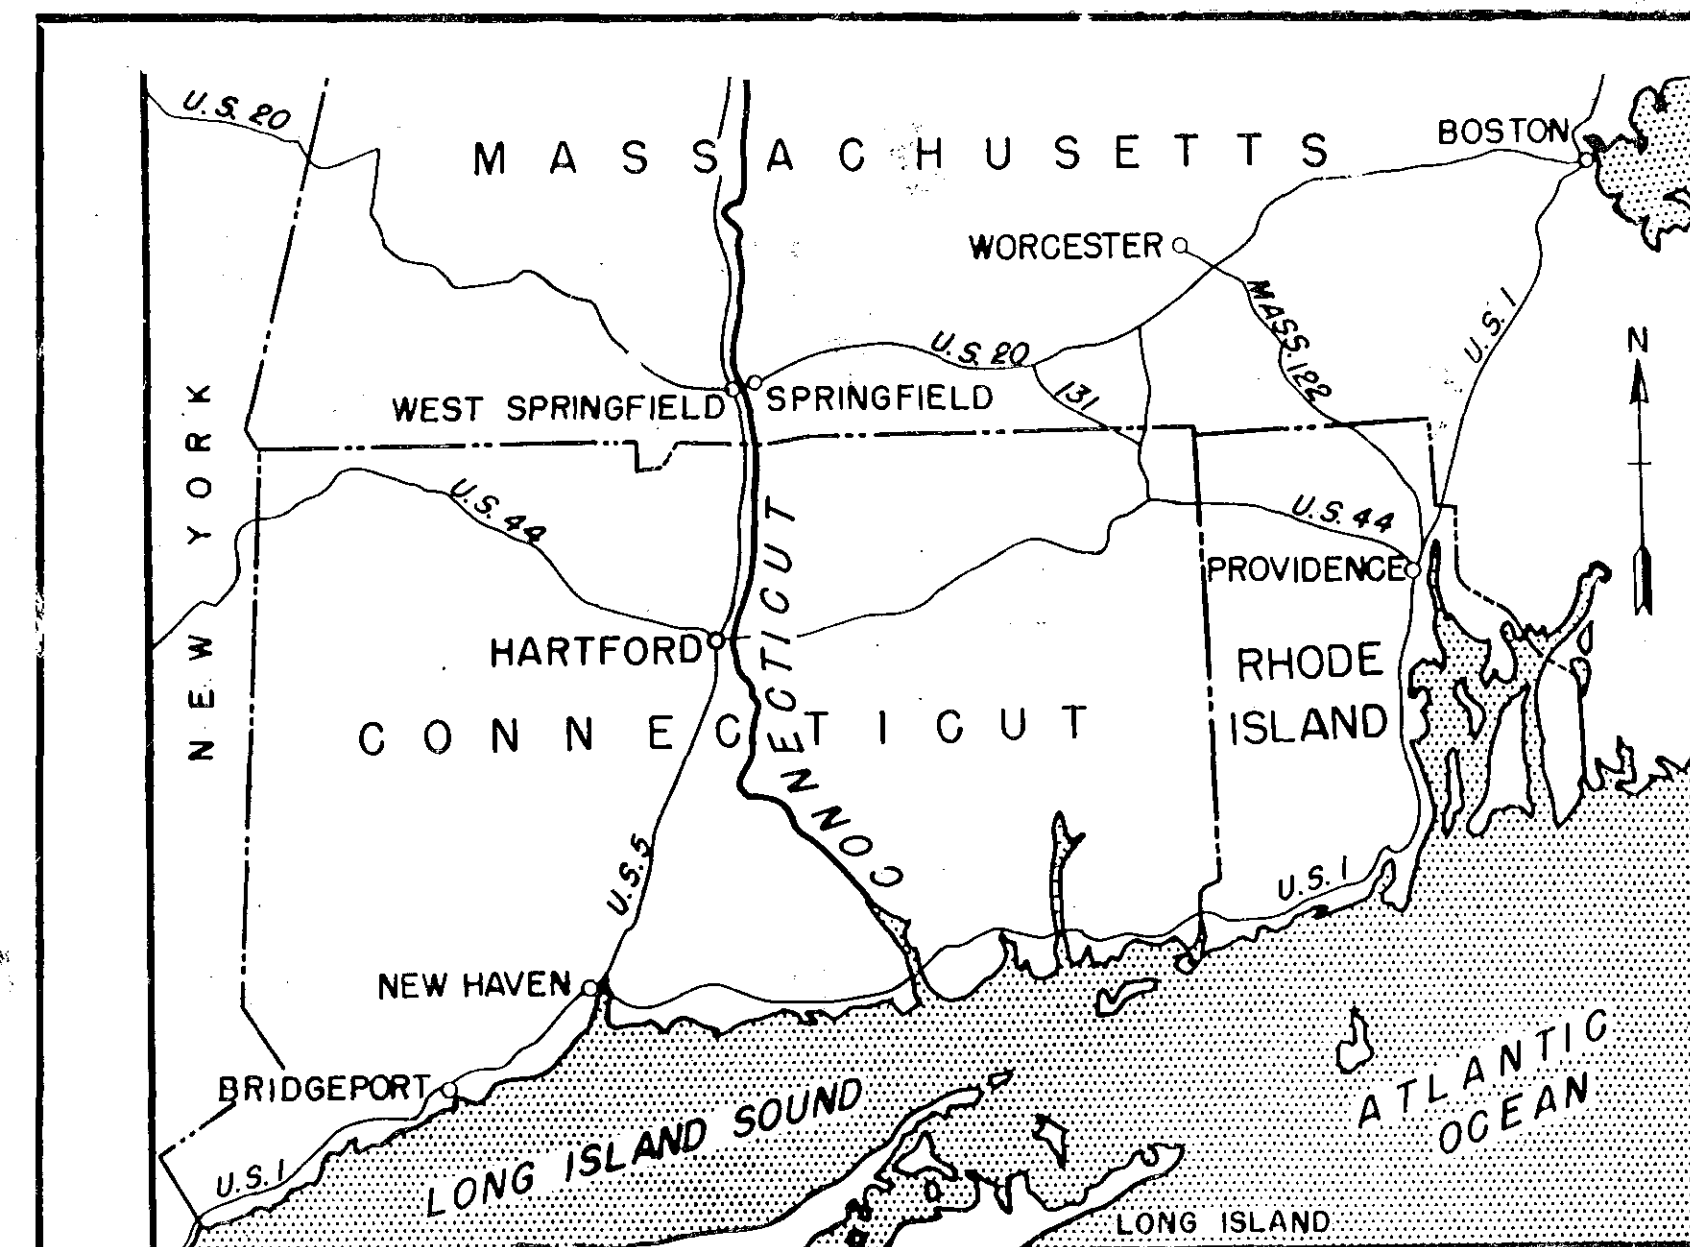

LOCATION MAP

SCALE OF MILES
0 10 20 30

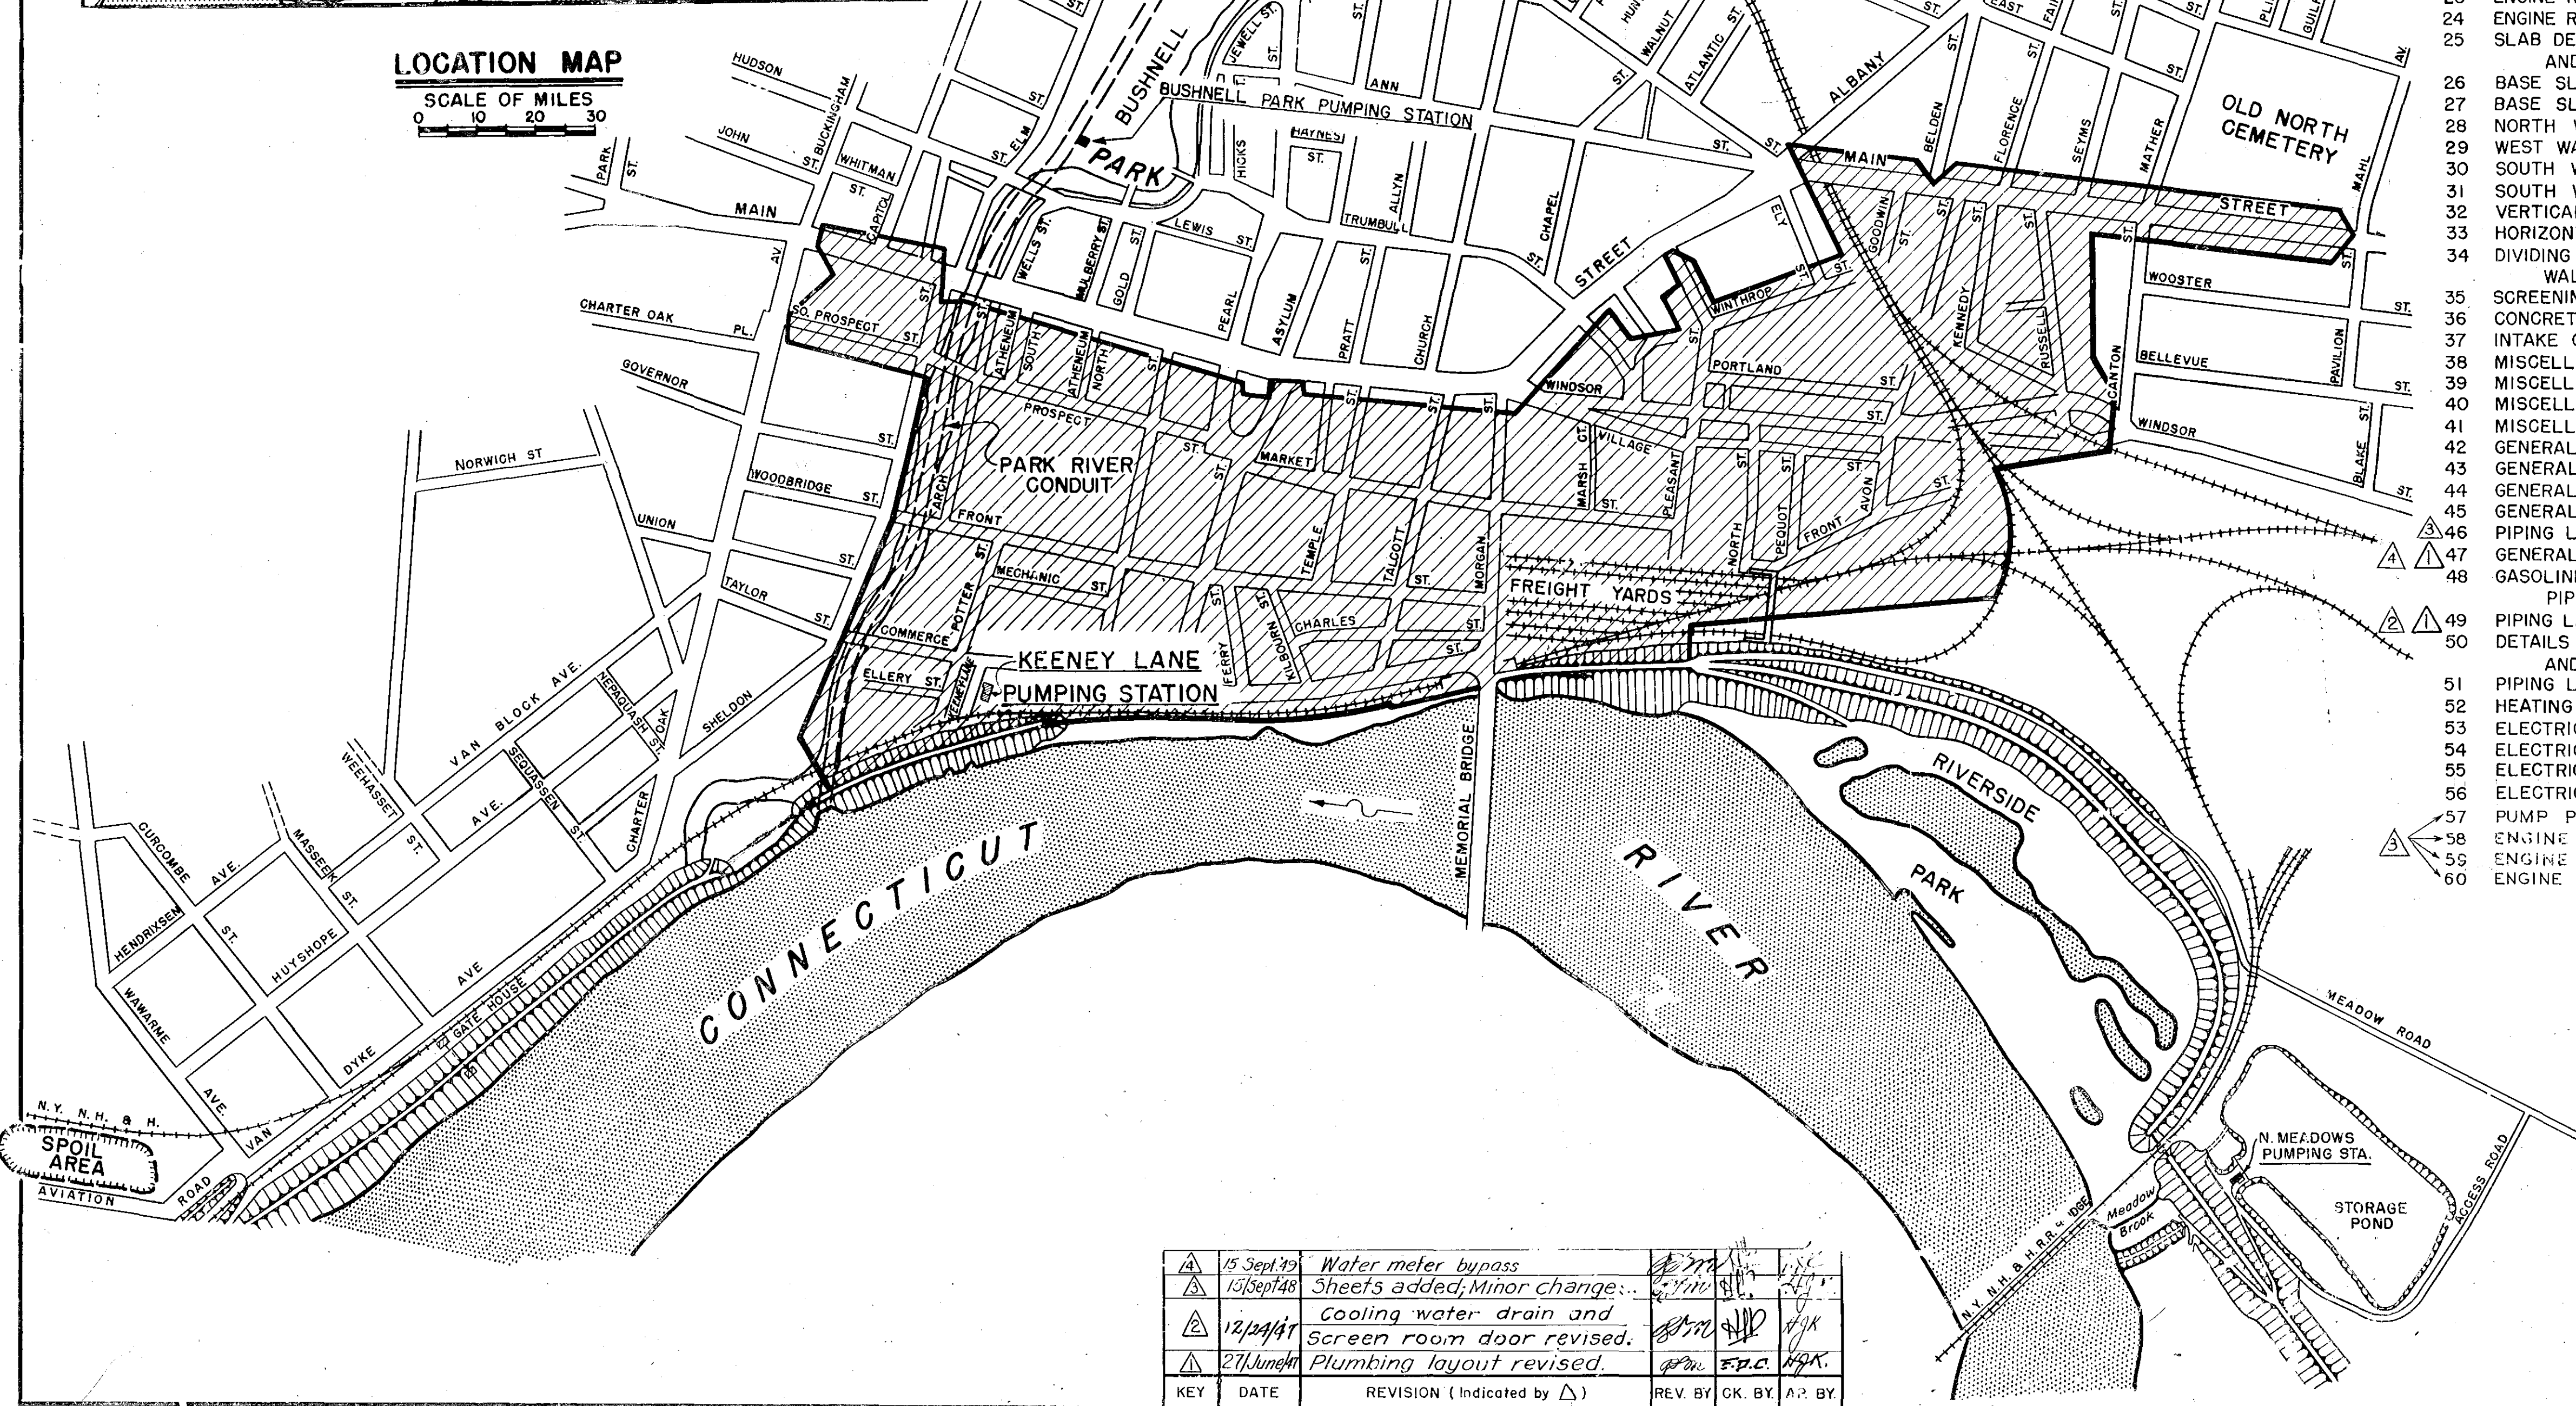

KEY	DATE	REVISION (Indicated by Δ)	REV. BY	CK. BY	AP. BY
Δ	15 Sept 42	Water meter bypass			
Δ	13 Sept 48	Sheets added; Minor change			
Δ	12/24/47	Cooling water drain and Screen room door revised			
Δ	27 June 48	Plumbing layout revised			