


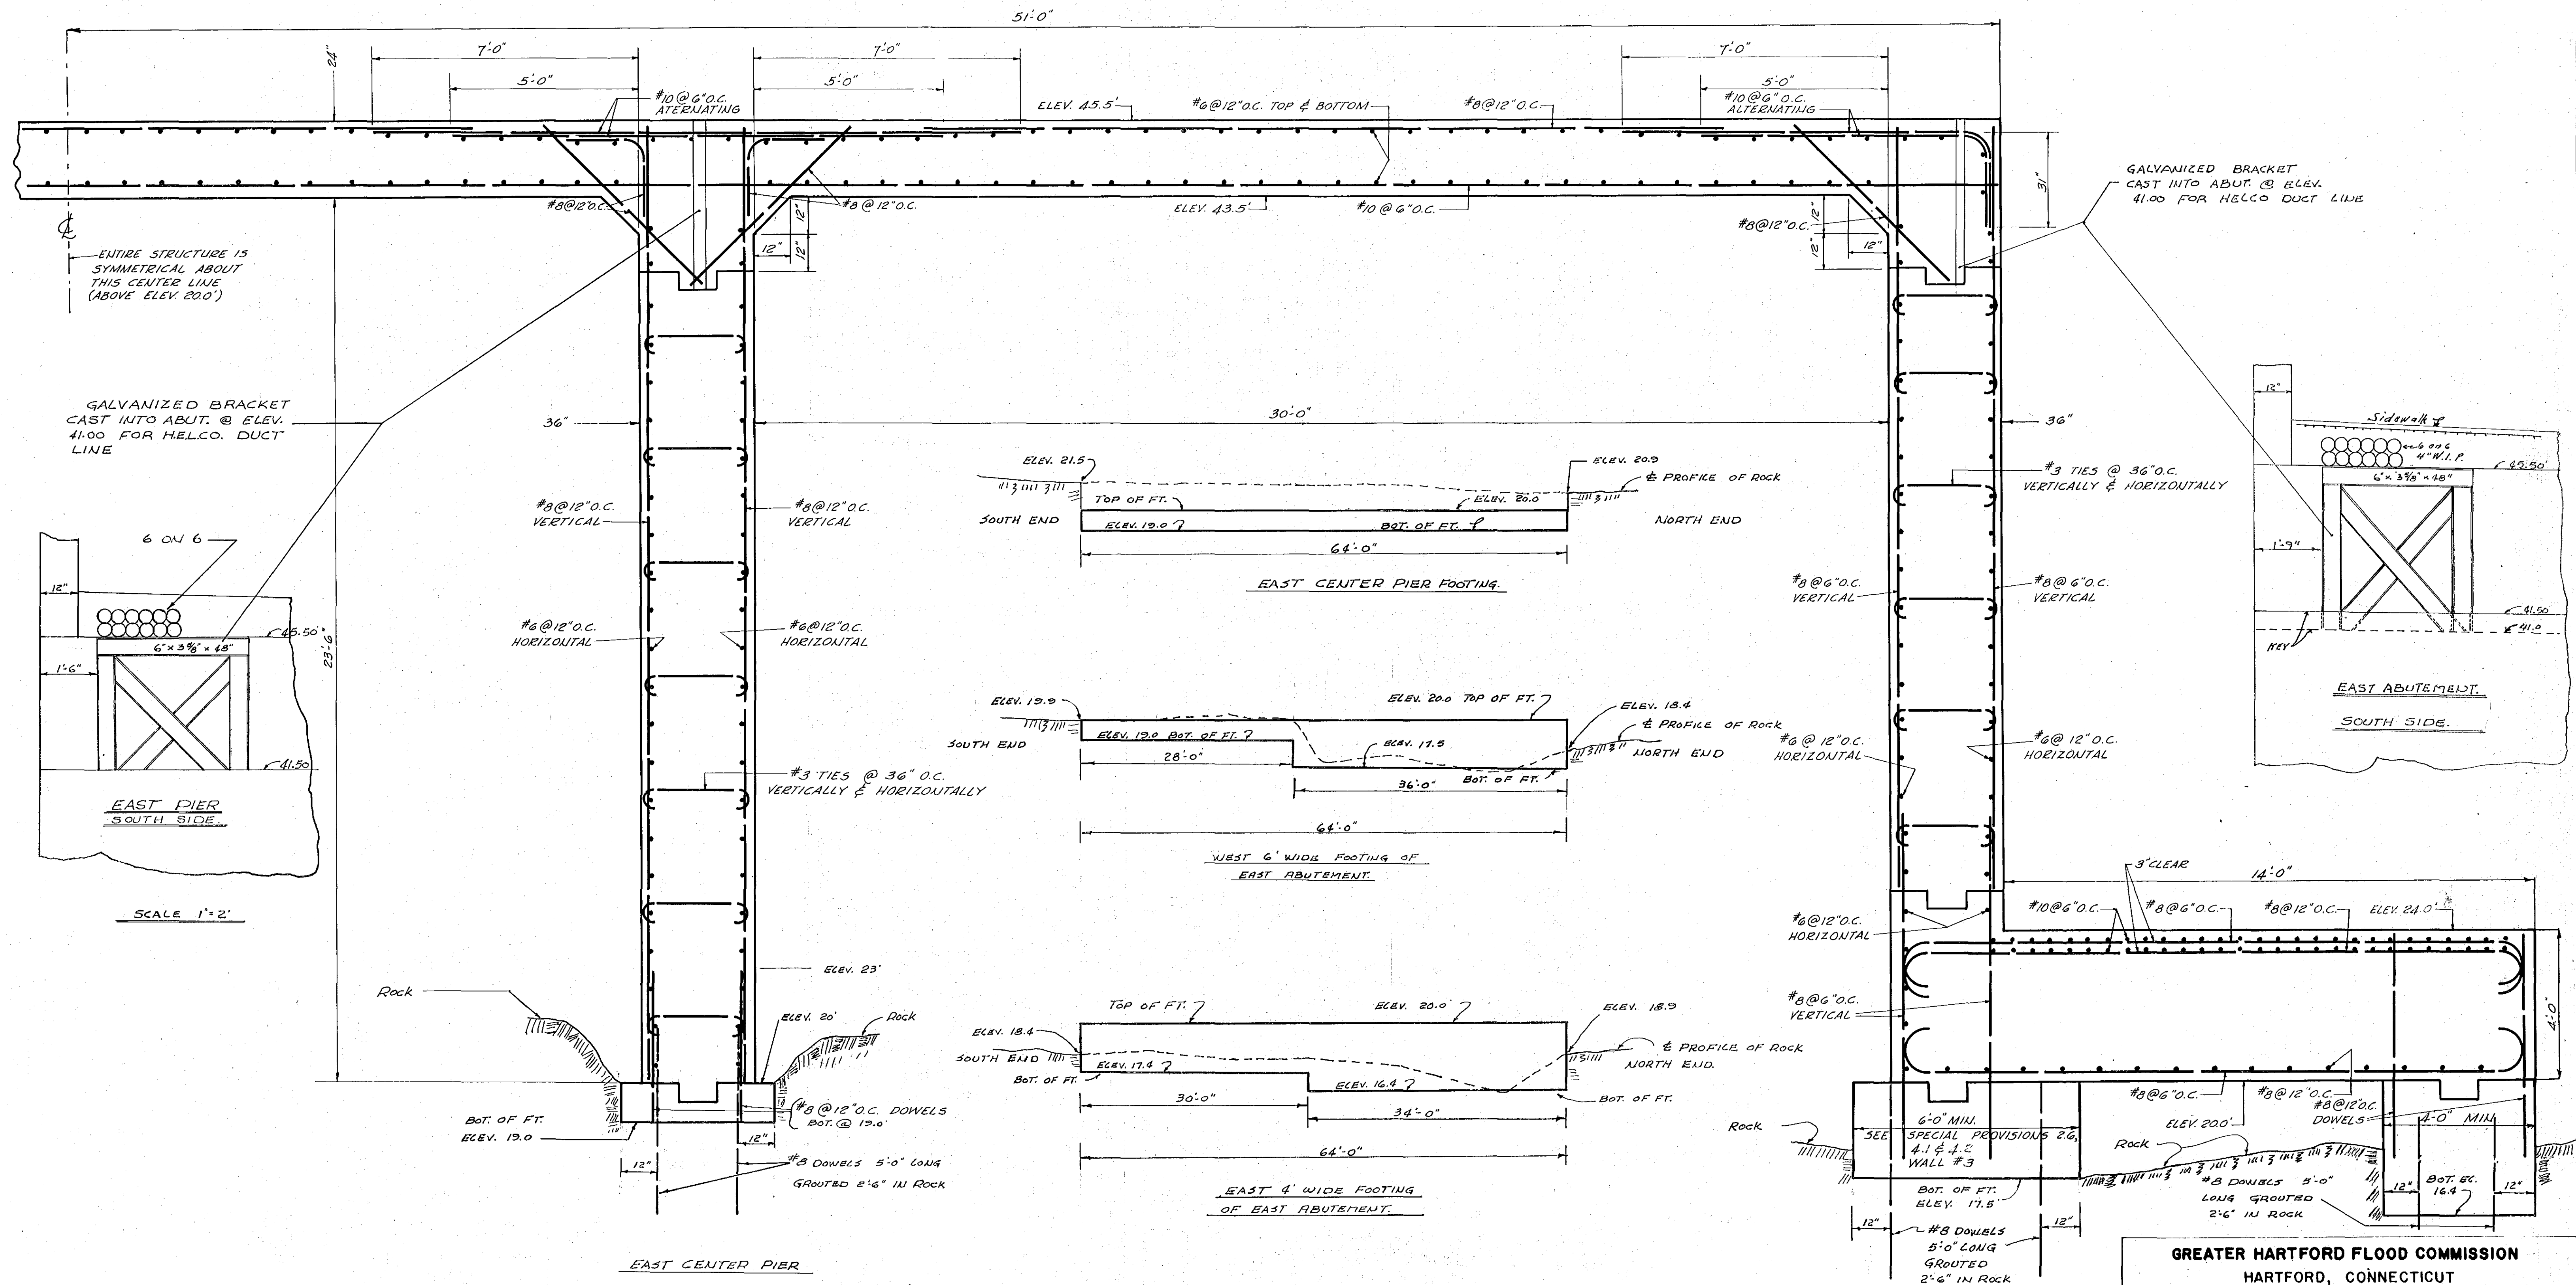

SCALE: HOR. 1" = 10'-0"
VERT 1" = 4'-0"

SECTION A-A

SEE SHEET 12 FOR NOTES

A3 BUILT PLAN NOV. 1959

GREATER HARTFORD FLOOD COMMISSION
HARTFORD, CONNECTICUT

DESIGNED BY
R.E.C. C.C.K.

TRACED BY
C.C.K. A.J.M.

CHECKED BY
R.E.C.

SCALE
1" = 2'-0"

DATE
MAY 1959

RECOMMENDED BY
PE CONN. NO. 554

APPROVED BY
PE CONN. NO. 290

HAMILTON ST. BRIDGE

SECTION A-A (EAST).
SHOWING DETAIL OF
REINFORCING STEEL

SERIAL NO. 000628

CHIEF ENGINEER
Charles C. Cooke

DIRECTOR

DRAWING NUMBER

11

SHEET 11 OF 16