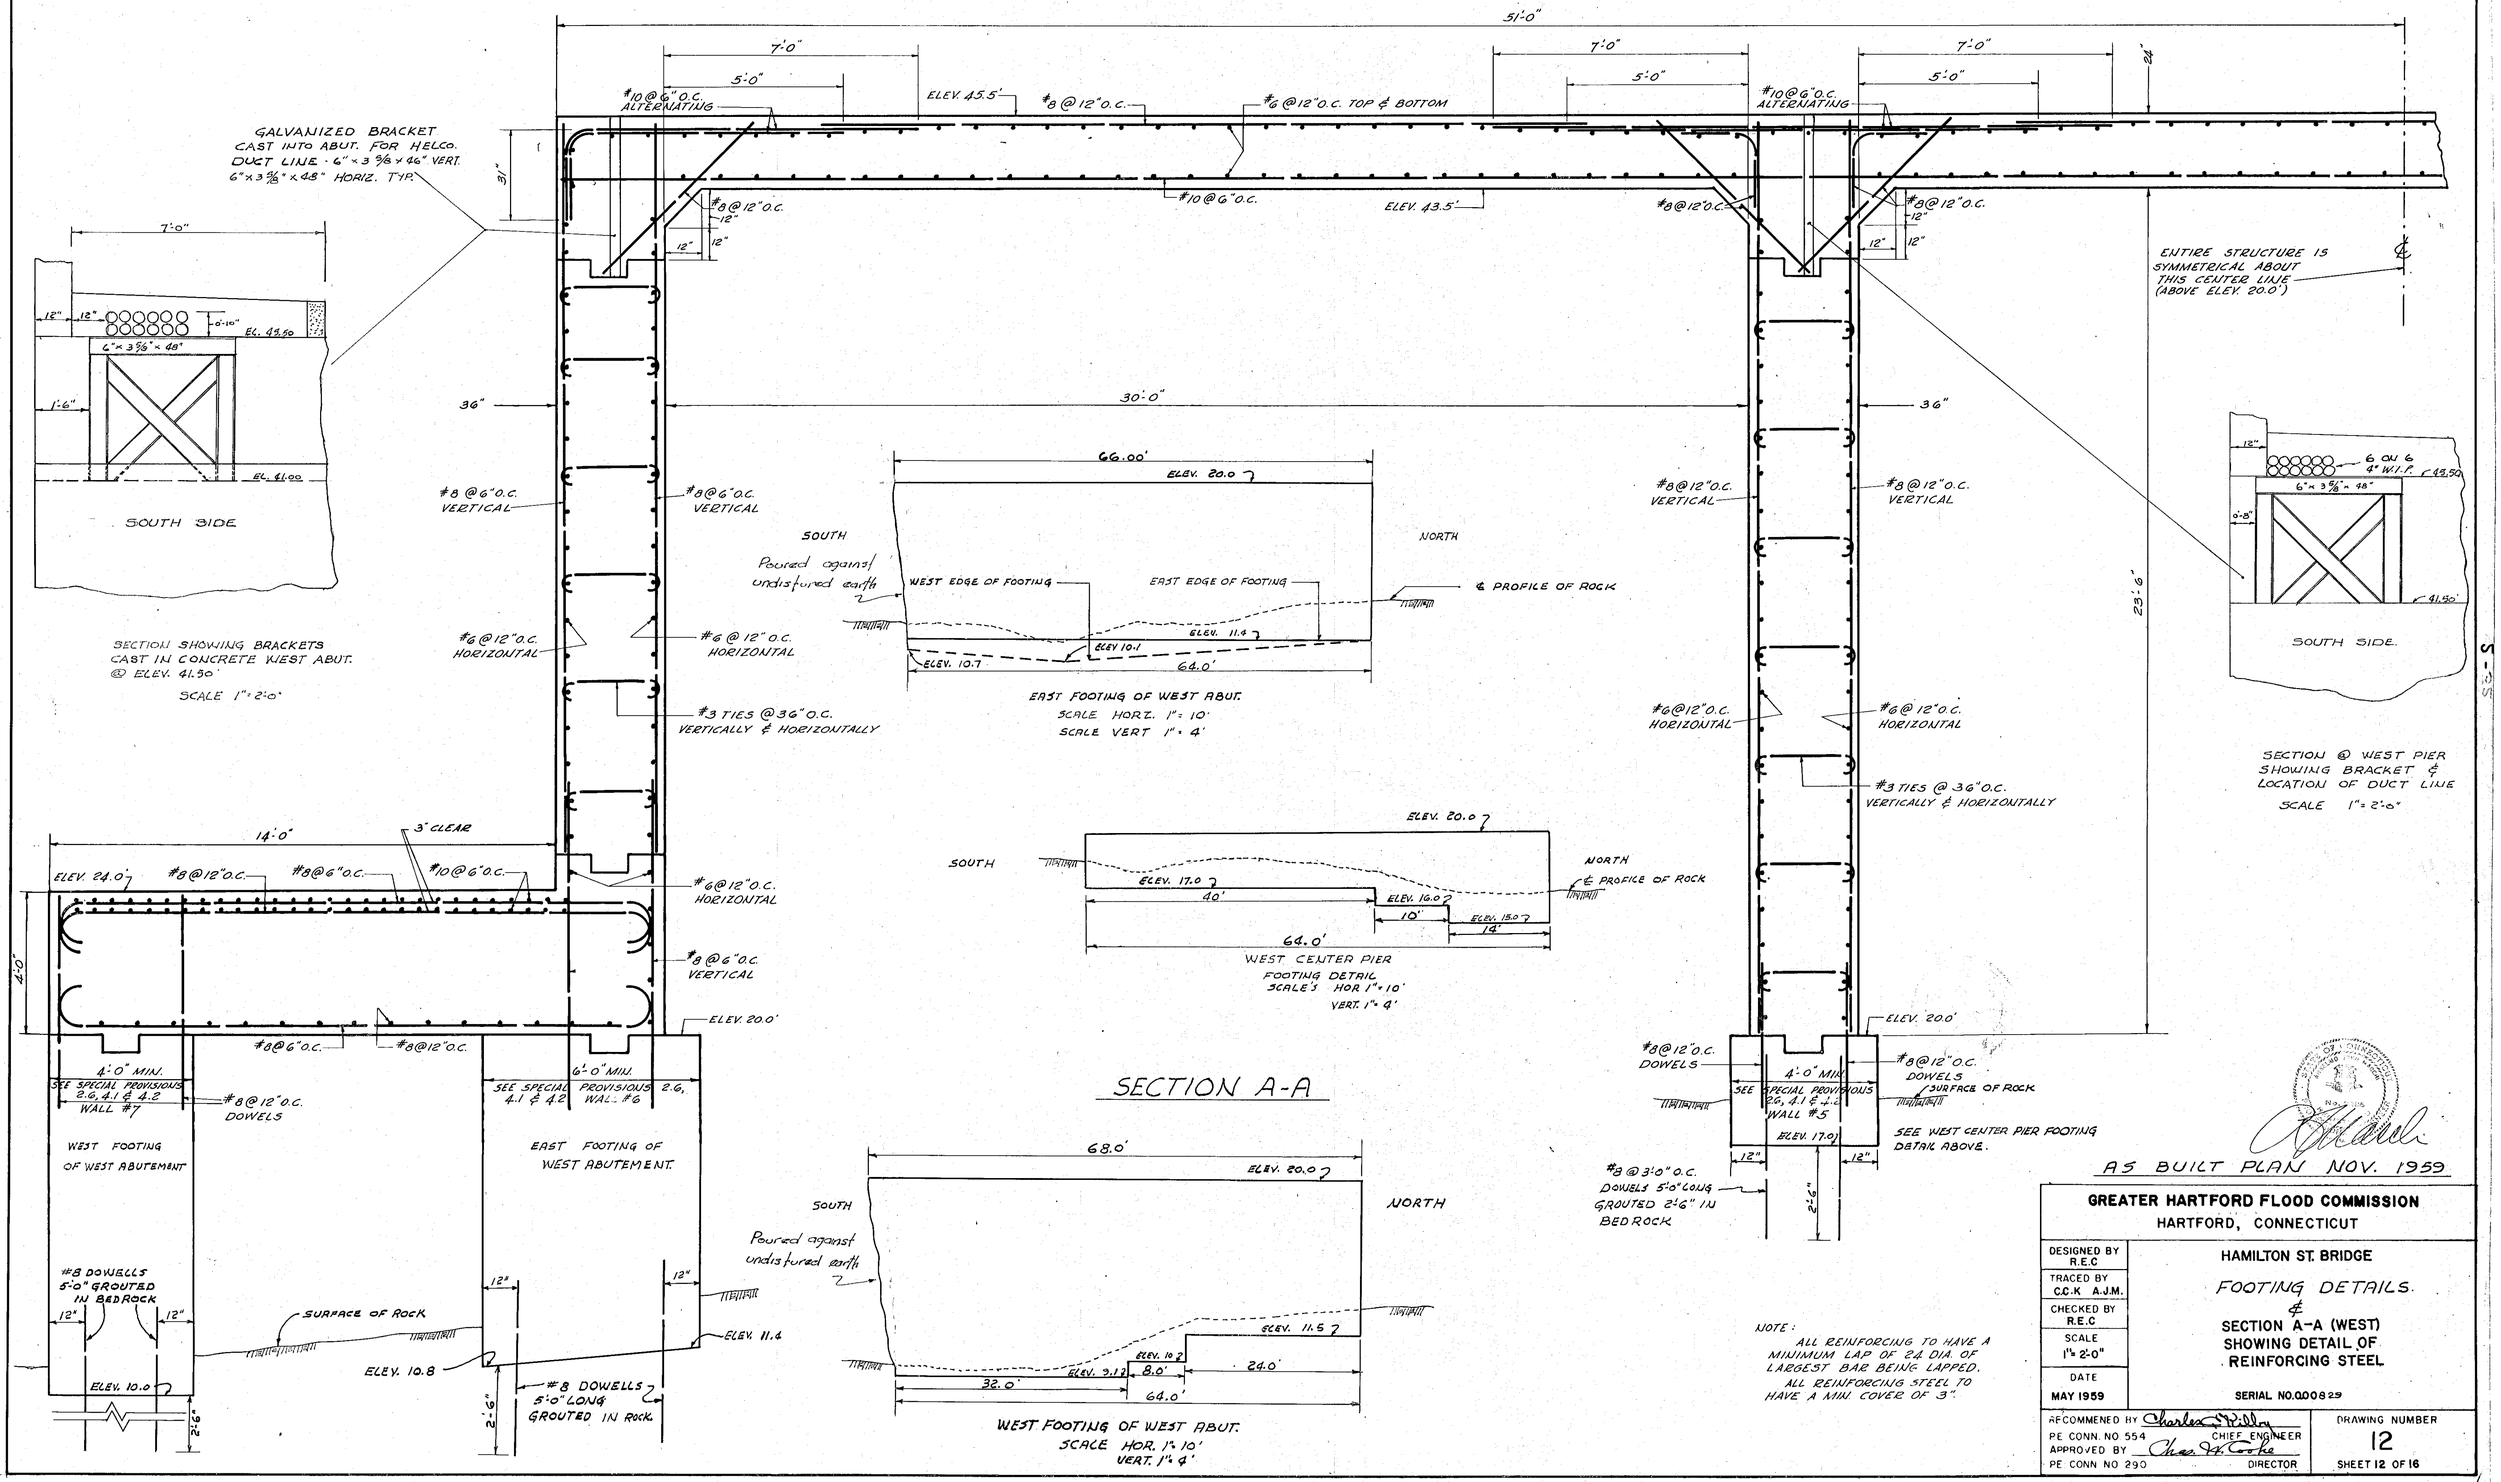

NOTE:
ALL REINFORCING TO HAVE A MINIMUM LAP OF 24 DIA. OF LARGEST BAR BEING LAPPED. ALL REINFORCING STEEL TO HAVE A MIN. COVER OF 3".

AS BUILT PLAN NOV. 1959

GREATER HARTFORD FLOOD COMMISSION
HARTFORD, CONNECTICUT

DESIGNED BY R.E.C	HAMILTON ST. BRIDGE
TRACED BY C.C.K A.J.M.	FOOTING DETAILS & SECTION A-A (WEST) SHOWING DETAIL OF REINFORCING STEEL
CHECKED BY R.E.C	
SCALE 1" = 2'-0"	
DATE MAY 1959	SERIAL NO. 000829
RECOMMENED BY Charles W. Kelley PE CONN. NO 554 CHIEF ENGINEER	DRAWING NUMBER 12
APPROVED BY Chas. W. Cooke PE CONN NO 290 DIRECTOR	SHEET 12 OF 16