


PLAN

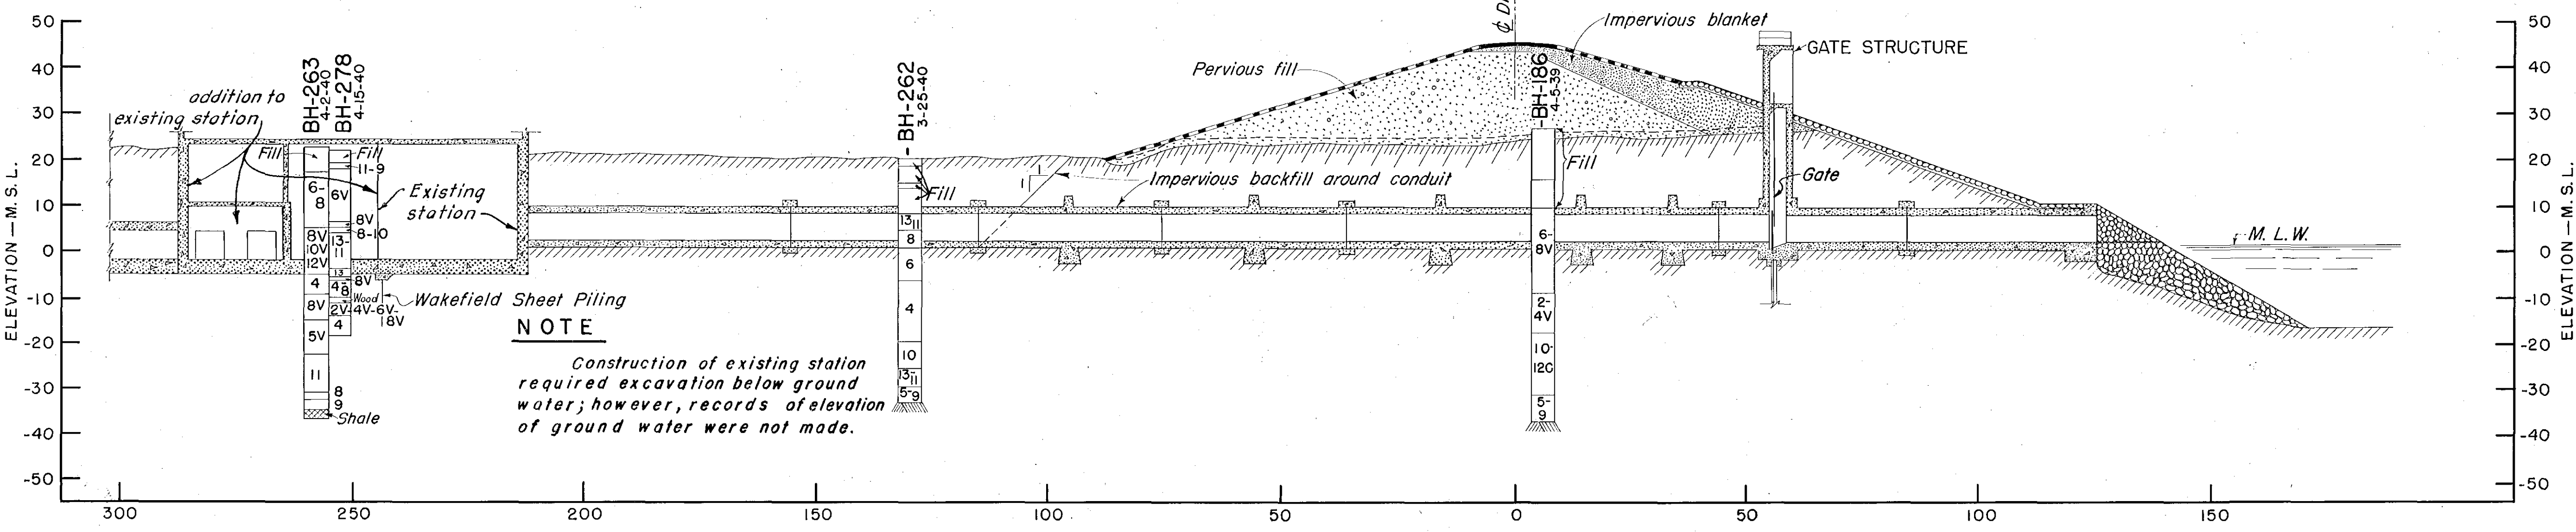

DESCRIPTION OF SOIL CLASSES

PROFILE ALONG ϕ KEENEY LANE OUTLET CONDUIT

- | | |
|---|---|
| 1 Graded from Gravel to Coarse Sand - Contains little medium sand. | 9 Graded from Gravel to Medium Silt - Contains little fine silt. |
| 2 Coarse to Medium Sand - Contains little gravel and fine sand. | 10 Medium to Fine Silt - Contains little coarse silt and coarse clay. Possesses behavior characteristics of silt. |
| 3 Graded from Gravel to Medium Sand - Contains little fine sand. | 10C Medium Silt to Coarse Clay - Contains little coarse silt and medium clay. Possesses behavior characteristics of clay. |
| 4 Medium to Fine Sand - Contains little coarse sand and coarse silt. | 11 Graded from Gravel or Coarse Sand to Fine Silt - Contains little coarse clay. |
| 5 Graded from Gravel to Fine Sand - Contains little coarse silt. | 12 Fine Silt to Clay - Contains little medium silt and fine clay (colloids). Possesses behavior characteristics of clay. |
| 6 Fine Sand to Coarse Silt - Contains little medium sand and medium silt. | 12C Clay - Contains little silt. Possesses behavior characteristics of clay. |
| 7 Graded from Gravel to Coarse Silt - Contains little medium silt. | 13 Graded from Coarse Sand to Clay - Contains little fine clay (colloids). Possesses behavior characteristics of silt. |
| 8 Coarse to Medium Silt - Contains little fine sand and fine silt. | 13C Clay - Graded from sand to fine clay (colloids). Possesses behavior characteristics of clay. |

NOTES

Samples, logs, and test results may be inspected at U. S. Engineer Office, Providence, R. I.
Soils having classifications of two soil classes (i.e. 4-2) have coarser portion of soil in initial class (4), and finer portion in final class (2).
Contours shown are those taken at time of exploration and before construction operations.

LEGEND

4V - Numerical class (Providence District Soil Classification). Letter "V" indicates visual classification.
BH = Bore Hole.

KEY	DATE	REVISION (Indicated by Δ)	REV. BY	CK. BY	AP. BY

RECORD
DRAWINGS

CONNECTICUT RIVER FLOOD CONTROL KEENEY LANE PUMPING STATION HARTFORD, CONN. SUBSURFACE EXPLORATIONS			
CONNECTICUT RIVER IN 60 SHEETS		CONNECTICUT SHEET NO. 4	
U.S. ENGINEER OFFICE, PROVIDENCE, R.I., JUNE 1944			
SUBMITTED: <i>H. S. Lane</i> ENGINEER		APPROVAL RECOMMENDED: <i>T. S. Bunker</i> HEAD ENGINEER	
HEAD, SOILS LABORATORY		COL. CORPS OF ENGINEERS DISTRICT ENGINEER	
PREPARED: <i>W. B. Bunker</i> SOILS LABORATORY		DRAWN: M. H. L. TRACED: H. A. Y. CHECKED: <i>M. H. L.</i>	
S. L. NO. Ht. 6d A2d		FILE NO. CT-2-1390	