


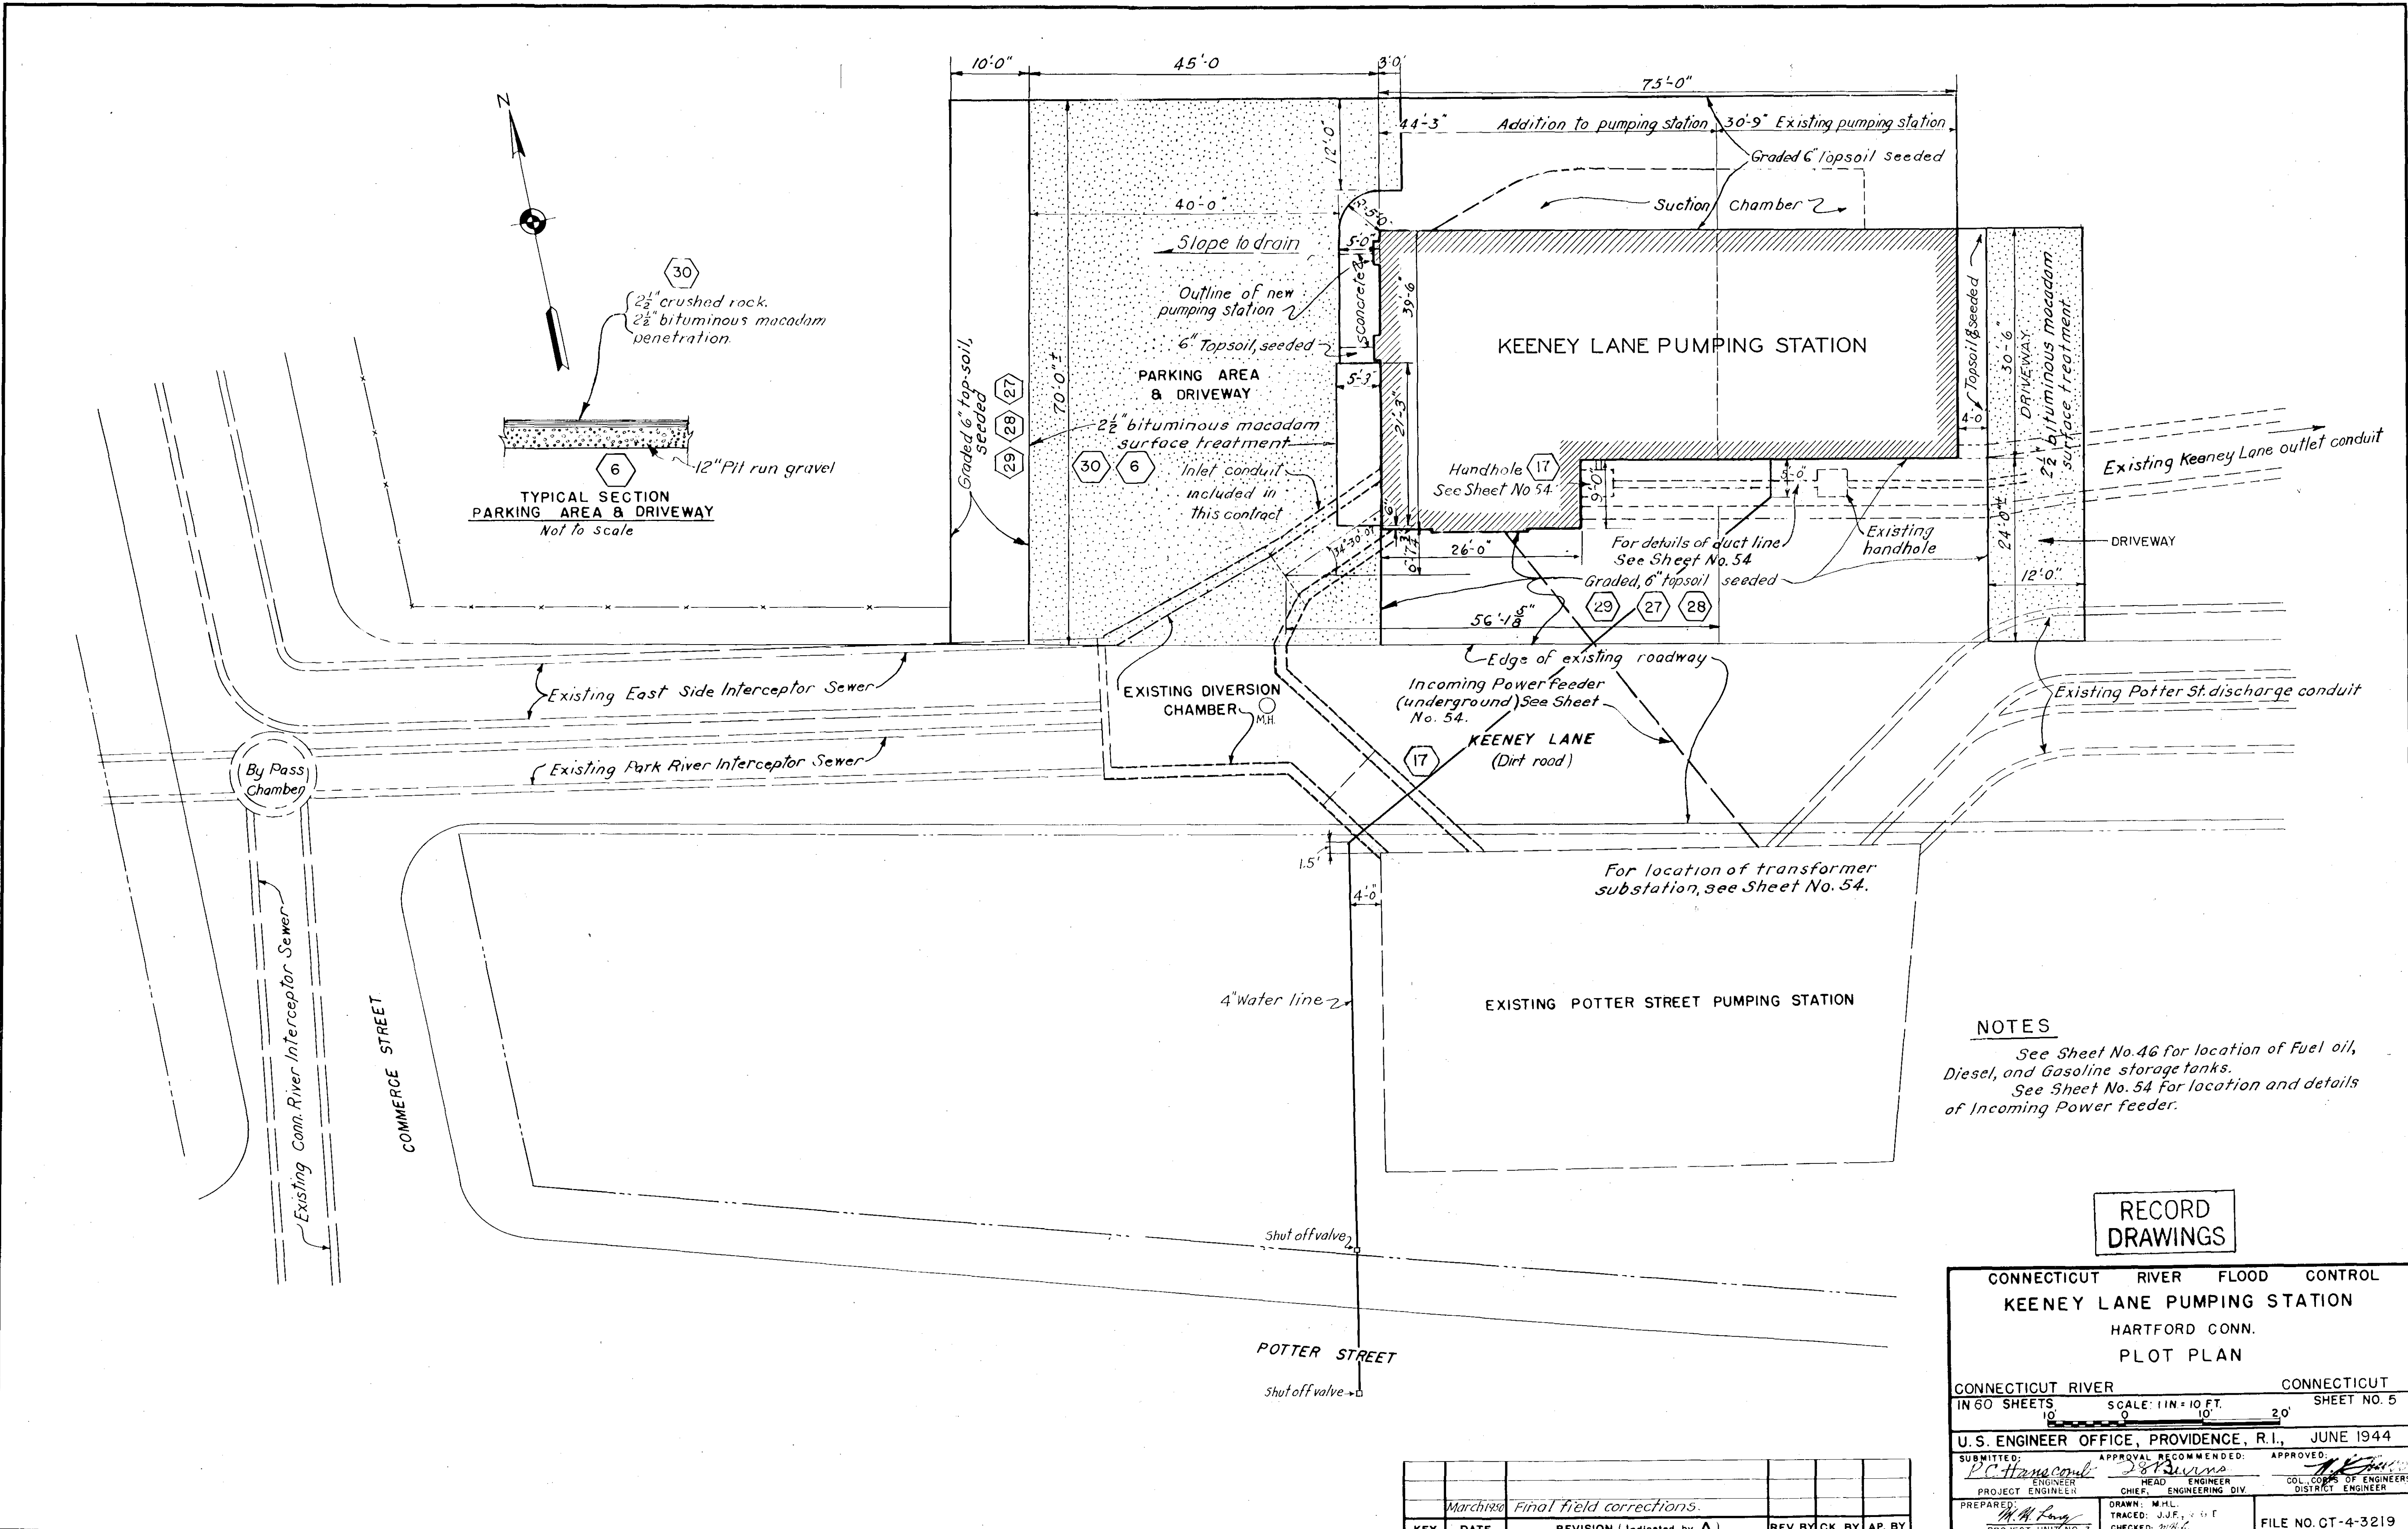

NOTES
See Sheet No. 46 for location of Fuel oil, Diesel, and Gasoline storage tanks.
See Sheet No. 54 for location and details of Incoming Power feeder.

RECORD
DRAWINGS

CONNECTICUT RIVER FLOOD CONTROL			
KEENEY LANE PUMPING STATION			
HARTFORD CONN.			
PLOT PLAN			
CONNECTICUT RIVER	SCALE: 1" = 10' FT.		CONNECTICUT
IN 60 SHEETS	0 10 20		SHEET NO. 5
U. S. ENGINEER OFFICE, PROVIDENCE, R.I., JUNE 1944			
SUBMITTED:	APPROVAL RECOMMENDED:	APPROVED:	
PROJECT ENGINEER	HEAD ENGINEER	COL. CORPS OF ENGINEERS	
PROJECT ENGINEER	CHIEF ENGINEERING DIV.	DISTRICT ENGINEER	
PREPARED:	DRAWN: M.H.L.	TRACED: J.J.F.	FILE NO. CT-4-3219
PROJECT UNIT NO. 3			

March 1940	Final field corrections.				
KEY	DATE	REVISION (Indicated by Δ)	REV. BY	CK. BY	AP. BY