


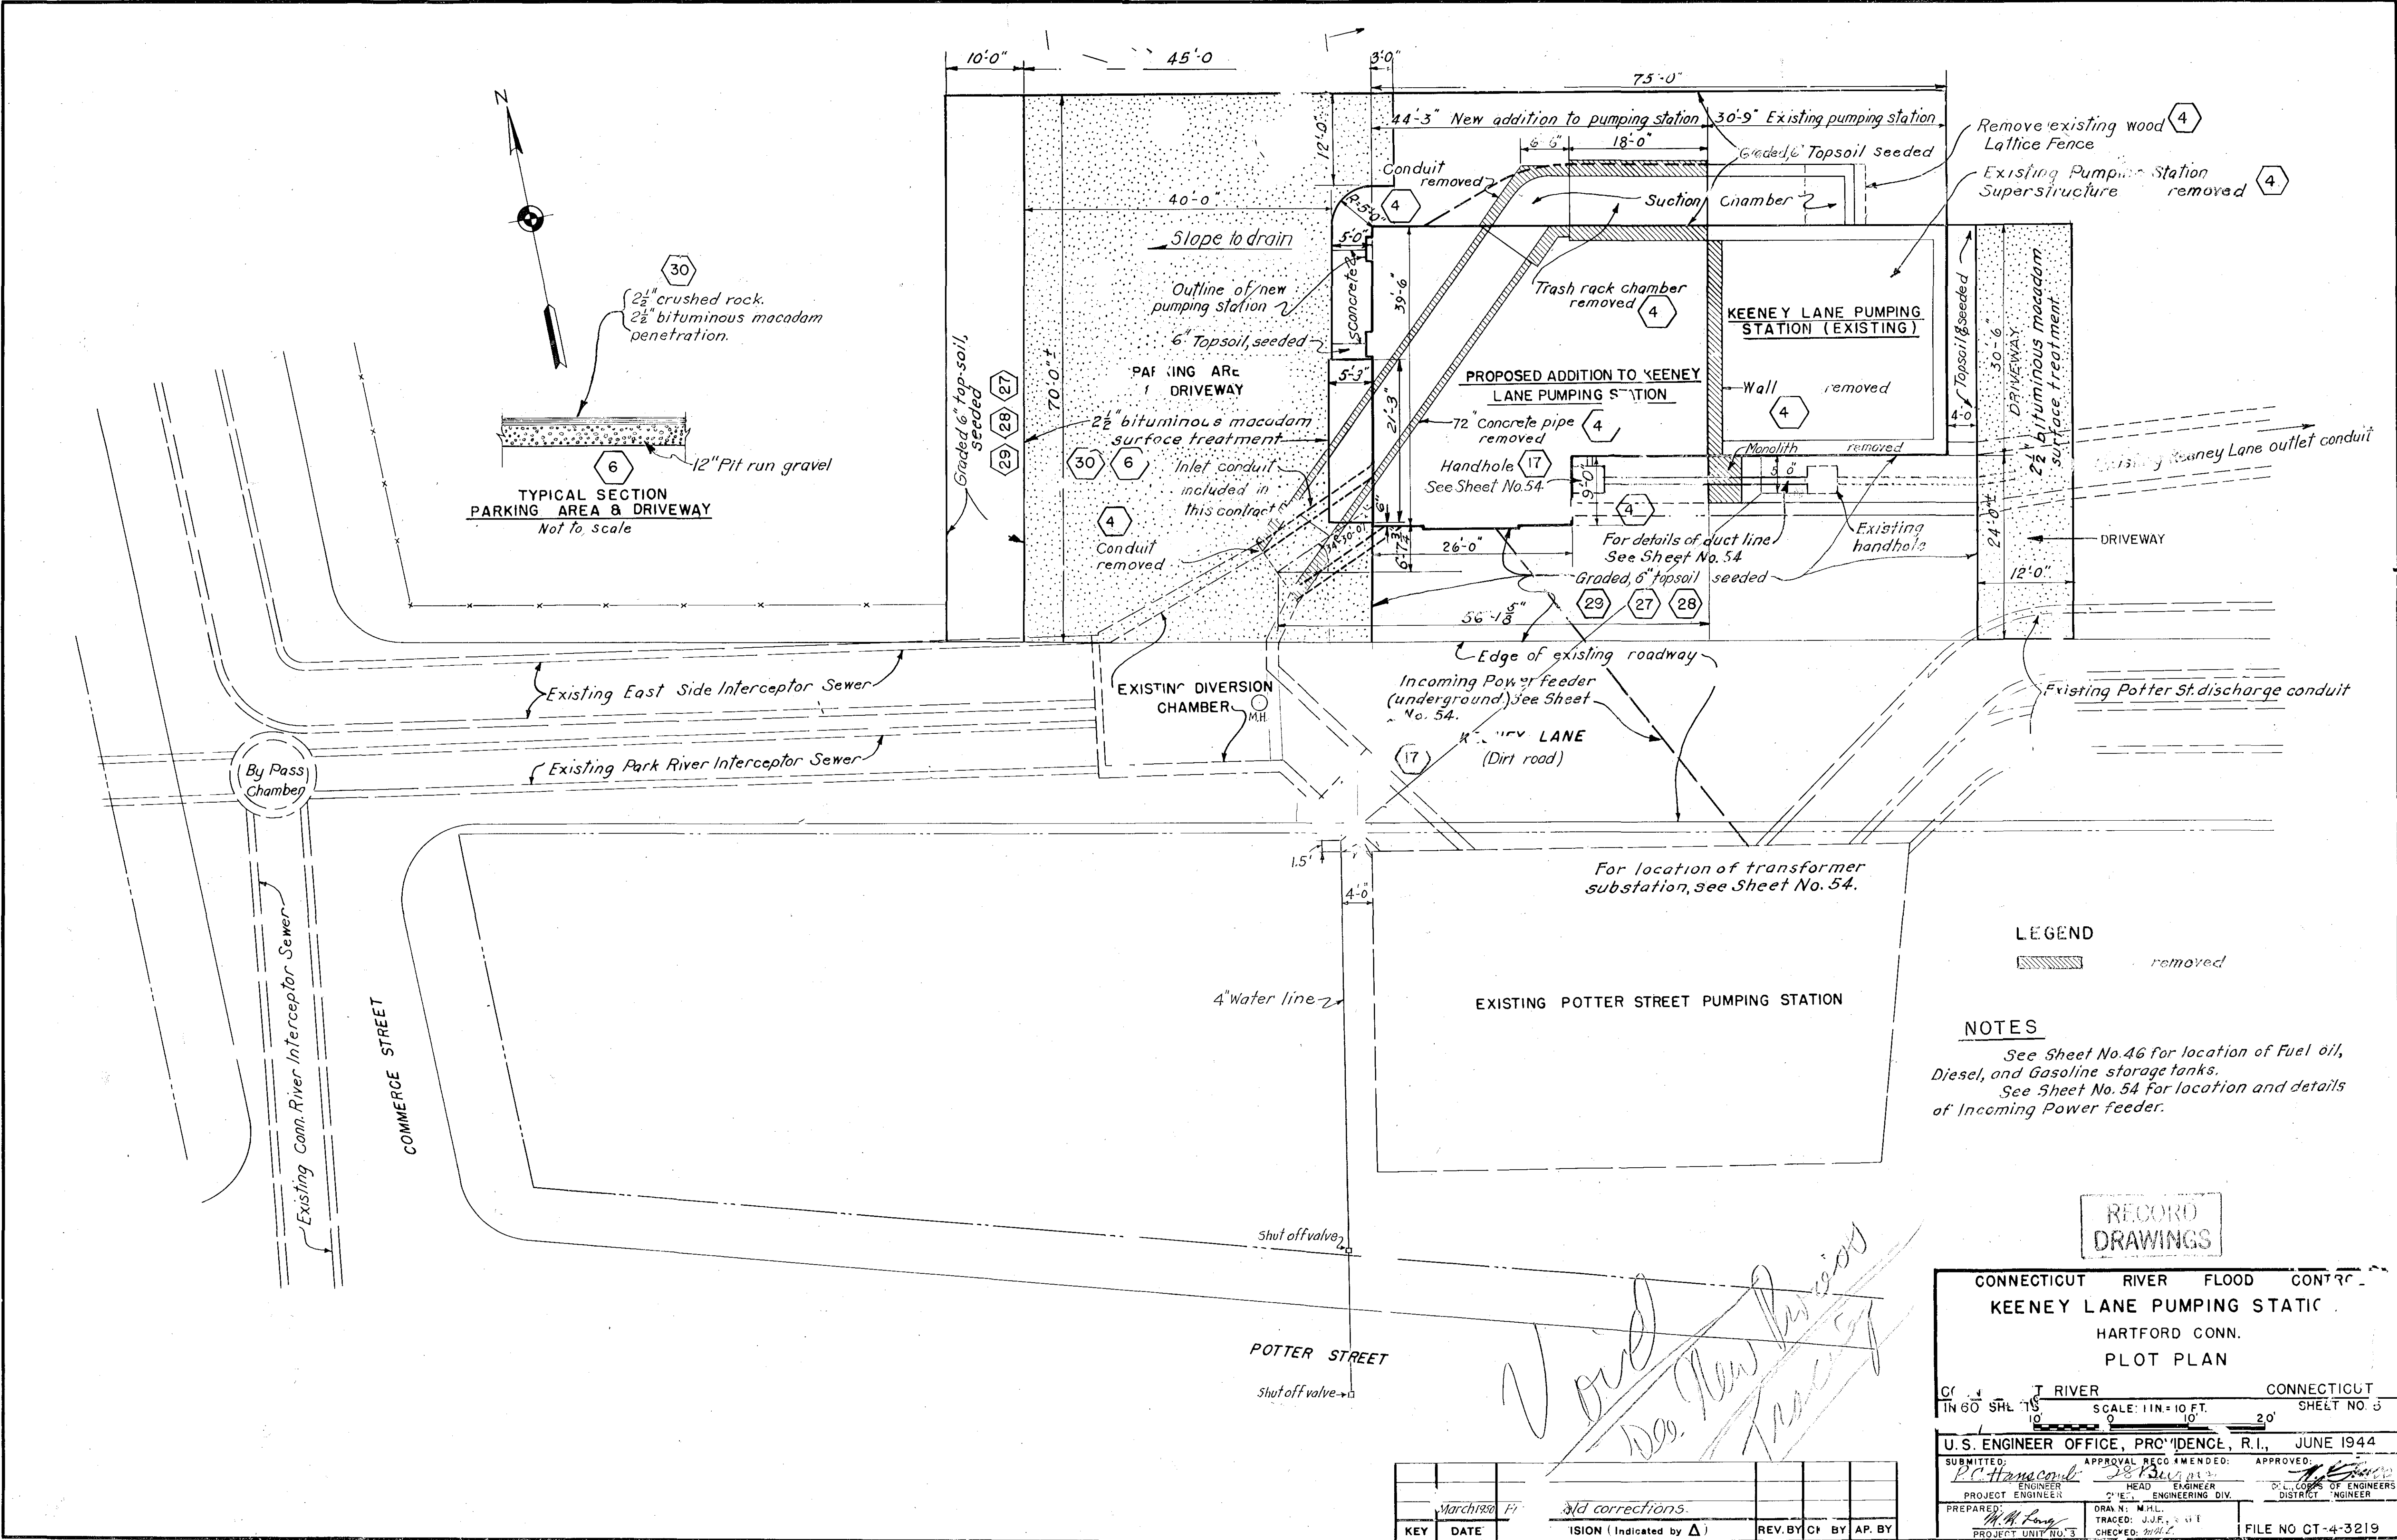

LEGEND
removed

NOTES
See Sheet No. 46 for location of Fuel oil, Diesel, and Gasoline storage tanks.
See Sheet No. 54 for location and details of Incoming Power feeder.

RECORD
DRAWINGS

CONNECTICUT RIVER FLOOD CONTROL
KEENEY LANE PUMPING STATION
HARTFORD CONN.
PLOT PLAN

CR	CT RIVER	CONNECTICUT
IN 60 SHEETS	SCALE: 1" = 10' FT.	SHEET NO. 3
U.S. ENGINEER OFFICE, PROVIDENCE, R.I., JUNE 1944		
PREPARED: M.H. LONG PROJECT UNIT NO. 3	DRAWN BY: J.J.F. CHECKED BY: M.H.L.	FILE NO. CT-4-3219

KEY	DATE	VISION (Indicated by Δ)	REV. BY	CH	BY	AP. BY
