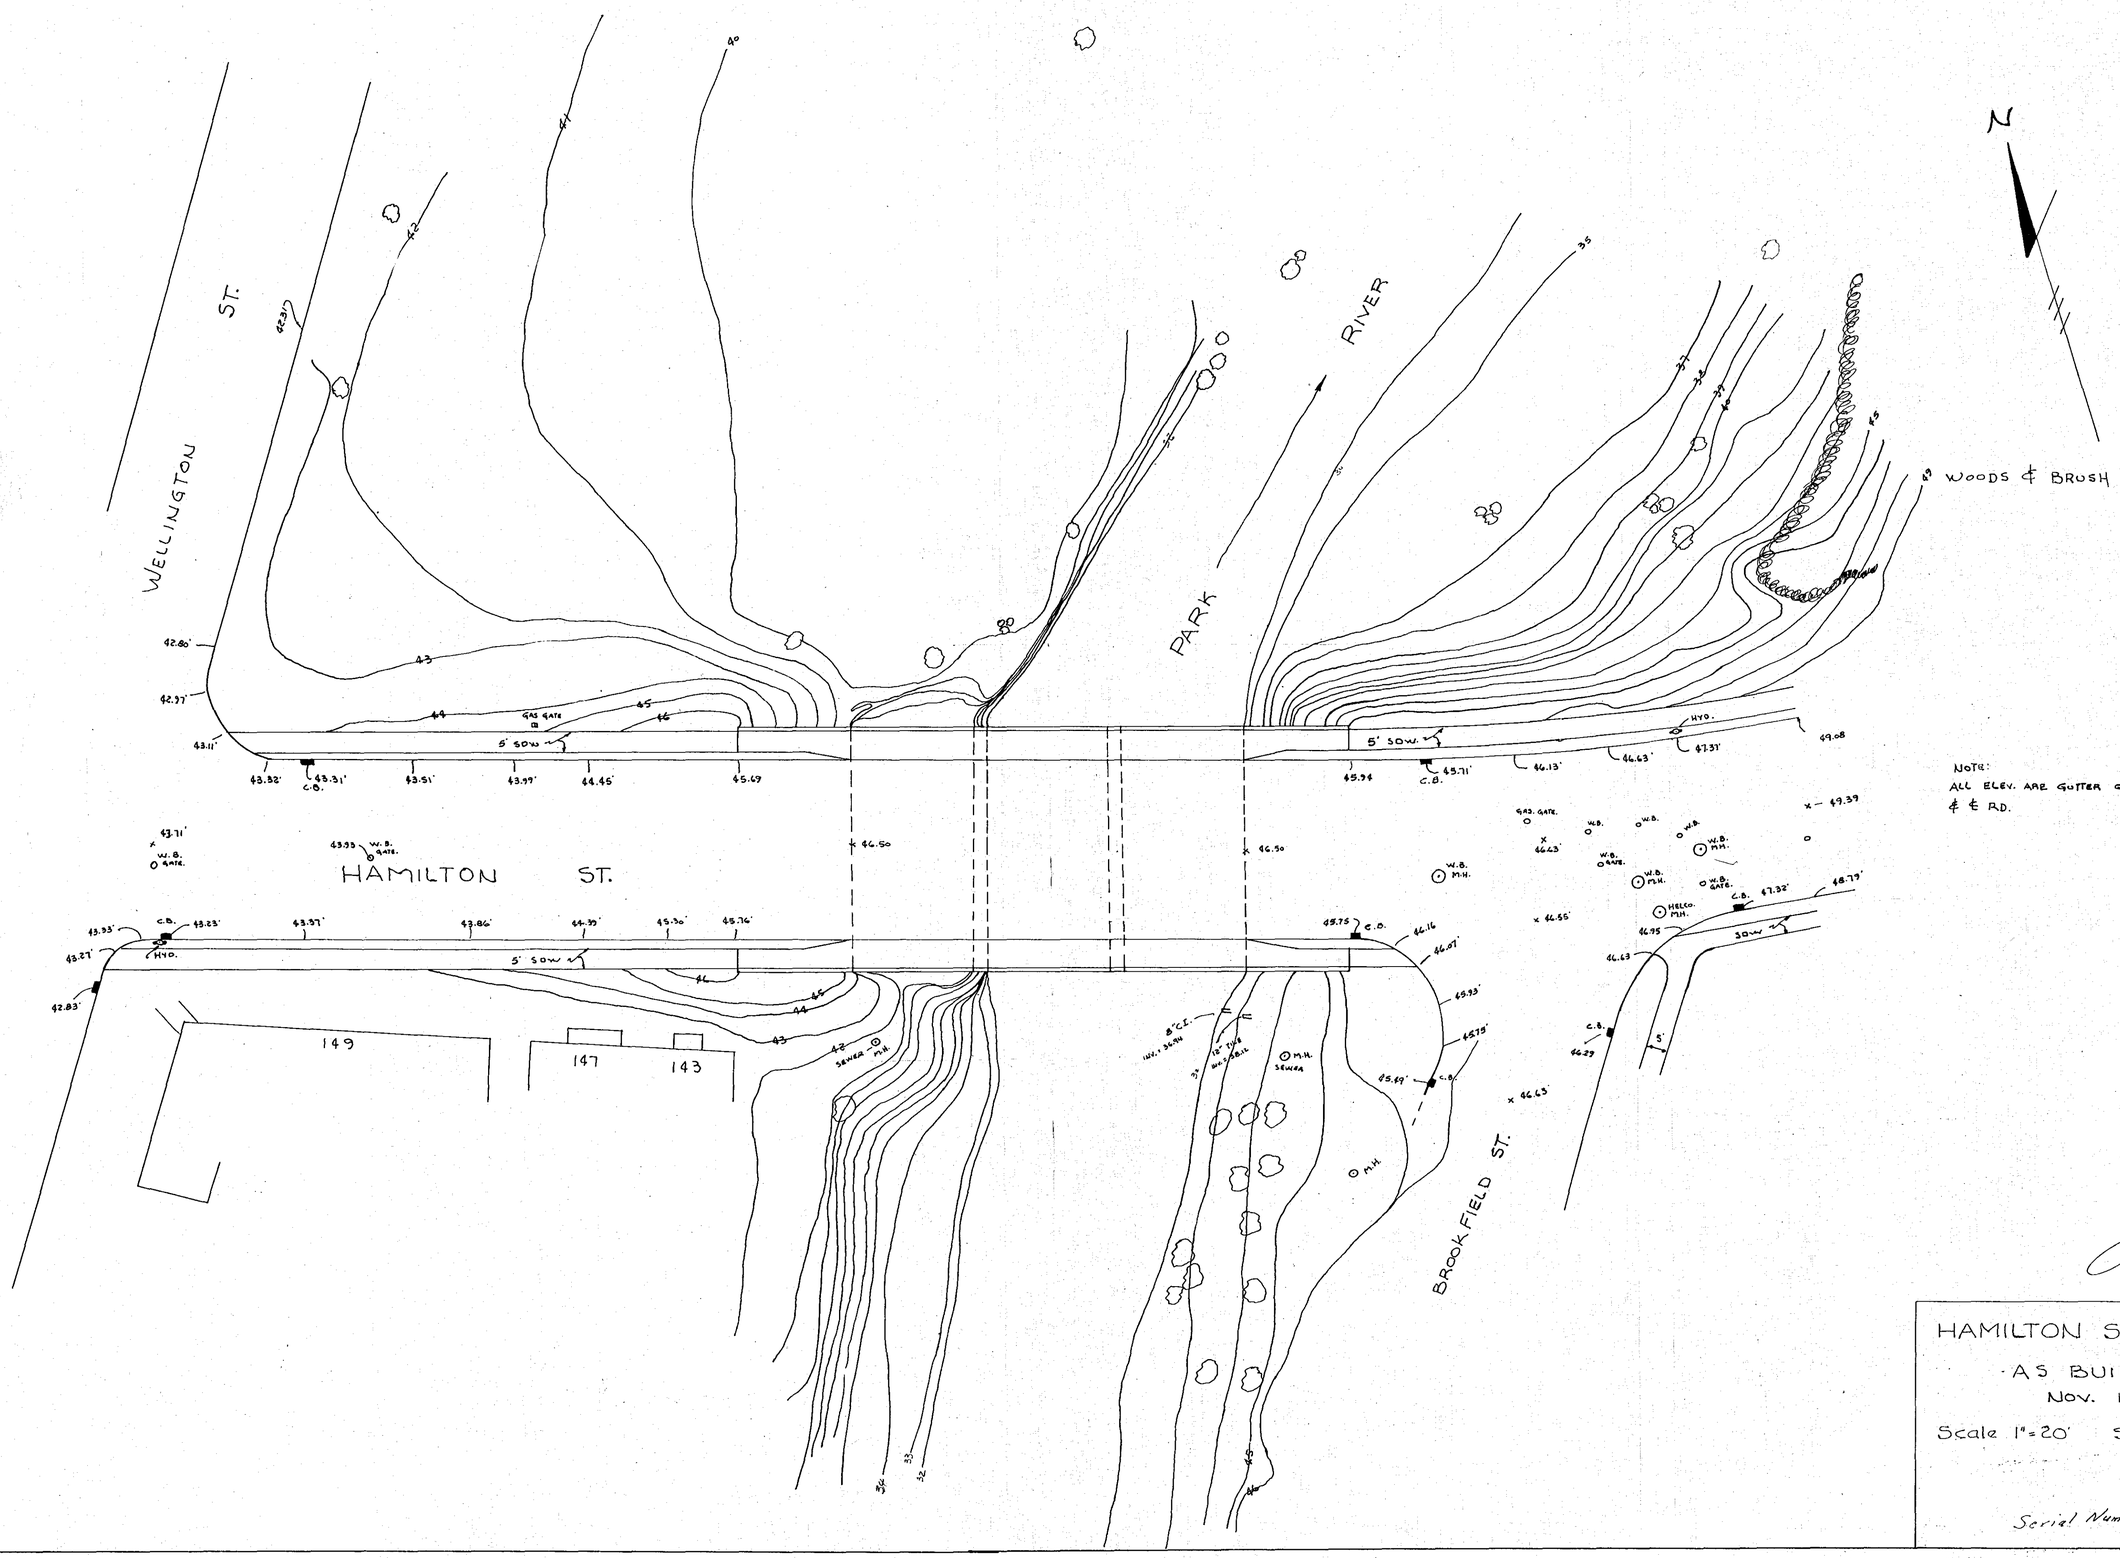

NOTE:
ALL ELEV. ARE GUTTER GRADES.
℄ ℄ RD.

STATE OF CONNECTICUT
PUBLIC WORKS COMMISSION
No. 2205
REGISTERED ENGINEER

HAMILTON ST. BRIDGE

AS BUILT PLAN

Nov. 1959

Scale 1"=20' Sheet Nº 7A

Serial Number 000833