
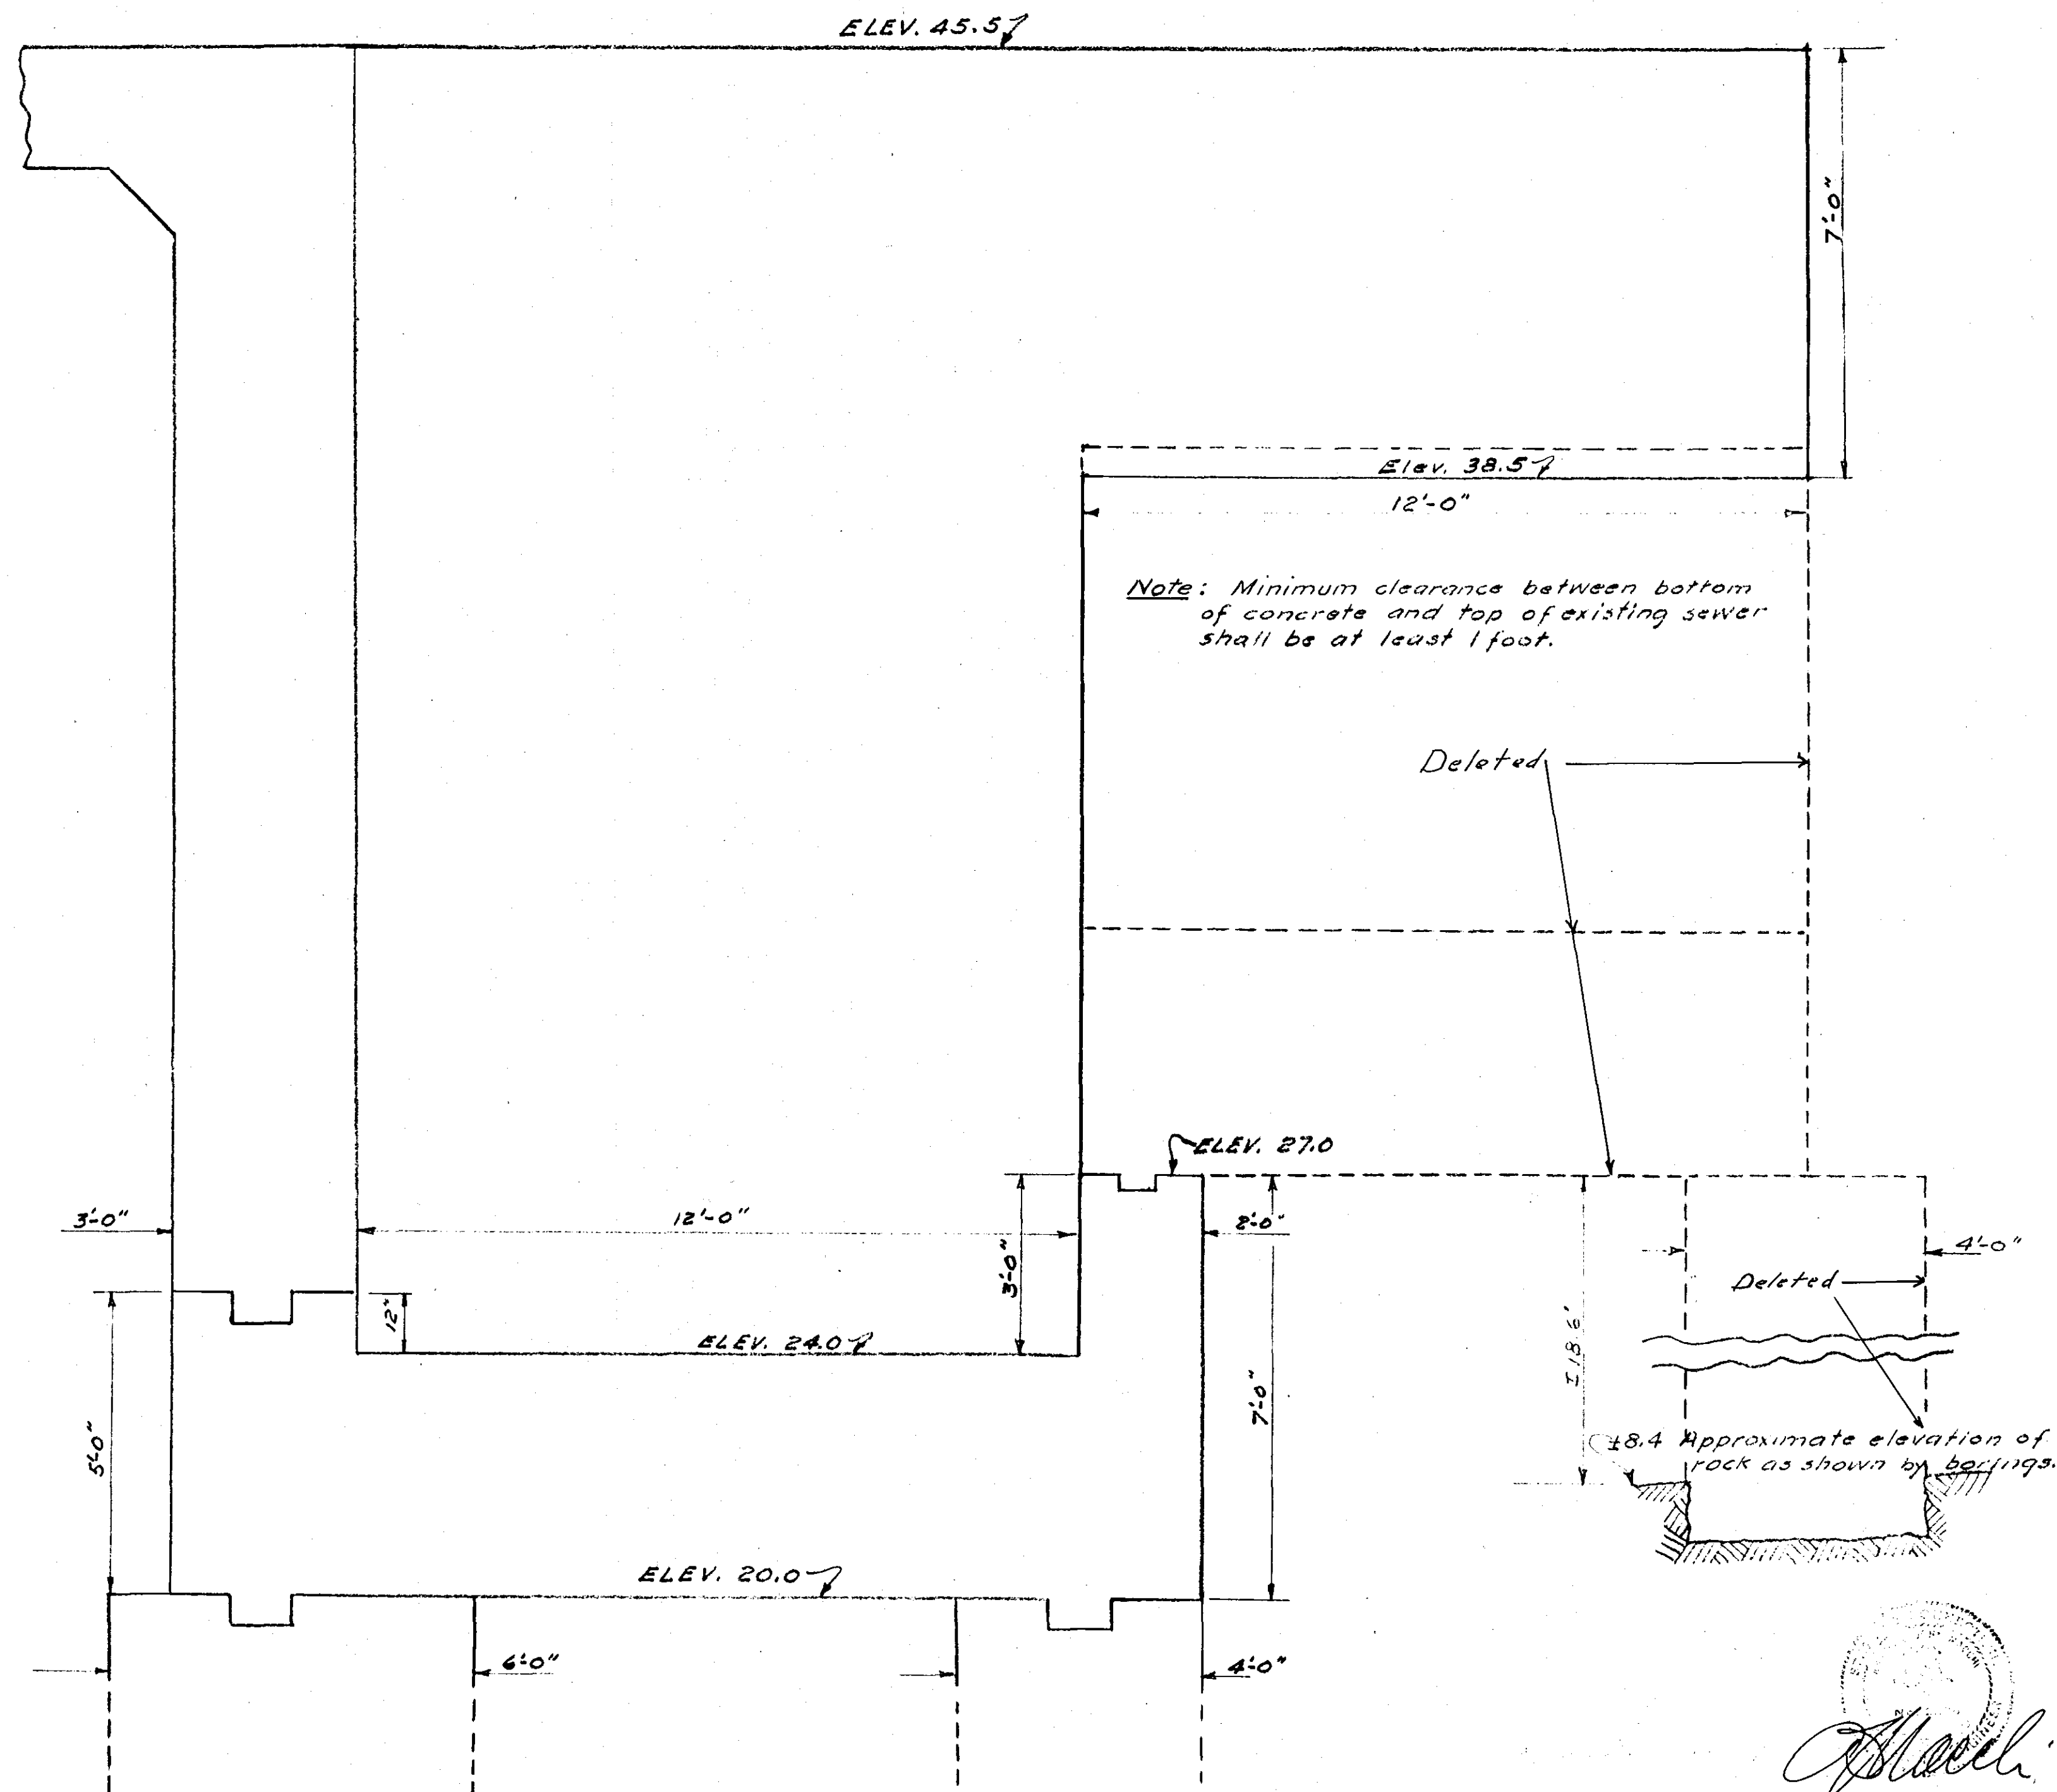


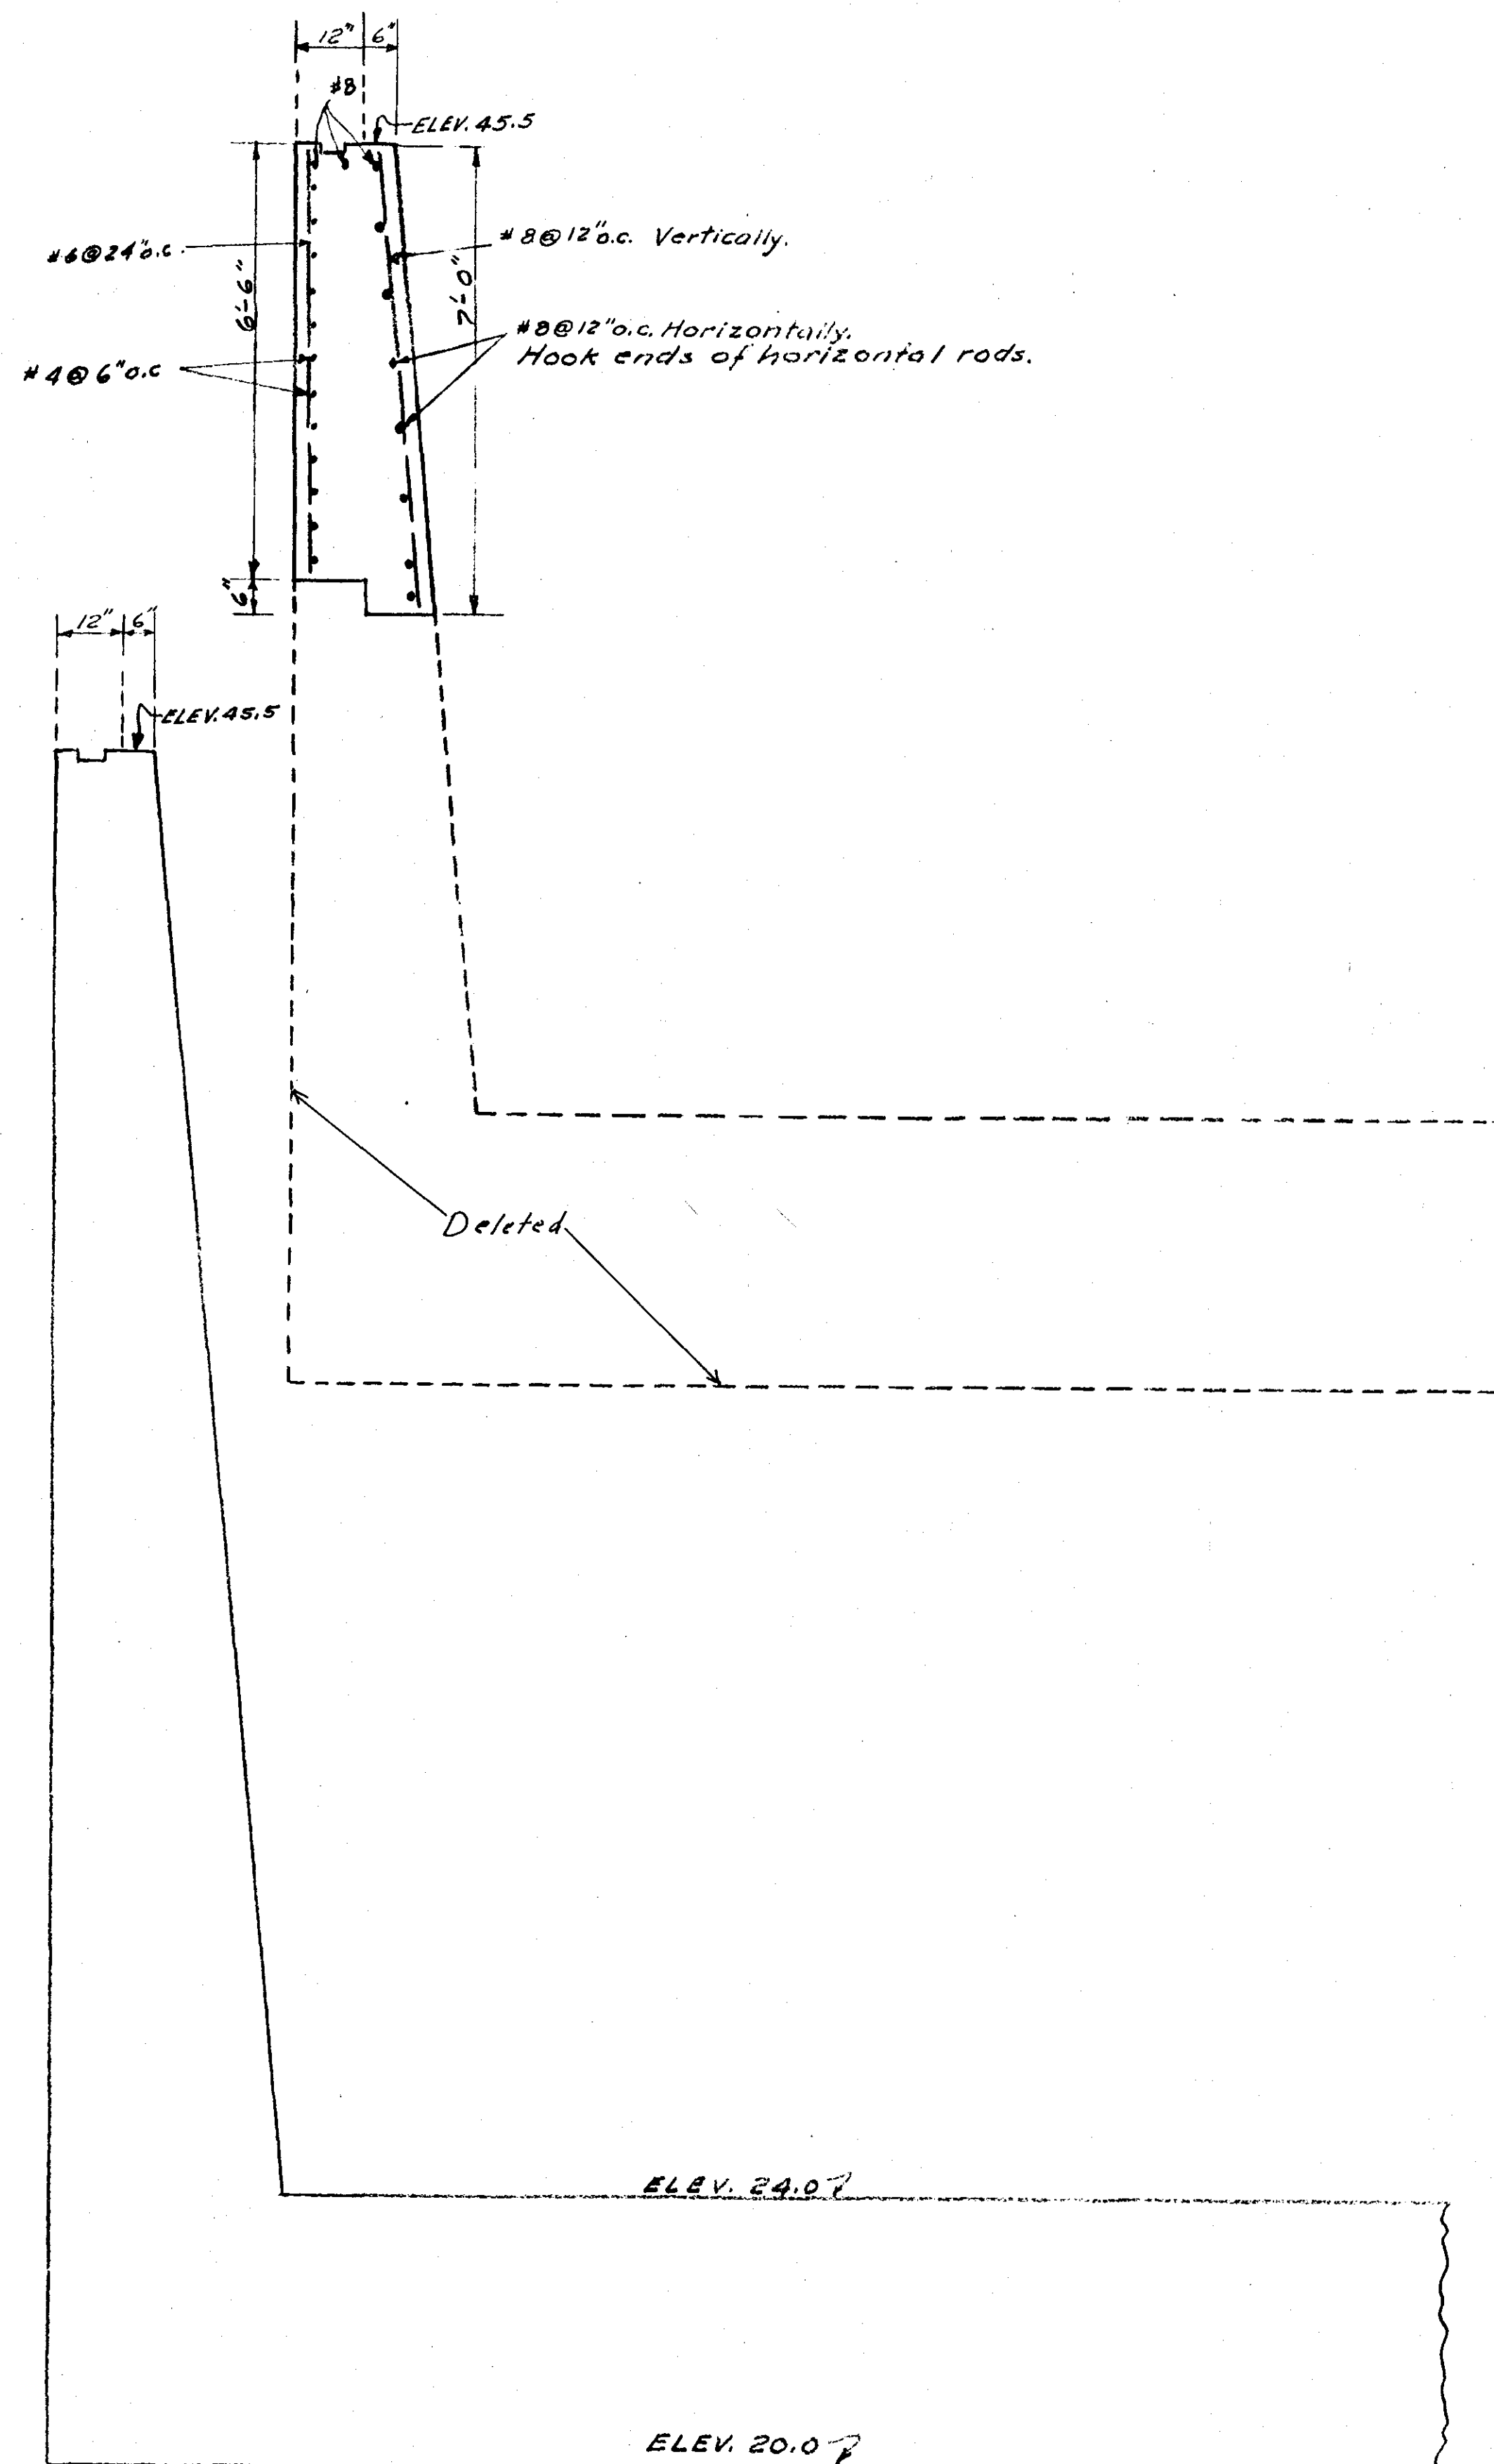

GREATER HARTFORD FLOOD COMMISSION HARTFORD, CONNECTICUT	
DESIGNED BY	HAMILTON ST. BRIDGE
TRACED BY	
CHECKED BY	DETAIL OF SOUTH WEST WING WALL AS REVISED TO CLEAR SEWER
SCALE 1" = 2'-0"	
DATE July 1959	G.H.F.C. Serial No. 000 838
RECOMMENDED BY P.E. CONN. NO. 554 APPROVED BY P.E. CONN. NO. 290	CHIEF ENGINEER DIRECTOR
DRAWING NUMBER 13-A SHEET 21 OF 16	