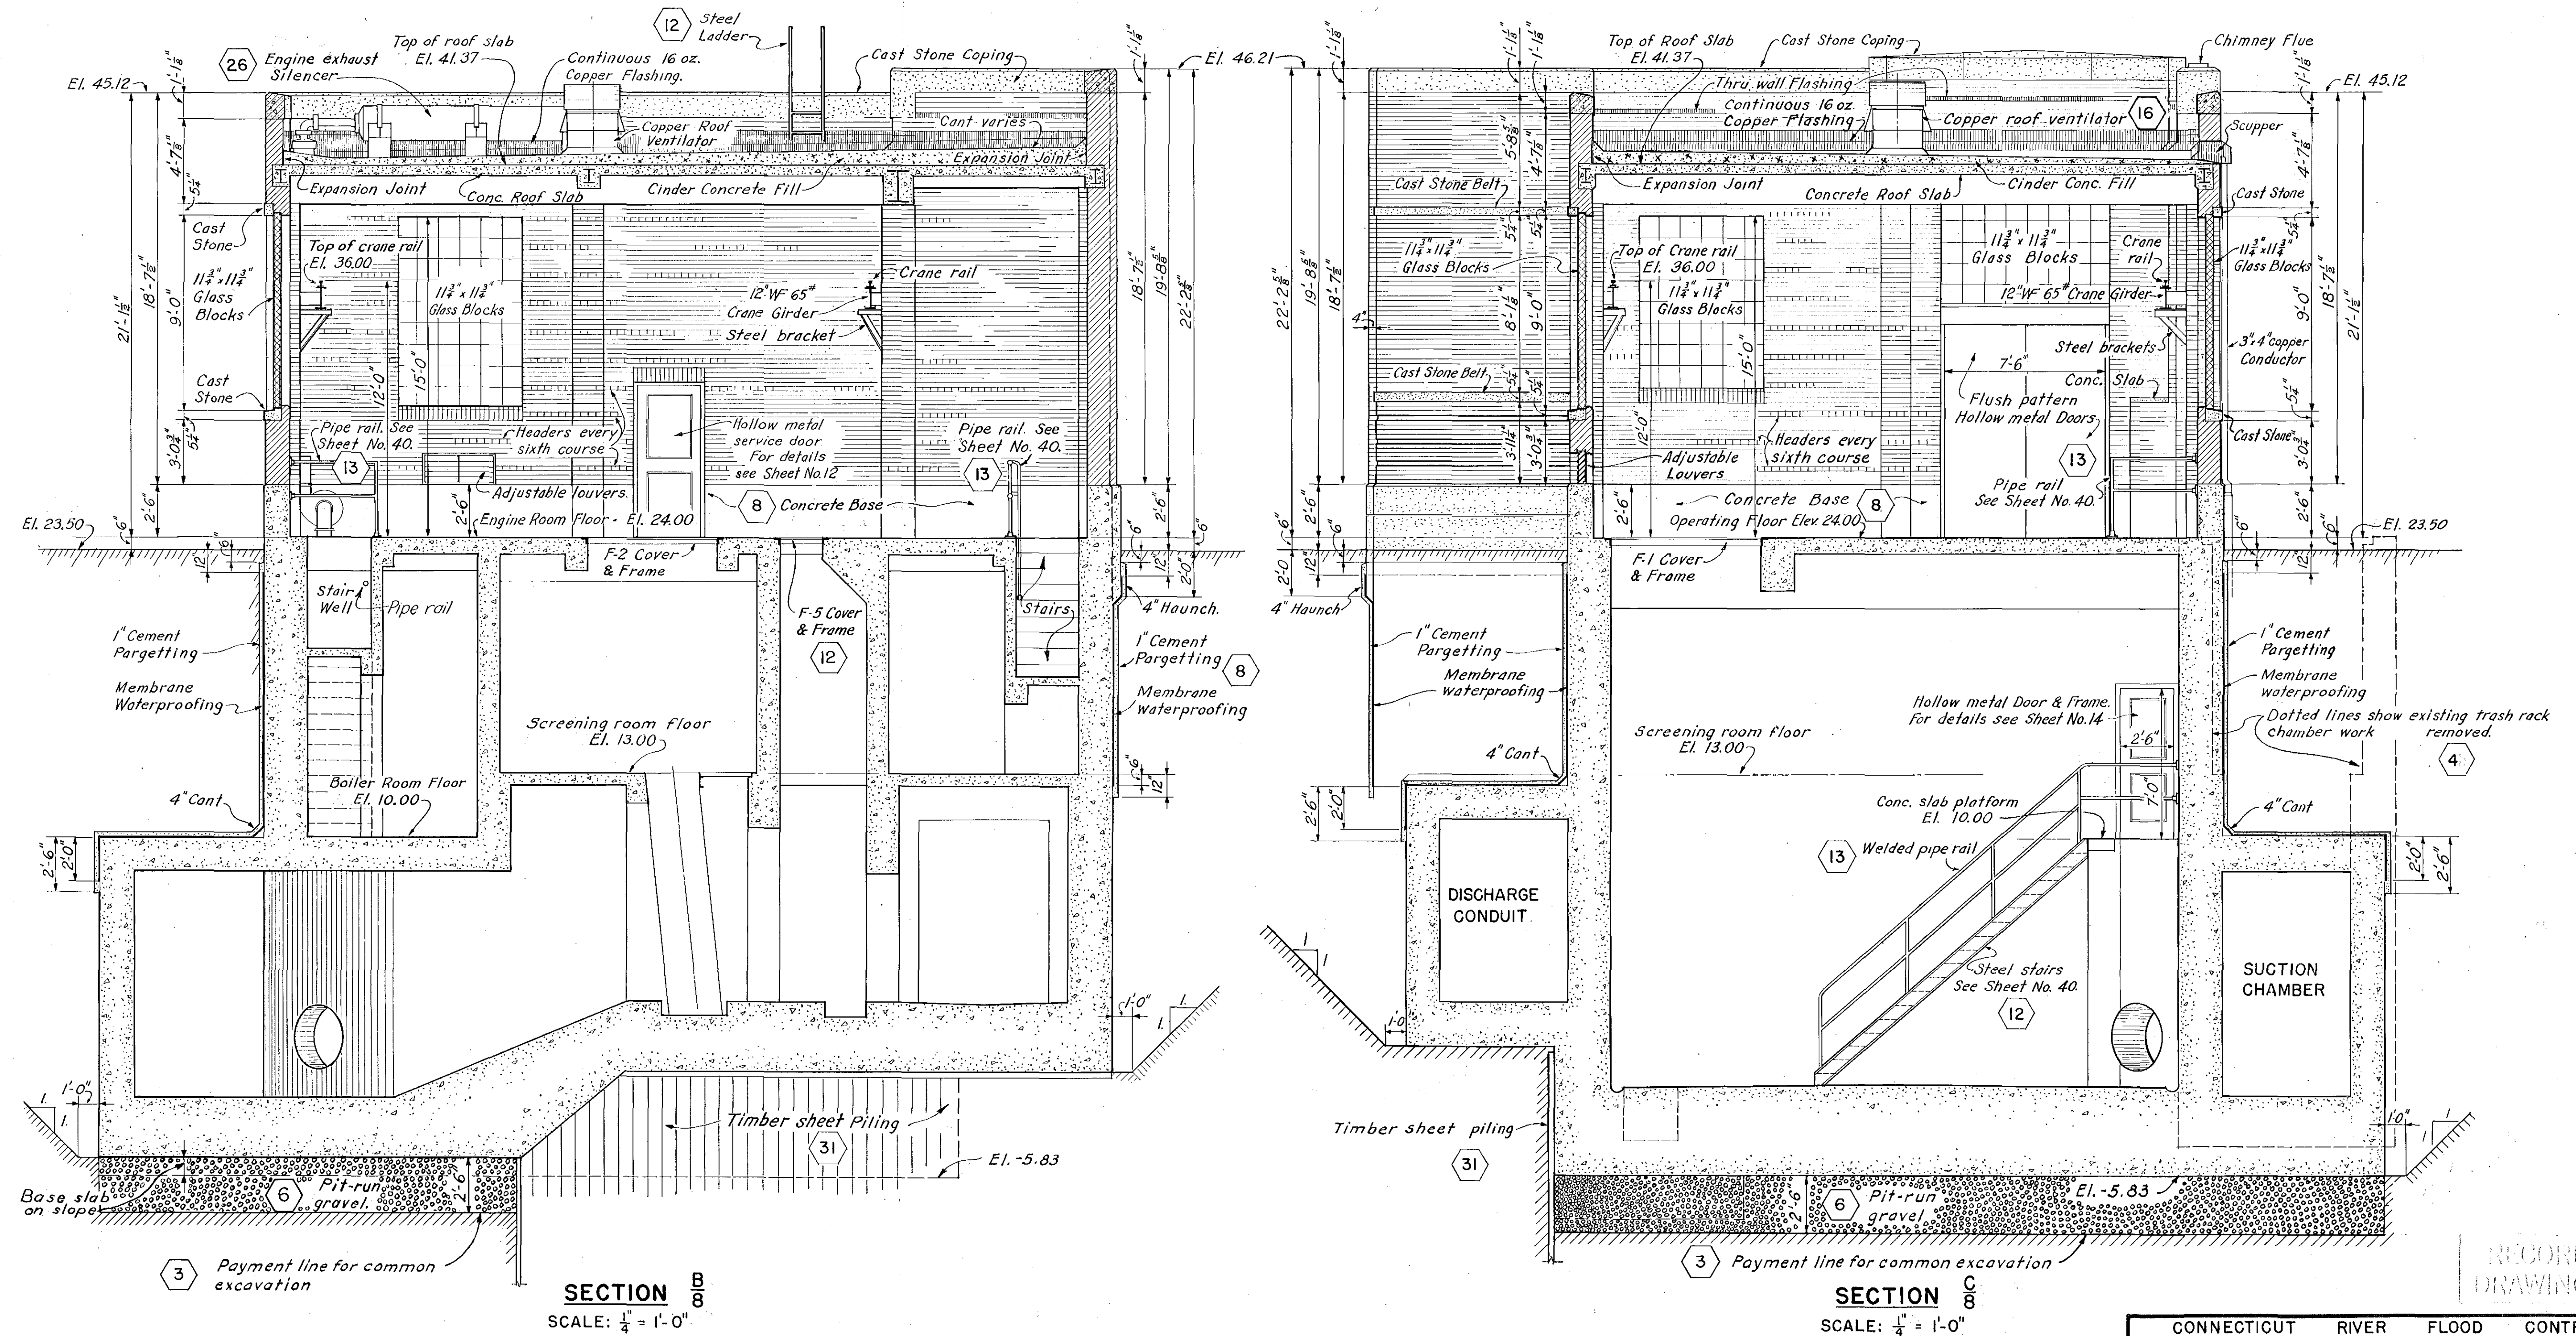


RECORD
DRAWINGS

CONNECTICUT RIVER FLOOD CONTROL			
KEENEY LANE PUMPING STATION			
HARTFORD, CONN.			
TRANSVERSE SECTIONS			
ARCHITECTURAL			
CONNECTICUT RIVER			CONNECTICUT
IN 60 SHEETS	SCALE 1/4 IN. = 1 FT.	SHEET NO. 15	
U.S. ENGINEER OFFICE, PROVIDENCE, R.I., JUNE 1944			
SUBMITTED:	APPROVAL:	RECOMMENDED:	APPROVED:
E. M. Viner	J. R. Collette	J. R. Collette	J. R. Collette
SENIOR ENGINEER	HEAD ENGINEER	CHIEF ENGINEER	COL. CORPS OF ENGINEERS
HEAD STRUCTURAL SECTION	CHIEF, ENGINEERING DIV.	DISTRICT ENGINEER	
PREPARED:	DRAWN:	TRACED:	CHECKED:
J. R. Collette	F. H. B. Jr.	S. H. B.	
ARCH. SUBSECTION			
			FILE NO. CT-4-3229

KEY	DATE	REVISION (Indicated by Δ)	REV. BY	CK. BY	AP. BY