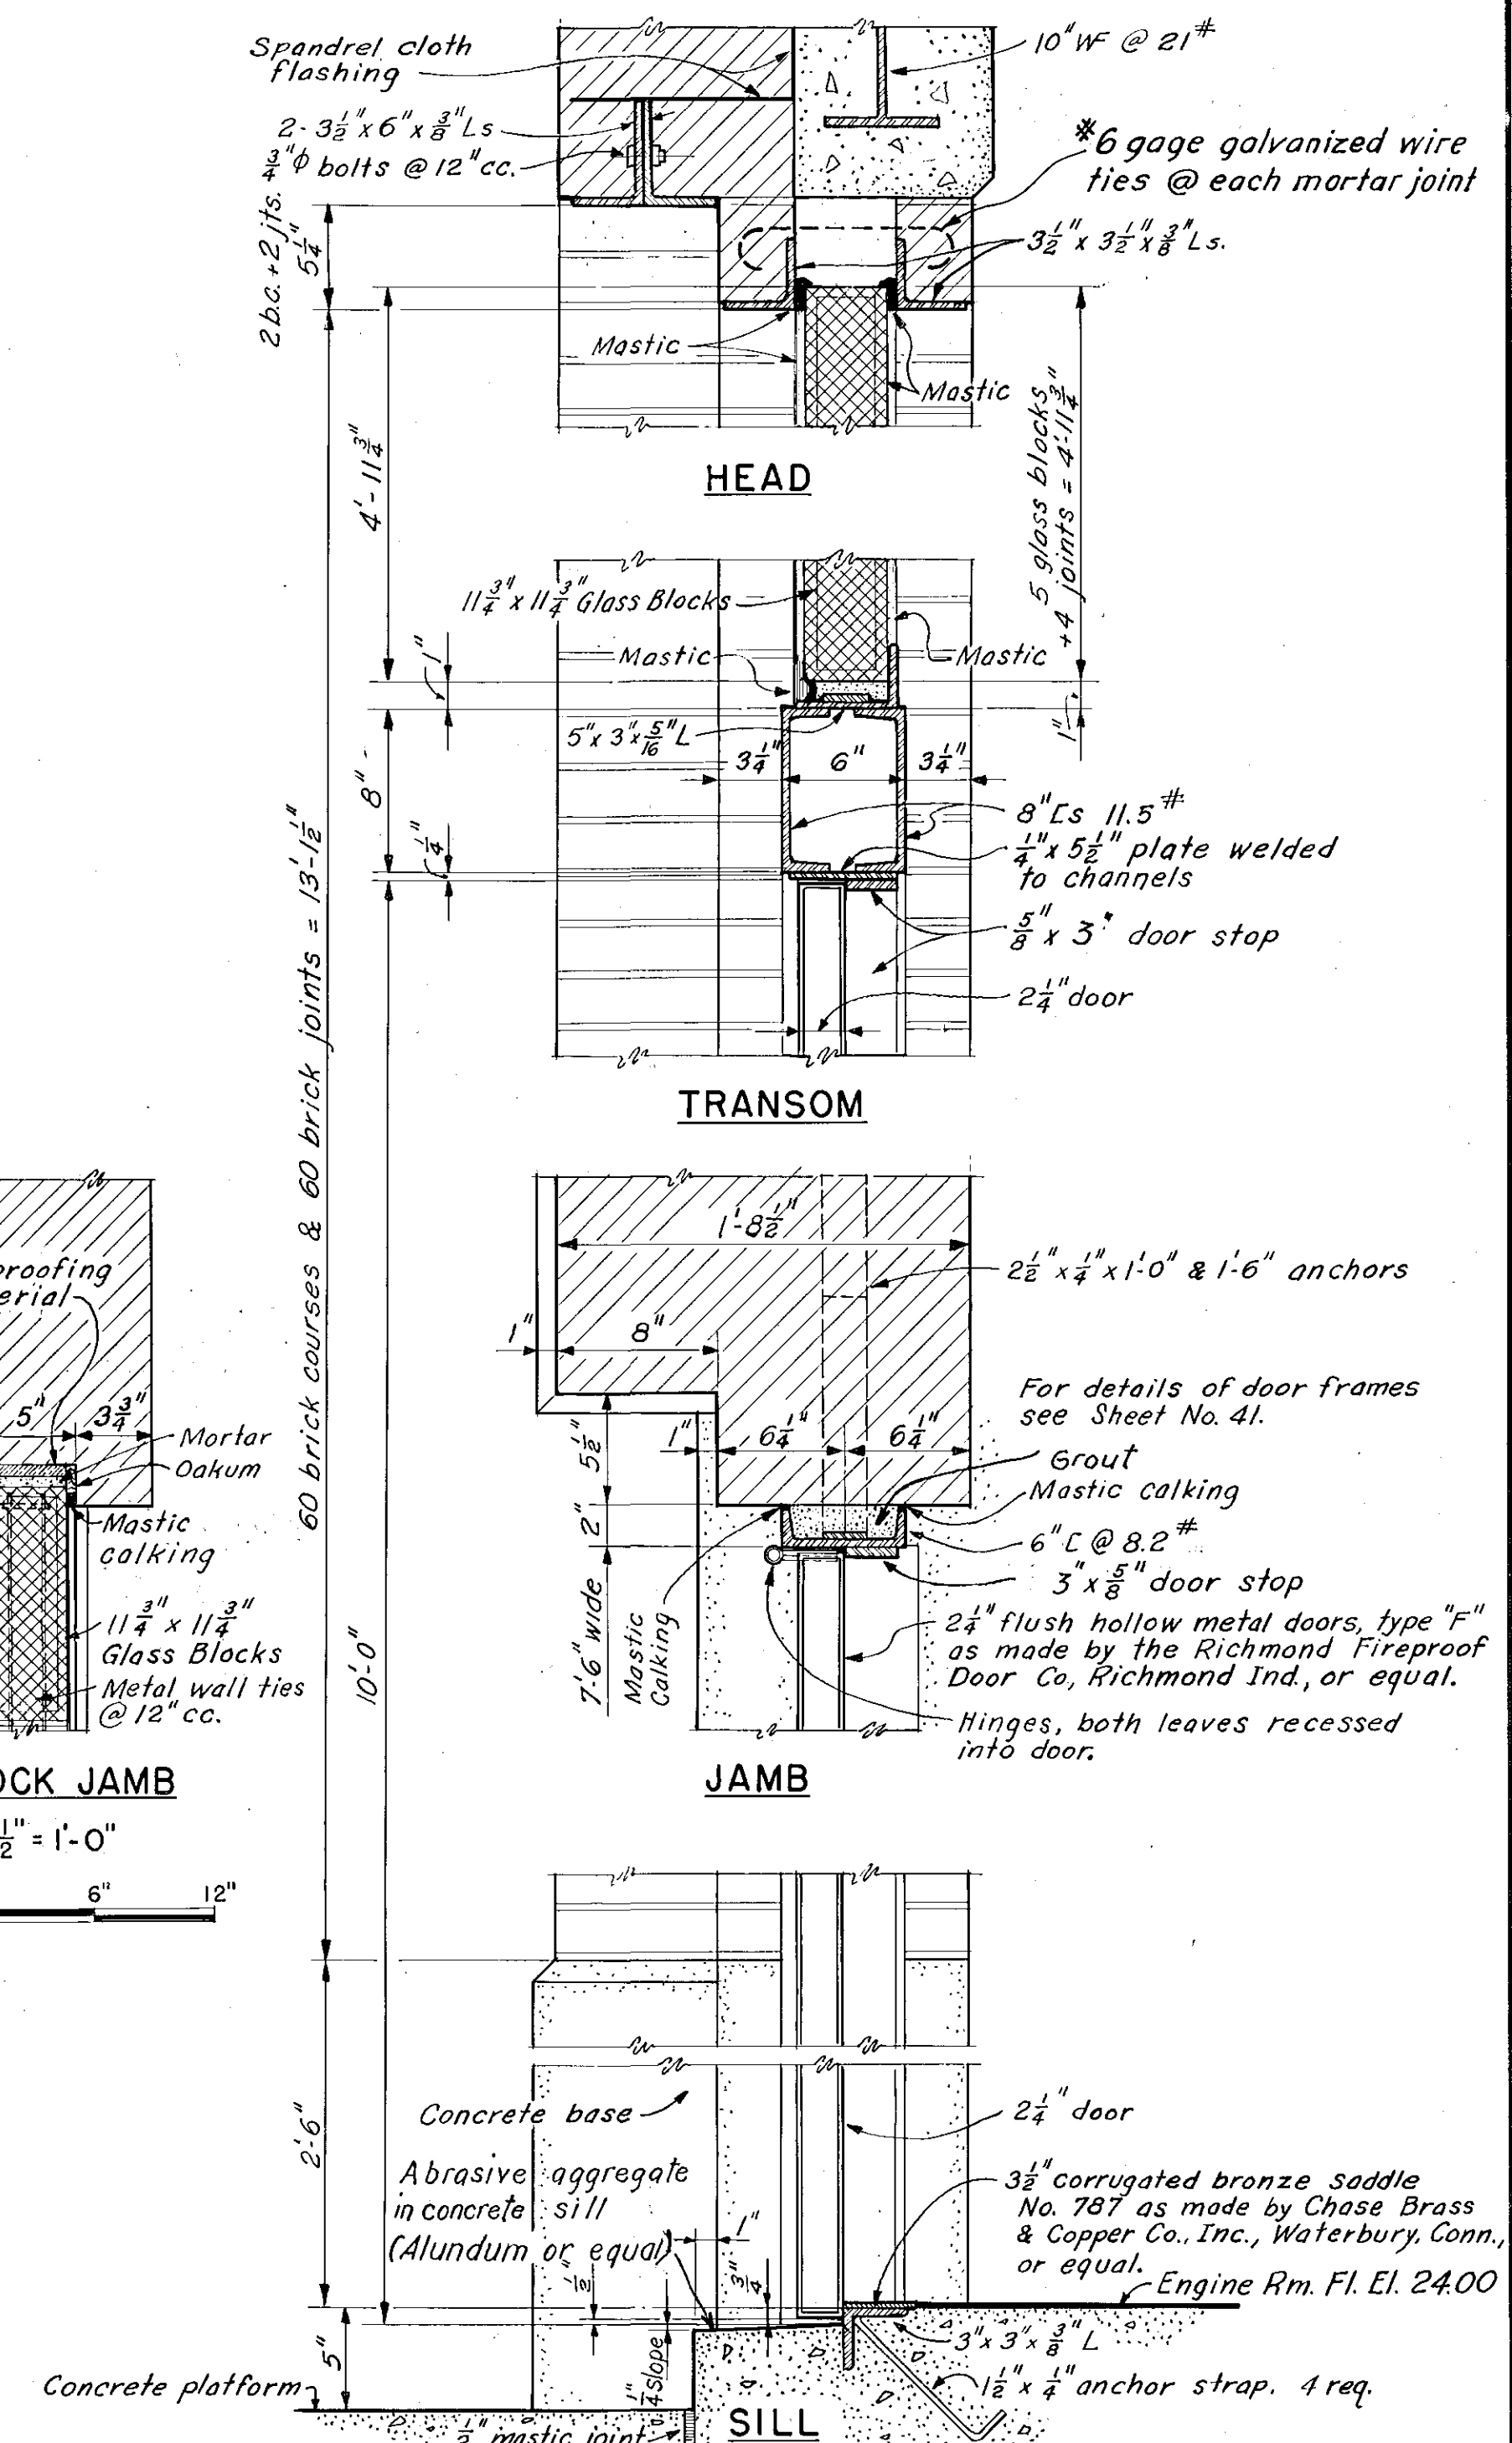
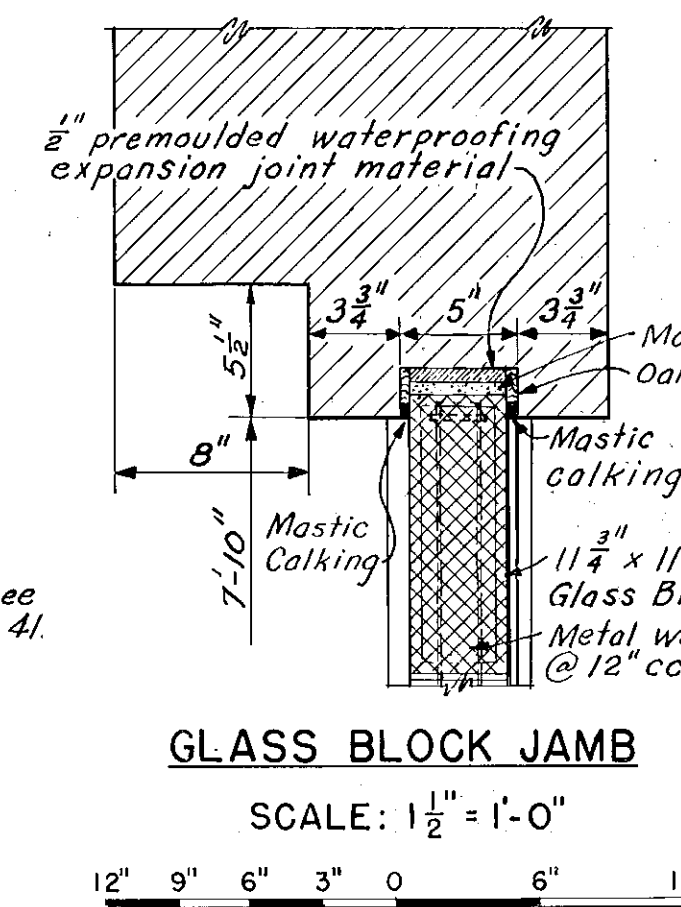
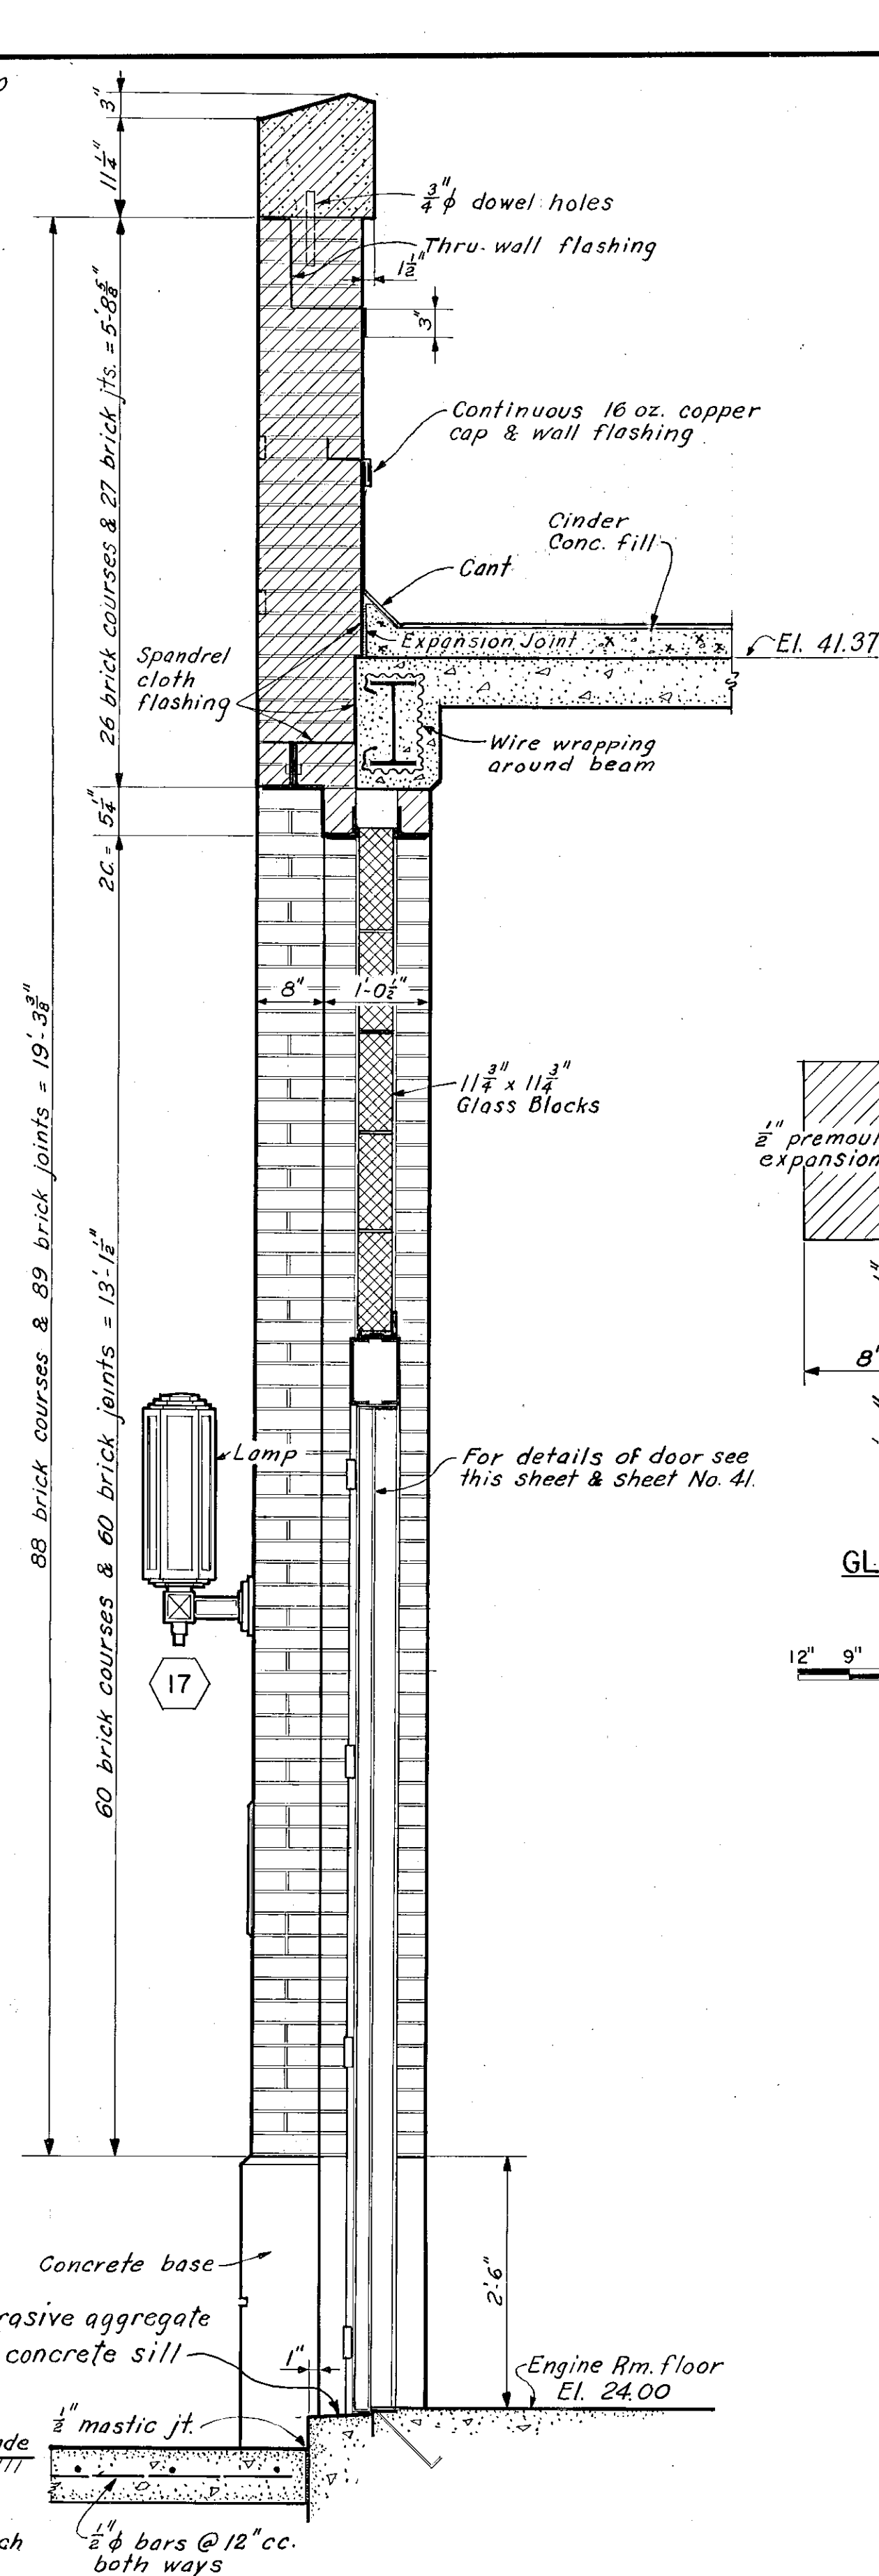
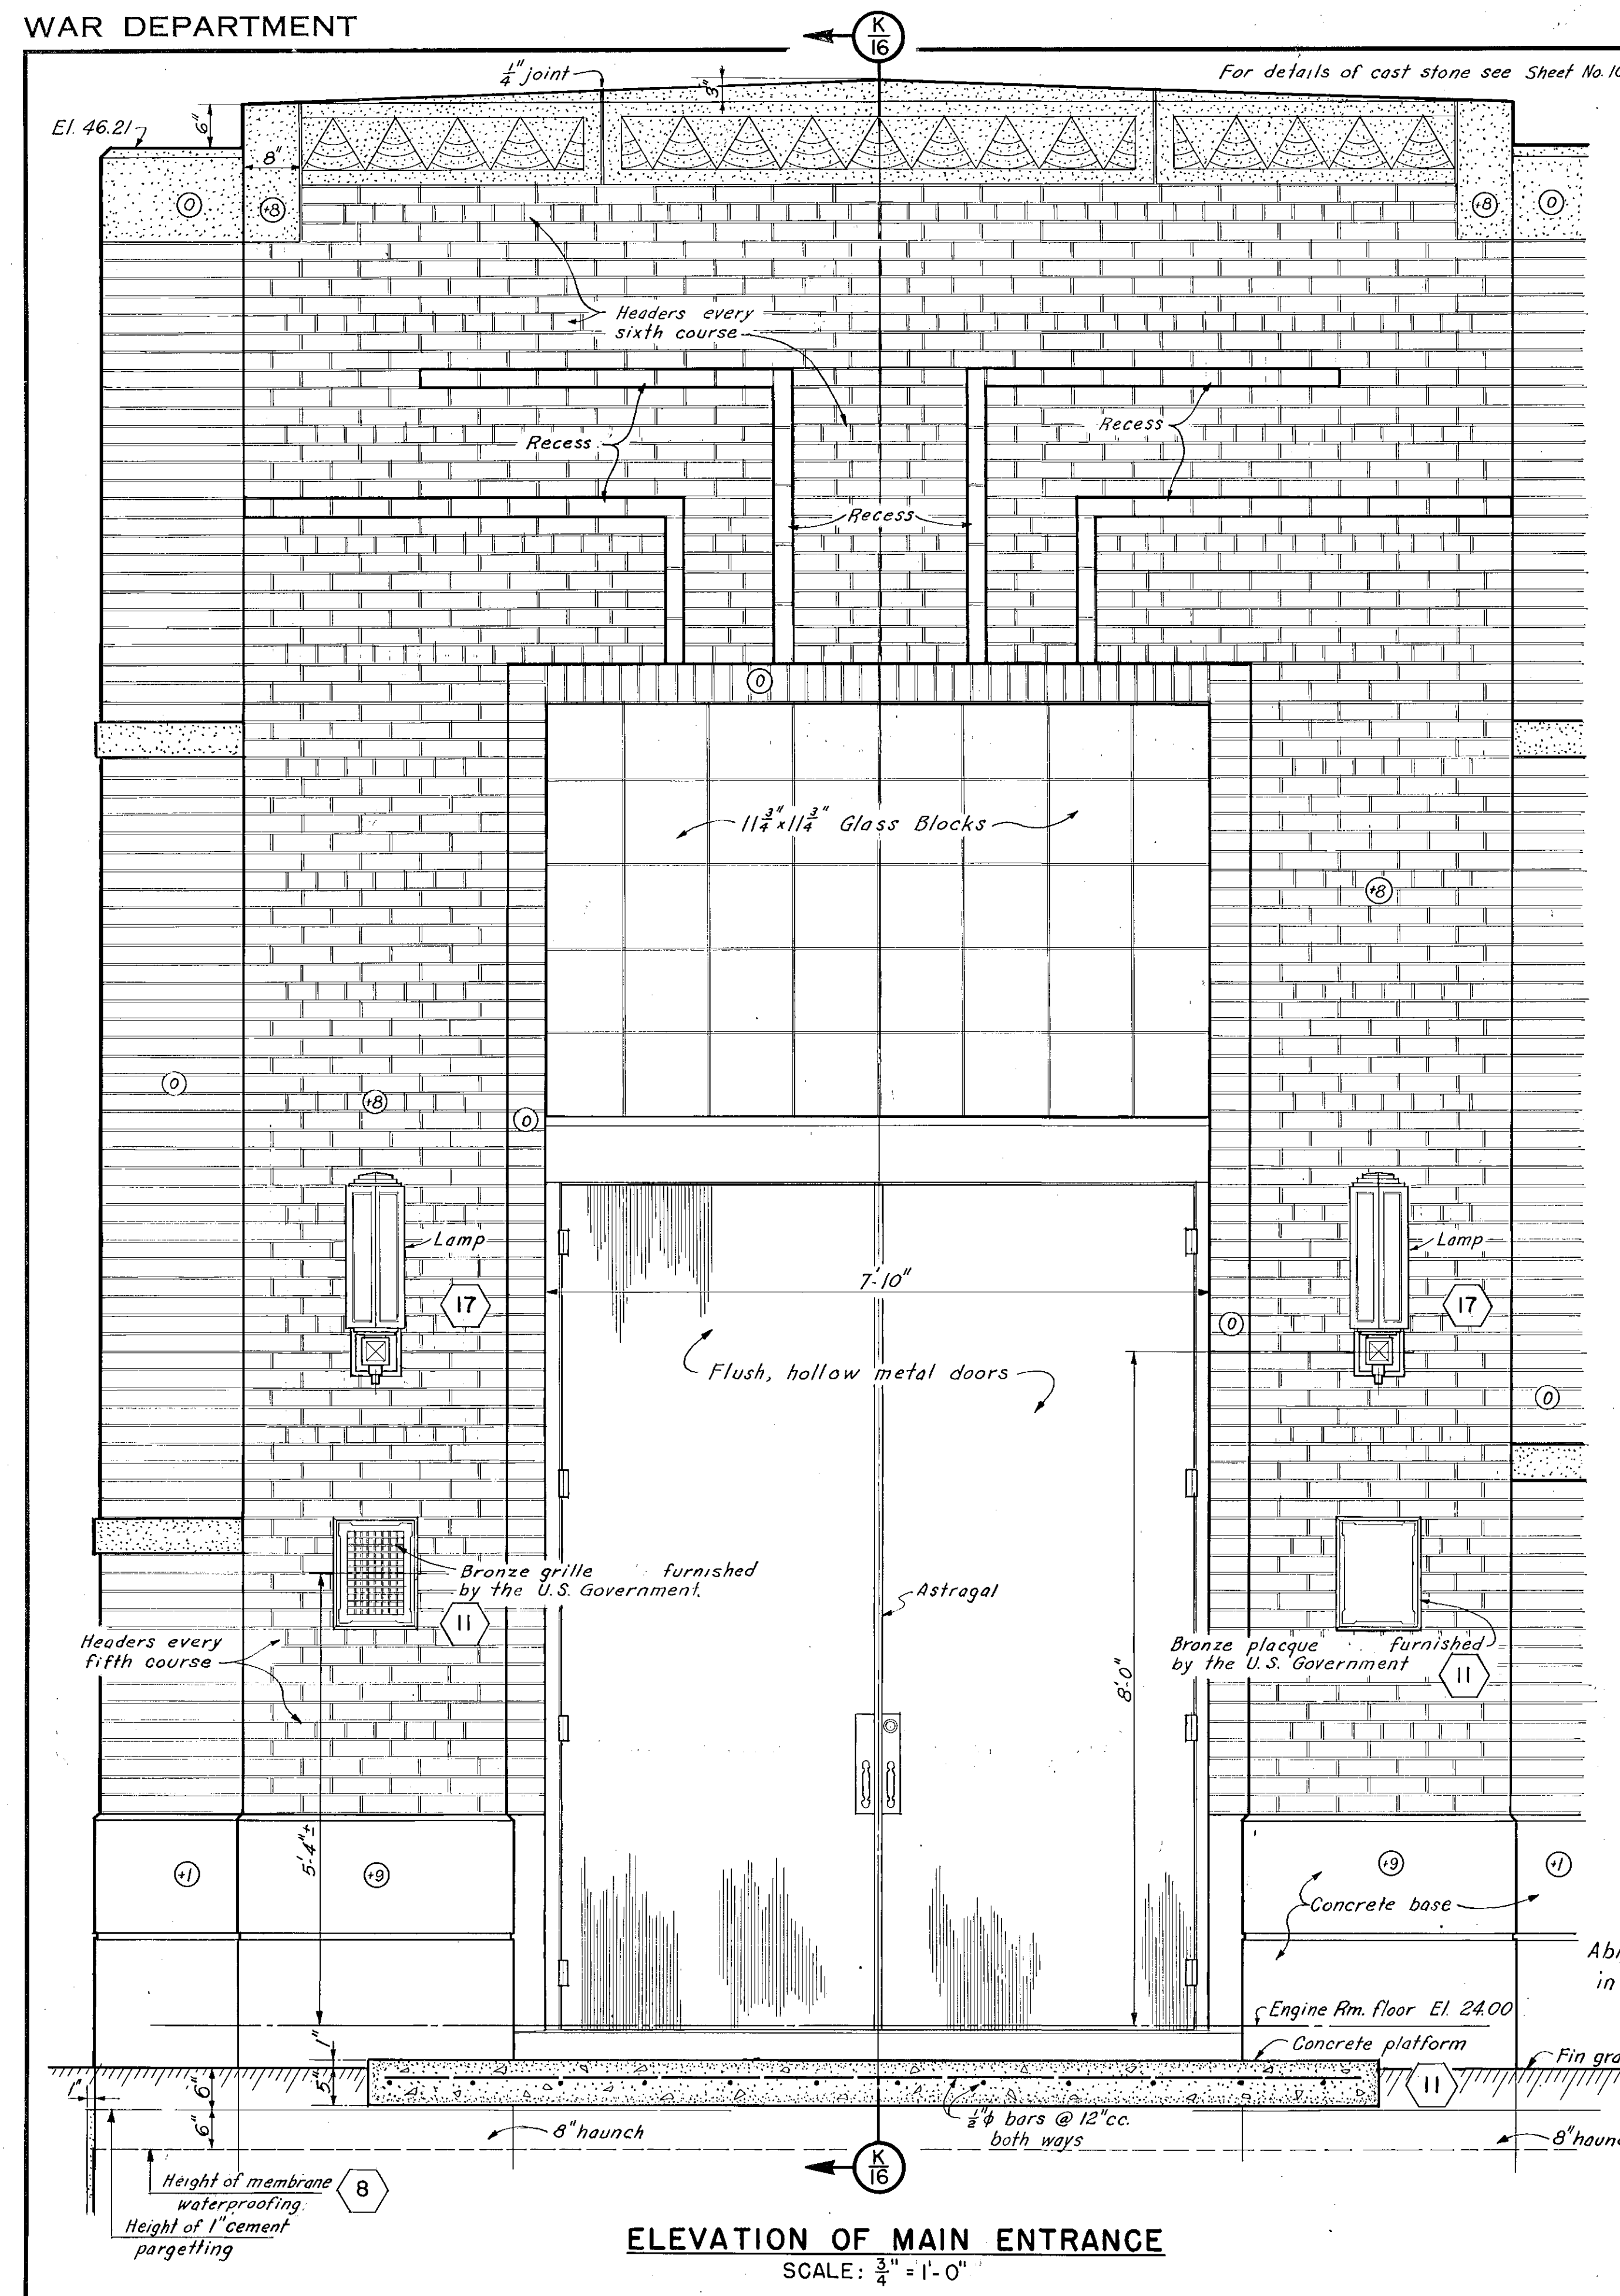


RECORD
DRAWINGSCONNECTICUT RIVER FLOOD CONTROL
KEENEY LANE PUMPING STATION
HARTFORD, CONN.MAIN ENTRANCE AND DETAILS
ARCHITECTURAL

CONNECTICUT RIVER IN 60 SHEETS SCALE: 3/4" = 1'-0" SHEET NO. 16

U.S. ENGINEER OFFICE, PROVIDENCE, R.I., JUNE 1944

SUBMITTED: *E. M. V. [Signature]* APPROVAL RECOMMENDED: *[Signature]* APPROVED: *[Signature]*
HEAD, STRUCTURAL SECTION SENIOR ENGINEER HEAD, ENGINEERING DIV. COL. CORPS OF ENGINEERS DISTRICT ENGINEERPREPARED: *J. B. Collett* DRAWN: J. S. TRACED: S.H.B. CHECKED: *[Signature]* FILE NO. CT-4-3230

KEY	DATE	REVISION (Indicated by Δ)	REV. BY	CK. BY	AP. BY