


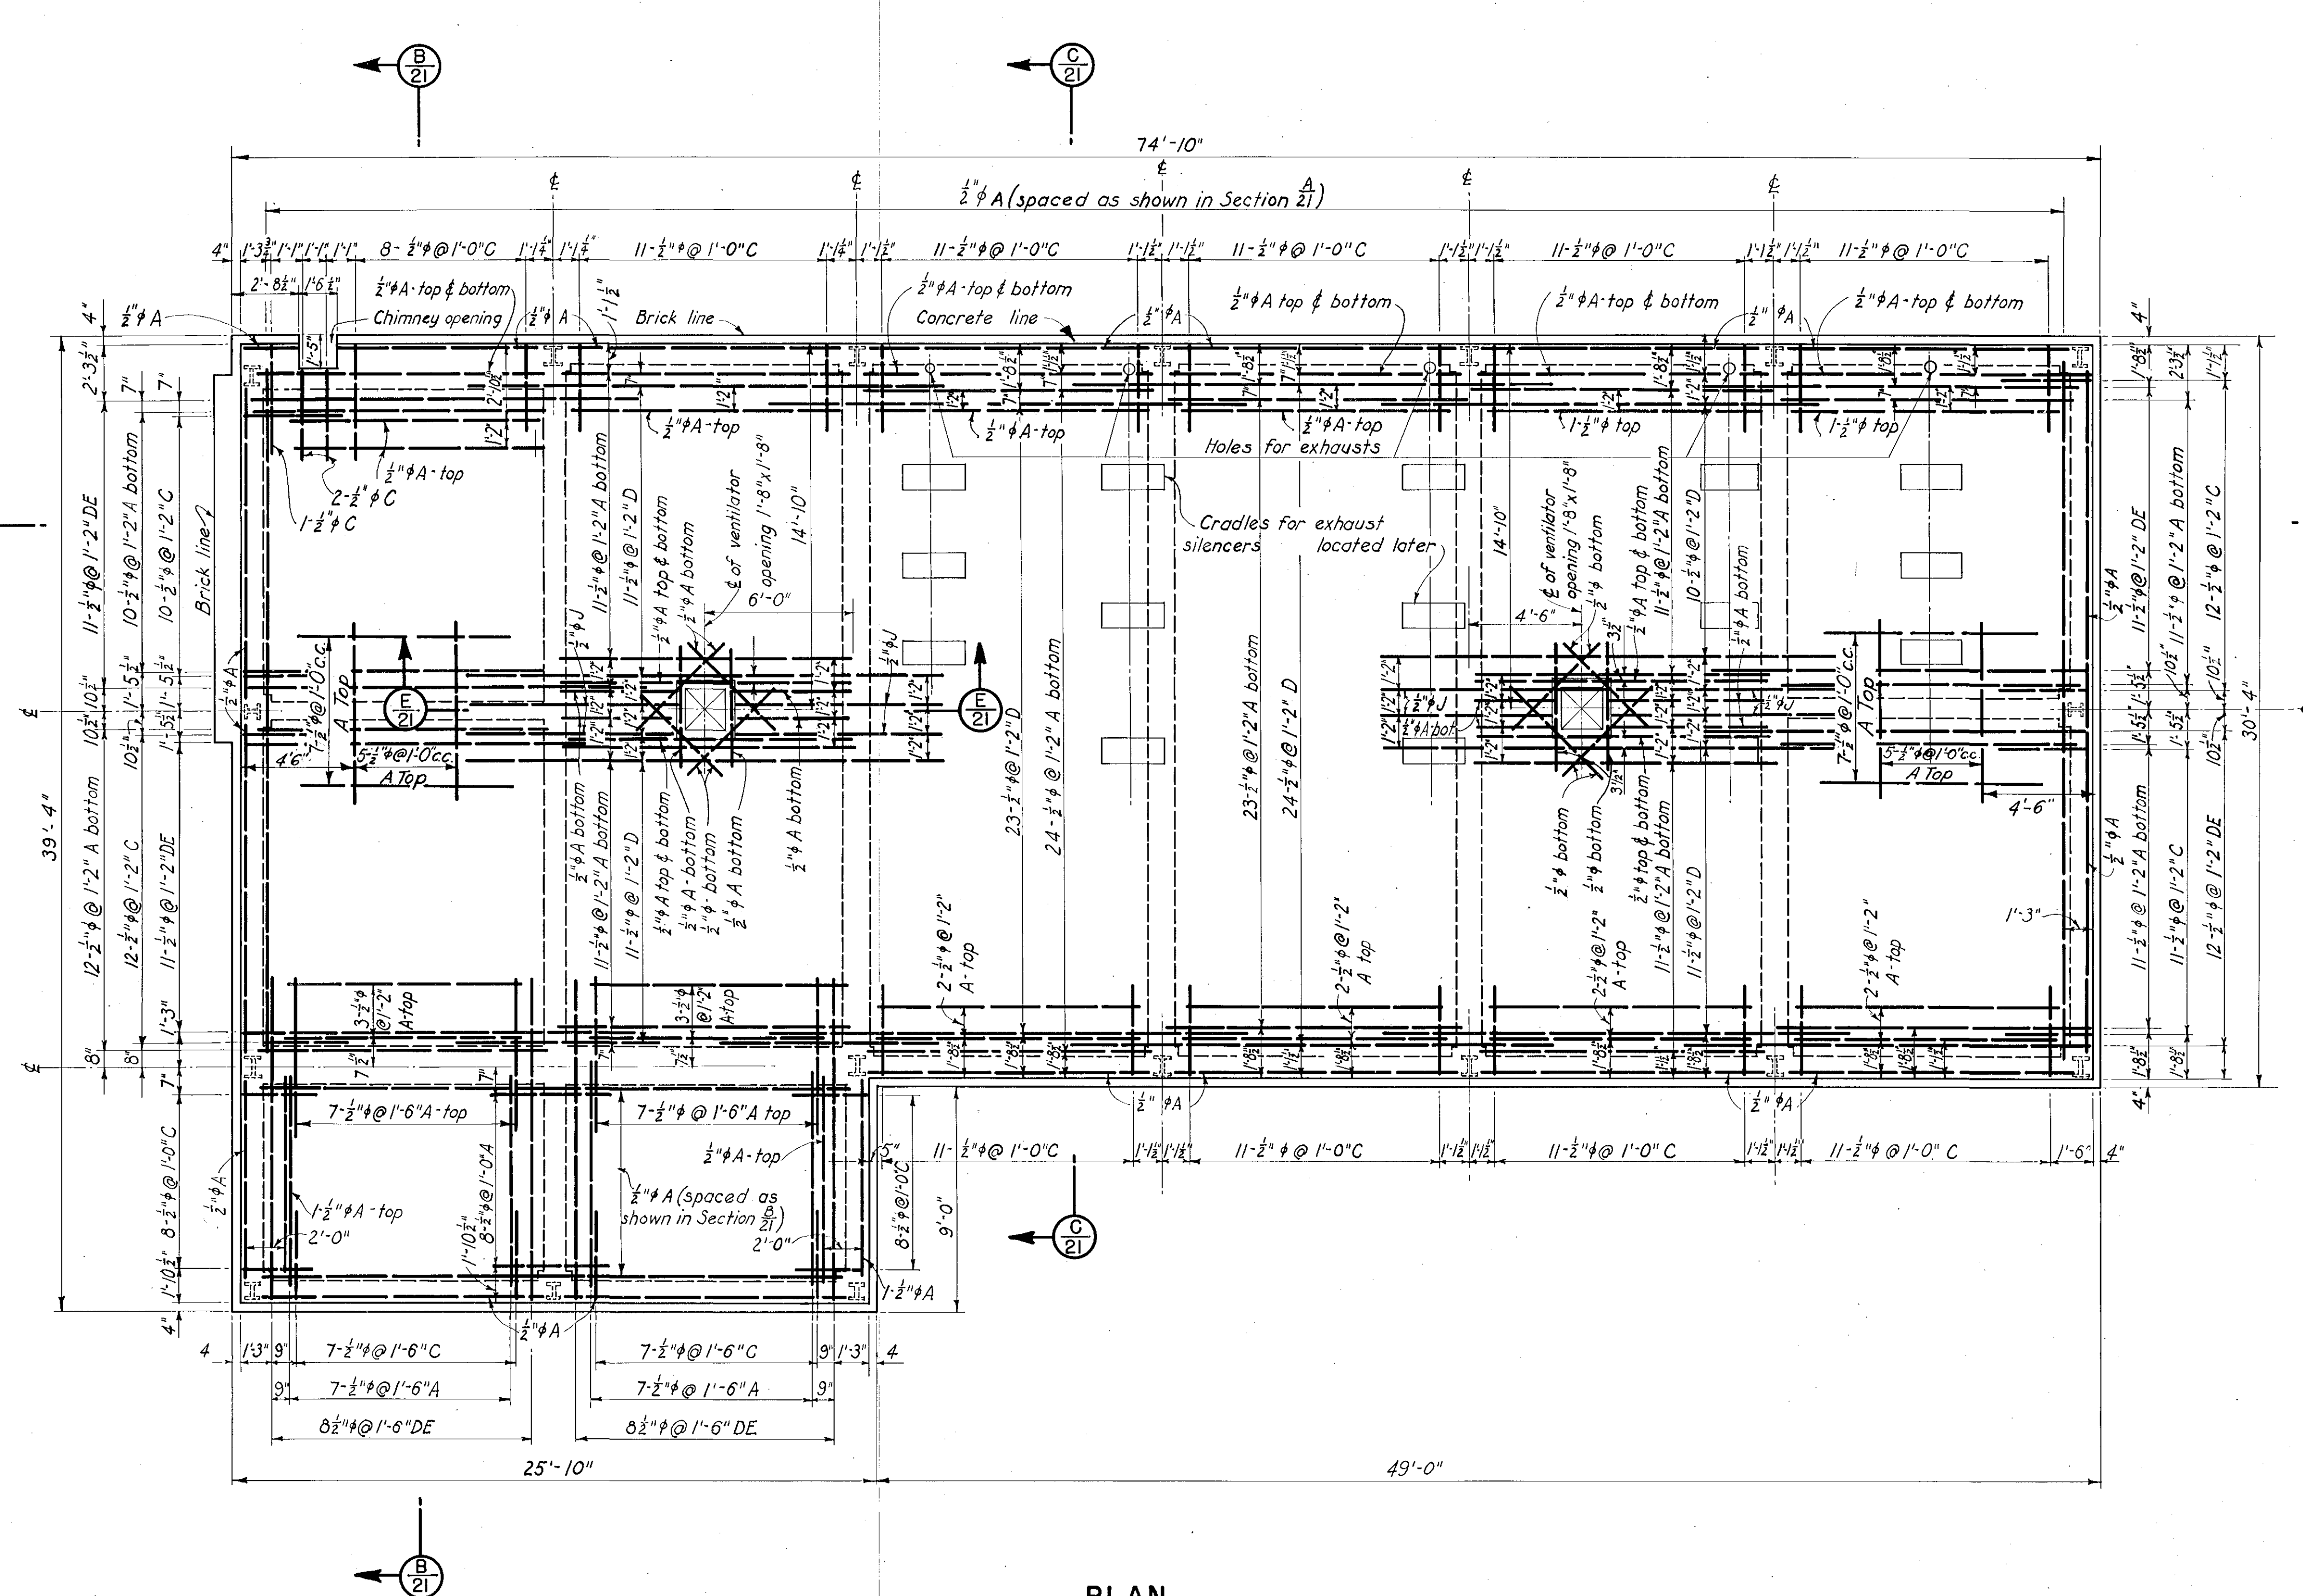

PLAN

SCALE: $\frac{1}{4}$ " = 1'-0"

NOTES:

- For general notes applying to this sheet, see sheet No. 22.
- For steel reinforcement bending key, see sheet No. 27.
- Concrete and steel reinforcement in roof slab were paid for under Item No. 11.
- For size and number of dowels in roof slab, and exhaust silencer cradles, see sheet No. 45.

RECORD
DRAWINGSCONNECTICUT RIVER FLOOD CONTROL
KEENEY LANE PUMPING STATION
HARTFORD, CONN.ROOF SLAB
STEEL REINFORCEMENT NO. 1

CONNECTICUT RIVER IN 60 SHEETS SCALE: 1/4" = 1 FT. CONNECTICUT SHEET NO. 20

U.S. ENGINEER OFFICE, PROVIDENCE, R.I., JUNE 1944

SUBMITTED:	APPROVAL RECOMMENDED:	APPROVED:
E. M. Viner	J. B. Burns	J. B. Burns
SENIOR ENGINEER	HEAD, ENGINEERING DIV.	CHIEF, ENGINEERING DIV.
HEAD, STRUCTURAL SECTION		DISTRICT ENGINEER

PREPARED:	DRAWN: N.I.	FILE NO. CT-4-3234
H. C. Whitmore	TRACED: D. G. O'R.	
STRUCTURAL SUBSECTION	CHECKED: A.L.K.	

KEY	DATE	REVISION (Indicated by Δ)	REV. BY	CK. BY	AP. BY