
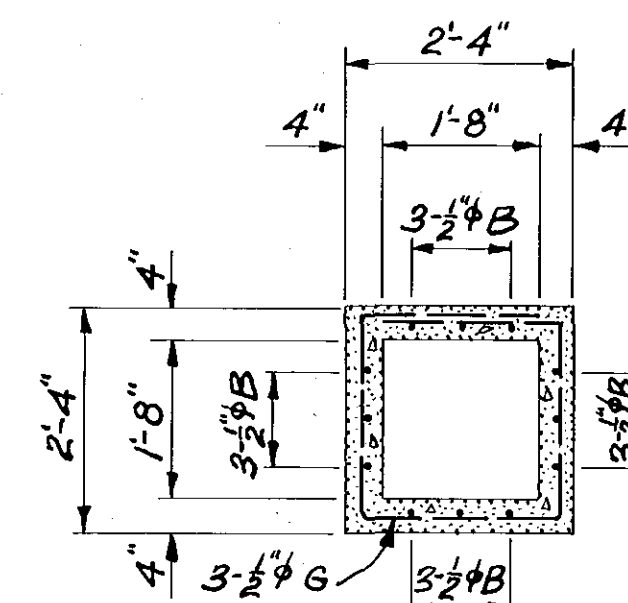
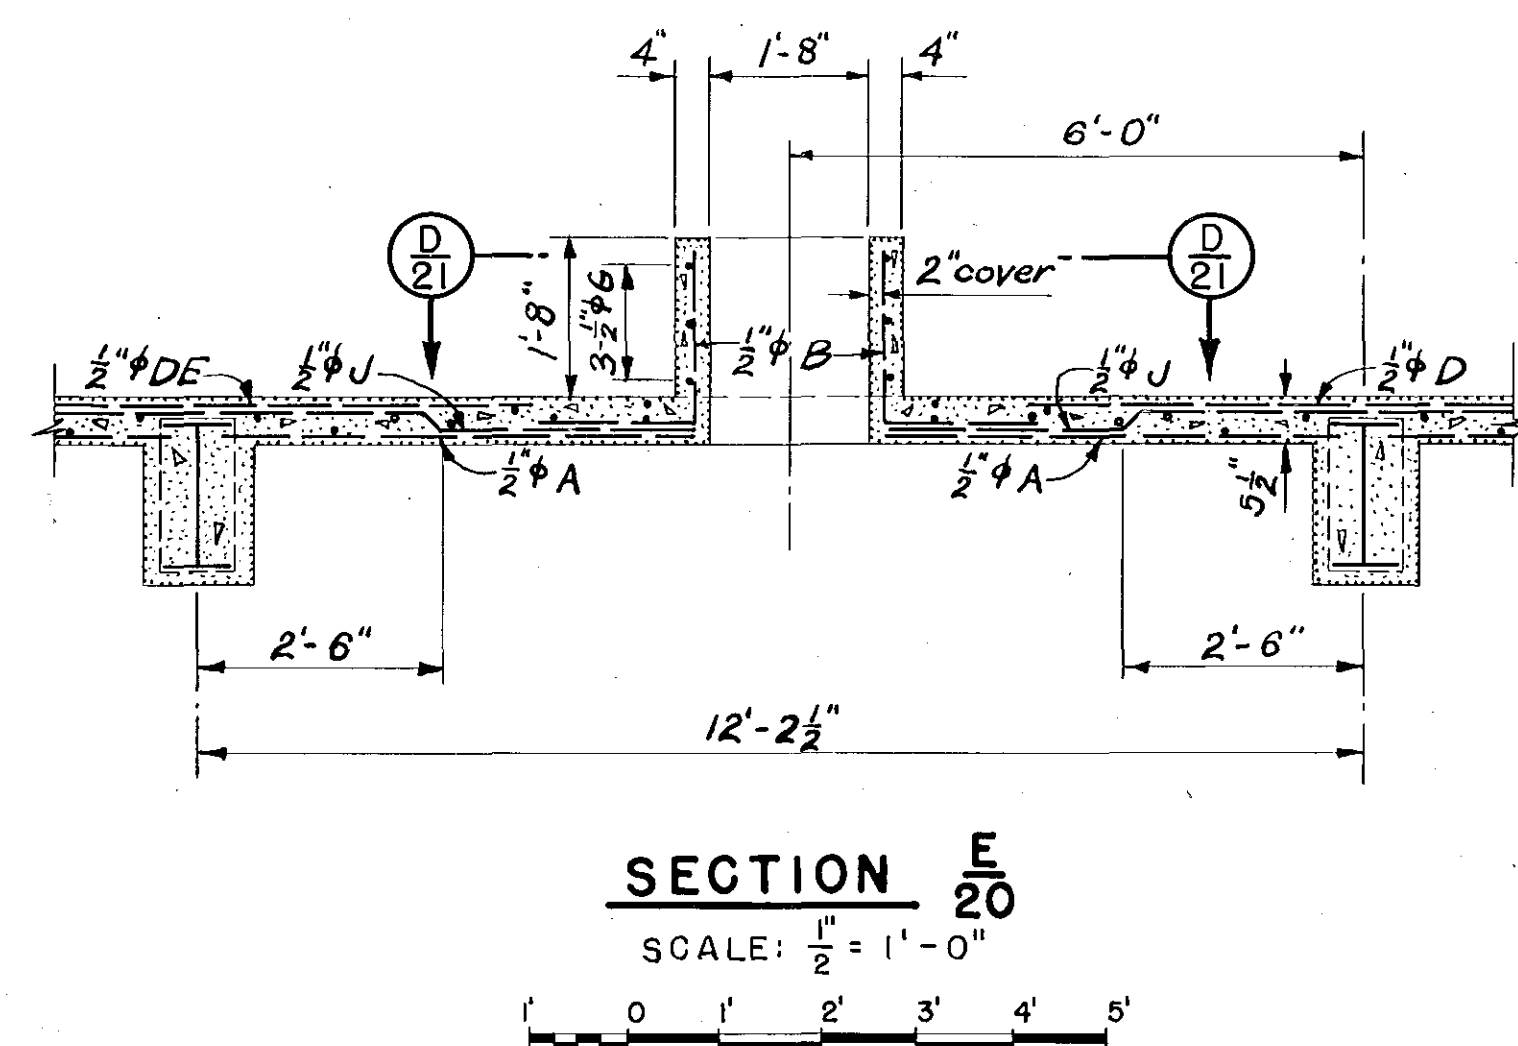
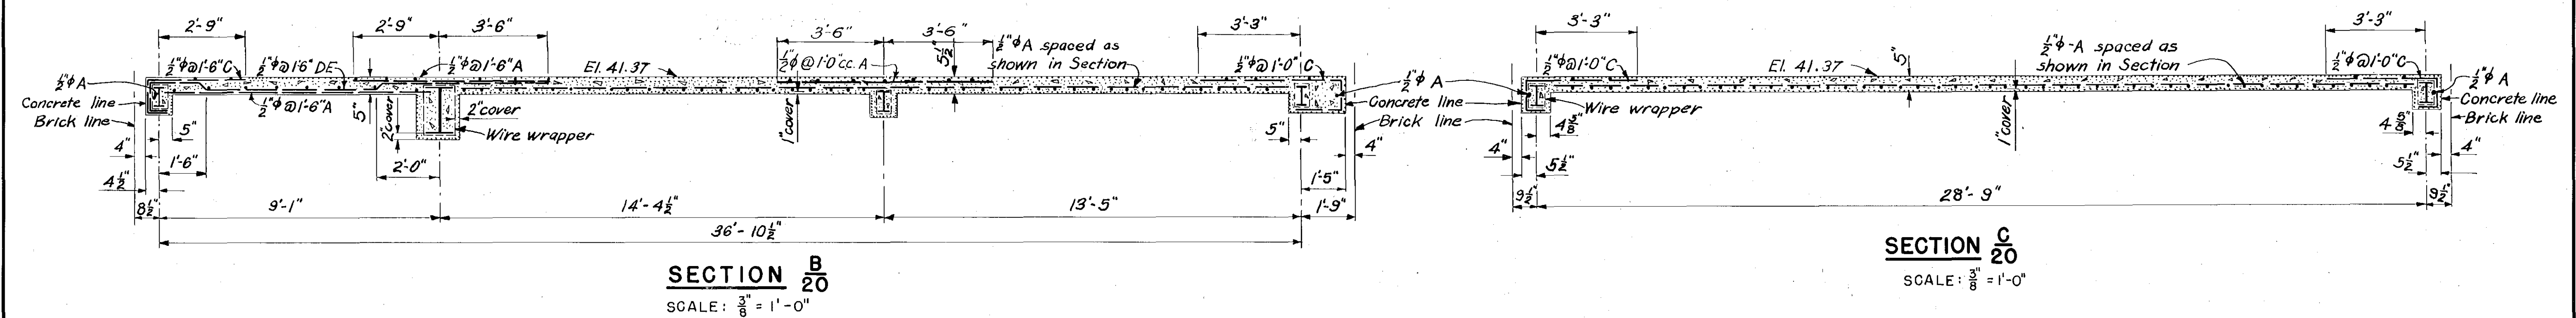


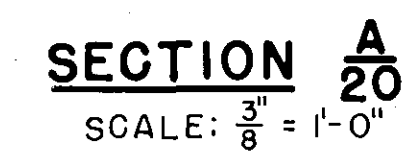

NOTES:
For general notes applying to this sheet, see Sheet No. 22
For steel reinforcement bending key, see Sheet No. 27
All beams are wrapped with wire wrapper

RECORD
DRAWINGS

CONNECTICUT RIVER			FLOOD CONTROL		
KEENEY LANE PUMPING STATION					
HARTFORD, CONN.					
ROOF SLAB					
STEEL REINFORCEMENT				NO. 2	
CONNECTICUT RIVER			CONNECTICUT		
IN 60 SHEETS		SCALE: 3/8" = 1 FT.		SHEET NO. 21	
U. S. ENGINEER OFFICE, PROVIDENCE, R.I., JUNE 1944					
SUBMITTED:		APPROVAL RECOMMENDED:		APPROVED:	
E. M. Usher		J. B. Burns		A. J. Burns	
SENIOR ENGINEER		HEAD ENGINEER		COL. CORPS OF U. S. ENGINEERS	
HEAD, STRUCTURAL SECTION		CHIEF, ENGINEERING DIV.		DISTRICT ENGINEER	
PREPARED:		DRAWN:		FILE NO. CT-4-3235	
A. C. Whittemore		TRACED: R.D.A.			
STRUCTURAL SUBSECTION		CHECKED: A.L.K.			

KEY	DATE	REVISION (Indicated by Δ)	REV. BY	CK. BY	AP. BY