




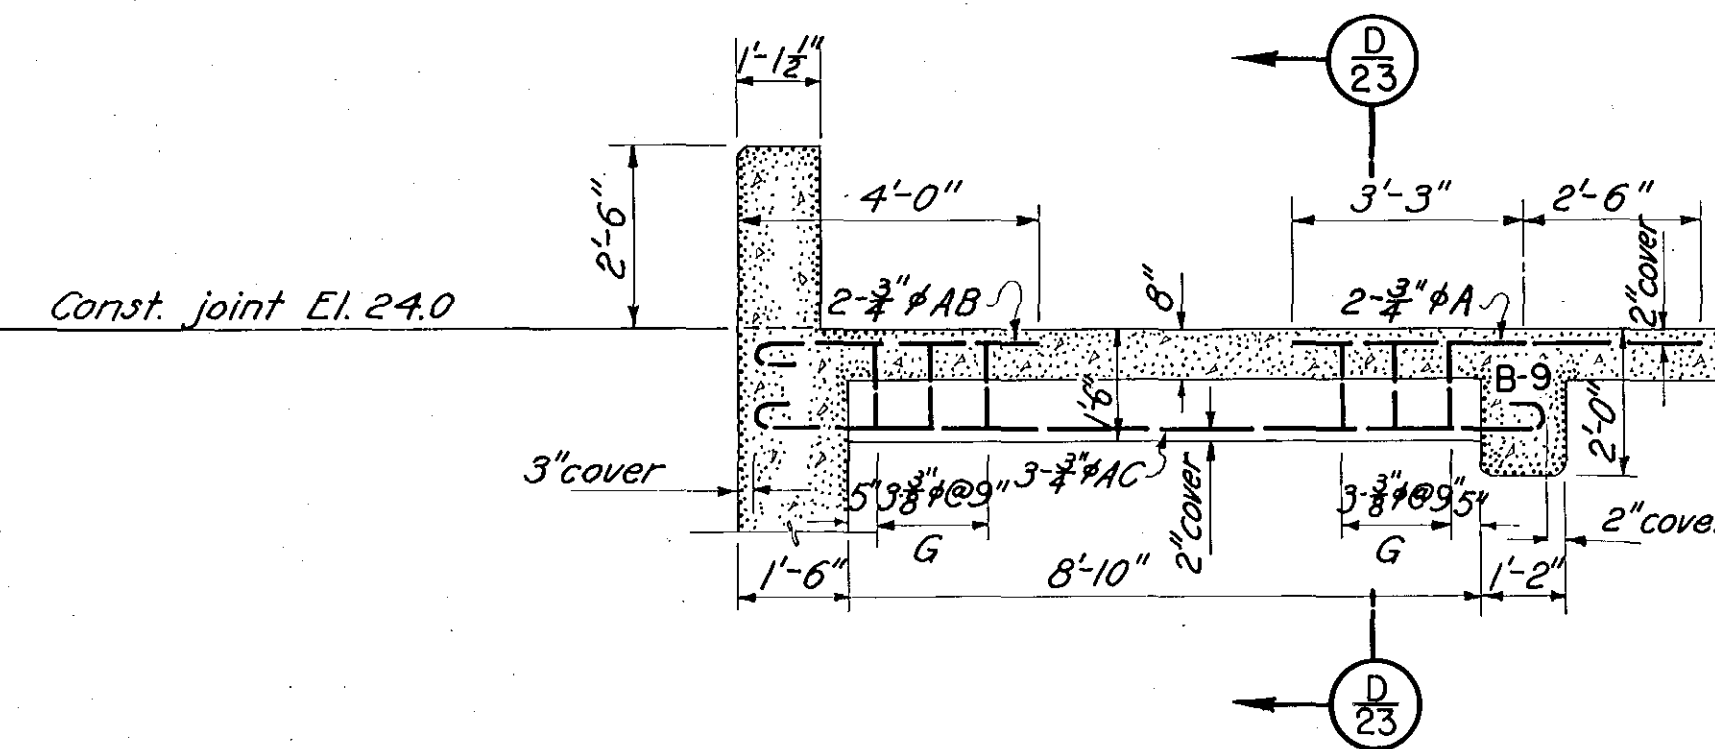


BEAM B-11

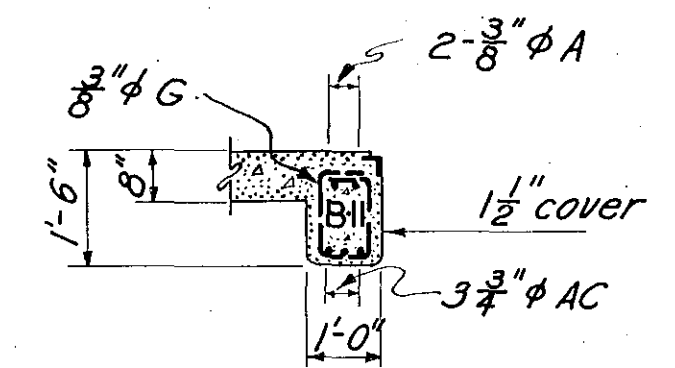


SECTION $\frac{D}{23}$

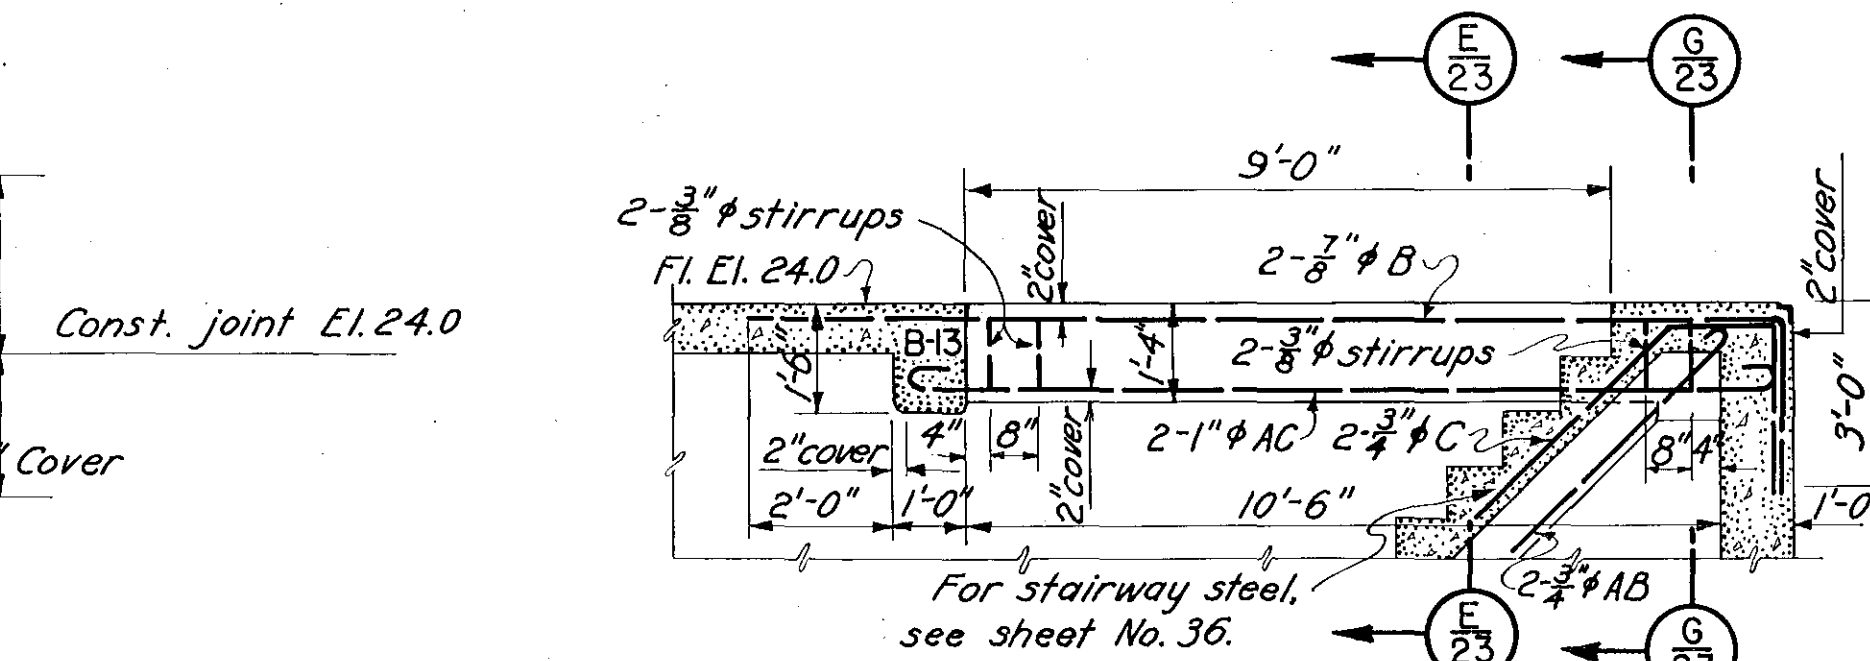


BEAM B-12

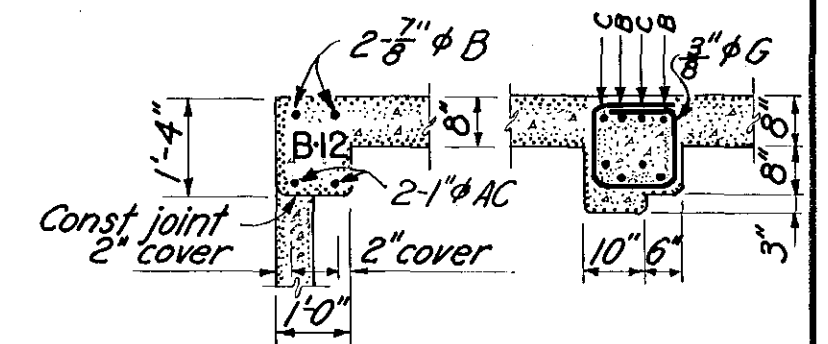


SECTION E SECTION G
23 23

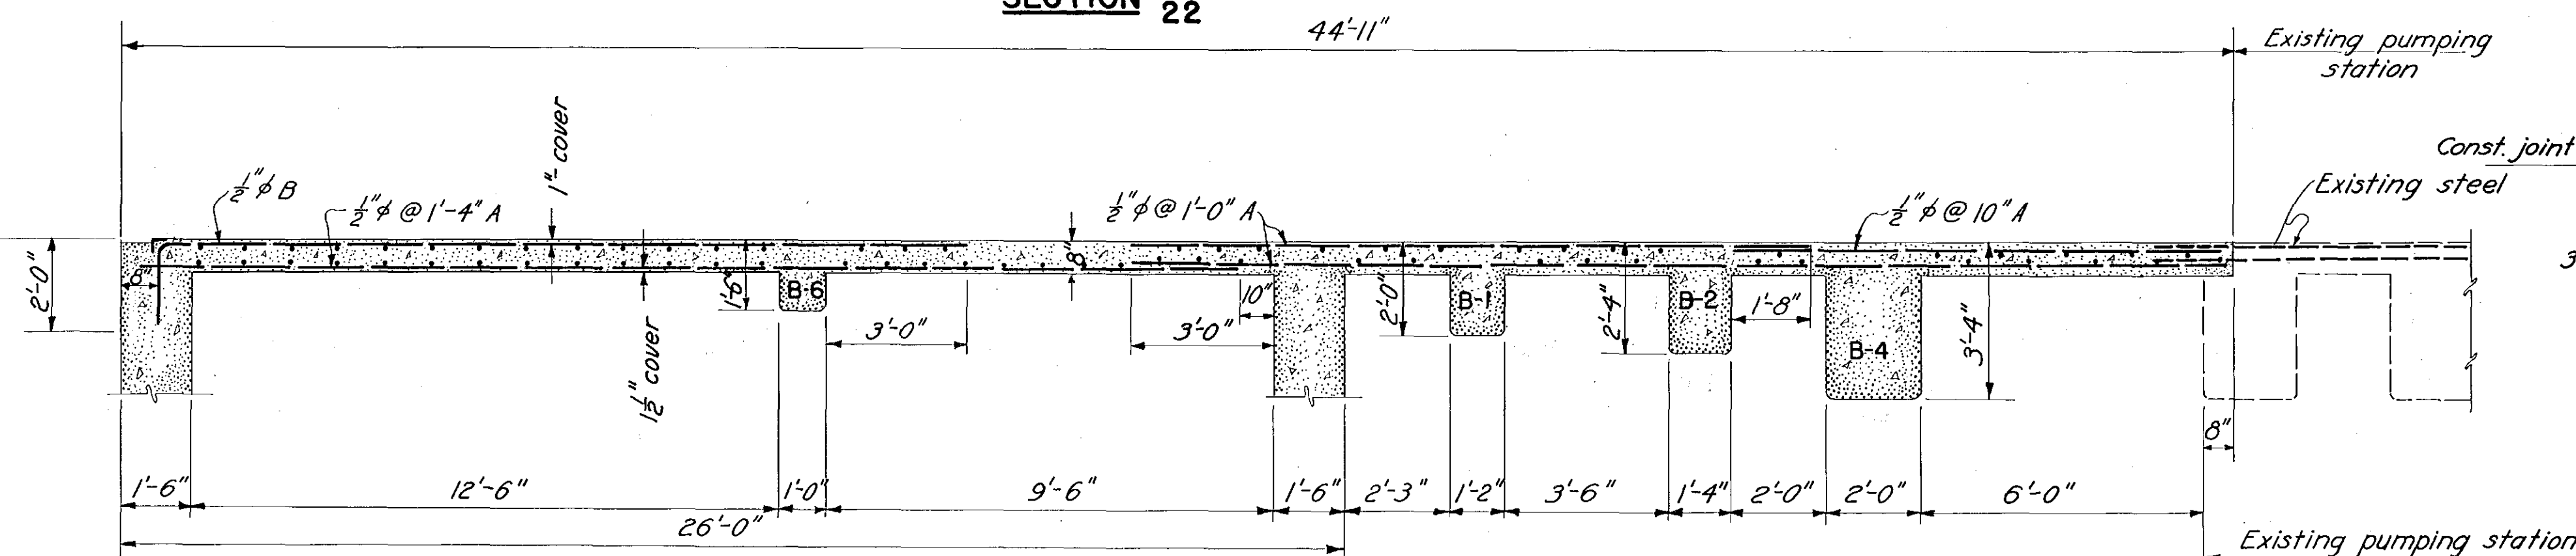

SECTION $\frac{C}{22}$

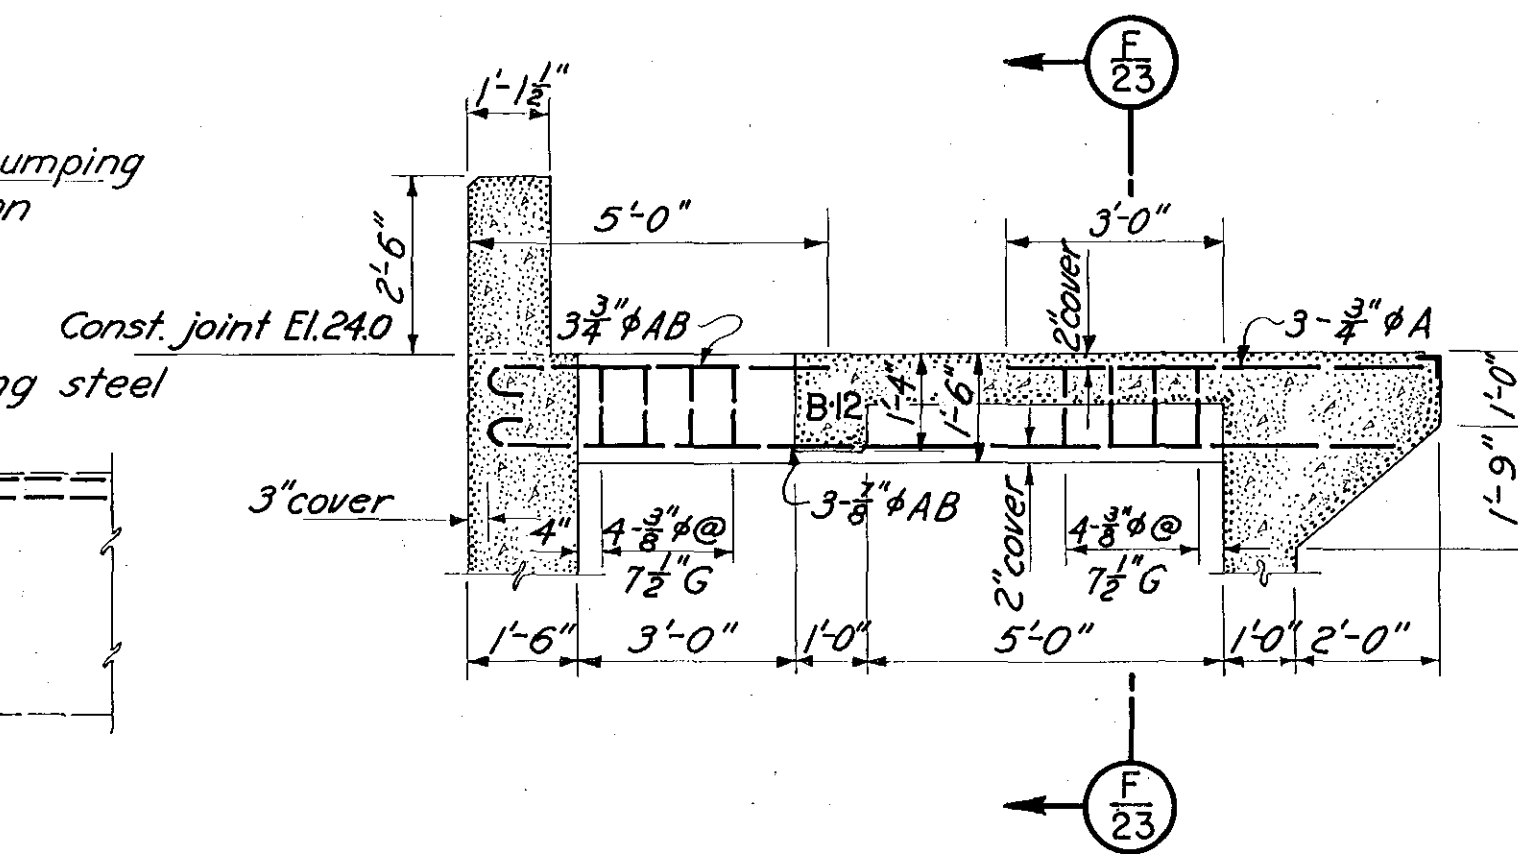

BEAM B-13

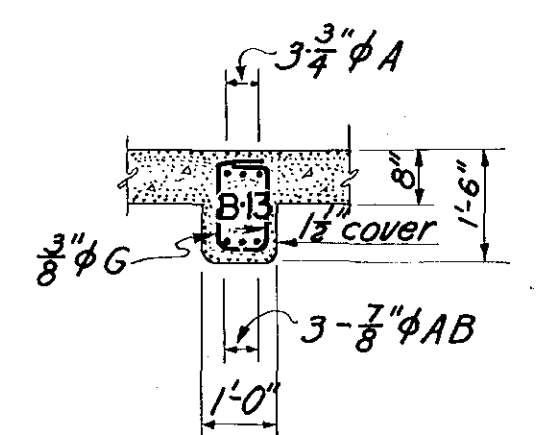

SECTION $\frac{F}{23}$

RECORD
DRAWINGS

CONNECTICUT RIVER FLOOD CONTROL	
KEENEY LANE PUMPING STATION HARTFORD, CONN. ENGINE ROOM FLOOR SLAB STEEL REINFORCEMENT NO. 2	
CONNECTICUT RIVER	CONNECTICUT
IN 60 SHEETS	SHEET NO 23
SCALE 3/8 IN. = 1 FT. 	
U.S. ENGINEER OFFICE PROVIDENCE. R.I. JUNE 1944	
SUBMITTED: <i>E. M. Viner</i> SENIOR ENGINEER HEAD, STRUCTURAL SECTION	APPROVAL RECOMMENDED: <i>W. L. Burns</i> CHIEF ENGINEER DIV. OF ENGINEERING COL. CORPS OF ENGINEERS
PREPARED: <i>H. C. Whitmore</i> STRUCTURAL SUBSECTION	DRAWN: R. L. L. & N. I. TRACED: A. B. CHECKED: C. D. H. FILE NO. CT-4-3237

KEY	DATE	REVISION (Indicated by Δ)	REV. BY	CK BY	AP BY