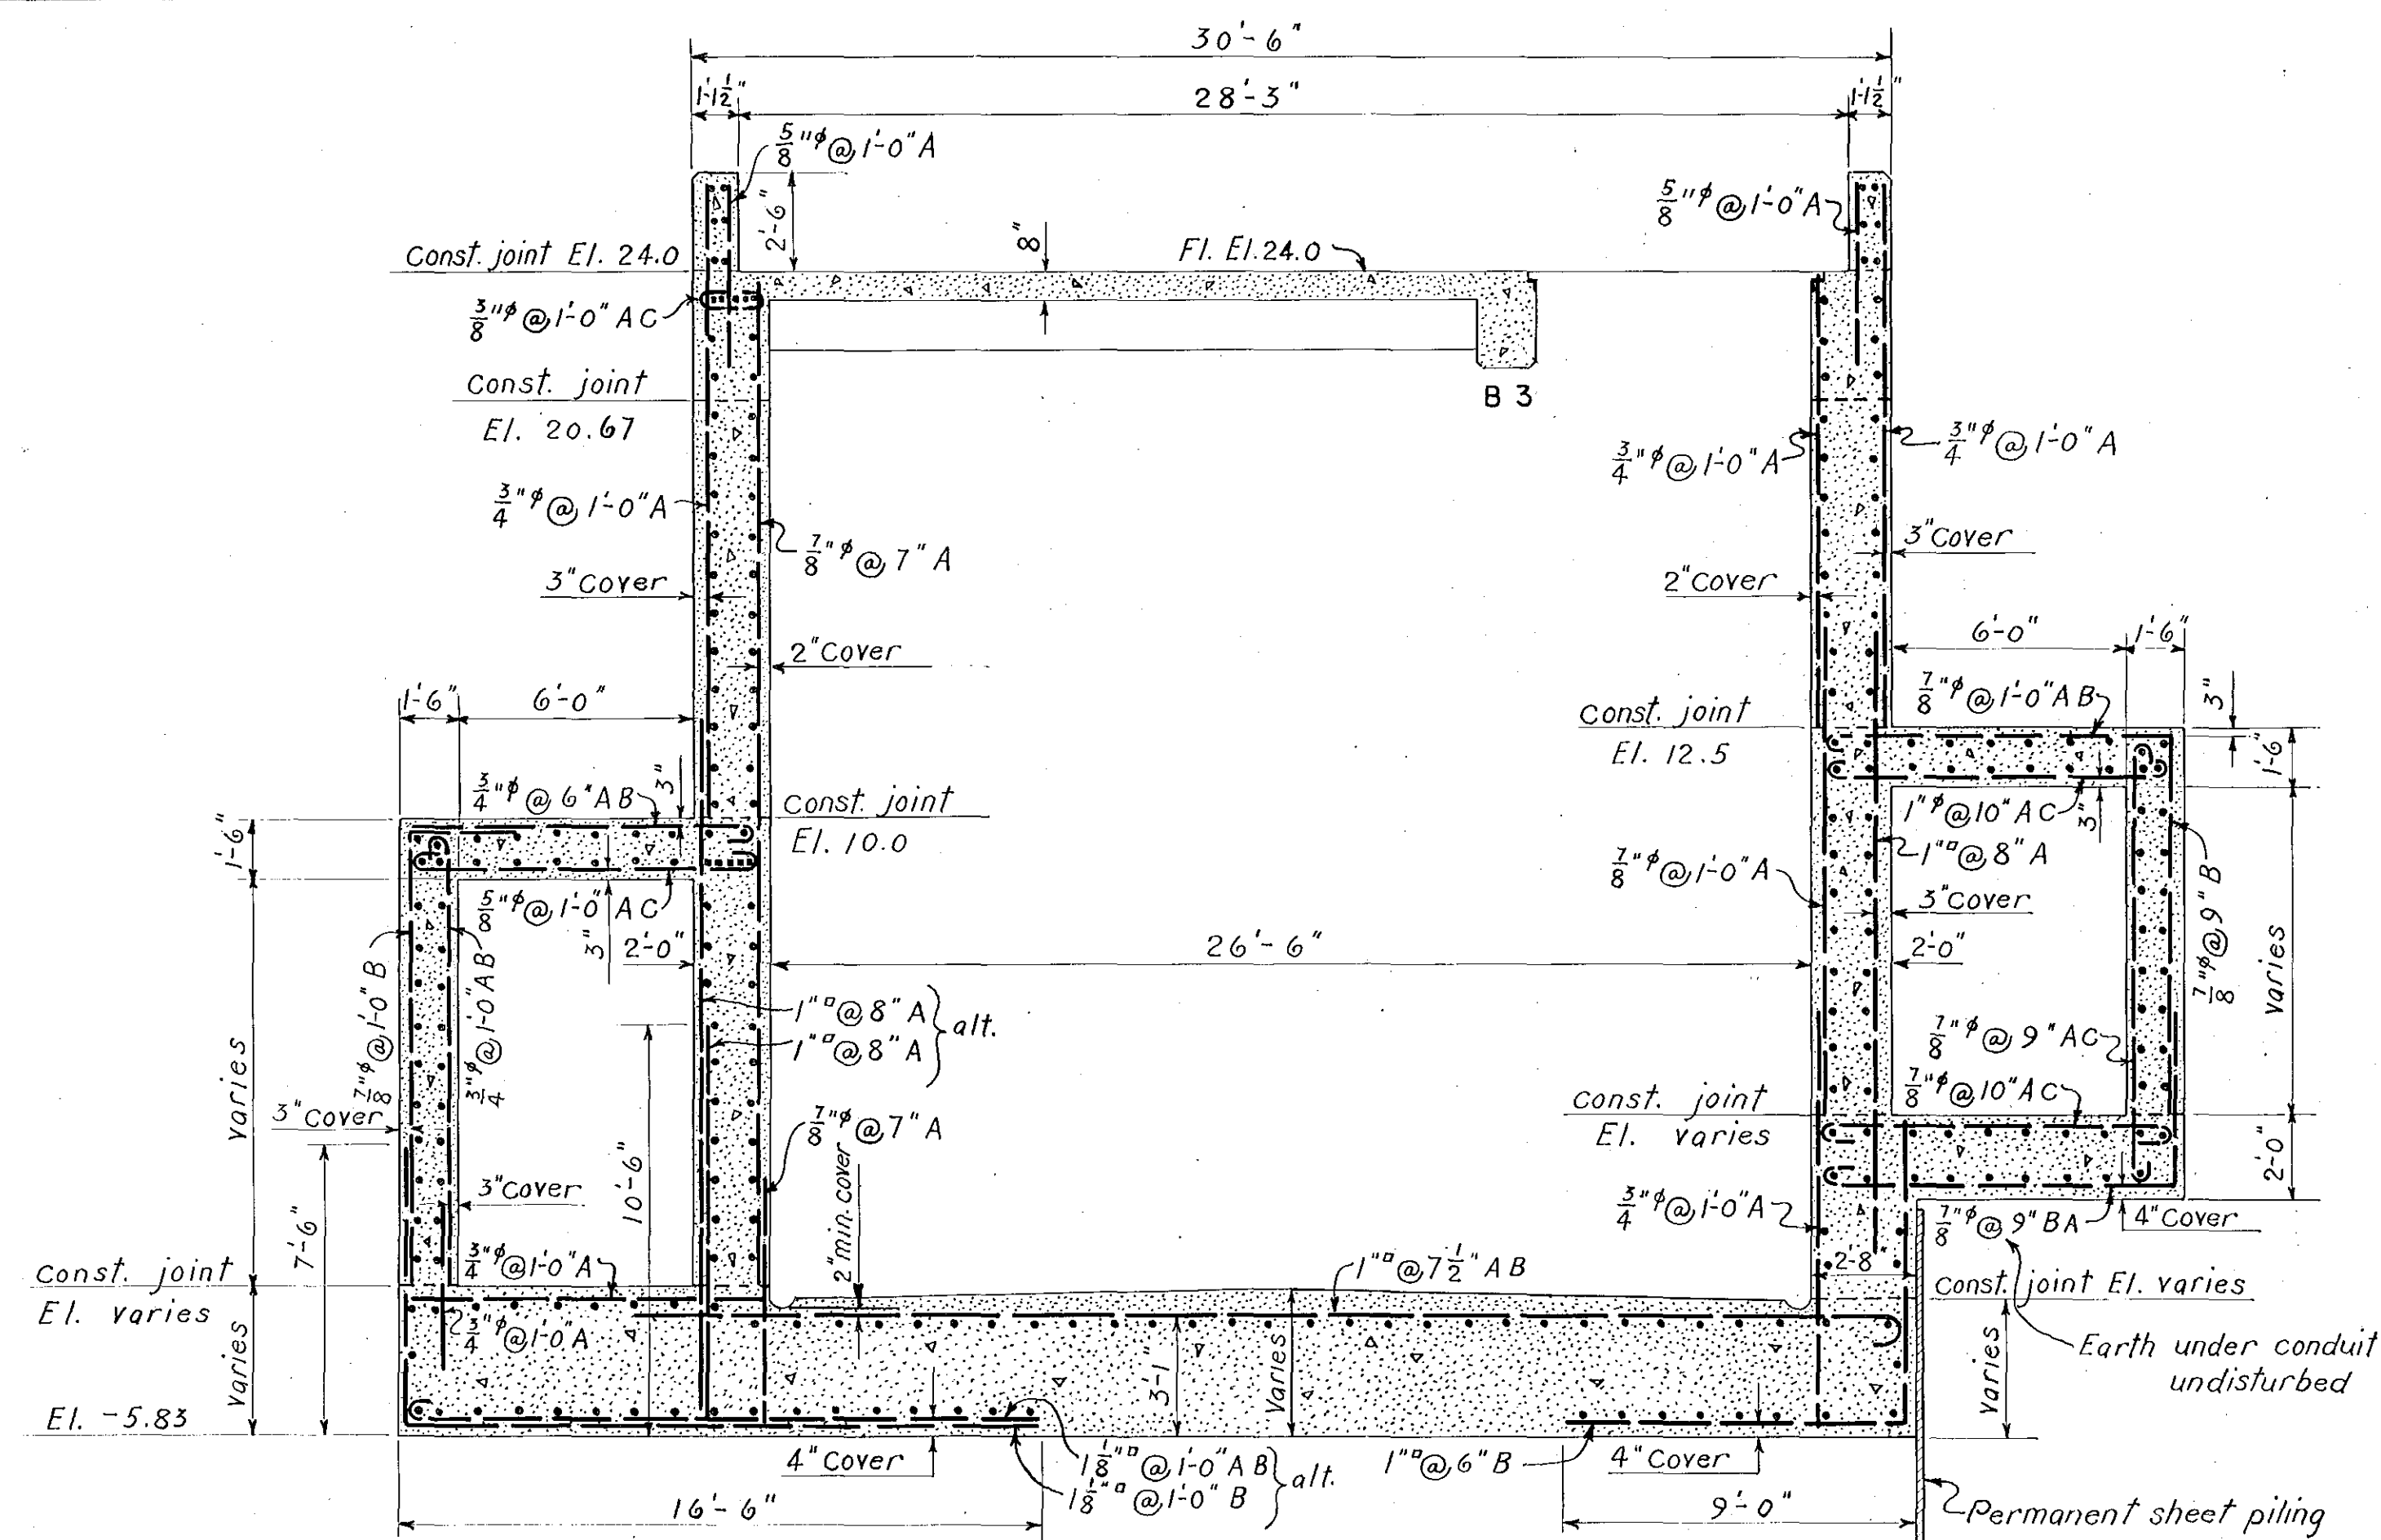
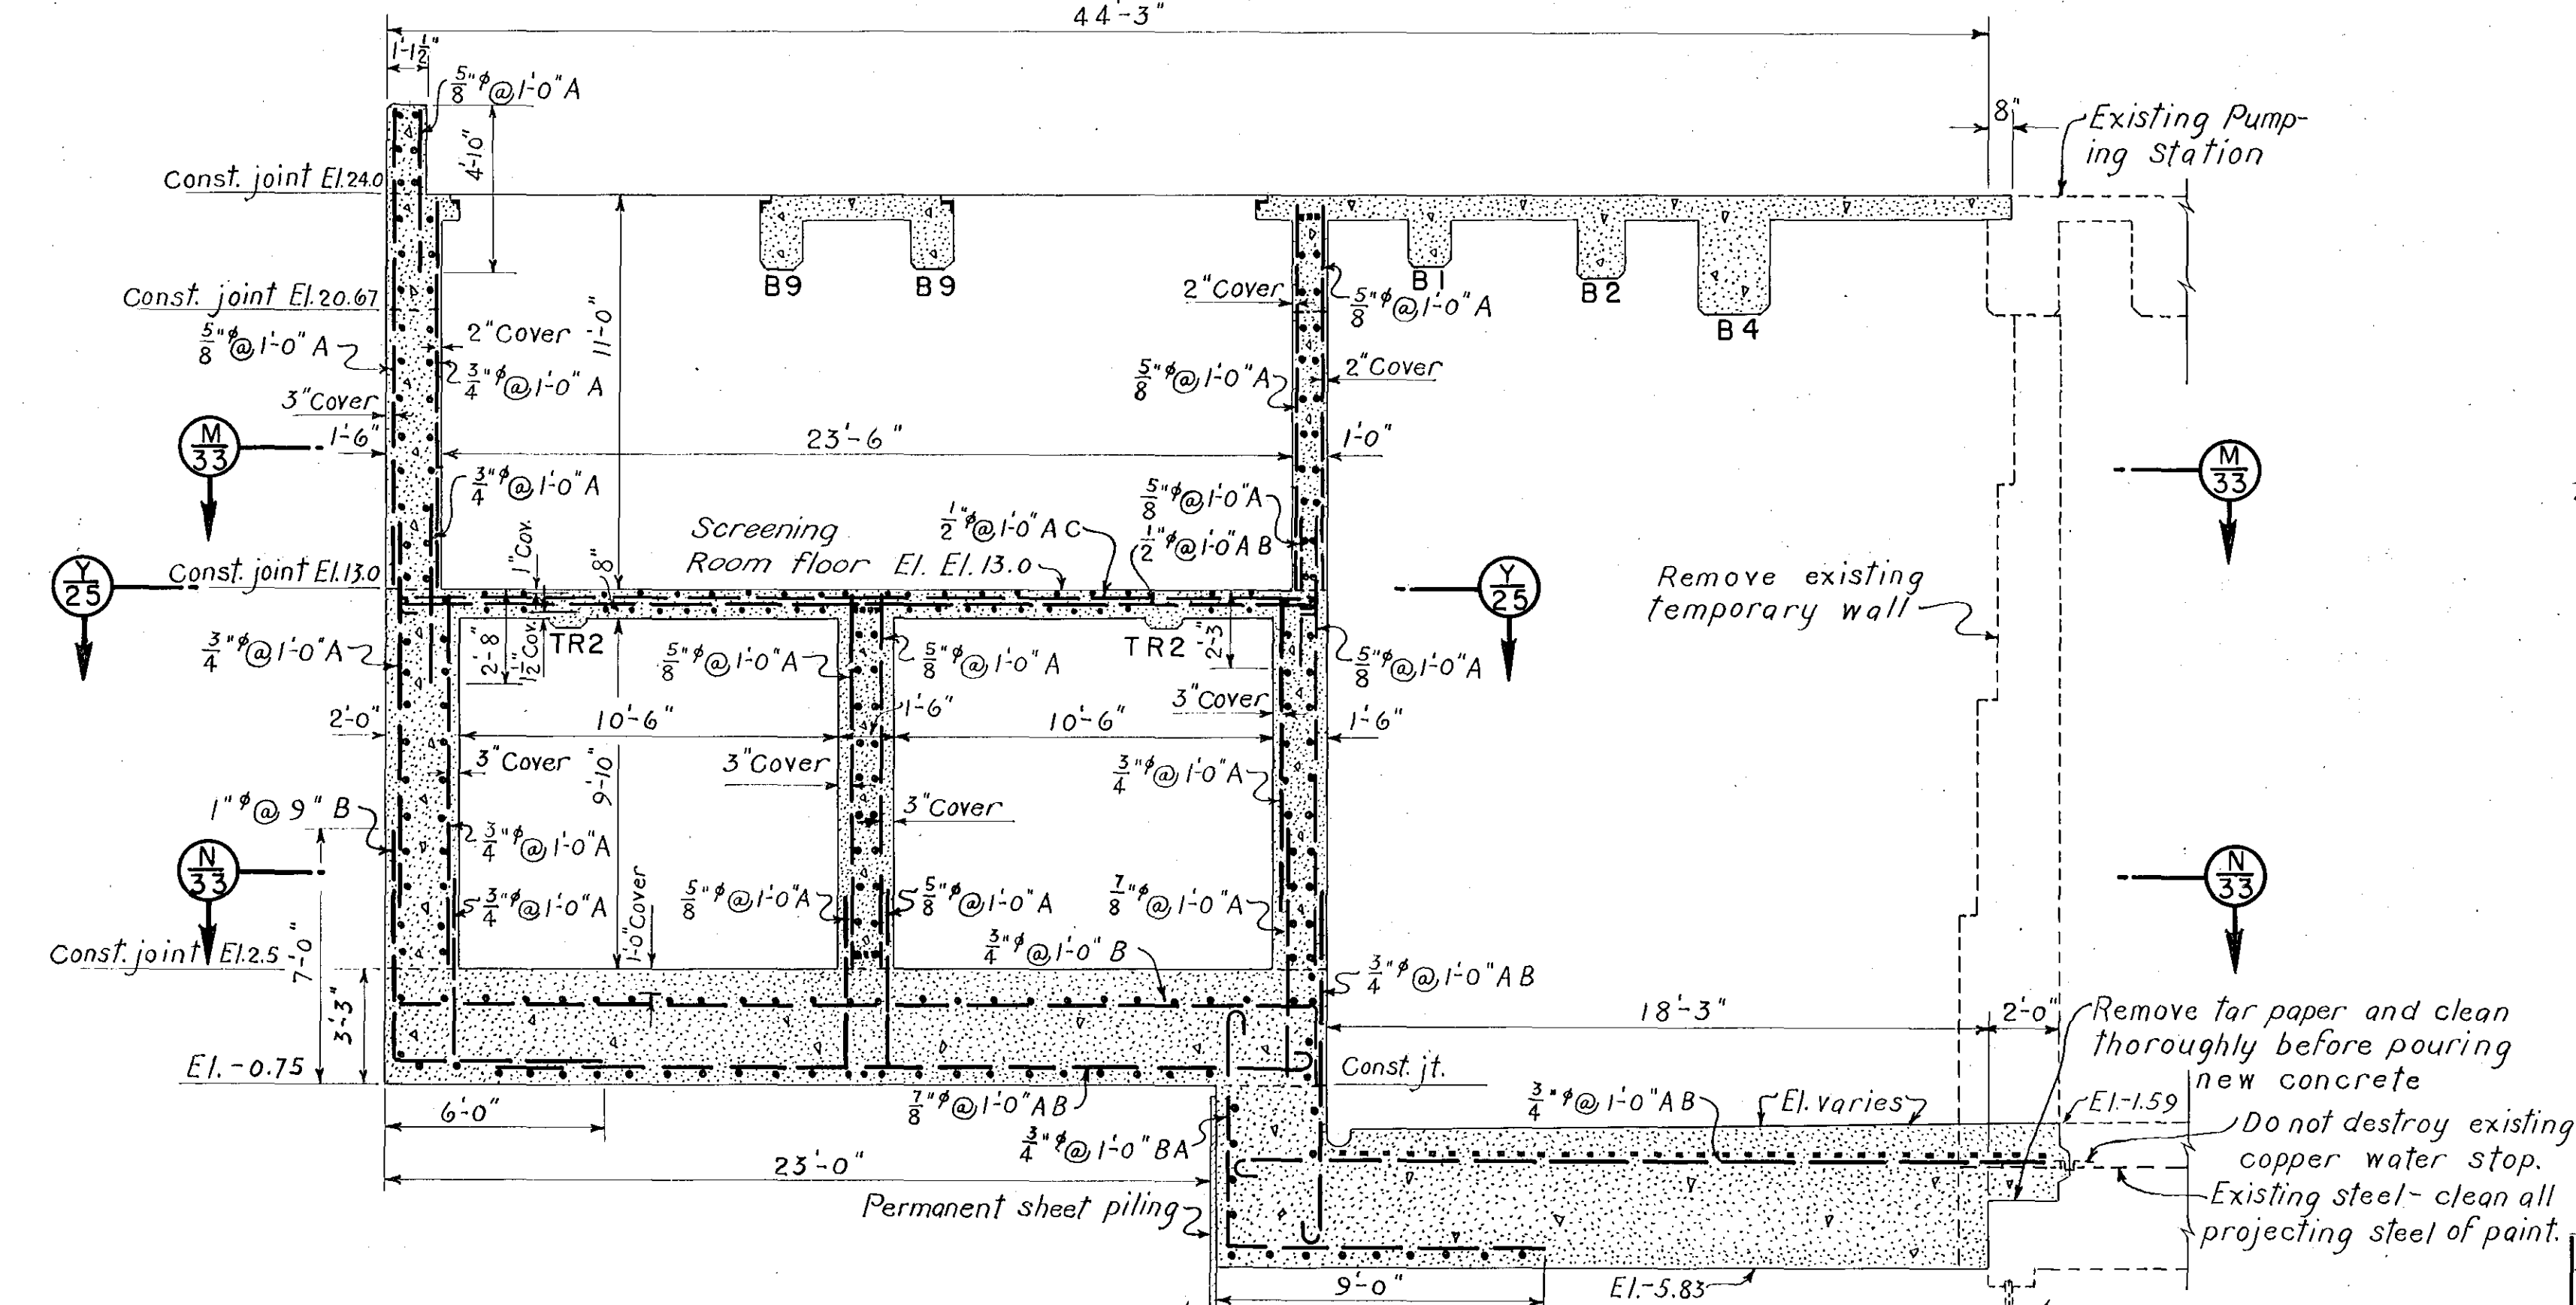
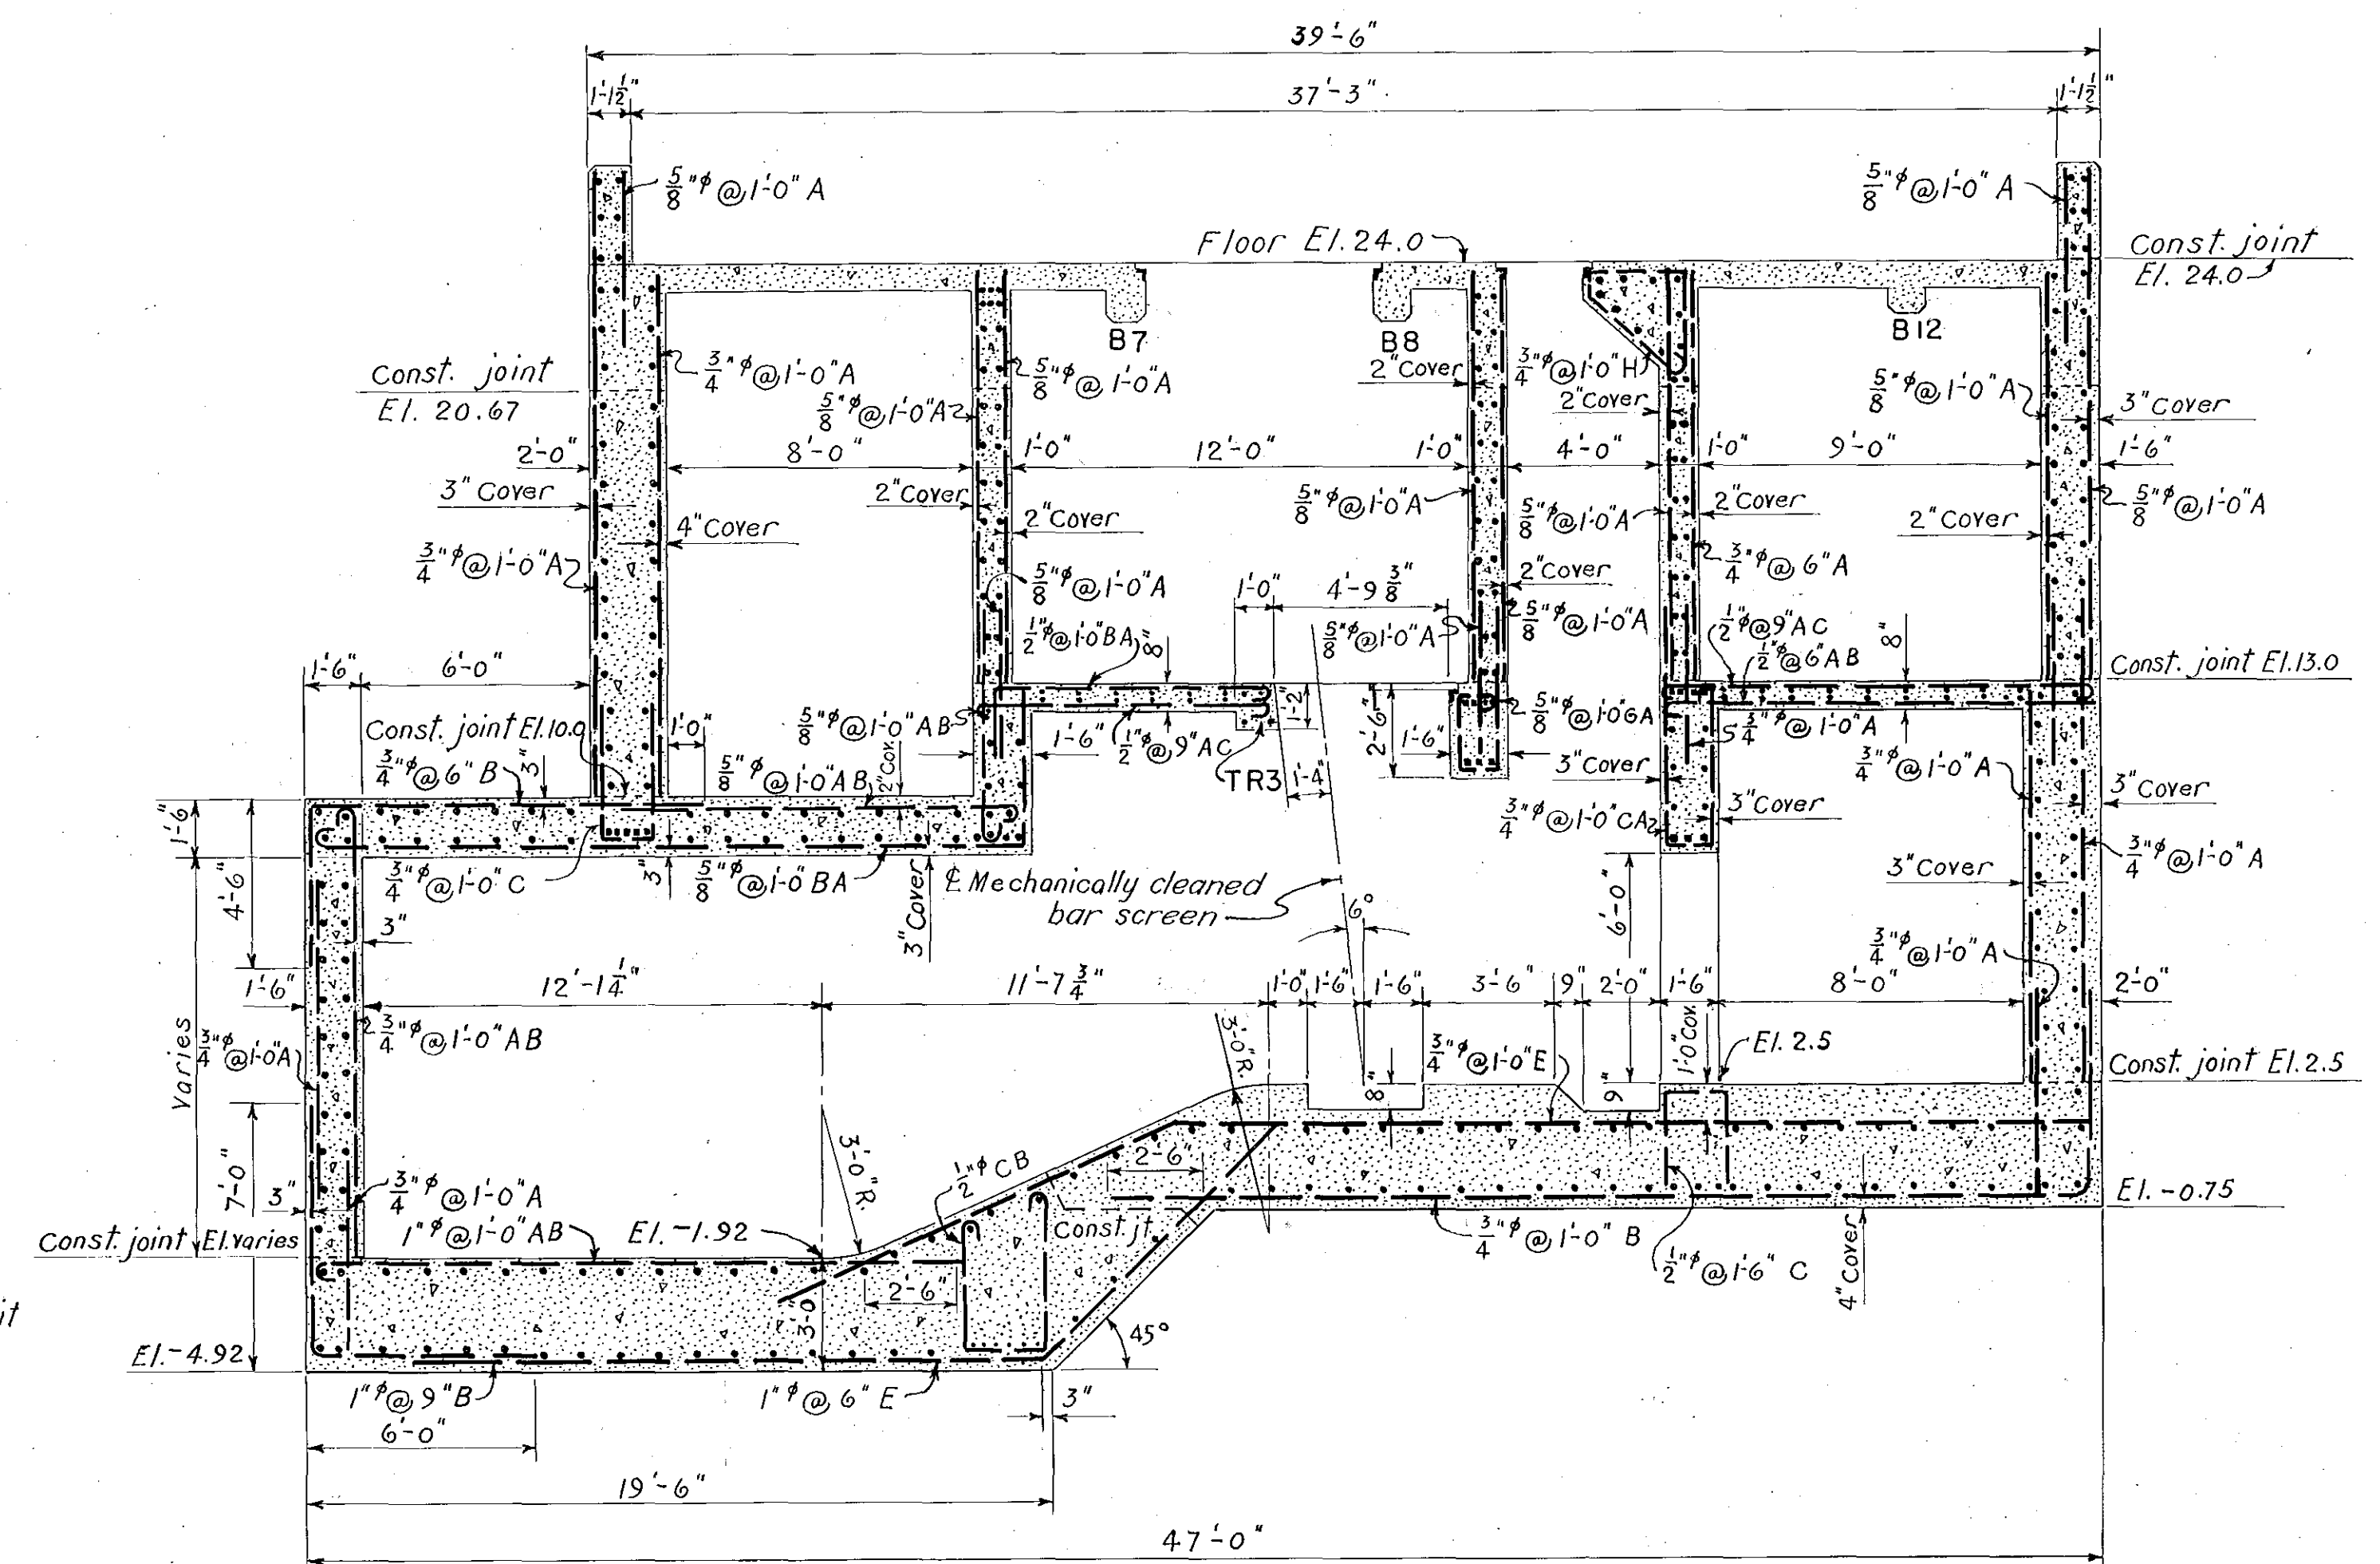
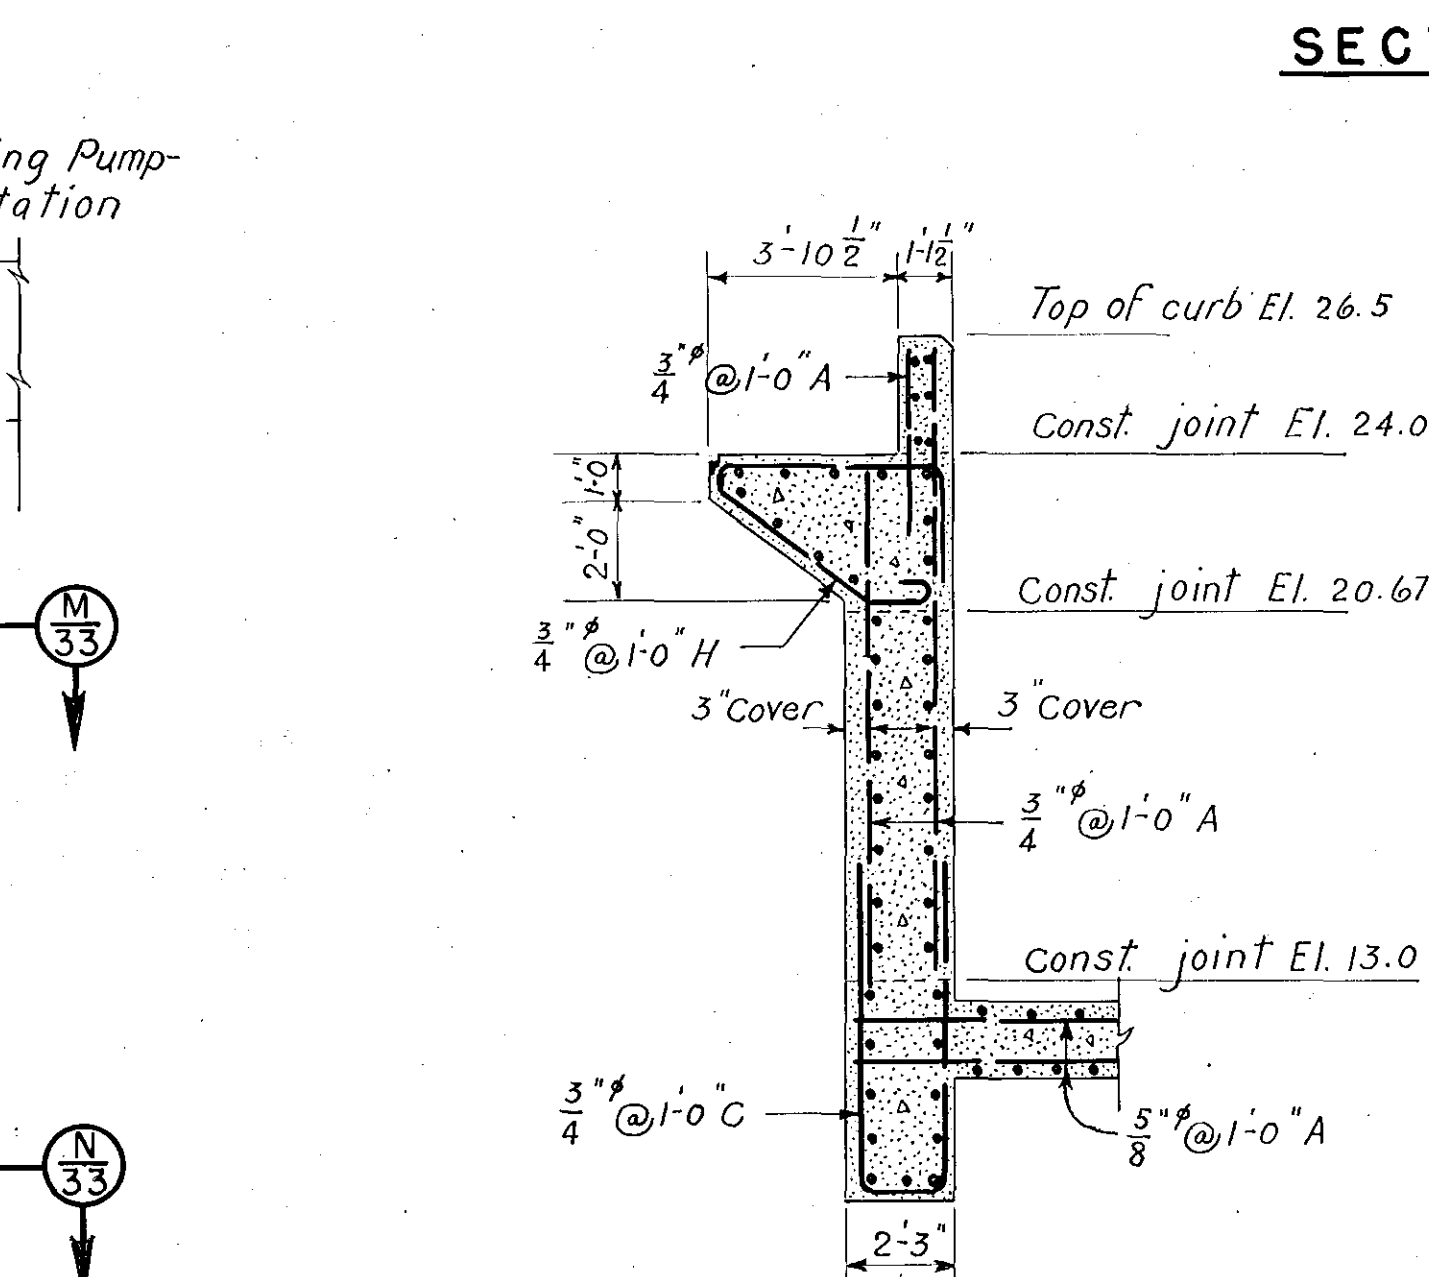


SECTION J
26SECTION K
26SECTION L
26SECTION M
26

NOTES:

- For general notes applying to this sheet, see sheet No. 22.
For steel reinforcement bending key, see sheet No. 27.

RECORD
DRAWINGSCONNECTICUT RIVER FLOOD CONTROL
KEENEY LANE PUMPING STATION
HARTFORD CONN.
VERTICAL SECTIONS

CONNECTICUT RIVER	CONNECTICUT
IN 60 SHEETS	SCALE: 1/4 IN. = 1 FT.
SHEET NO. 32	
U.S. ENGINEER OFFICE, PROVIDENCE, R.I., JUNE 1944	
SUBMITTED: E.M. Vignola	APPROVAL RECOMMENDED: J.B. Burns
SENIOR ENGINEER	HEAD OF ENGINEERING DIV.
HEAD STRUCTURAL SECTION	CHIEF, ENGINEERING DIV.
PREPARED BY: H.C. Whittenmore	TRACED: J.J.F.
STRUCTURAL SUBSECTION	CHECKED: A.L.K.
FILE NO. CT-4-3246	

KEY	DATE	REVISION (Indicated by Δ)	REV. BY	CK. BY	AP. BY