


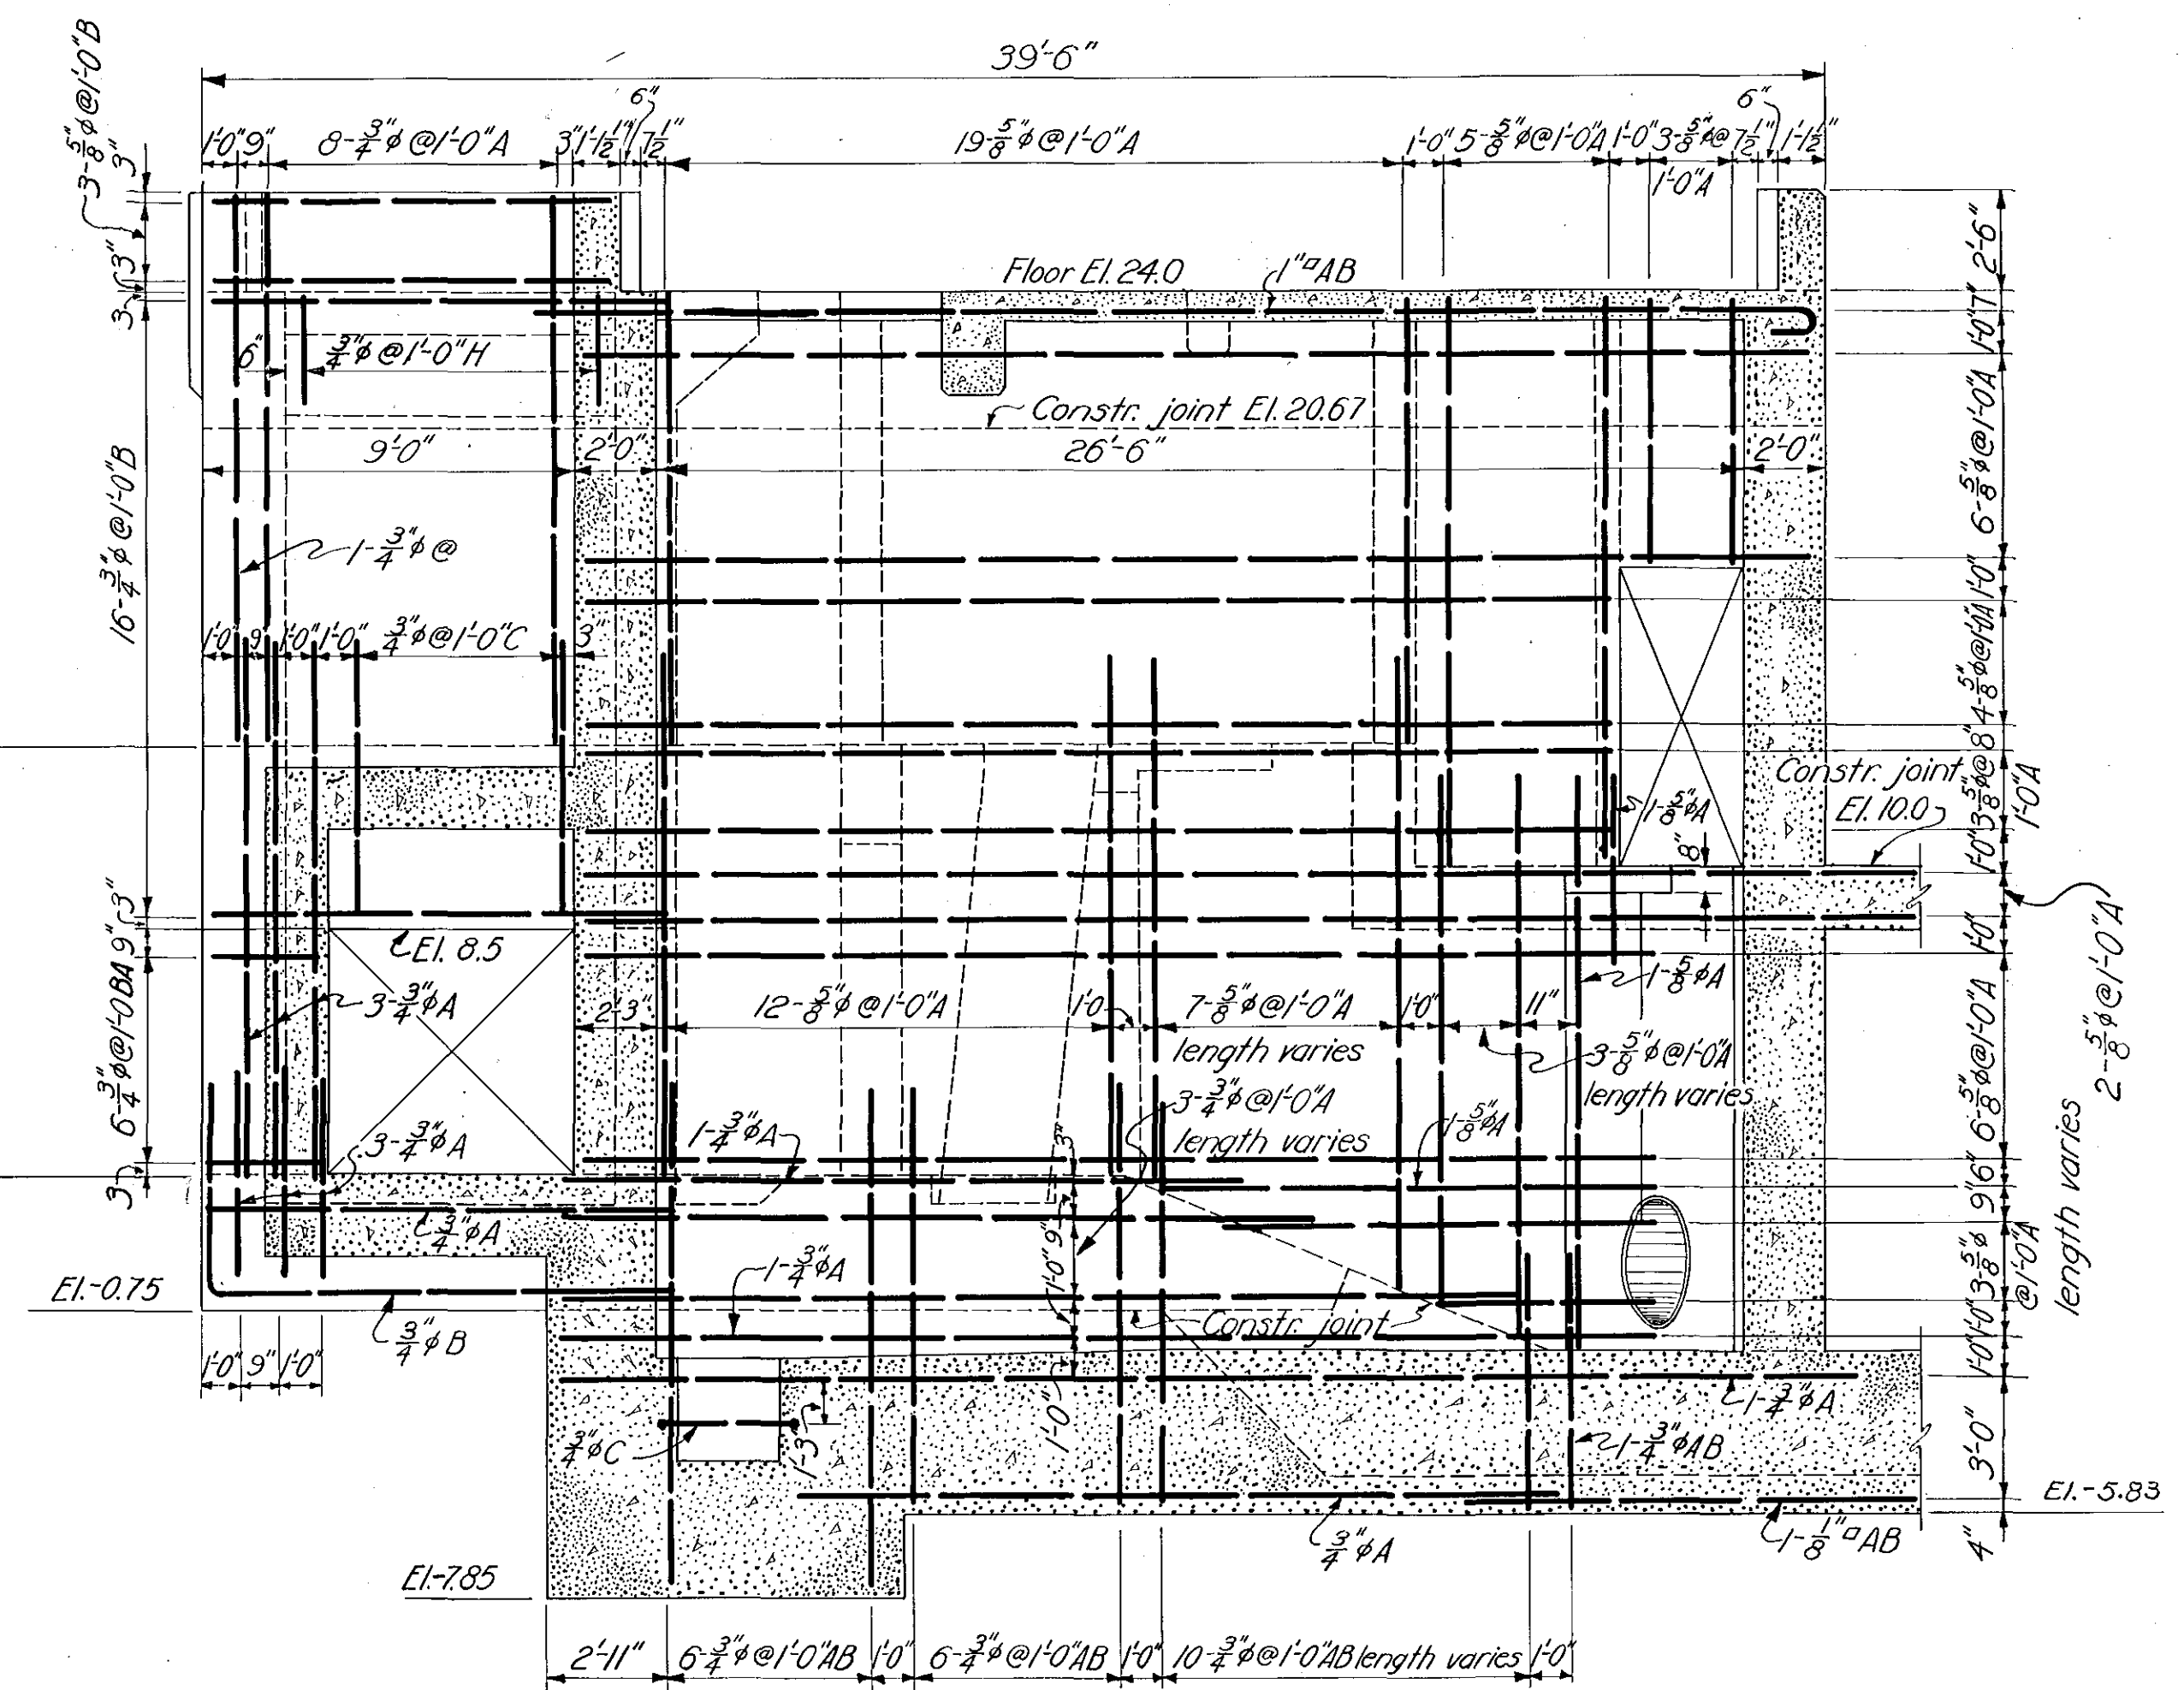

SECTION P
26

RECORD
DRAWINGS

KEY	DATE	REVISION (Indicated by Δ)	REV. BY	CK. BY	AP. B