


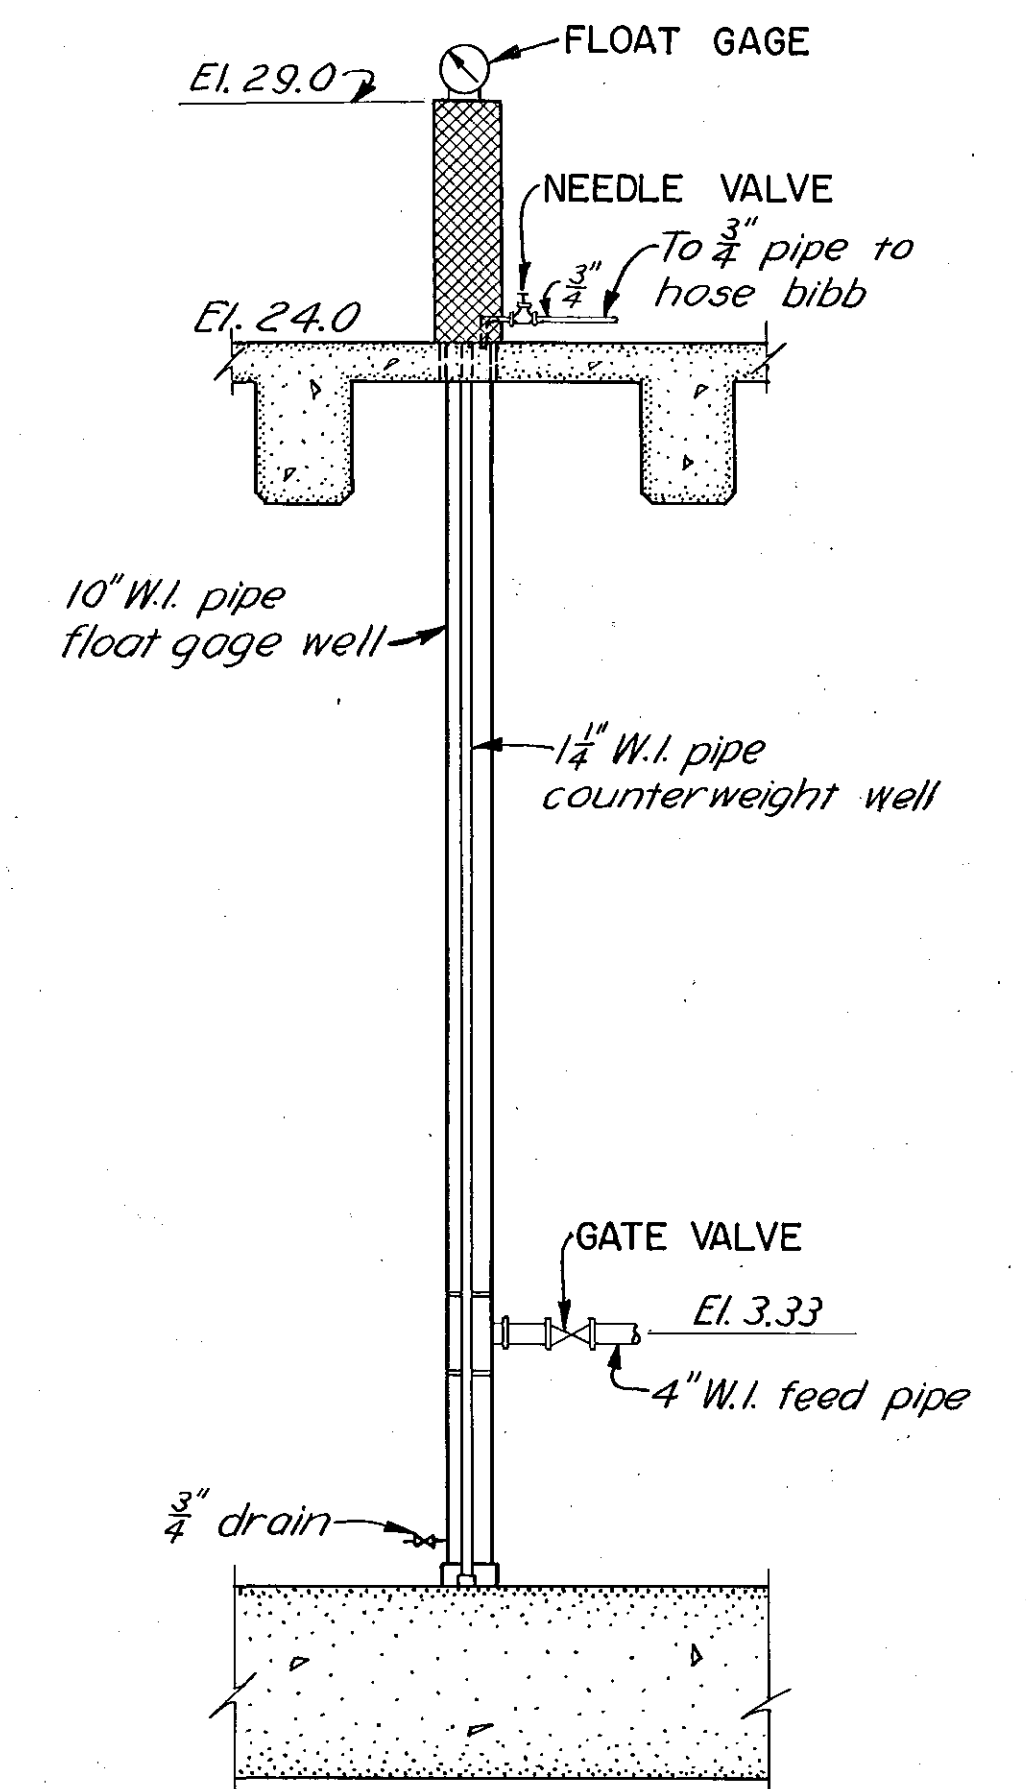

SECTION $\frac{E}{42}$
FLOAT GAGE

The gasoline engines, Diesel engine, exhaust piping and silencers for pump engines, gear units, couplings, 36" pumps, 16" pump, intake and discharge piping, 36" hydraulic operated gate valves, 16" hand operated gate valves, check valves and wall castings, were furnished by the government. Installing equipment furnished by the government was paid for under Item No.26.

RECORD
DRAWINGS

CONNECTICUT RIVER	CONNECTICUT	CONNECTICUT
IN 60 SHEETS	SCALE: 1/4 IN. = 1 FT.	SHEET NO. 42

SUBMITTED: 11/1/00 APPROVAL RECOMMENDED: 380 APPROVED: 11/1/00

<i>H. J. Kropfner</i> SENIOR ENGINEER	<i>J. B. Burns</i> HEAD ENGINEER	<i>W. J. Feltz</i> CO-., CORPS OF ENGINEERS
HEAD MECHANICAL SECTION	CHIEF, ENGINEERING DIV.	DISTRICT ENGINEER

HEAD, MECHANICAL SECTION	CHIEF, ENGINEERING DIV.	DISTRICT ENGINEER
PREPARED: <i>[Signature]</i>	DRAWN: E.H.W. TRACED: C.C.B.	

MECHANICAL SUBSECTION	TRACED: D.C.O'R CHECKED: <i>Q. Mue.</i>	FILE NO. CT-4-3256
-----------------------	--	--------------------

Ht. 11