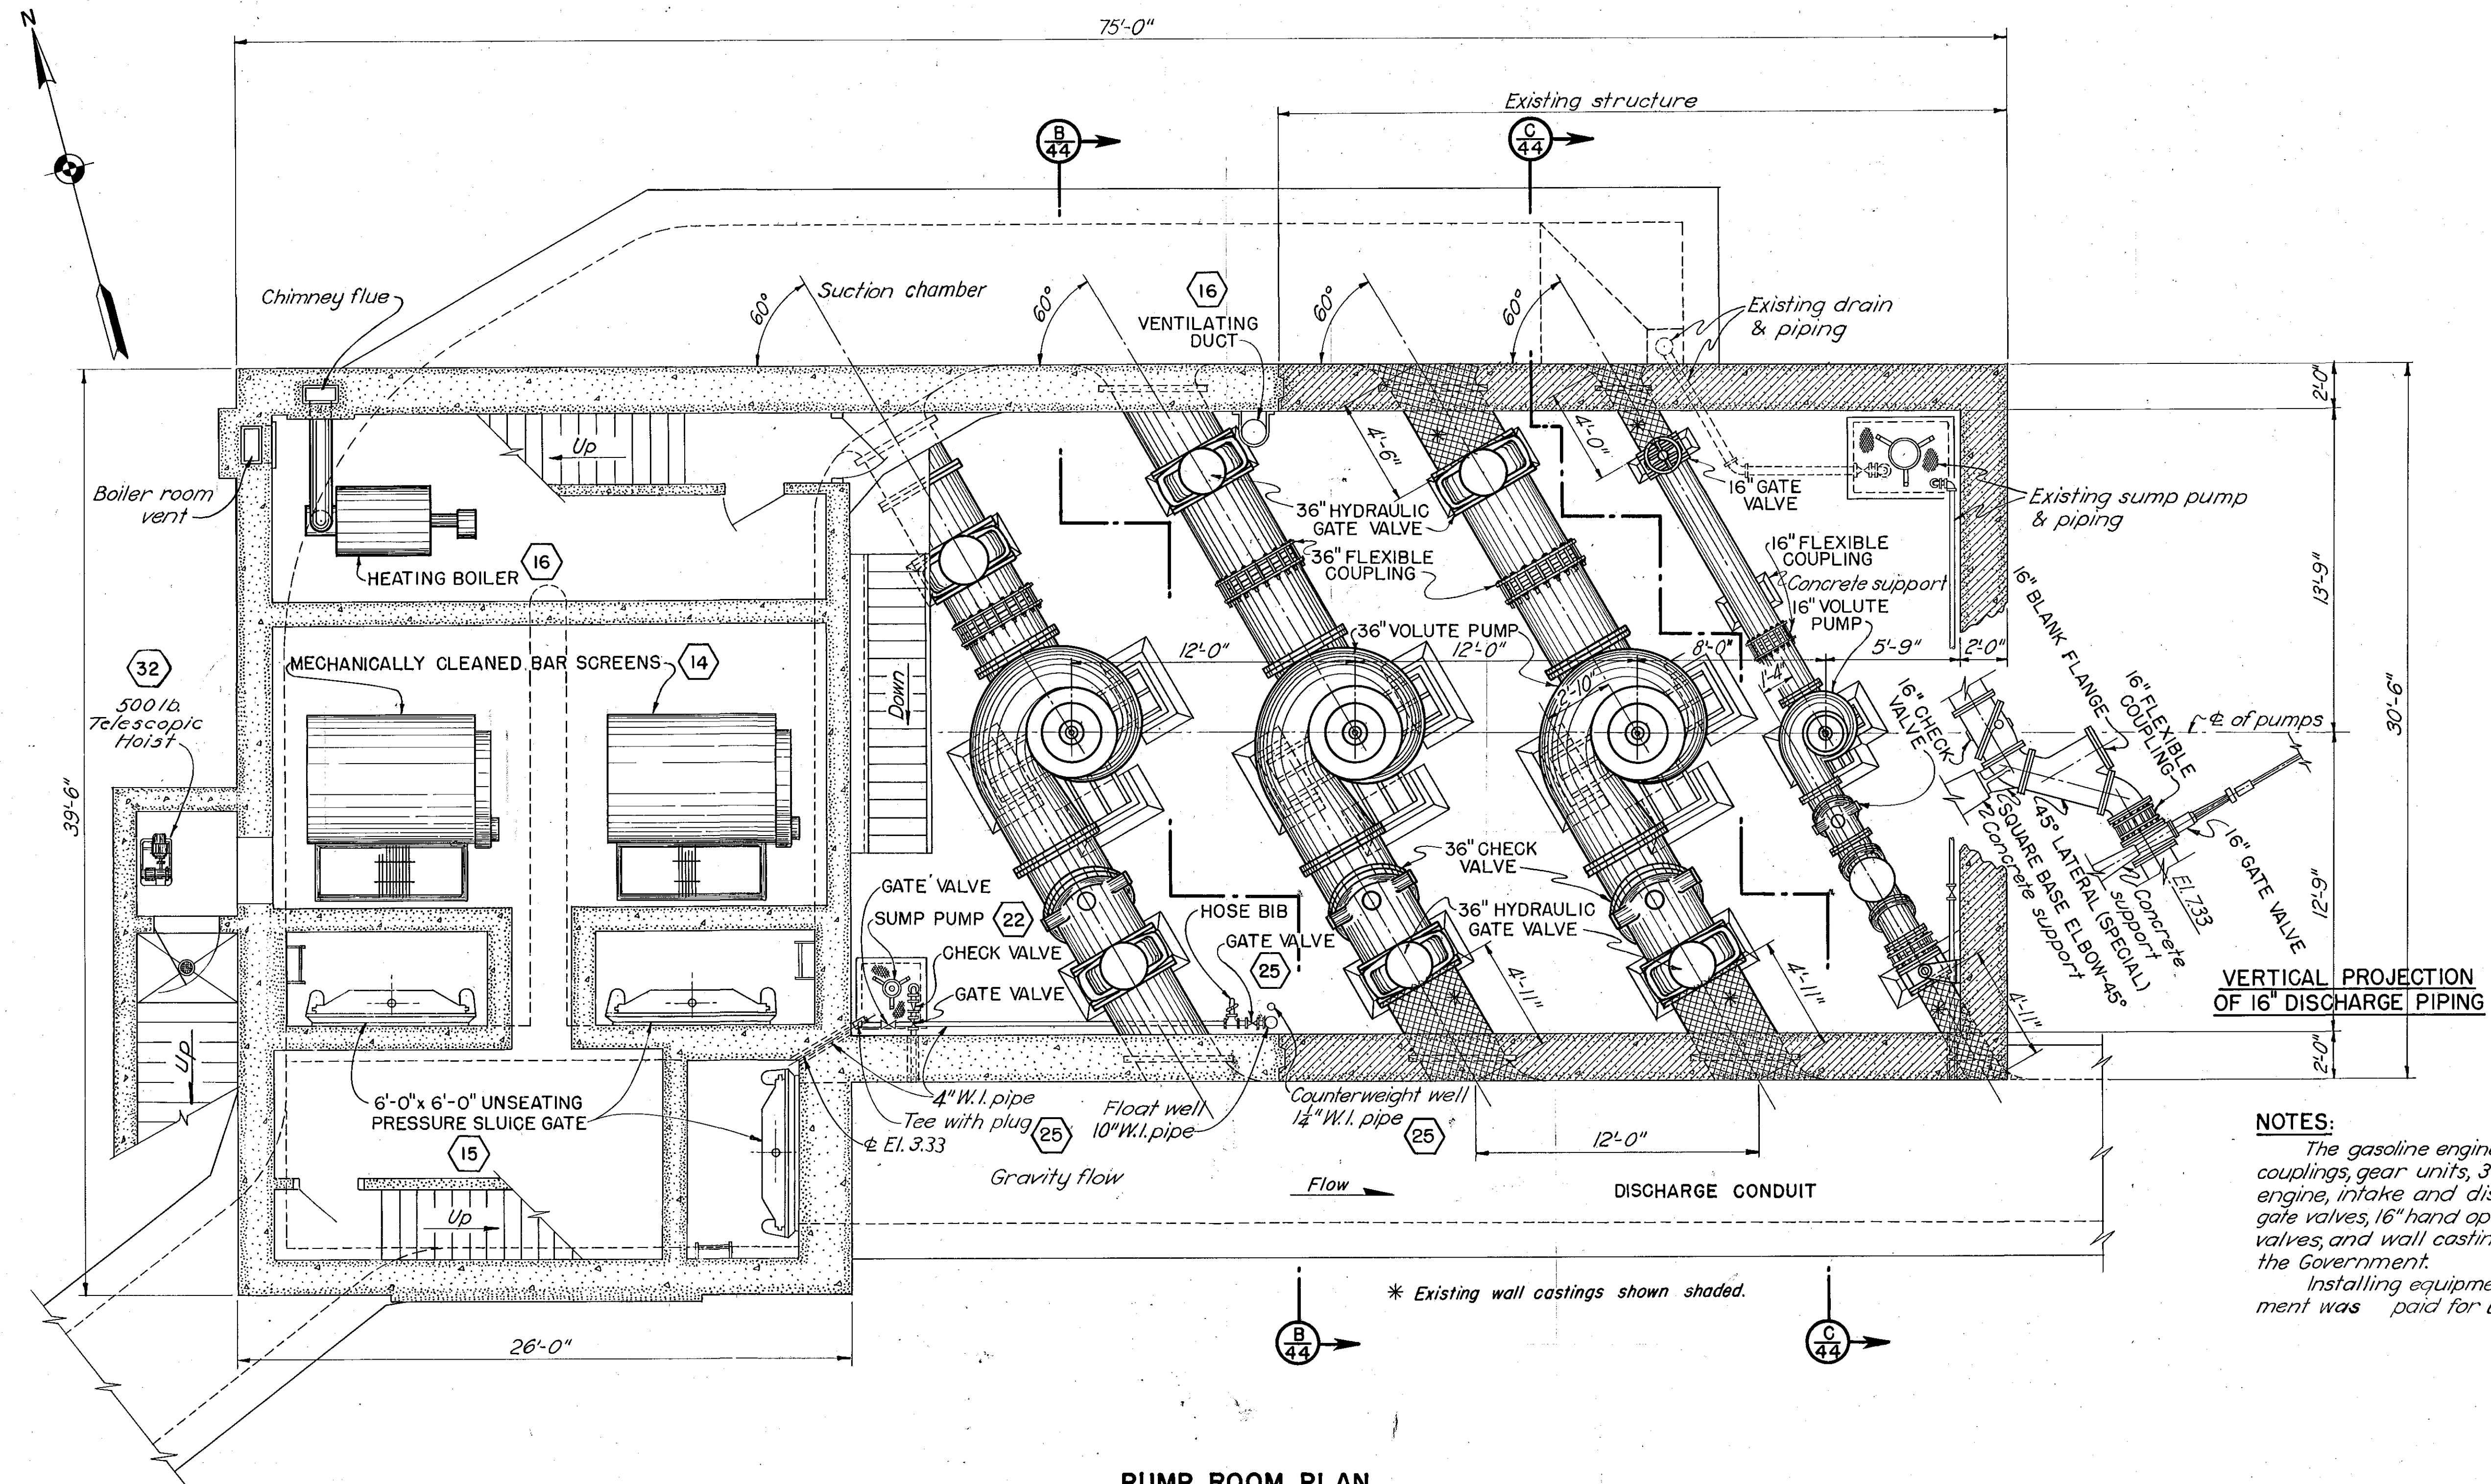


RECORD
DRAWINGS

CONNECTICUT RIVER FLOOD CONTROL

KEENEY LANE PUMPING STATION

HARTFORD, CONN.

GENERAL ARRANGEMENT OF EQUIPMENT NO. 2

CONNECTICUT RIVER
IN 60 SHEETS
SCALE: $\frac{1}{4}'' = 1' - 0''$
SHEET NO. 43

U. S. ENGINEER OFFICE, PROVIDENCE, R. I., JUNE 1944

SUBMITTED:	APPROVAL RECOMMENDED:	APPROVED:
HEAD MECHANICAL SECTION	HEAD ENGINEER	DISTRICT ENGINEER
CHIEF, ENGINEERING DIV.		
PREPARED:	DRAWN: R. M. W.	
MECHANICAL SUBSECTION	TRACED: R. K. J.	
CHECKED:		

FILE NO. GT-4-3257

Ht. II

43