
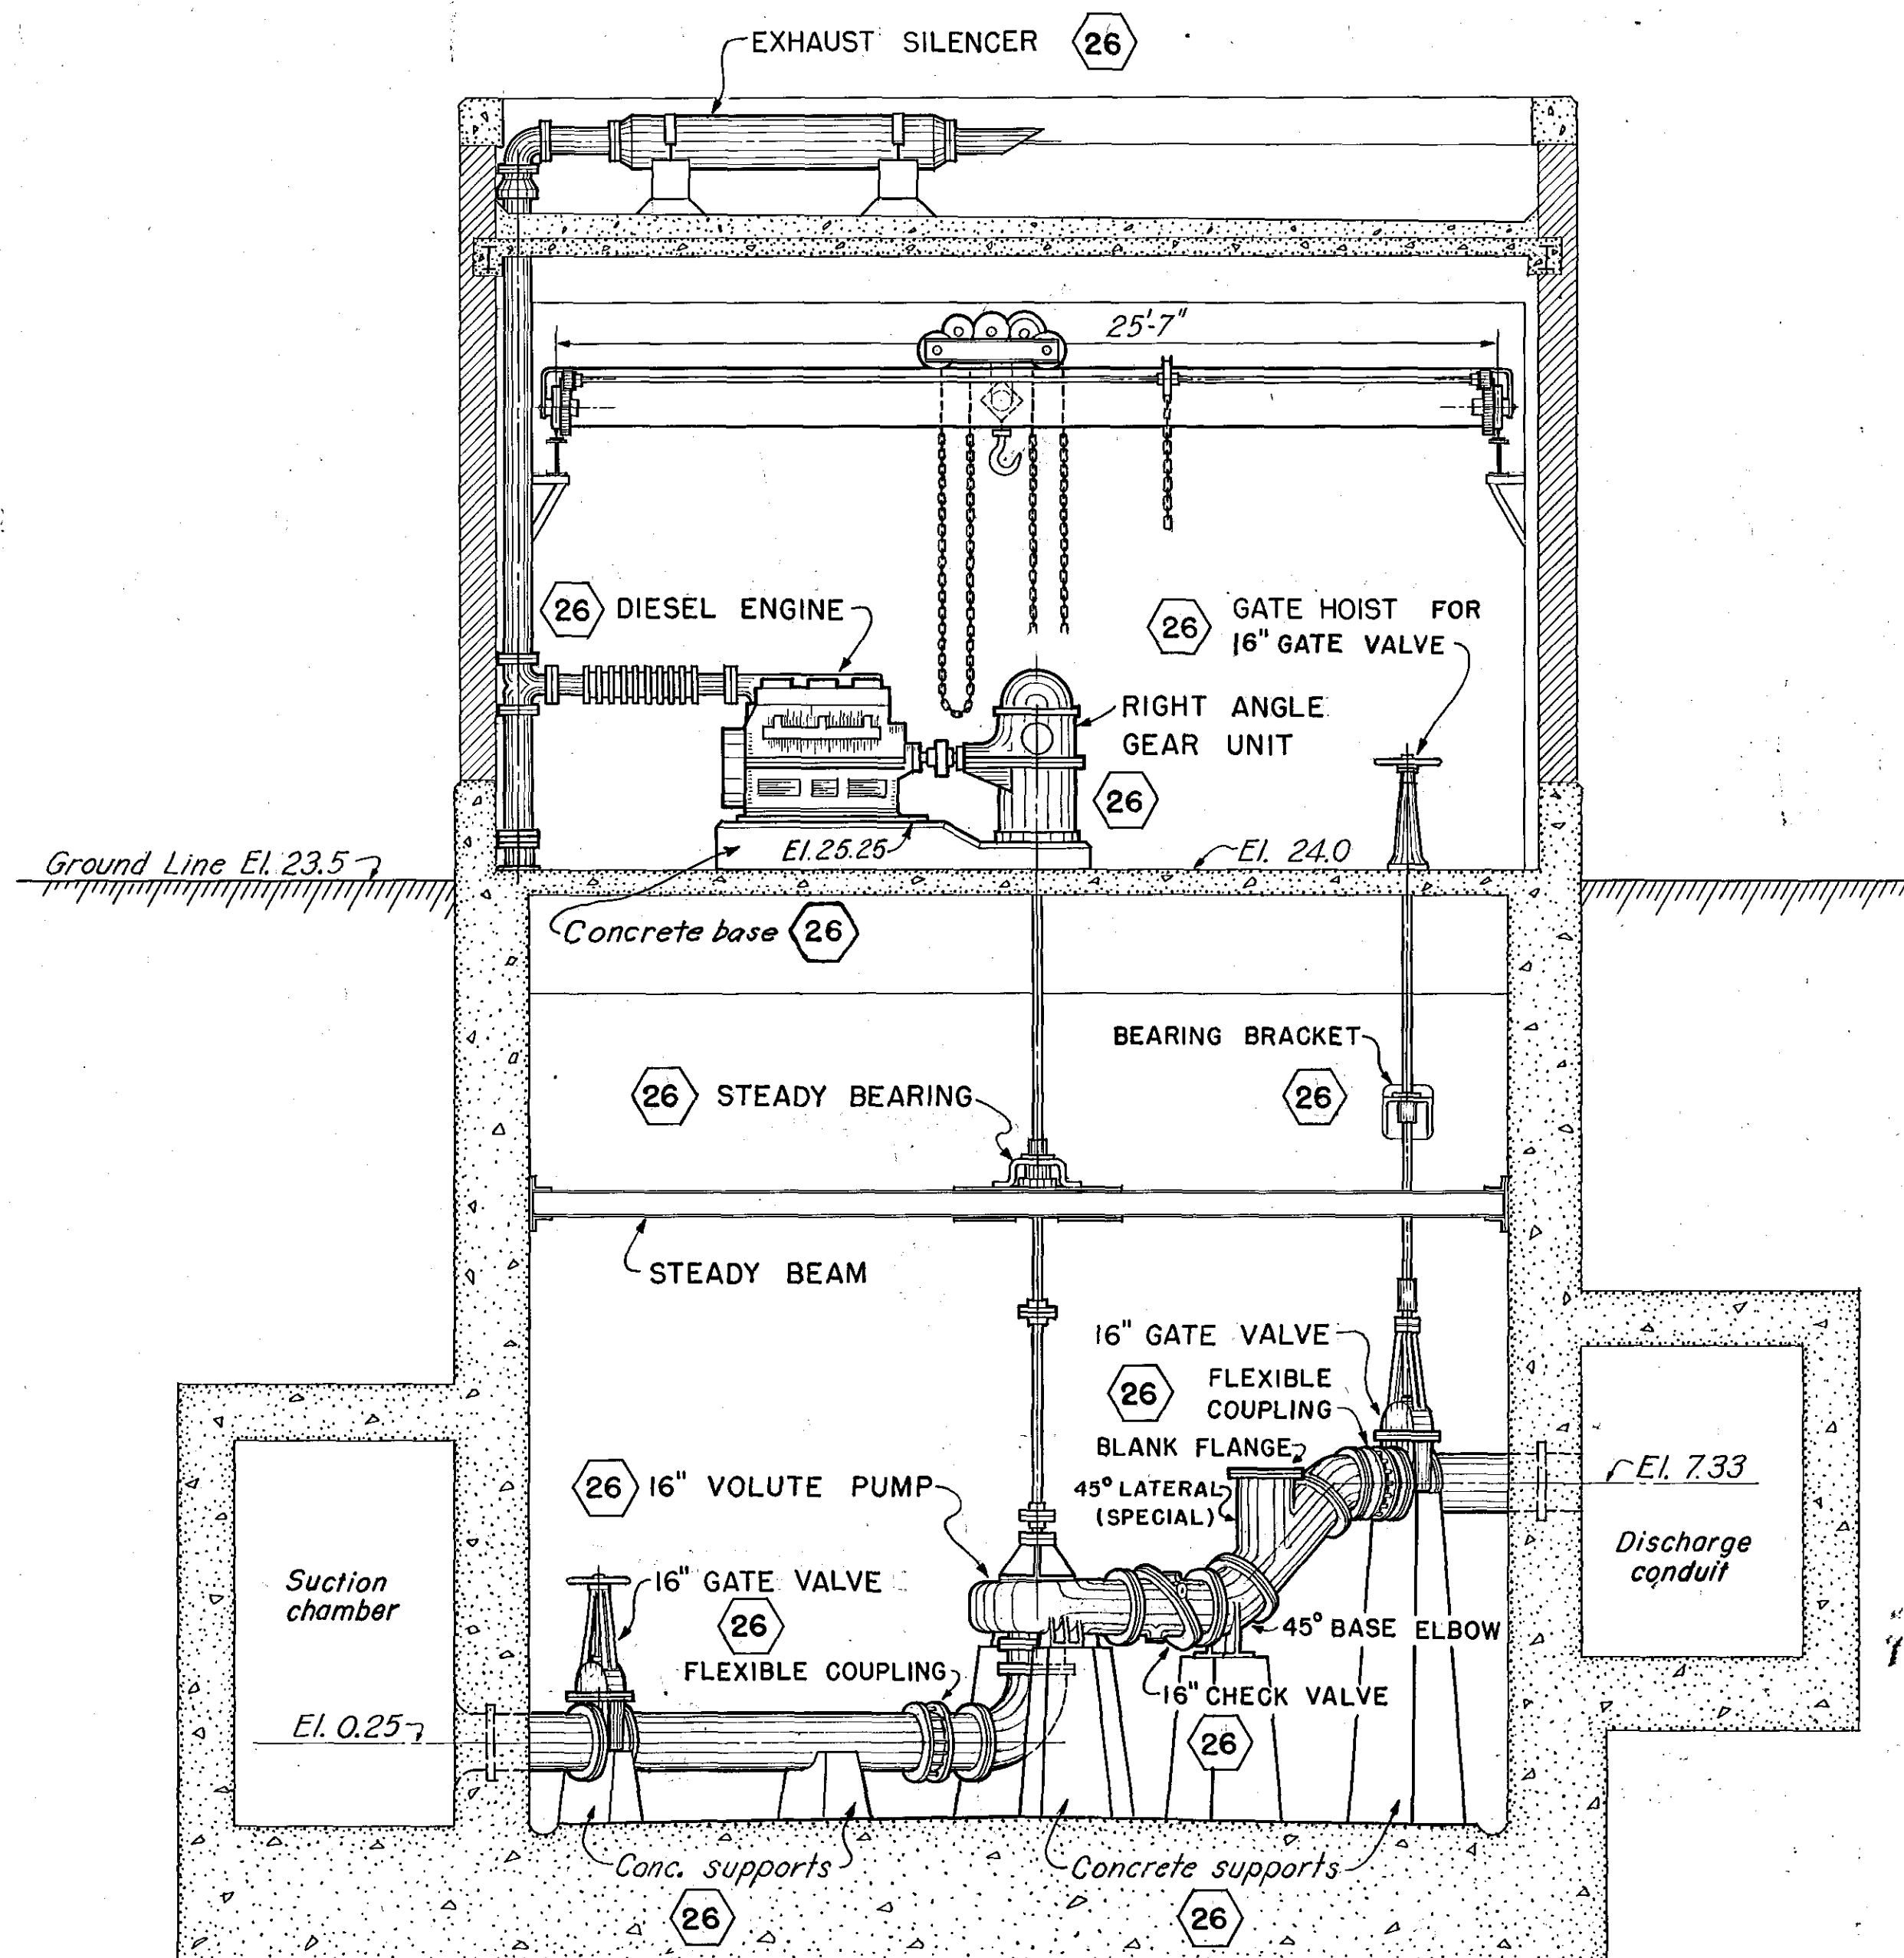


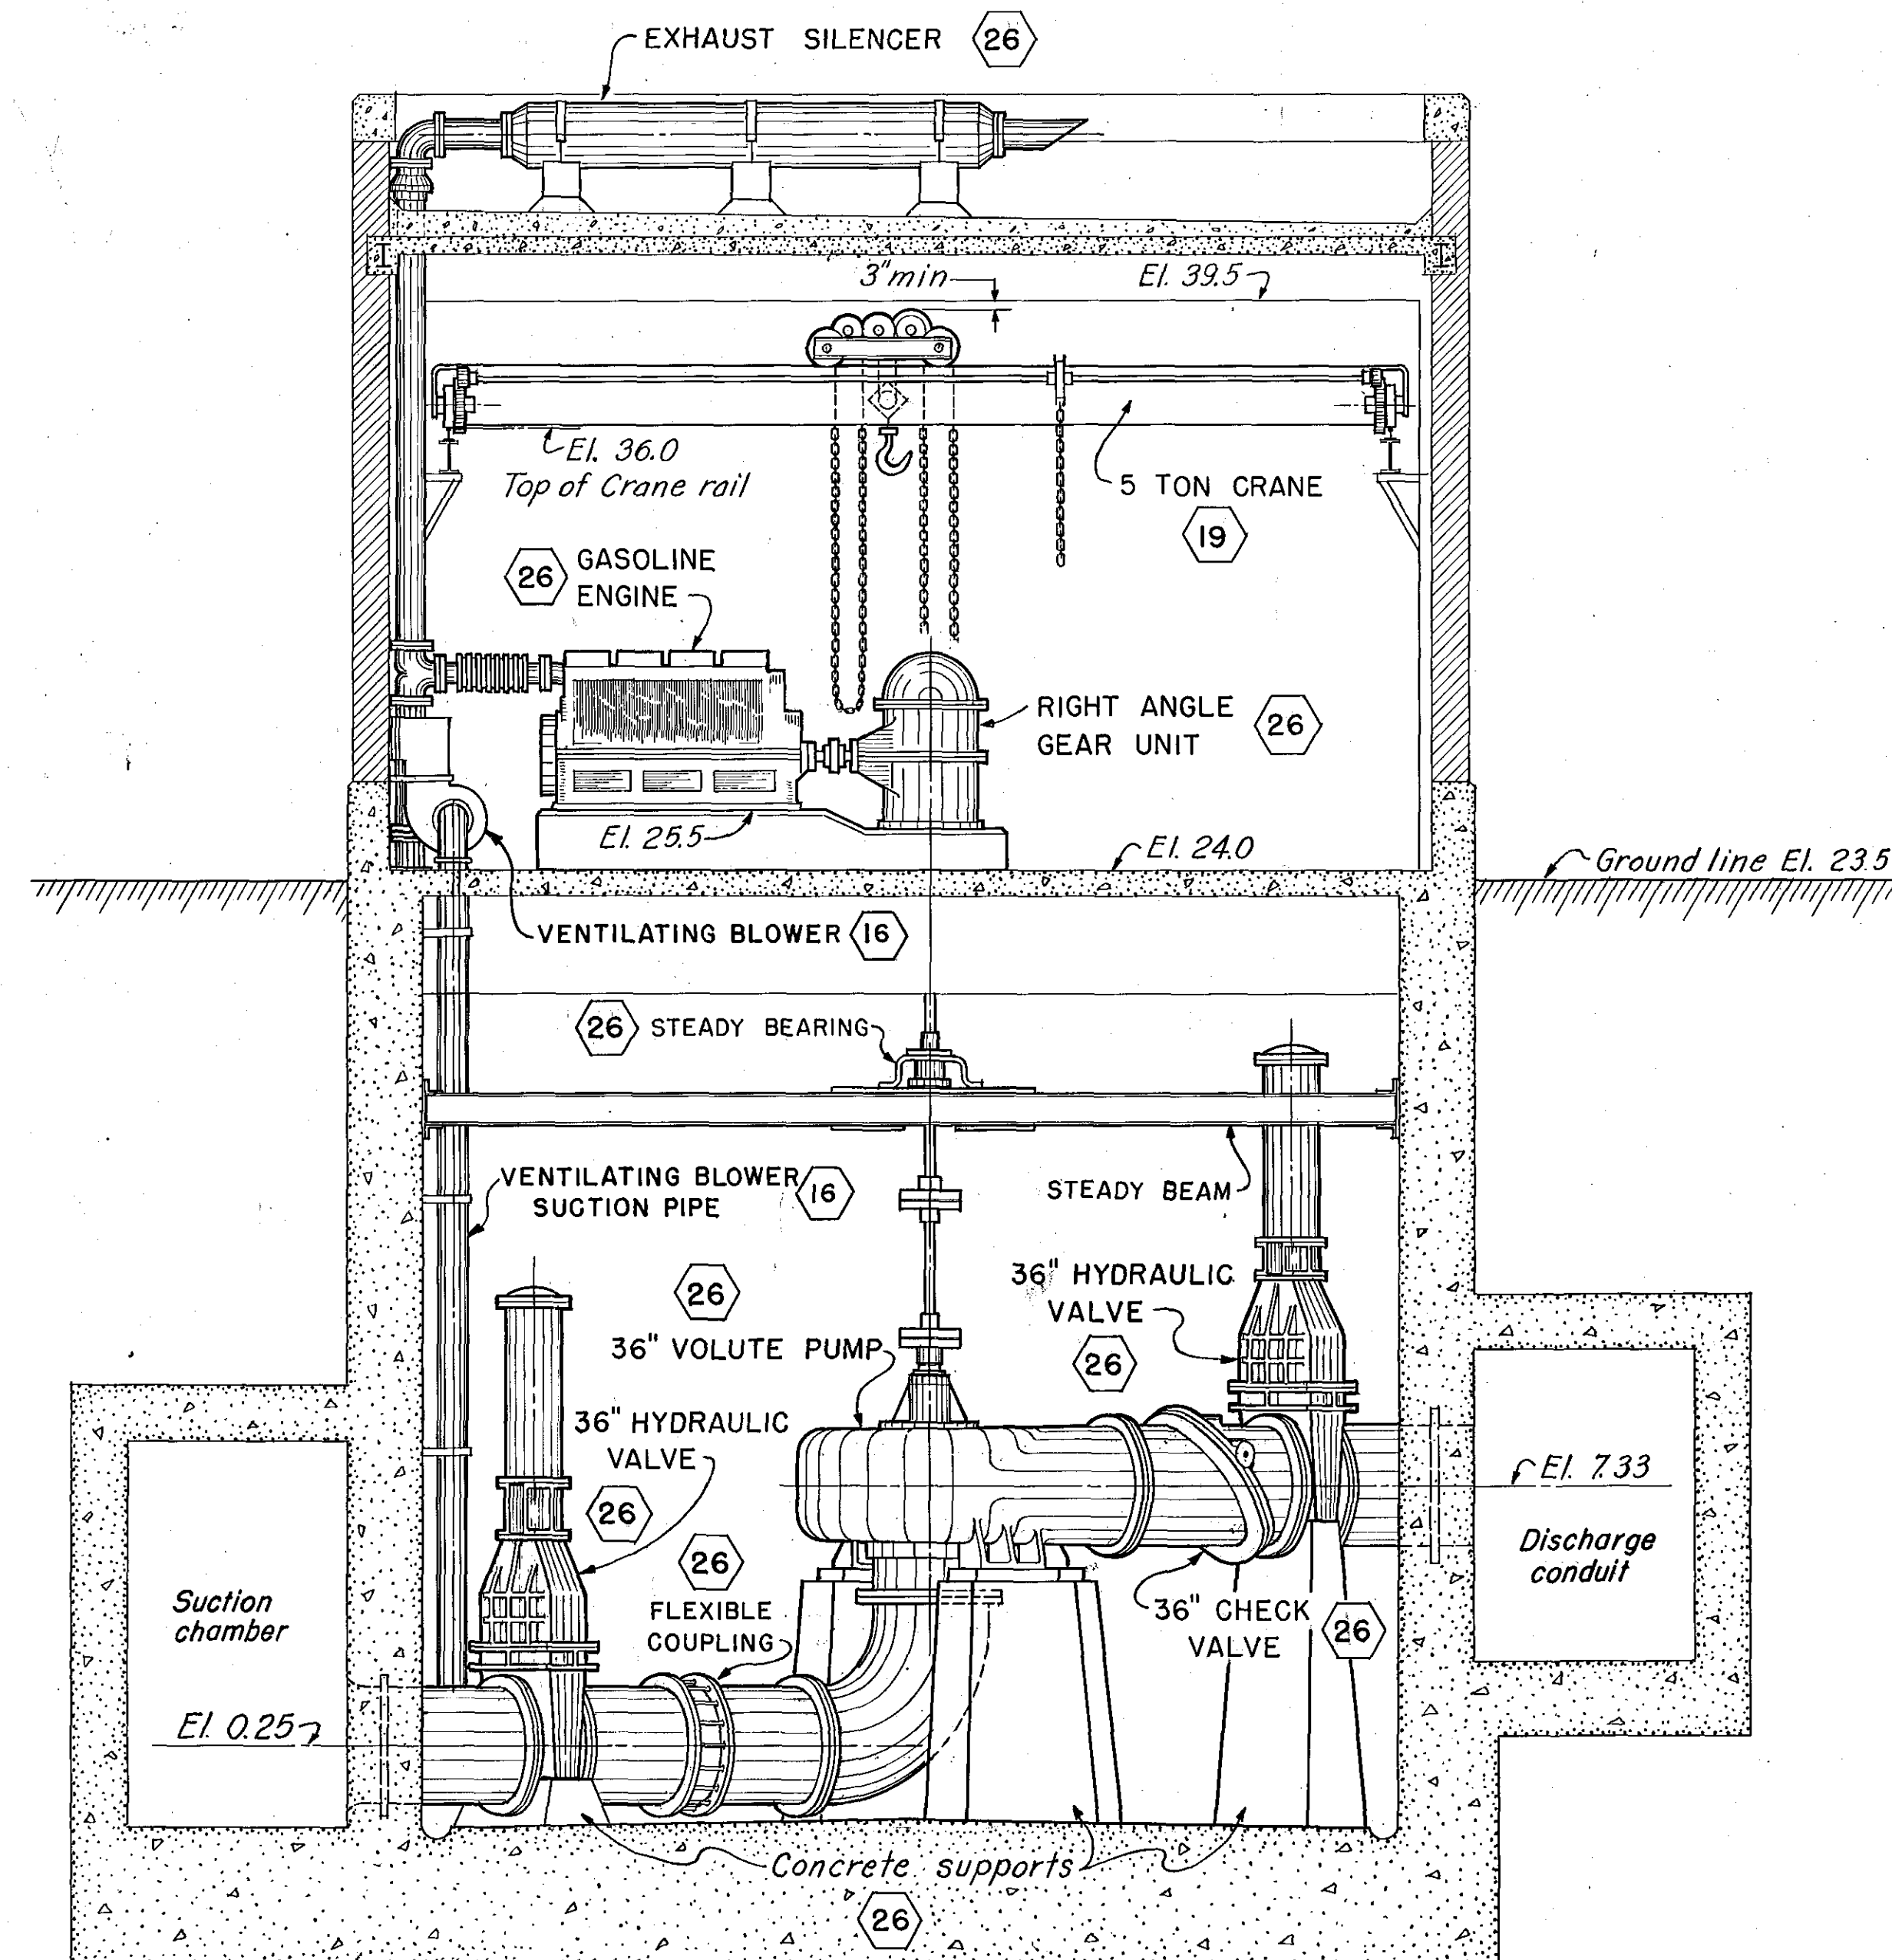

SECTION C 43

SCALE: $\frac{1}{4}$ " = 1'-0"

SECTION B 43

SCALE: $\frac{1}{4}$ " = 1'-0"

NOTES

The gasoline engines, Diesel engine, exhaust piping and silencers for pump engines, gear units, couplings, intake and discharge piping, 36" hydraulic operated gate valves, 16" hand operated gate valves, check valves and wall castings, were furnished by the government.

Installing equipment furnished by the government was paid for under Item No. 26.

Furnishing and installing travelling crane were paid for under Item No. 19.

KEY	DATE	REVISION (Indicated by Δ)	REV. BY	CK. BY	AP. BY

RECORD
DRAWINGS

CONNECTICUT RIVER FLOOD CONTROL

KEENEY LANE PUMPING STATION

GENERAL ARRANGEMENT OF EQUIPMENT NO. 3

CONNECTICUT RIVER CONNECTICUT

IN 60 SHEETS SCALE: 1/4 IN. = 1 FT. SHEET NO. 44

U. S. ENGINEER OFFICE, PROVIDENCE, R.I., JUNE 1944

SUBMITTED: APPROVED: RECOMMENDED: APPROVED:

HEAD, MECHANICAL SECTION HEAD, ENGINEER CHIEF, ENGINEERING DIV. DISTRICT ENGINEER

DRAWN: J. P. K. TRACED: S. H. B. CHECKED: S. H. B. FILE NO. CT-4-3258