


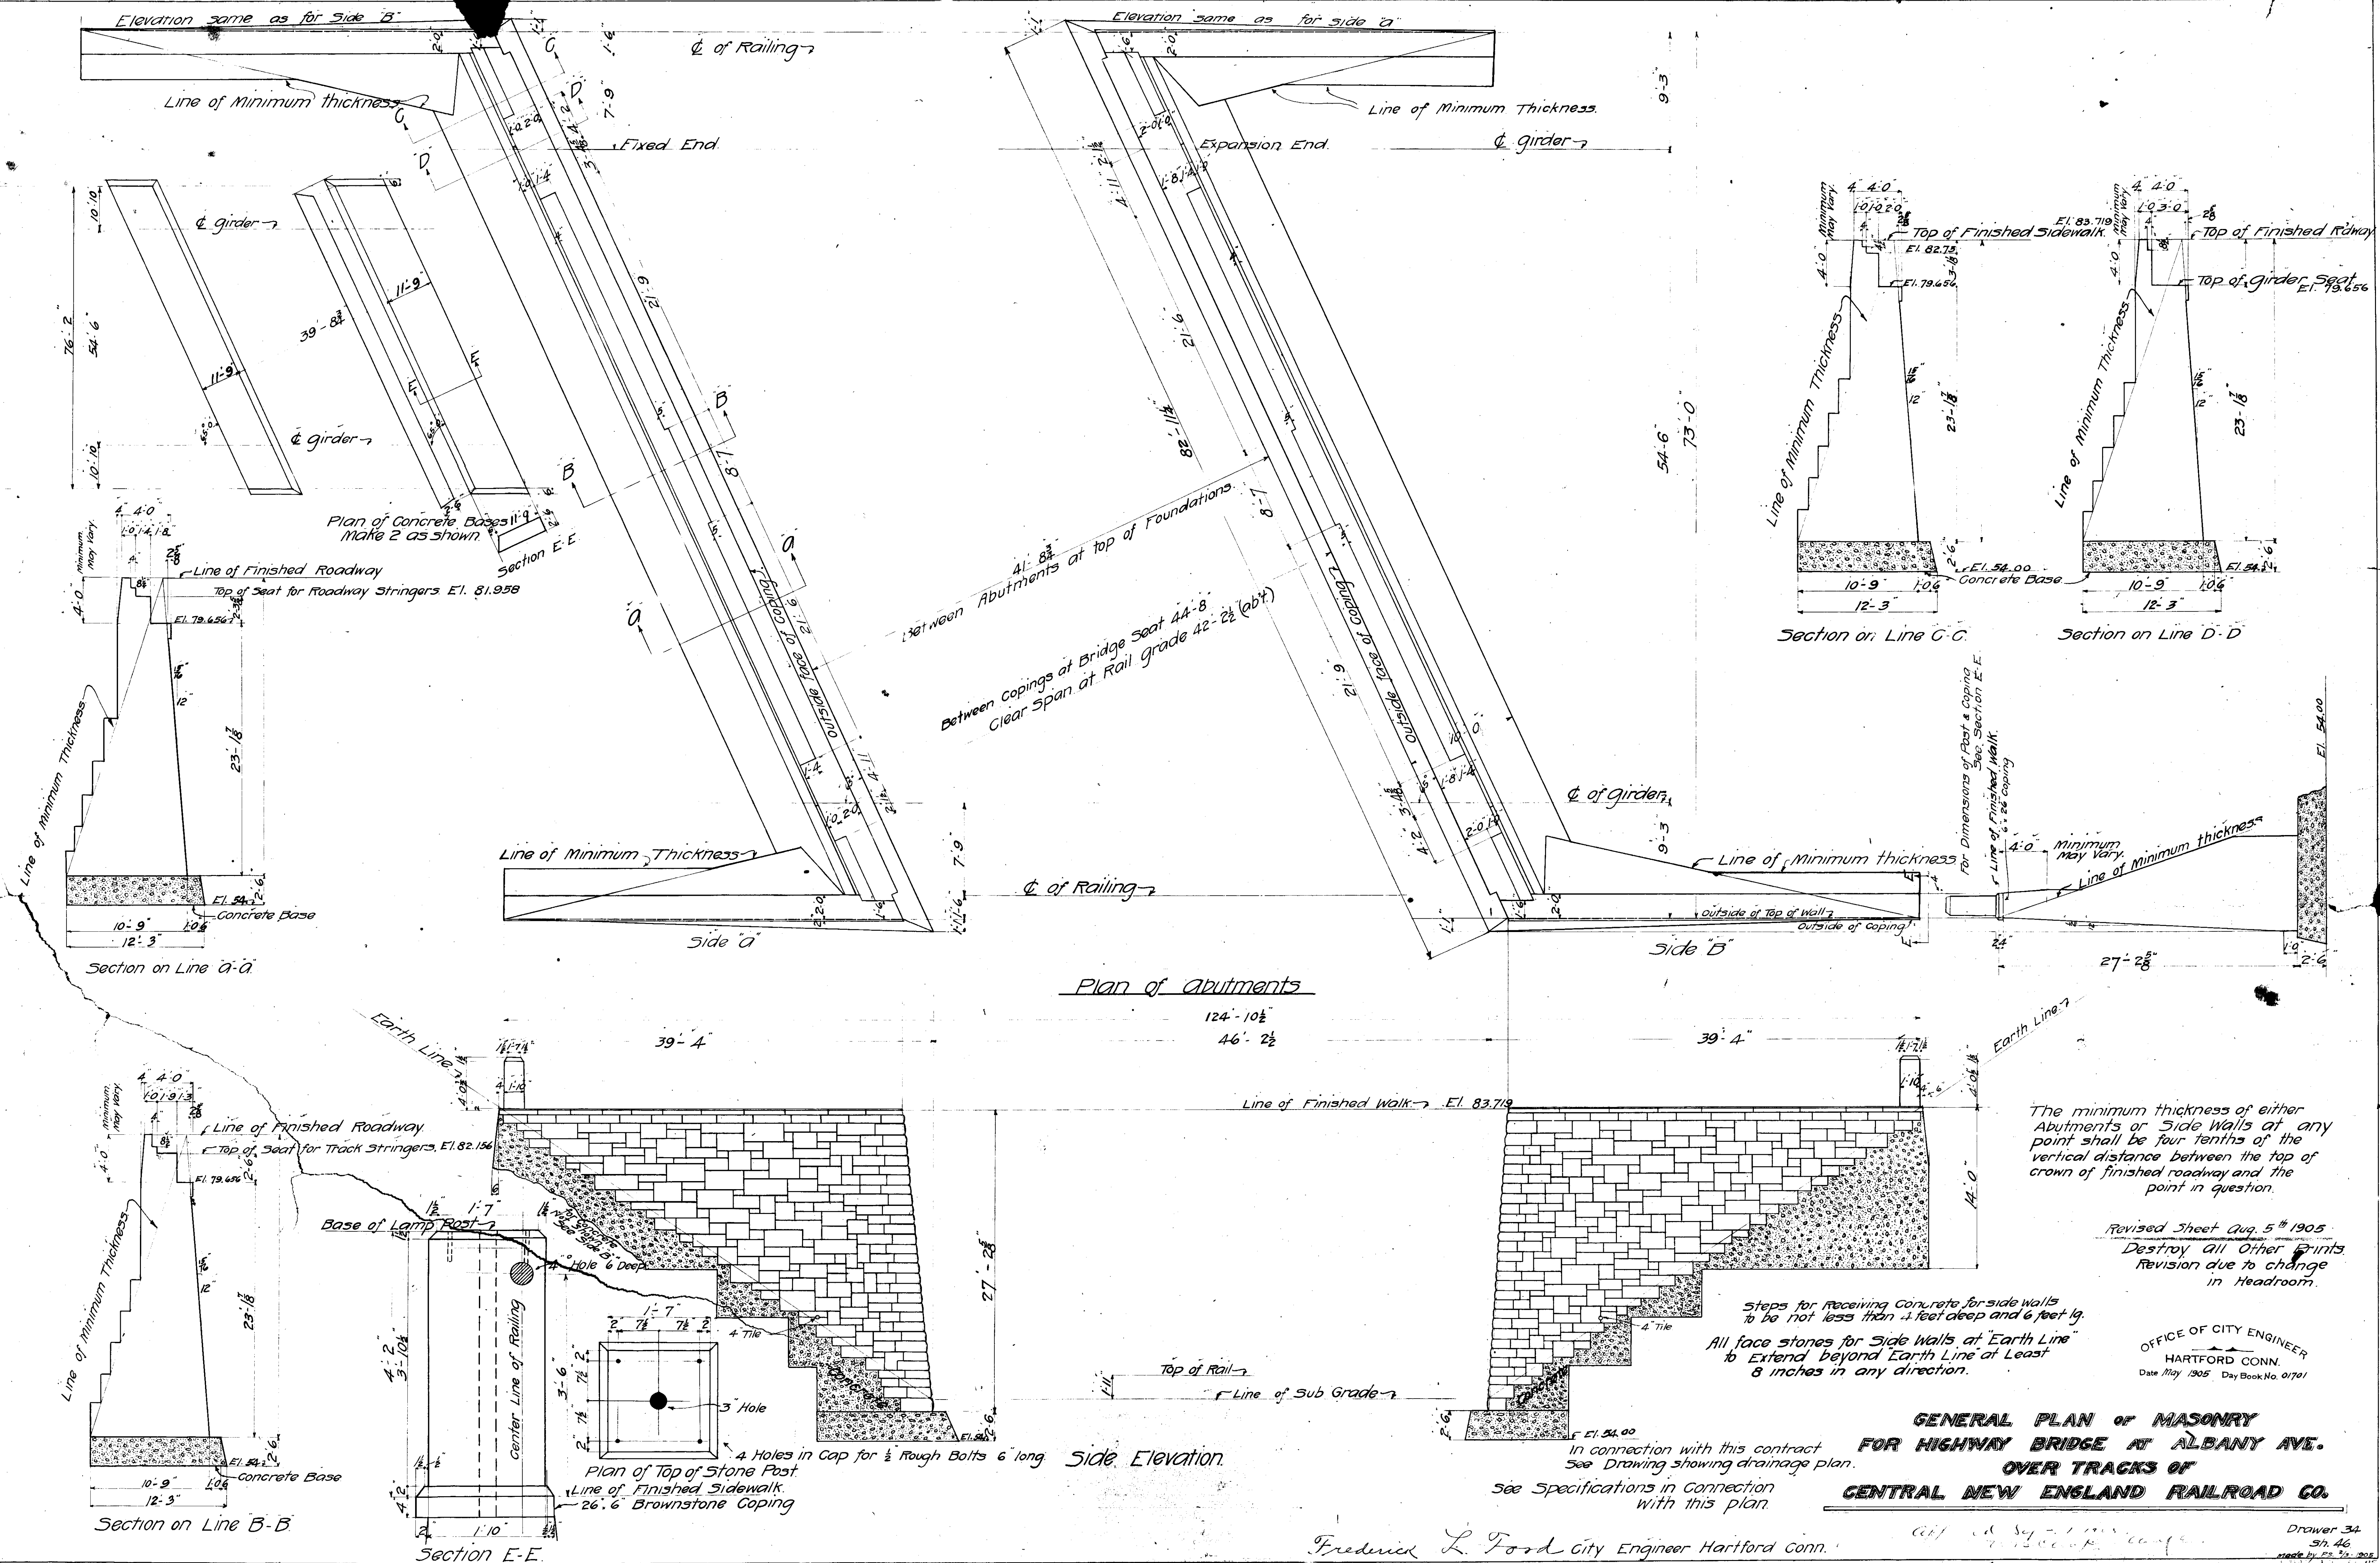

The minimum thickness of either Abutments or Side Walls at any point shall be four tenths of the vertical distance between the top of crown of finished roadway and the point in question.

Revised Sheet Aug. 5th 1905.
Destroy all other prints
Revision due to change
in Headroom.

OFFICE OF CITY ENGINEER
HARTFORD CONN.
Date *May 1905* Day Book No. *0170*

Steps for Receiving Concrete for side Walls
to be not less than 4 feet deep and 6 feet lg.

All face stones for Side Walls at "Earth Line"
to Extend beyond Earth Line at Least
8 inches in any direction.

57.54.00
 In connection with this contract
 See Drawing showing drainage plan.
 See Specifications in connection
 with this plan.

**GENERAL PLAN of MASONRY
 FOR HIGHWAY BRIDGE AT ALBANY AVE.
 OVER TRACKS OF
 CENTRAL NEW ENGLAND RAILROAD CO.**

Frederick L. Good City Engineer Hartford Conn.

Drawer 34
Sh. 46.
made by P.S. 2/3-190