



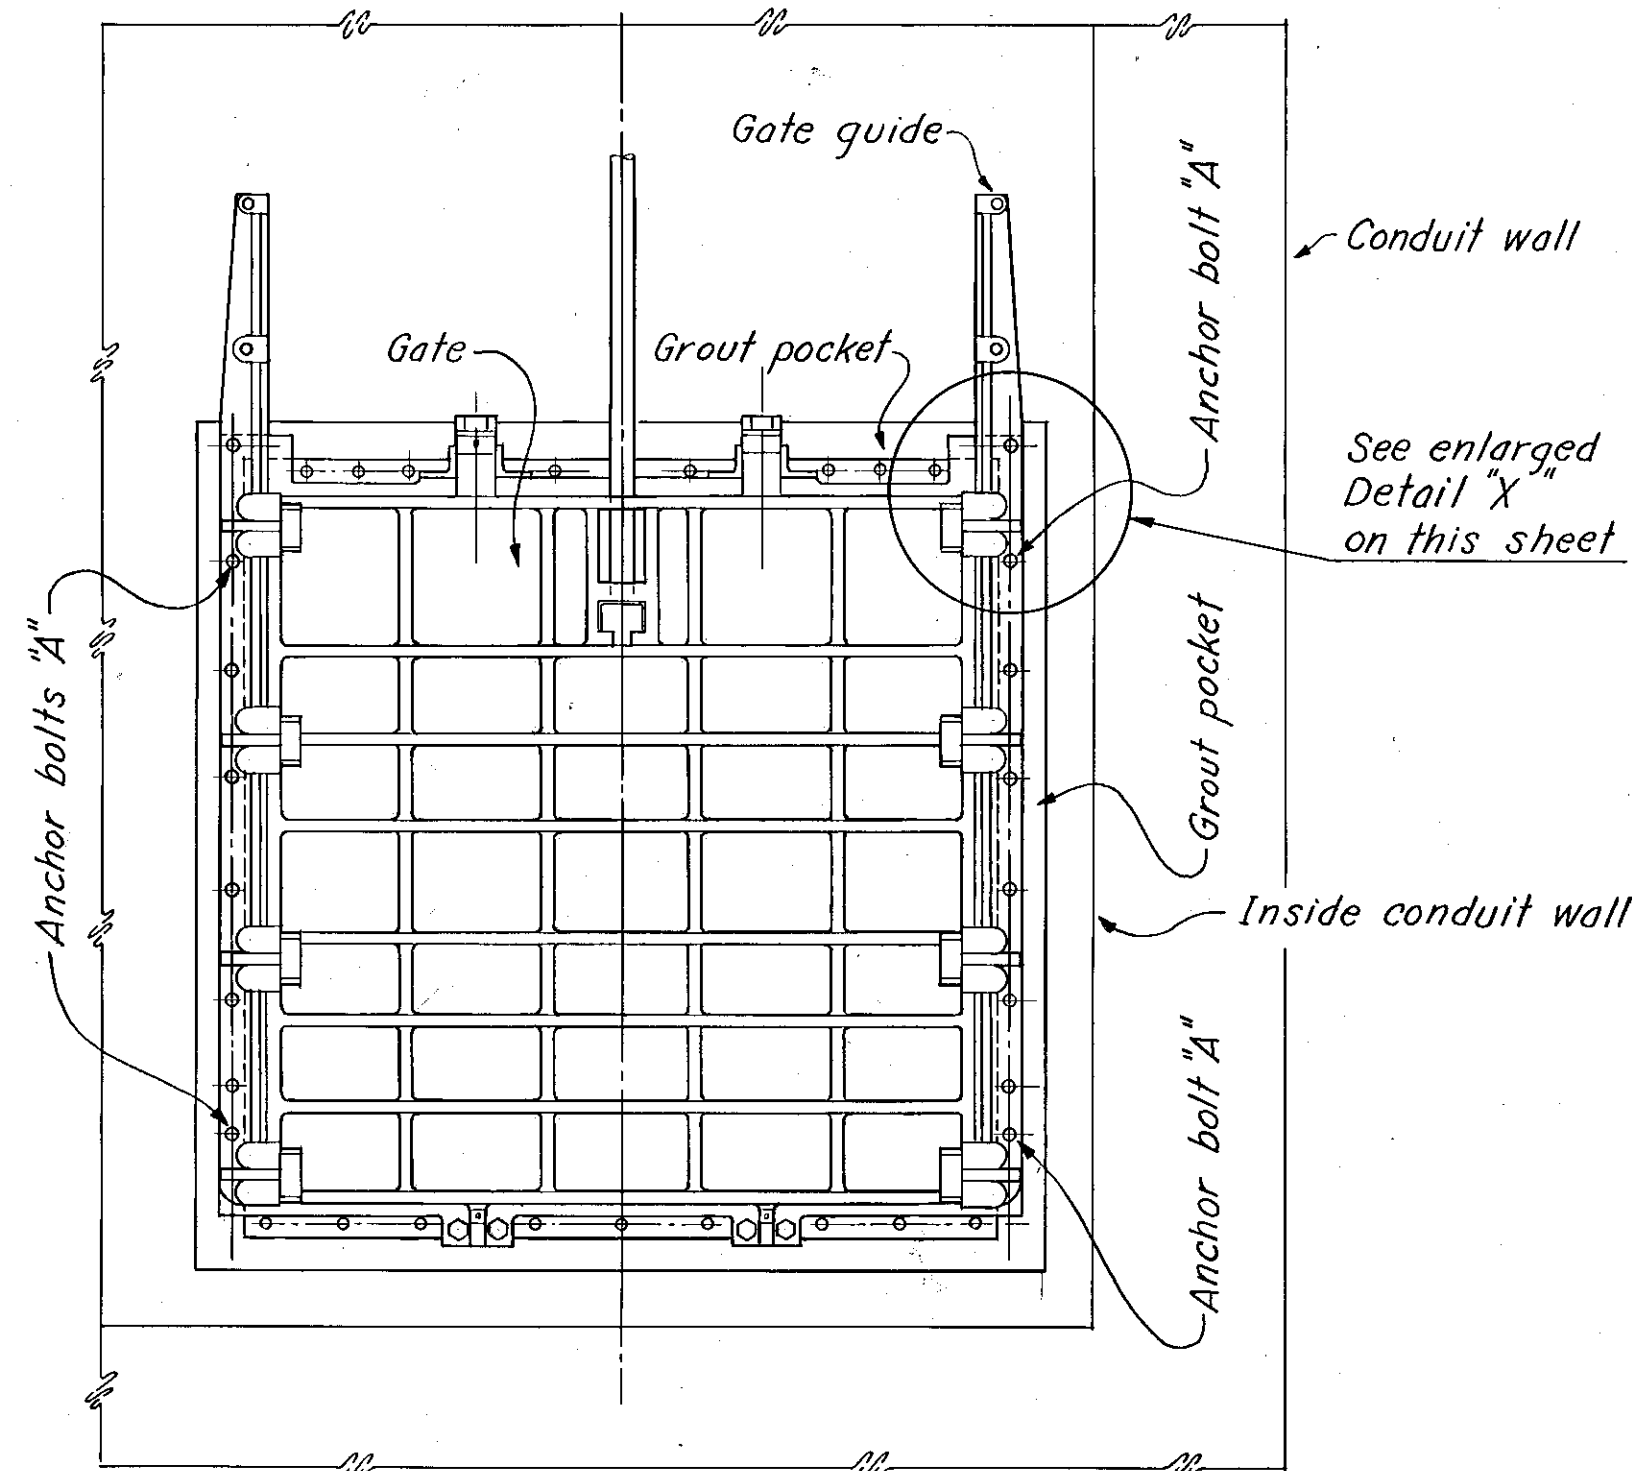


ELEVATION  
SLUICE GATE INSTALLATION

NOT TO SCALE

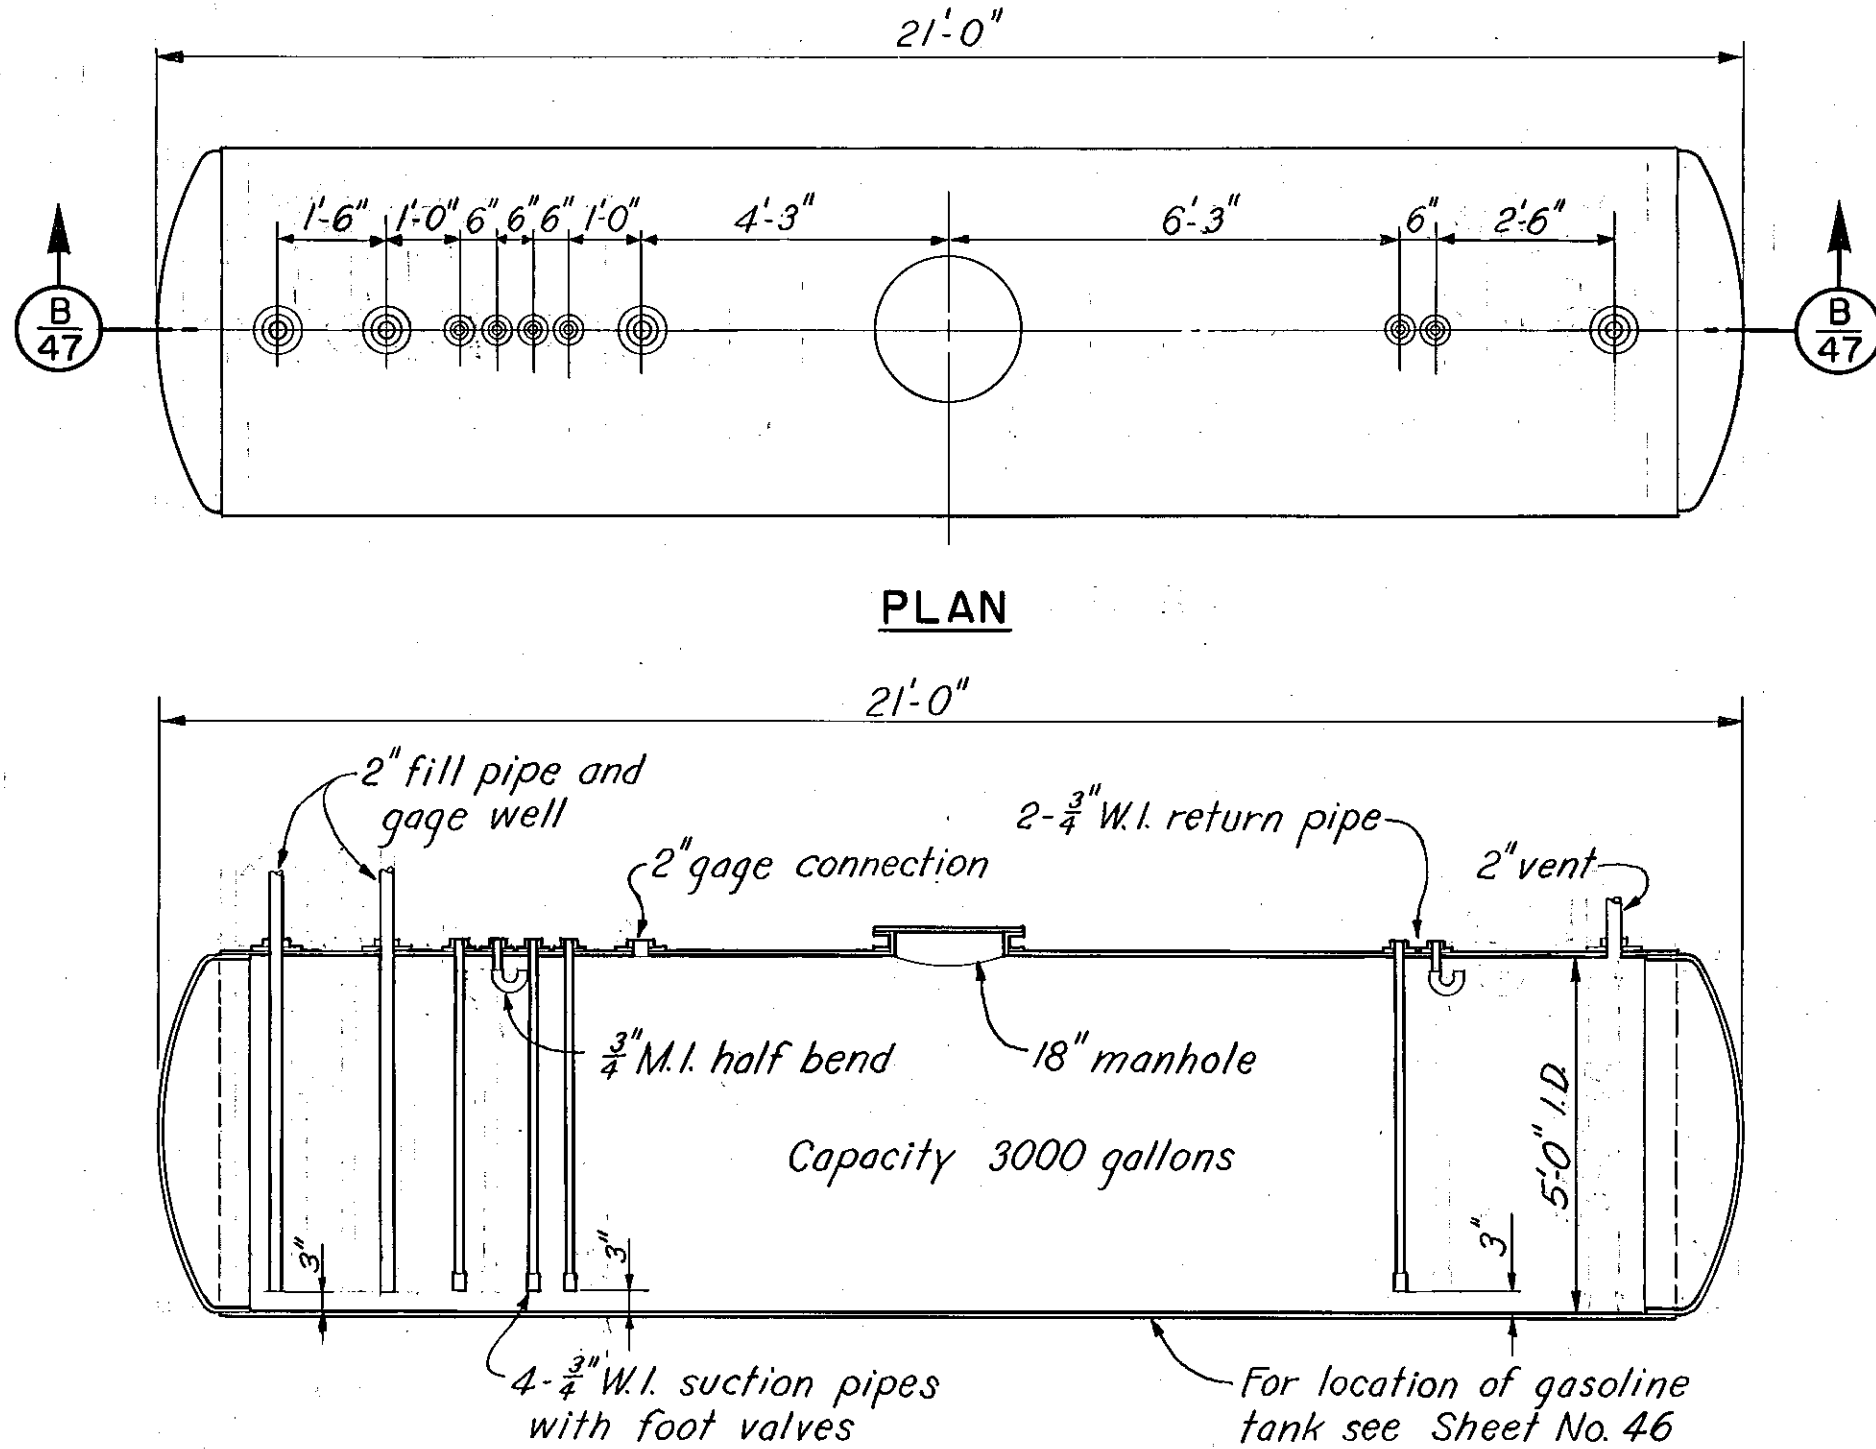


SECTION B 47  
GASOLINE TANK

SCALE: 3/8" = 1'-0"  
4' 0 4'

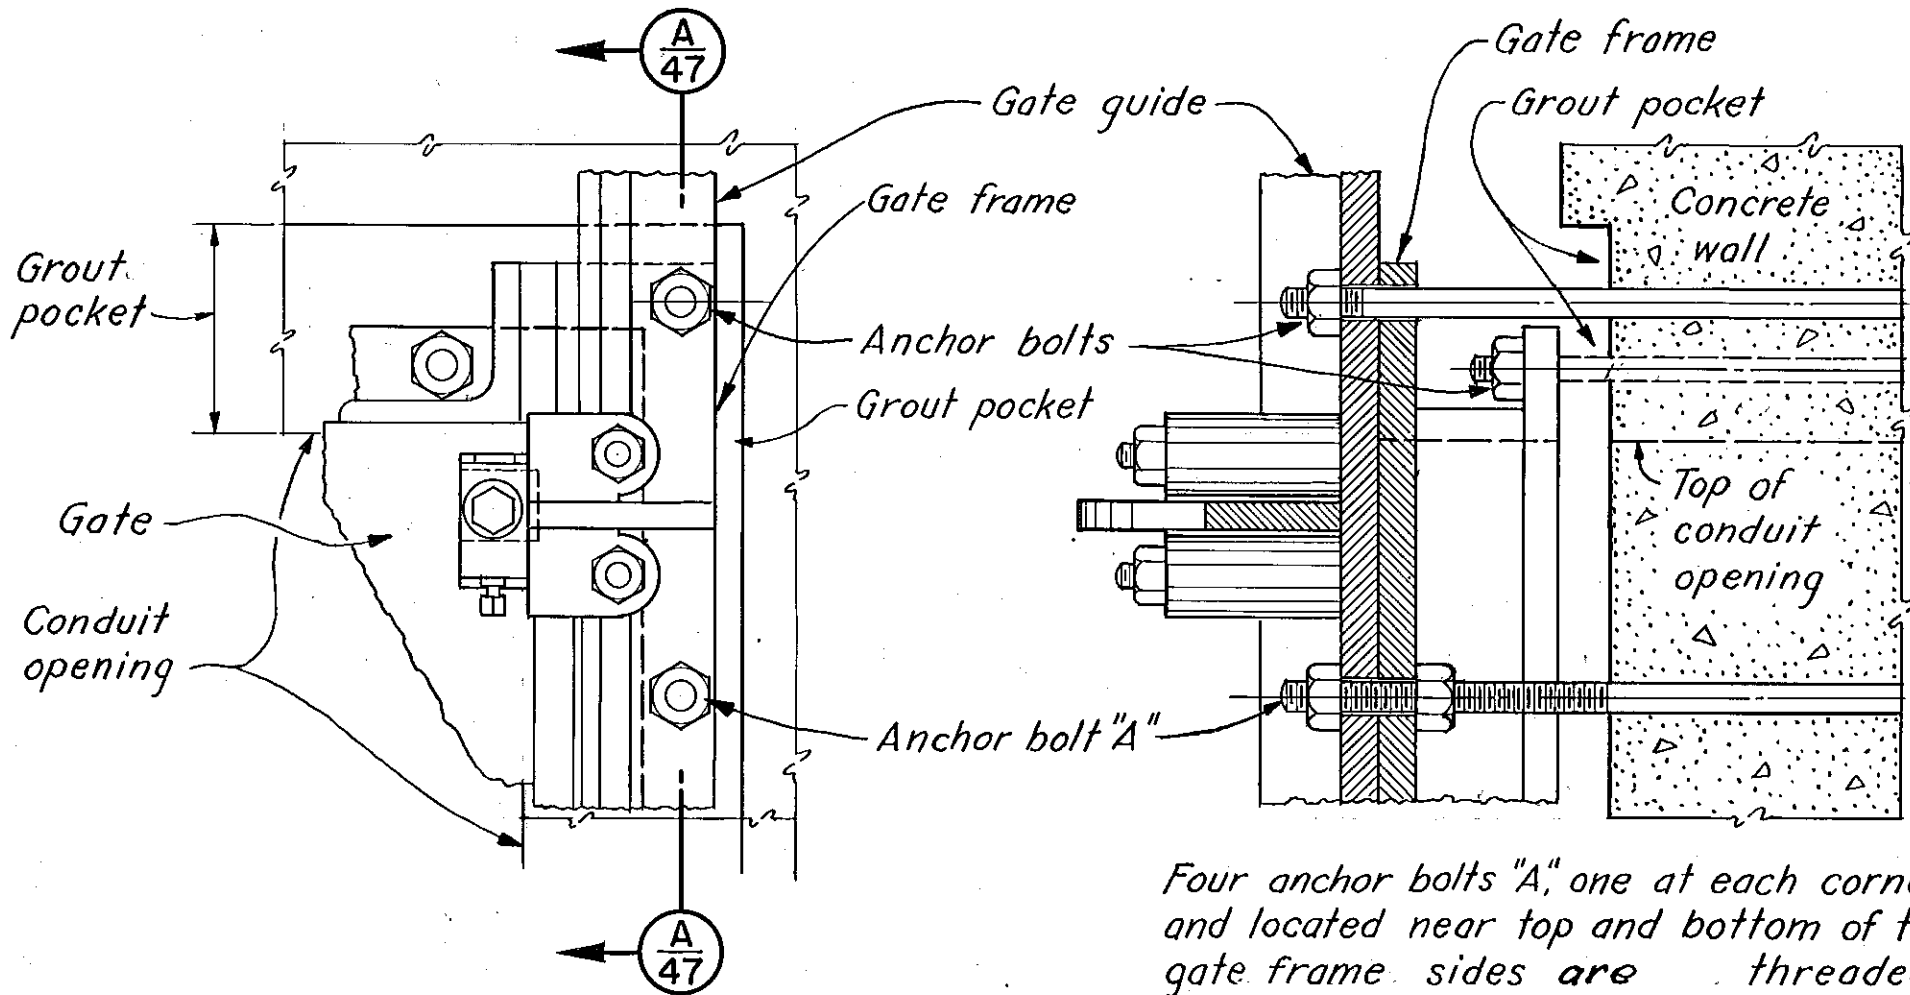


ELEVATION  
DETAIL X - SLUICE GATE INSTALLATION

SCALE: 1 1/2" = 1'-0"  
12" 9" 6" 3" 0 6" 12"

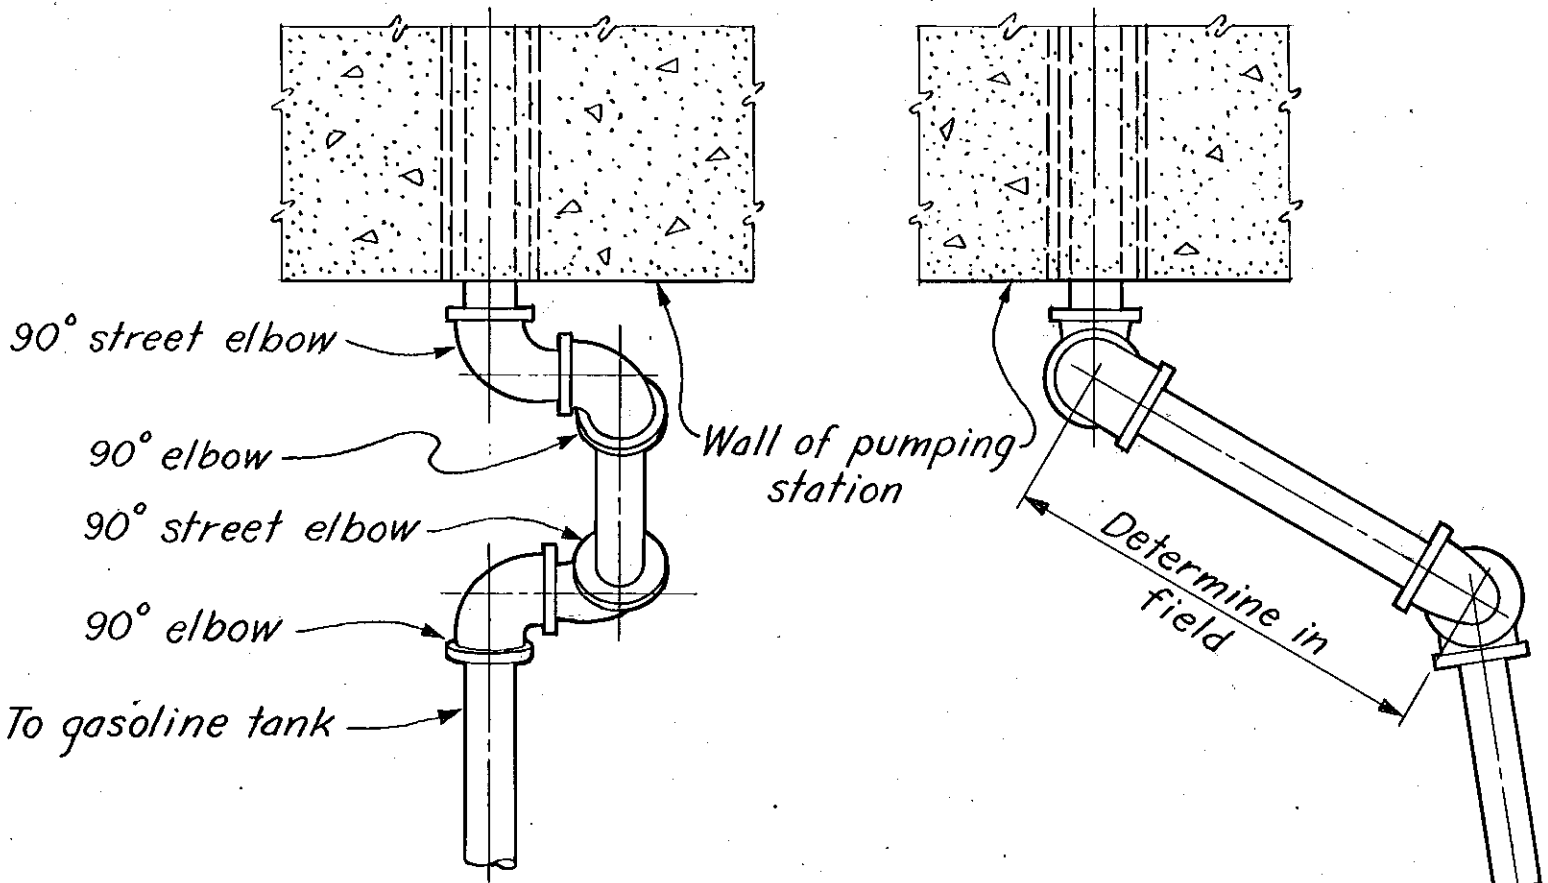


PLAN  
ELEVATION  
Note: Install and adapt this type swing connection on all supply, return and vent lines.  
DETAIL OF SWING CONNECTION

SCALE: 3" = 1'-0"

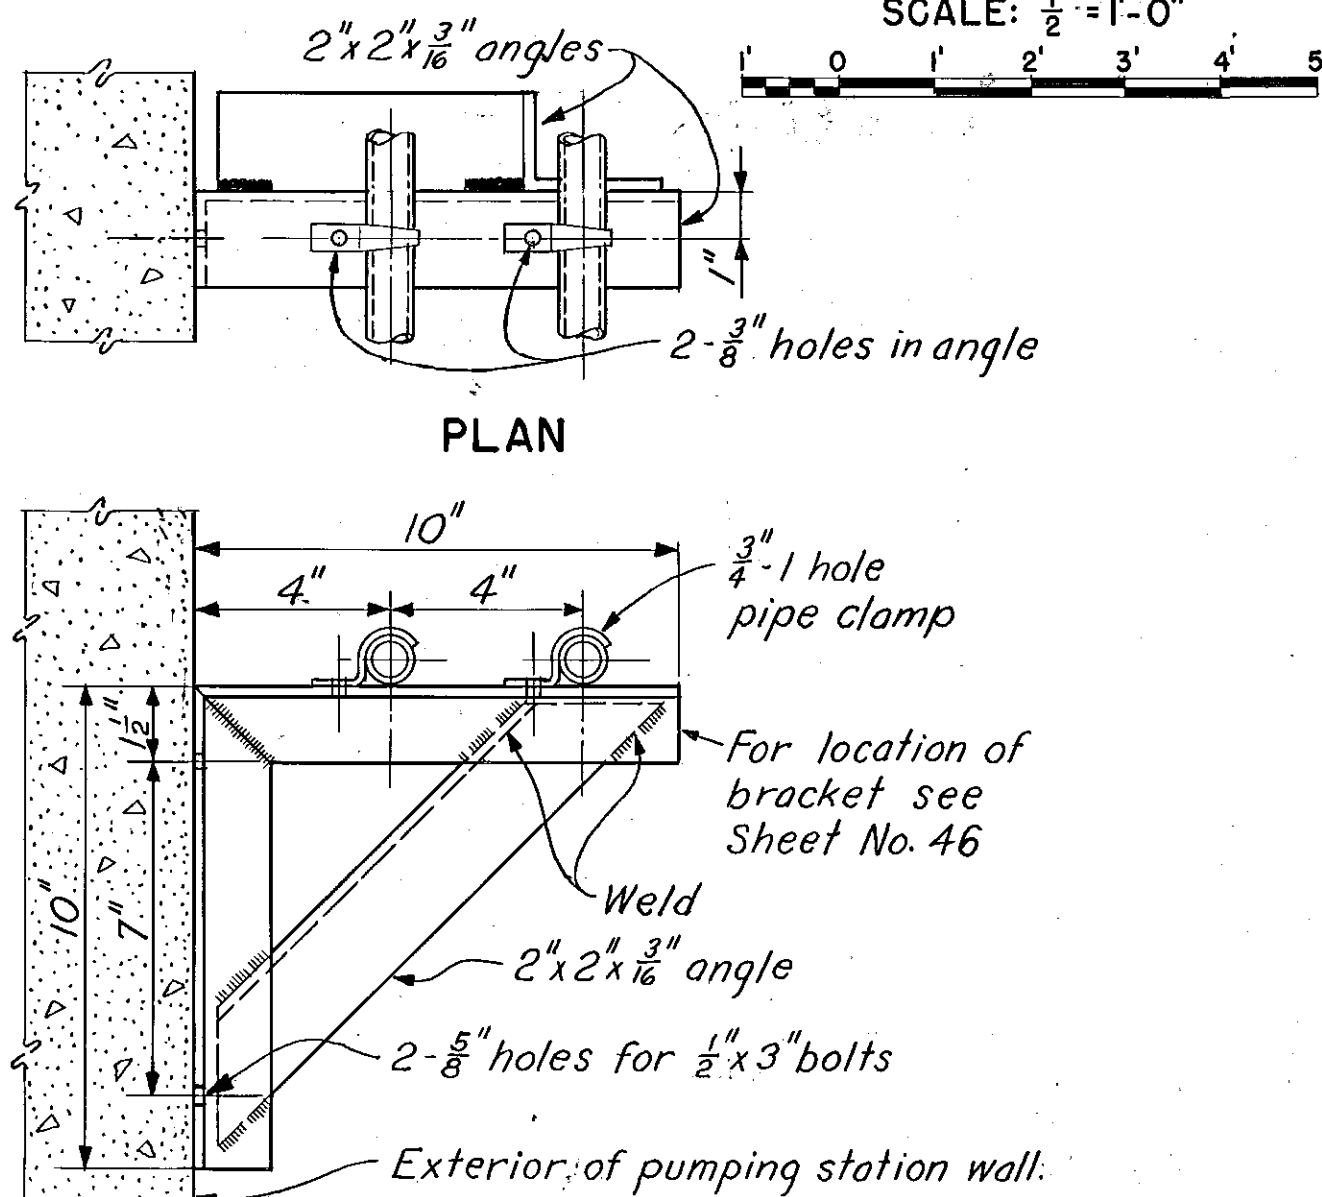

DETAIL - BRACKET

SCALE: 3" = 1'-0"  
3" 0 3" 6" 9"

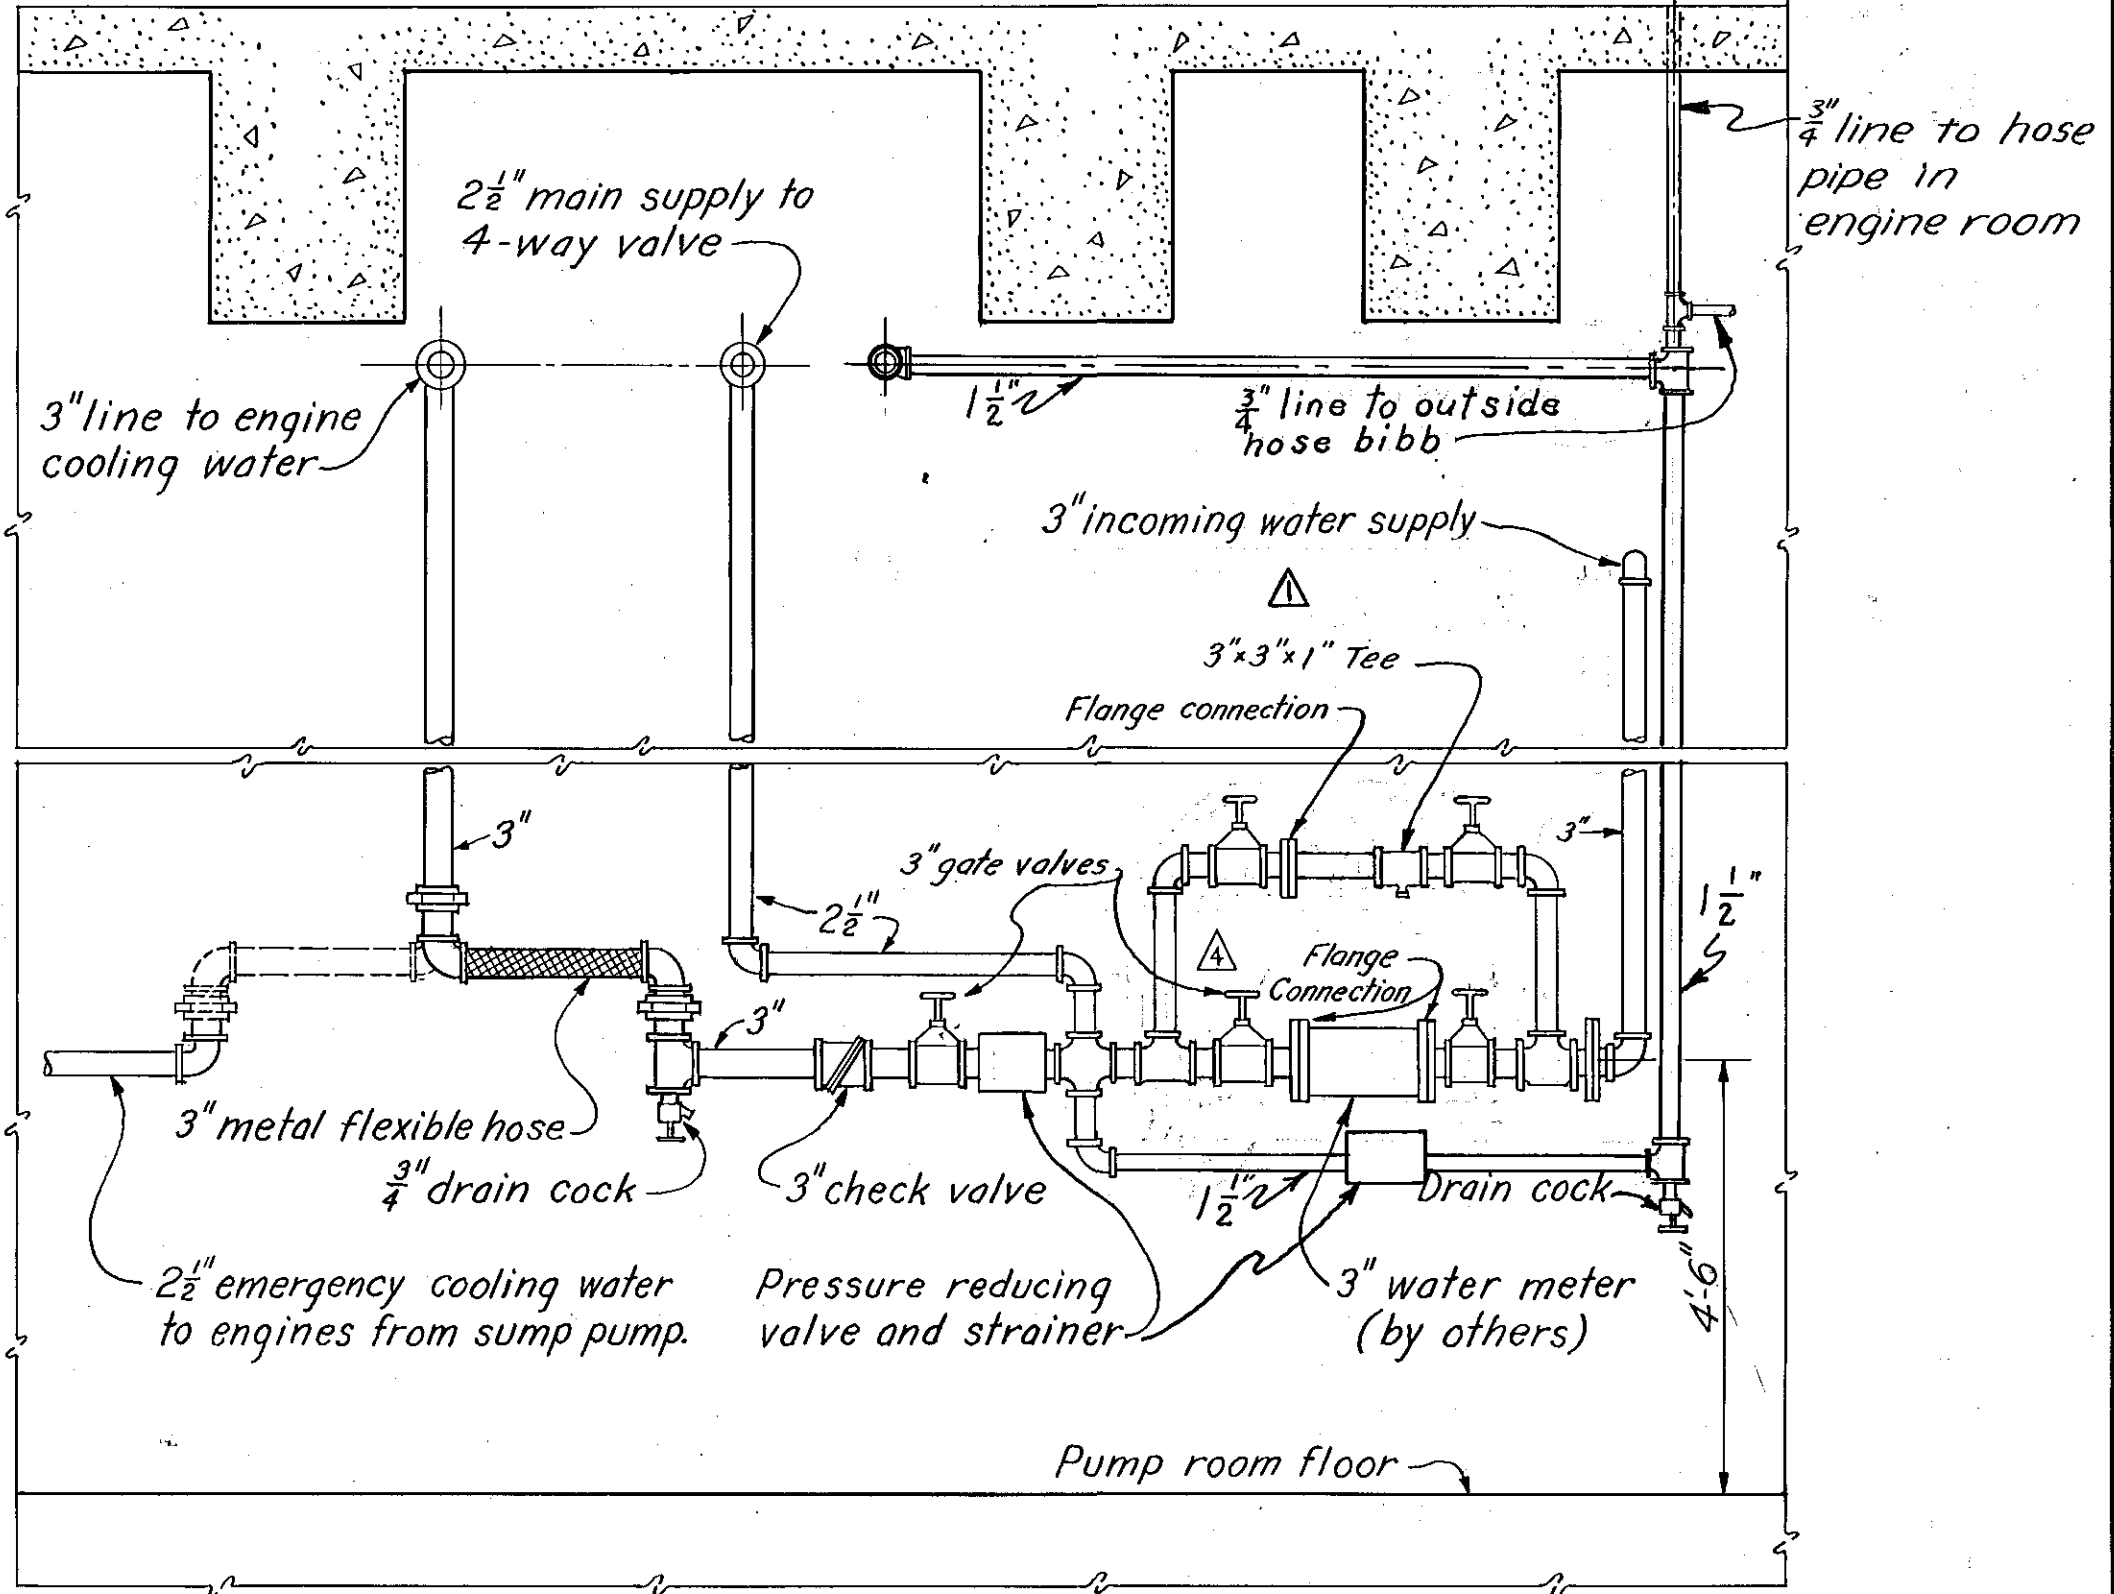

SECTION A 49

SCALE: 1 1/2" = 1'-0"  
1' 0 1' 2' 3' 4' 5'

RECORD  
DRAWINGS

CONNECTICUT RIVER FLOOD CONTROL  
KEENEY LANE PUMPING STATION  
HARTFORD, CONN.  
GENERAL INSTALLATION DETAILS

CONNECTICUT RIVER CONNECTICUT  
IN 60 SHEETS SCALE AS SHOWN SHEET NO. 47

U.S. ENGINEER OFFICE, PROVIDENCE, R.I., JUNE 1944

SUBMITTED: APPROVAL RECOMMENDED: APPROVED:  
HEAD MECHANICAL SECTION SENIOR ENGINEER HEAD ENGINEER COL. COMPS OF ENGINEERS  
PREPARED: TRACED: S.H.B. CHECKED: MECHANICAL SUBSECTION FILE NO. CT-4-3300

|     |            |                                    |         |        |        |
|-----|------------|------------------------------------|---------|--------|--------|
| KEY | DATE       | REVISION (Indicated by Δ)          | REV. BY | CK. BY | AP. BY |
| Δ   | 15 Sept 49 | Water meter bypass                 |         |        |        |
| Δ   | 27 June 47 | Connection to exist. water service |         |        |        |