
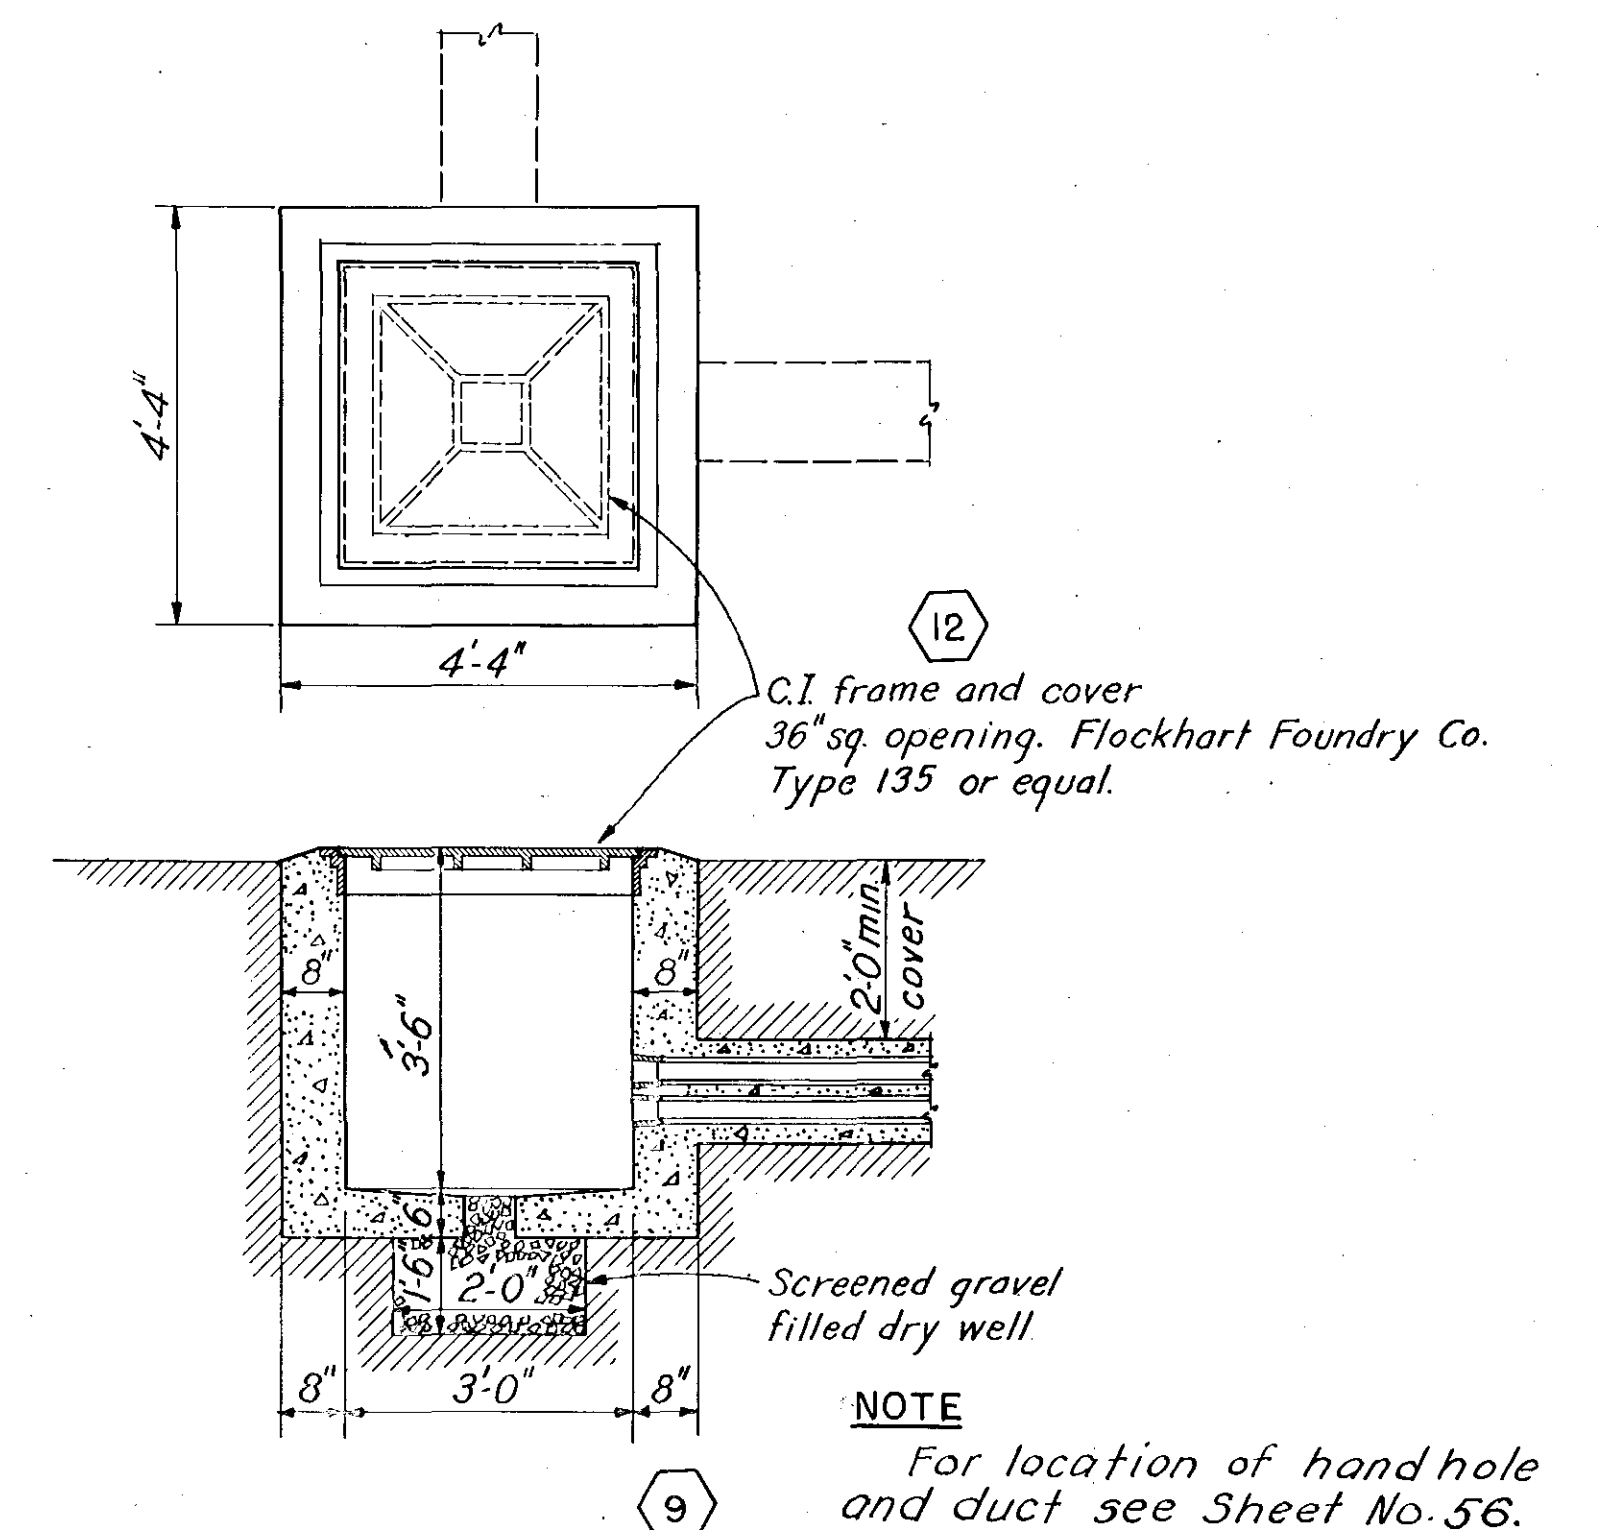
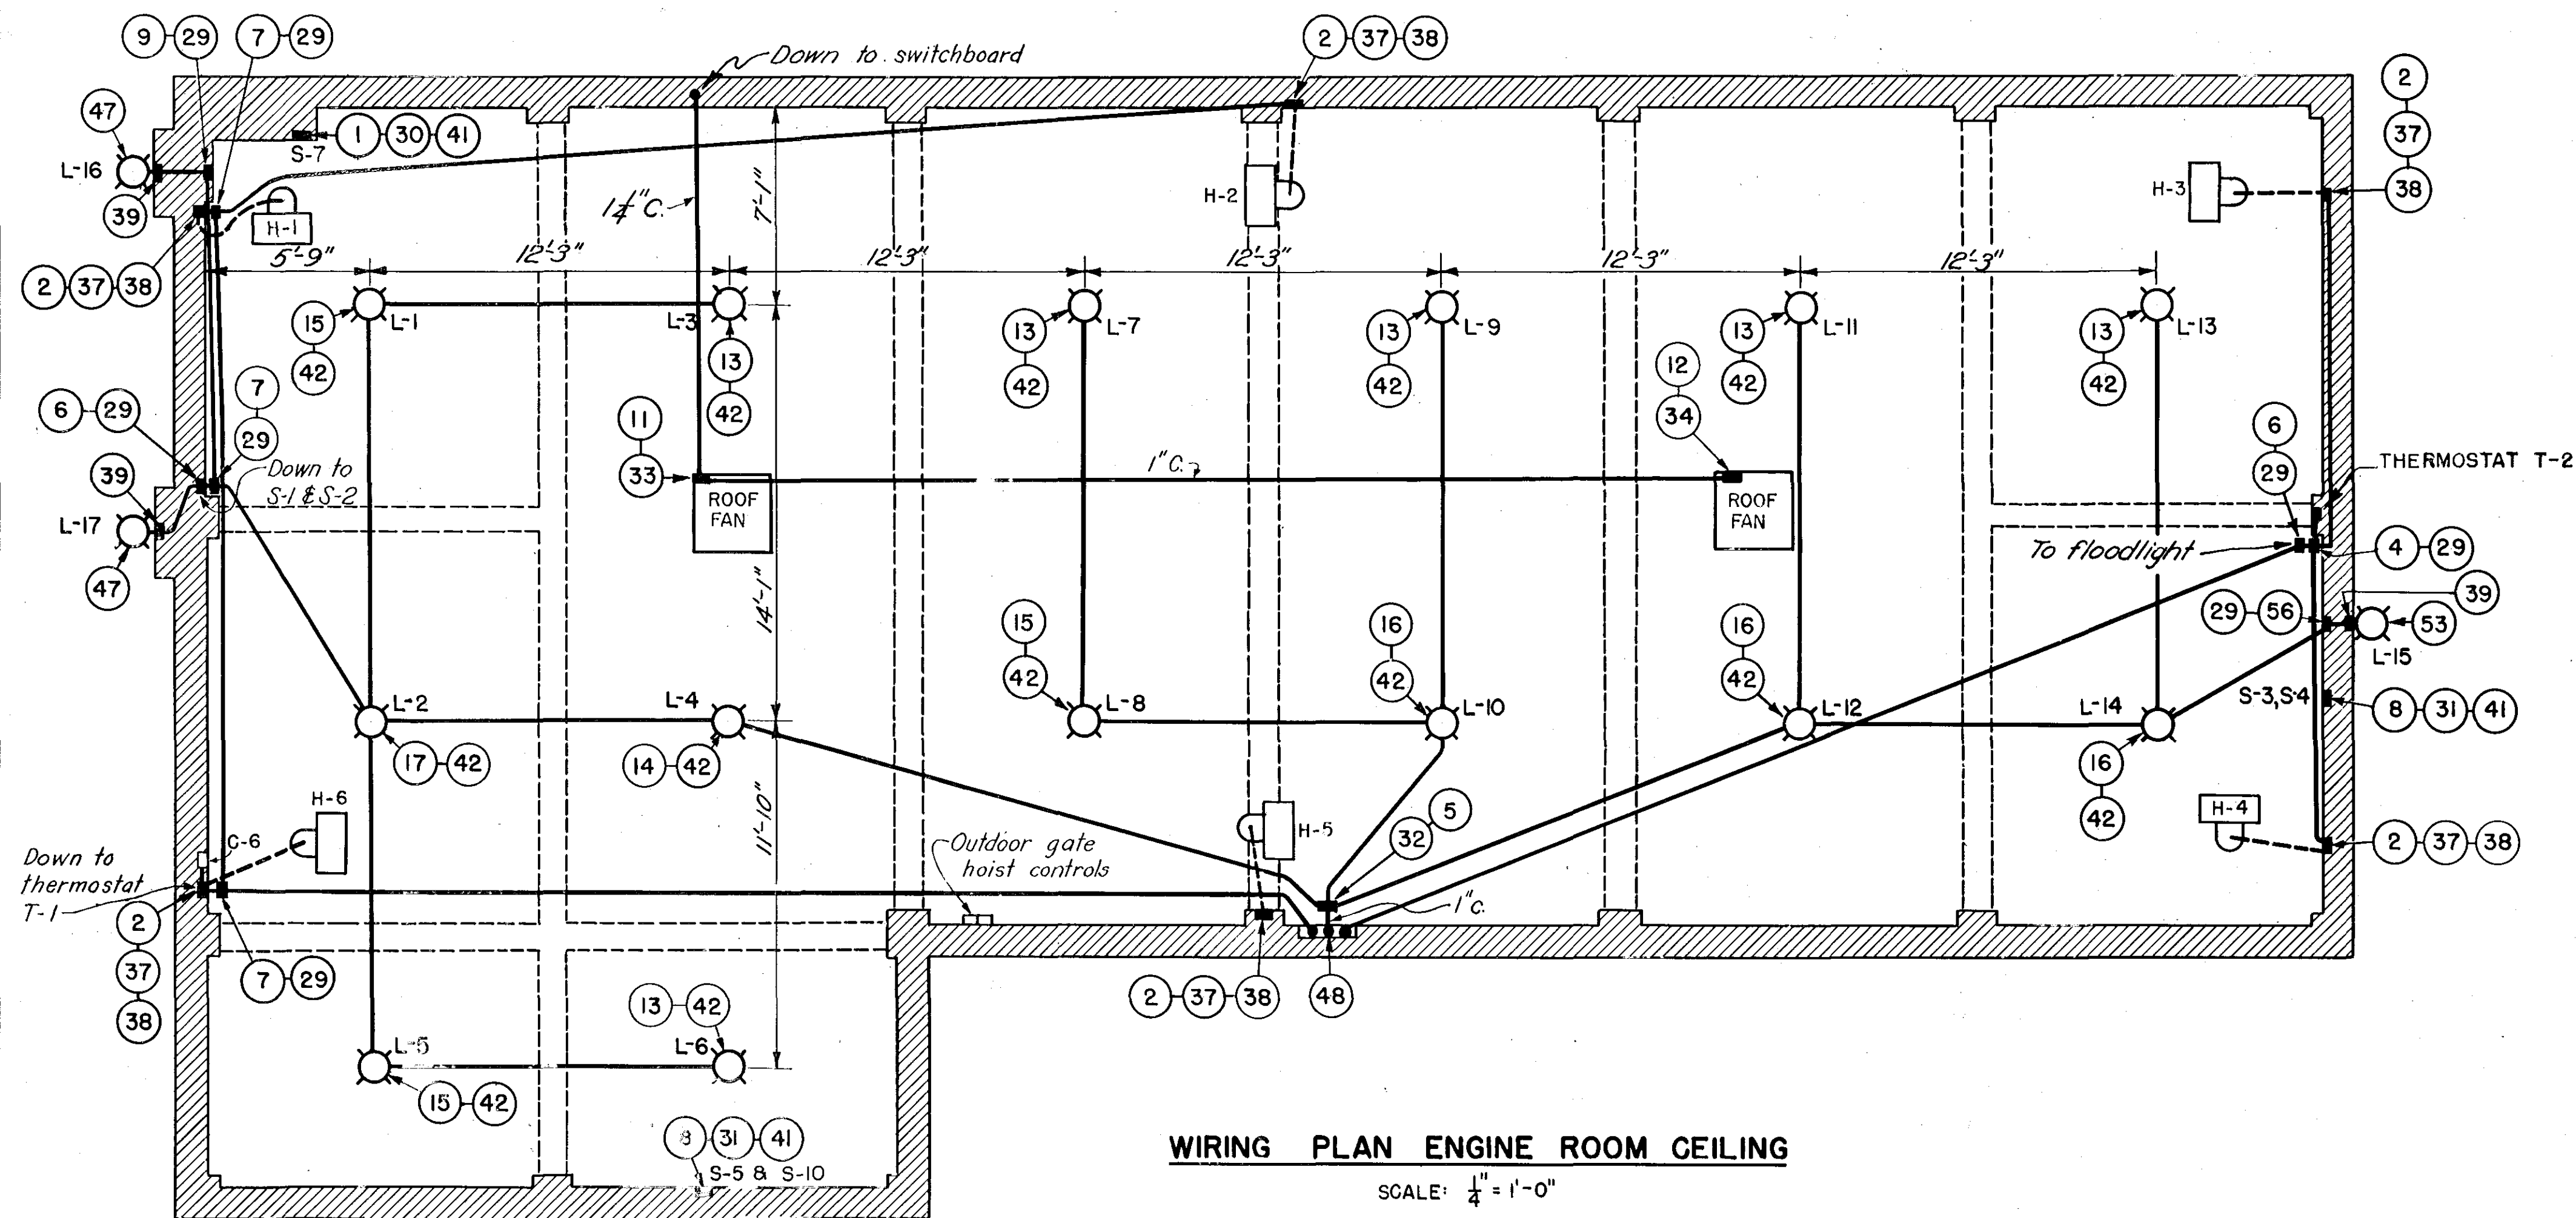
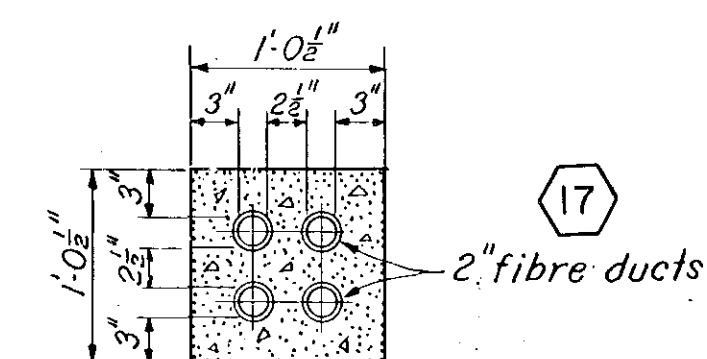


SCALE: $\frac{1}{2}'' = 1'-0''$

0 1 2 3 4 5



SCALE: $1'' = 1'-0''$

0 1 2

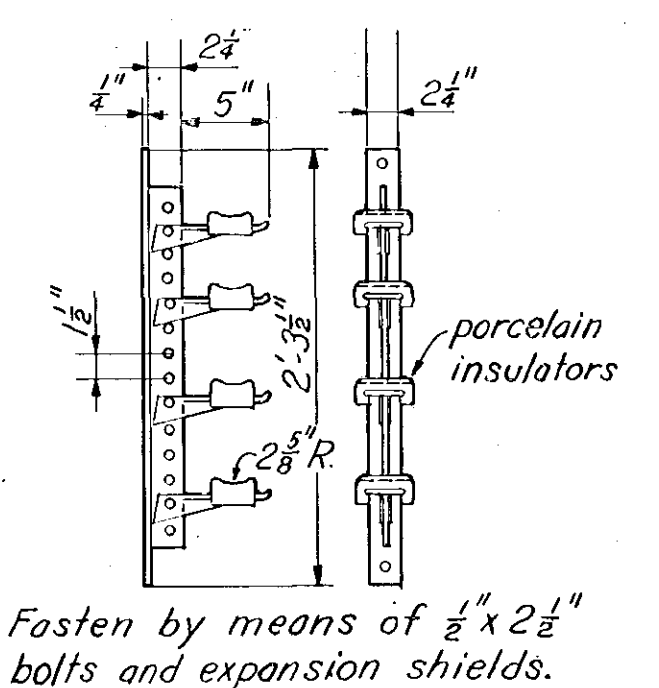

NOTE


For general notes and legend see Sheet No. 53.

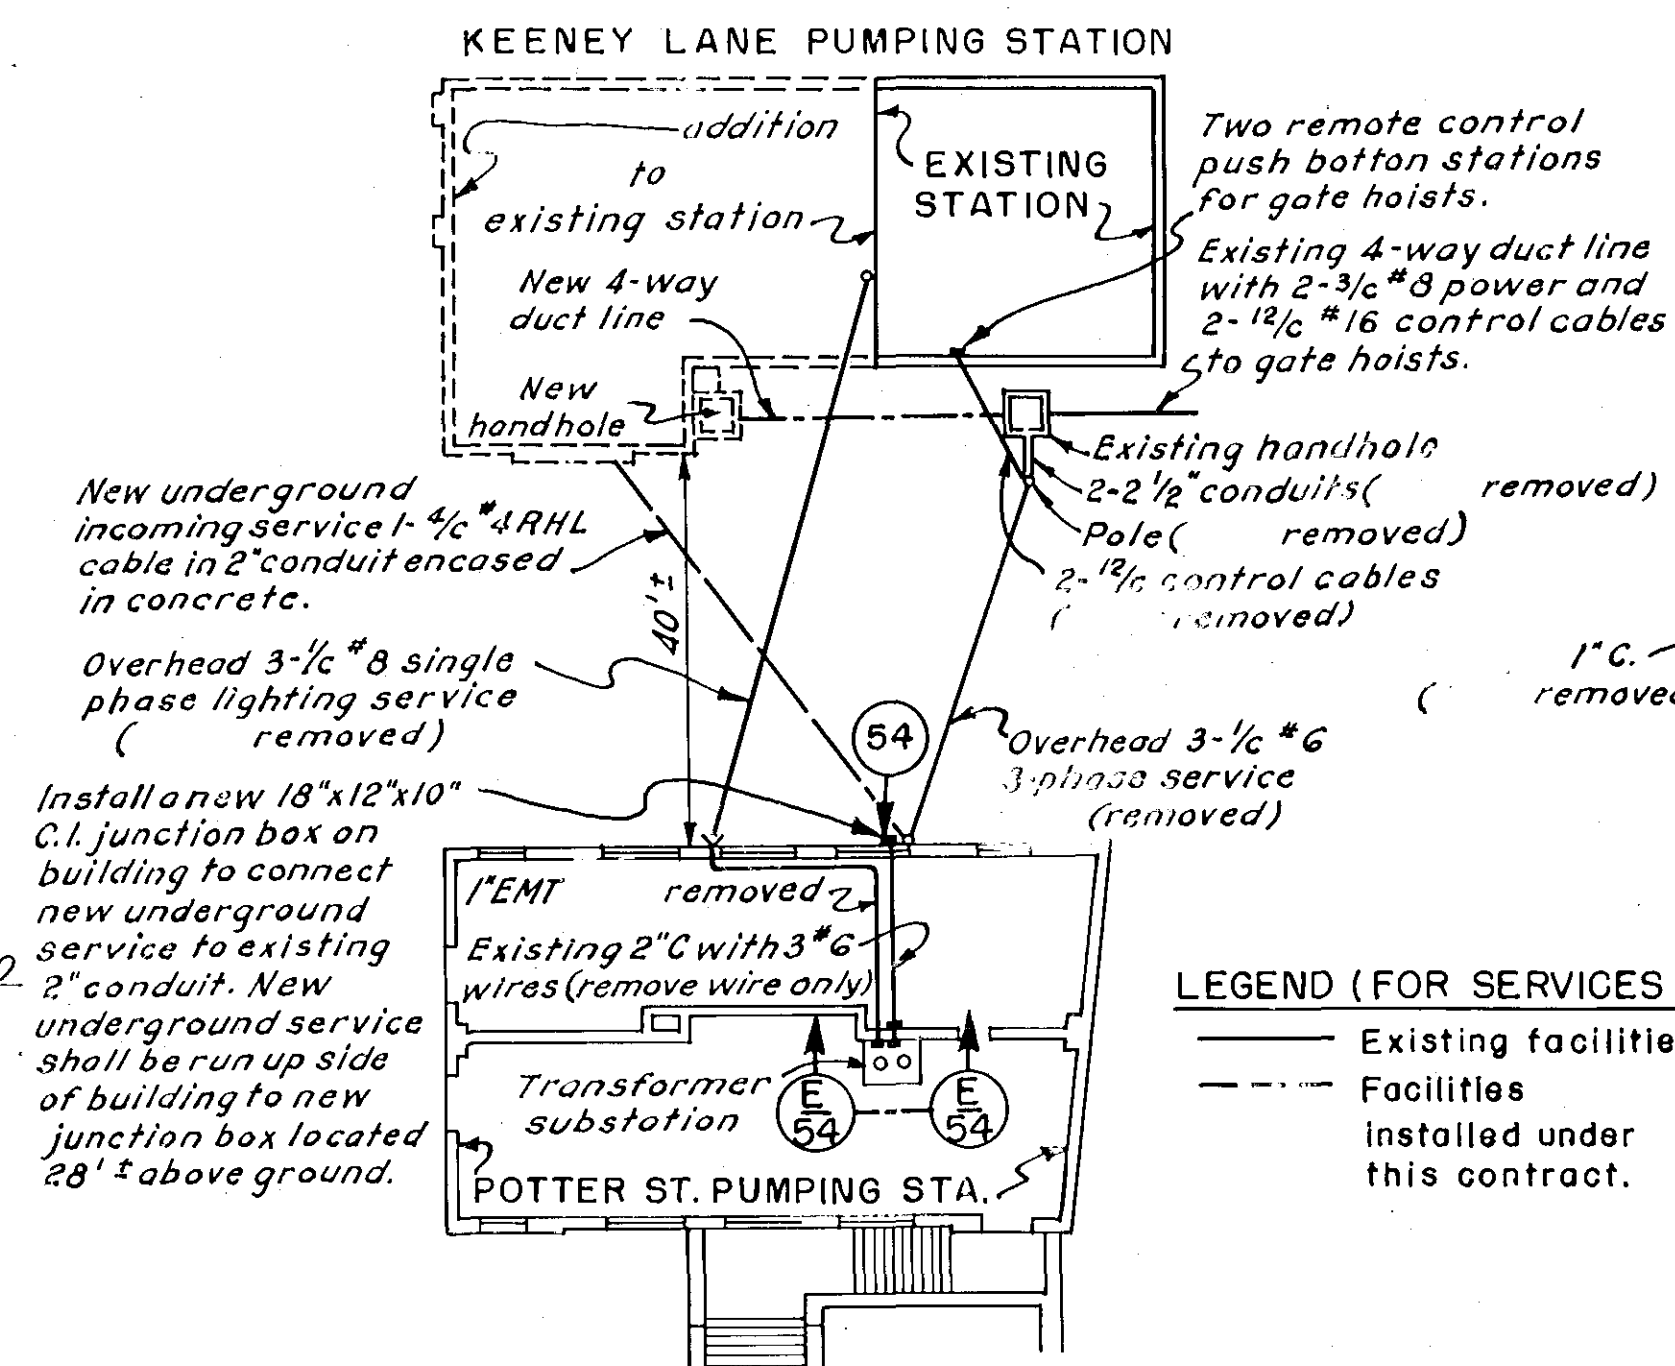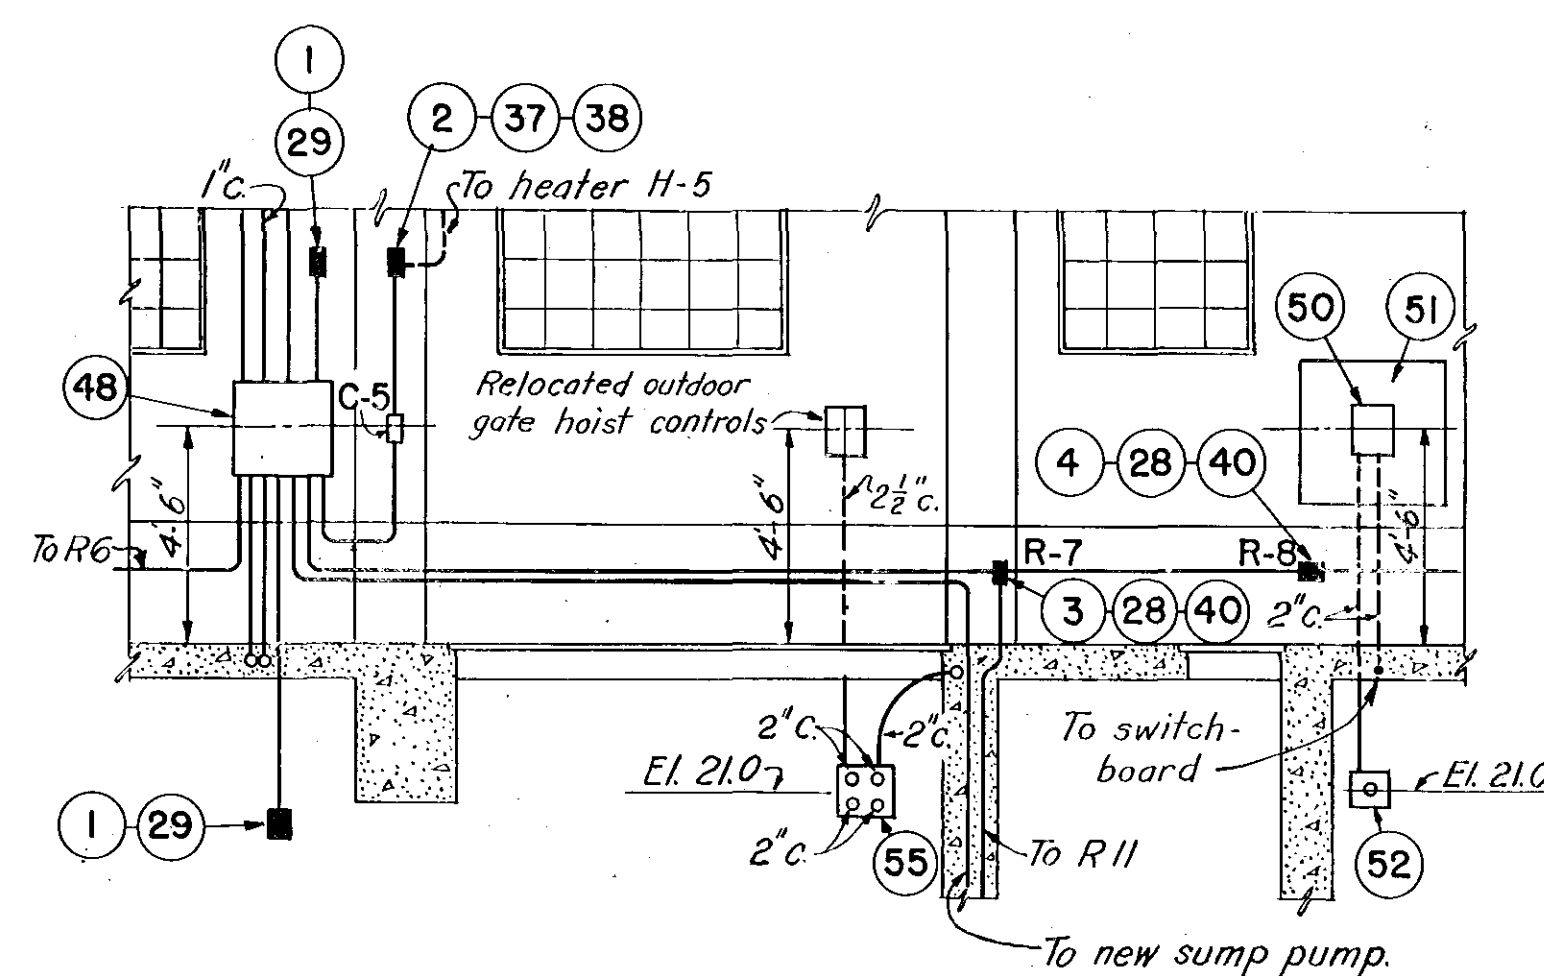

LEGEND (FOR SERVICES ONLY)

— Existing facilities
- - - Facilities installed under this contract.

SECTION E-54
SCALE: $\frac{1}{4}'' = 1'-0''$

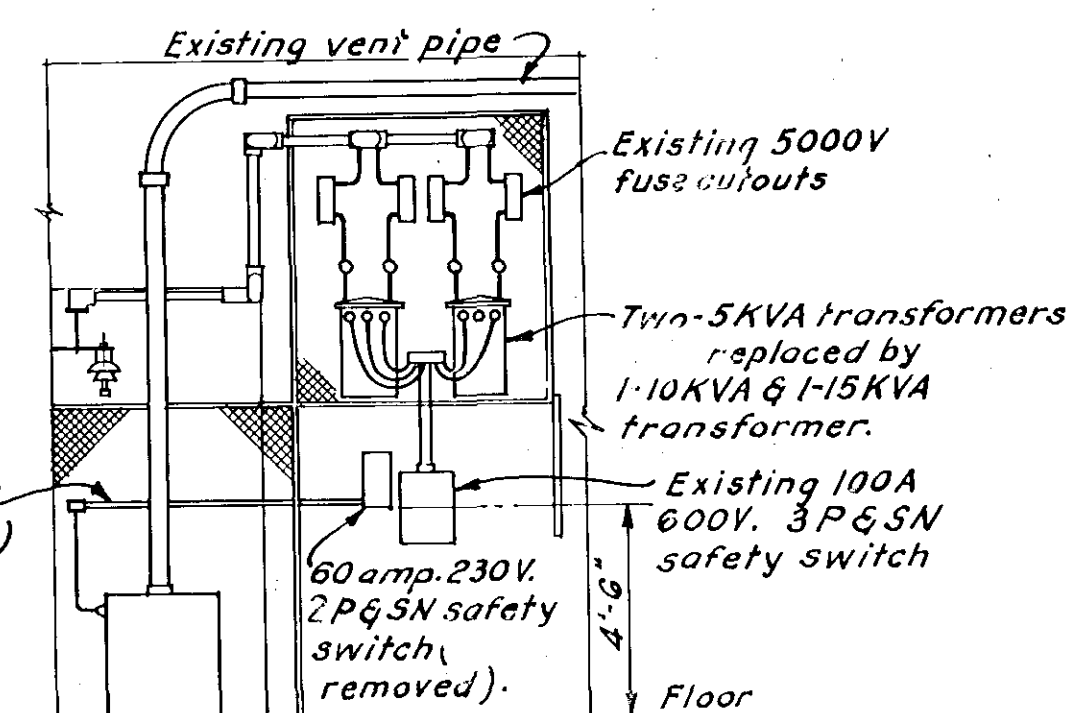RECORD
DRAWINGS

KEY	DATE	REVISION (Indicated by Δ)	REV. BY	CK. BY	AP. BY

CONNECTICUT RIVER FLOOD CONTROL		
KEENEY LANE PUMPING STATION		
HARTFORD, CONN.		
ELECTRIC LIGHT AND POWER SYSTEM NO. 2		
CONNECTICUT RIVER	CONNECTICUT	
IN 60 SHEETS	SCALE: $1/4'' = 1'-0''$	SHEET NO. 54
U.S. ENGINEER OFFICE, PROVIDENCE, R.I., JUNE 1944		
SUBMITTED:	APPROVAL RECOMMENDED:	APPROVED:
HEAD ENGINEER	HEAD ENGINEER	HEAD ENGINEER
HEAD MECHANICAL SECTION	CHIEF, ENGINEERING DIV.	DISTRICT ENGINEER
PREPARED:	DRAWN:	TRACED:
ELEG. SUBSECTION	F. J. G.	A. B. / S.H.B.
	CHECKED:	FILE NO. CT-4-3267