


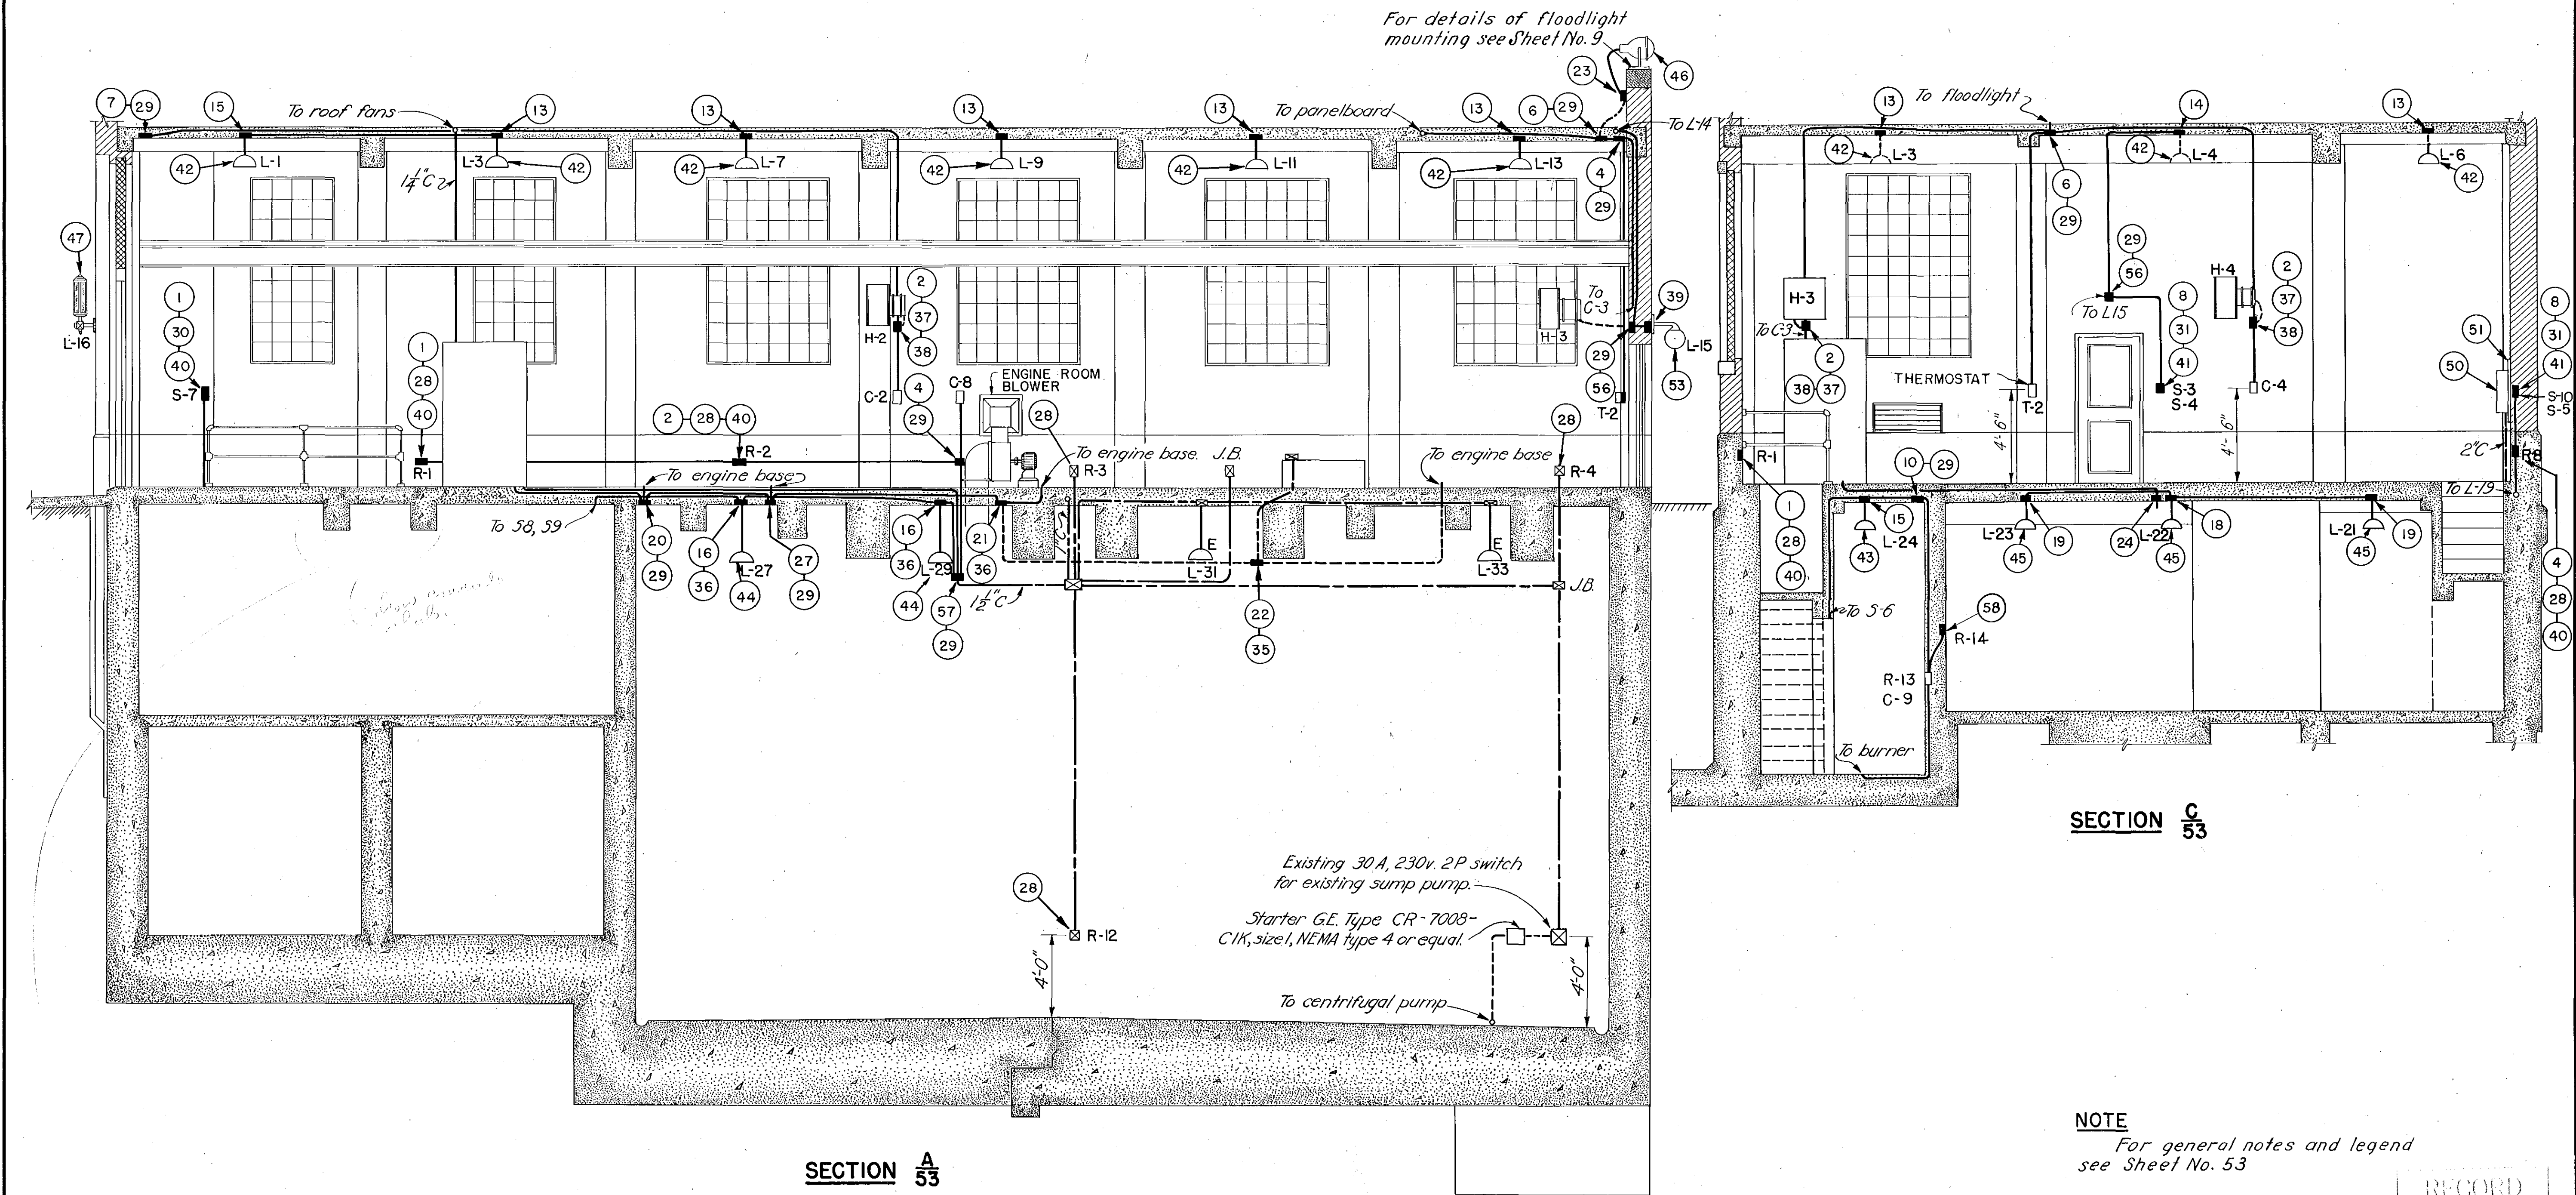

NOTE
For general notes and legend
see Sheet No. 53

RECORD
DRAWINGS

CONNECTICUT RIVER FLOOD CONTROL			
KEENEY LANE PUMPING STATION			
HARTFORD, CONN.			
ELECTRIC LIGHT AND POWER SYSTEM NO.3			
CONNECTICUT RIVER		CONNECTICUT	
IN 60 SHEETS		SCALE: 1/4 IN. = 1 FT.	
		SHEET NO. 55	
U. S. ENGINEER OFFICE, PROVIDENCE, R.I., JUNE 1944			
SUBMITTED: <i>H. J. Wagner</i>		APPROVED: <i>H. J. Wagner</i>	
SENIOR ENGINEER		HEAD ENGINEER	
HEAD MECHANICAL SECTION		CHIEF, ENGINEERING DIV.	
PREPARED: <i>E. S. Warner</i>		DRAWN: <i>F. J. G.</i>	
ELEG. SUBSECTION		TRACED: <i>A. B.</i>	
		CHECKED: <i>J. G.</i>	
		FILE NO. CT-4-3283	

KEY	DATE	REVISION (Indicated by Δ)	REV. BY	CK. BY	AP. BY