

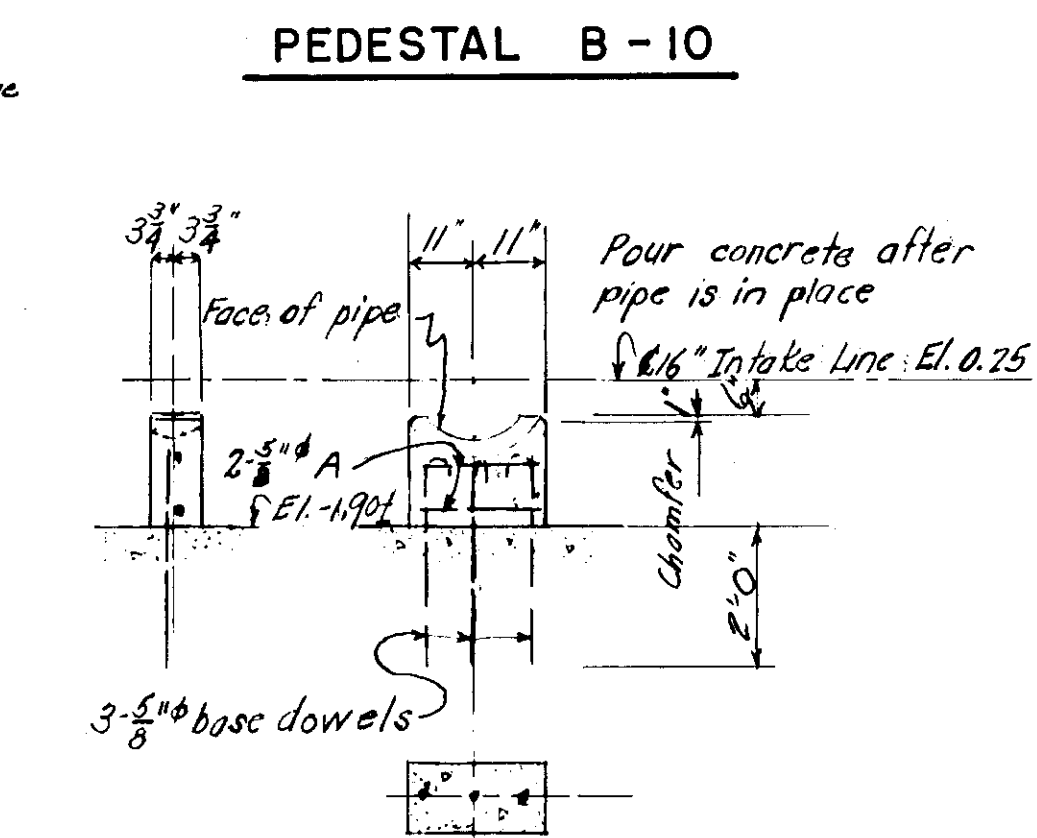


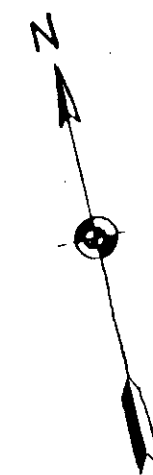

PEDESTAL	B - 7
PEDESTAL	B - 8


PEDESTAL B - 2

PEDESTAL B - 4

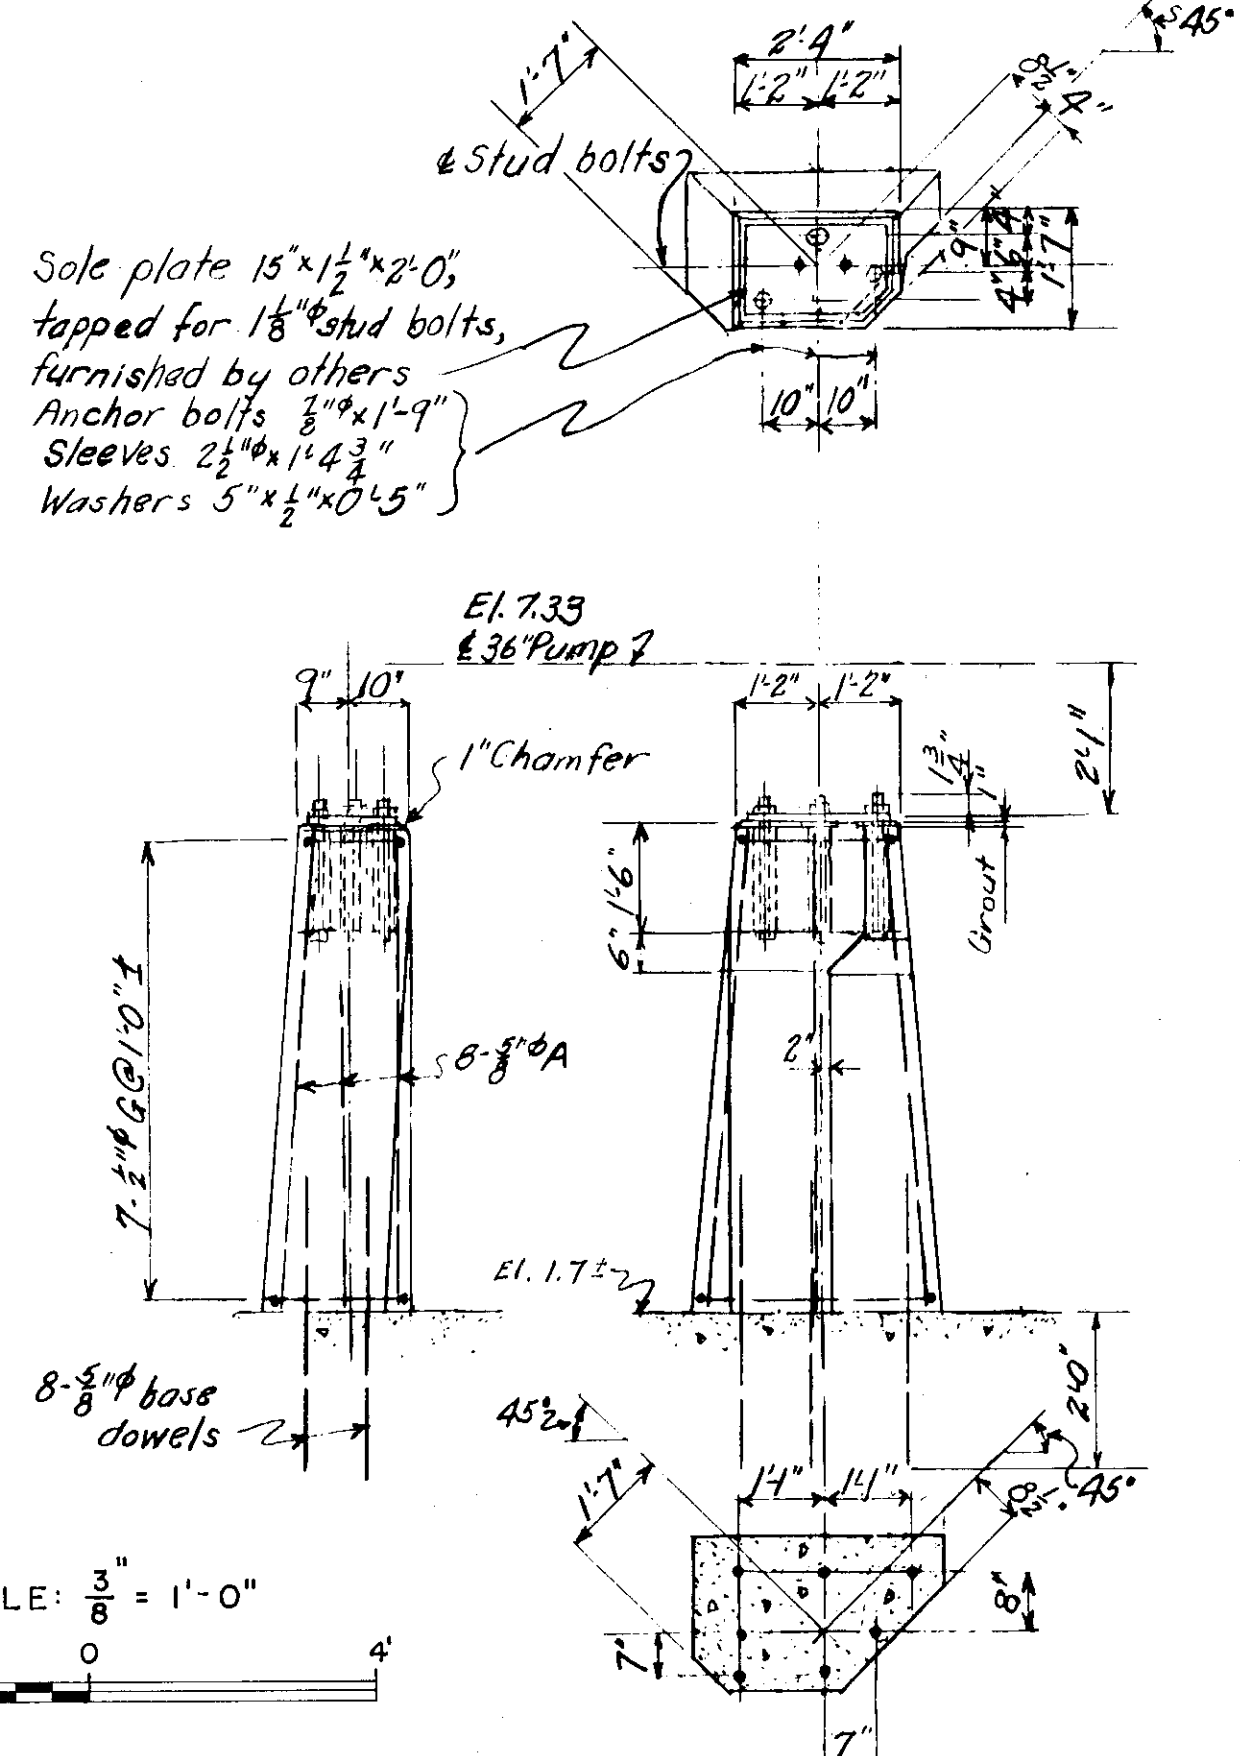


PEDESTAL B - 3

PEDESTAL B - 6

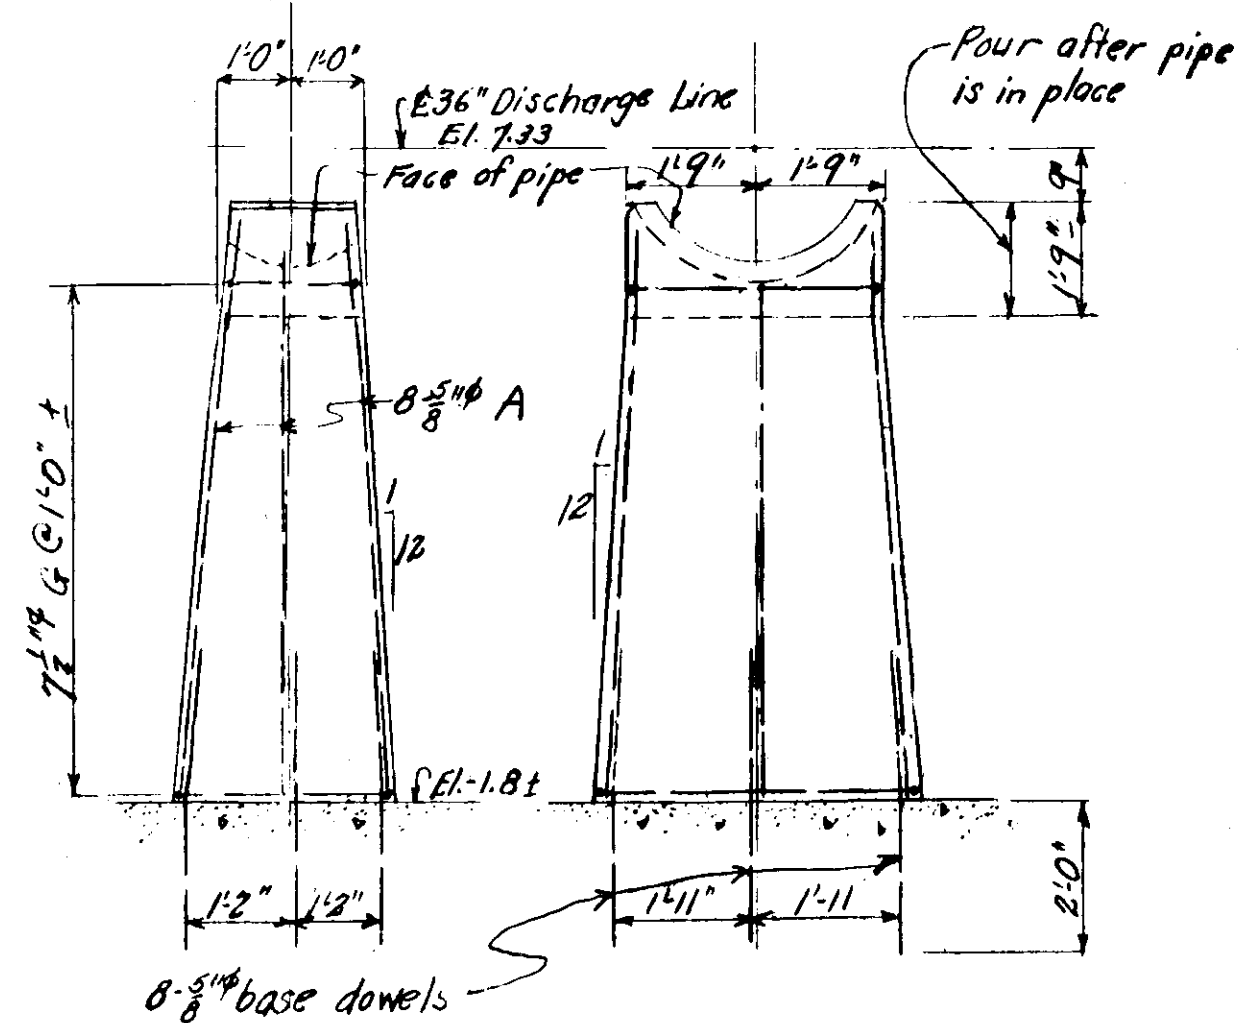

PEDESTAL B - 9

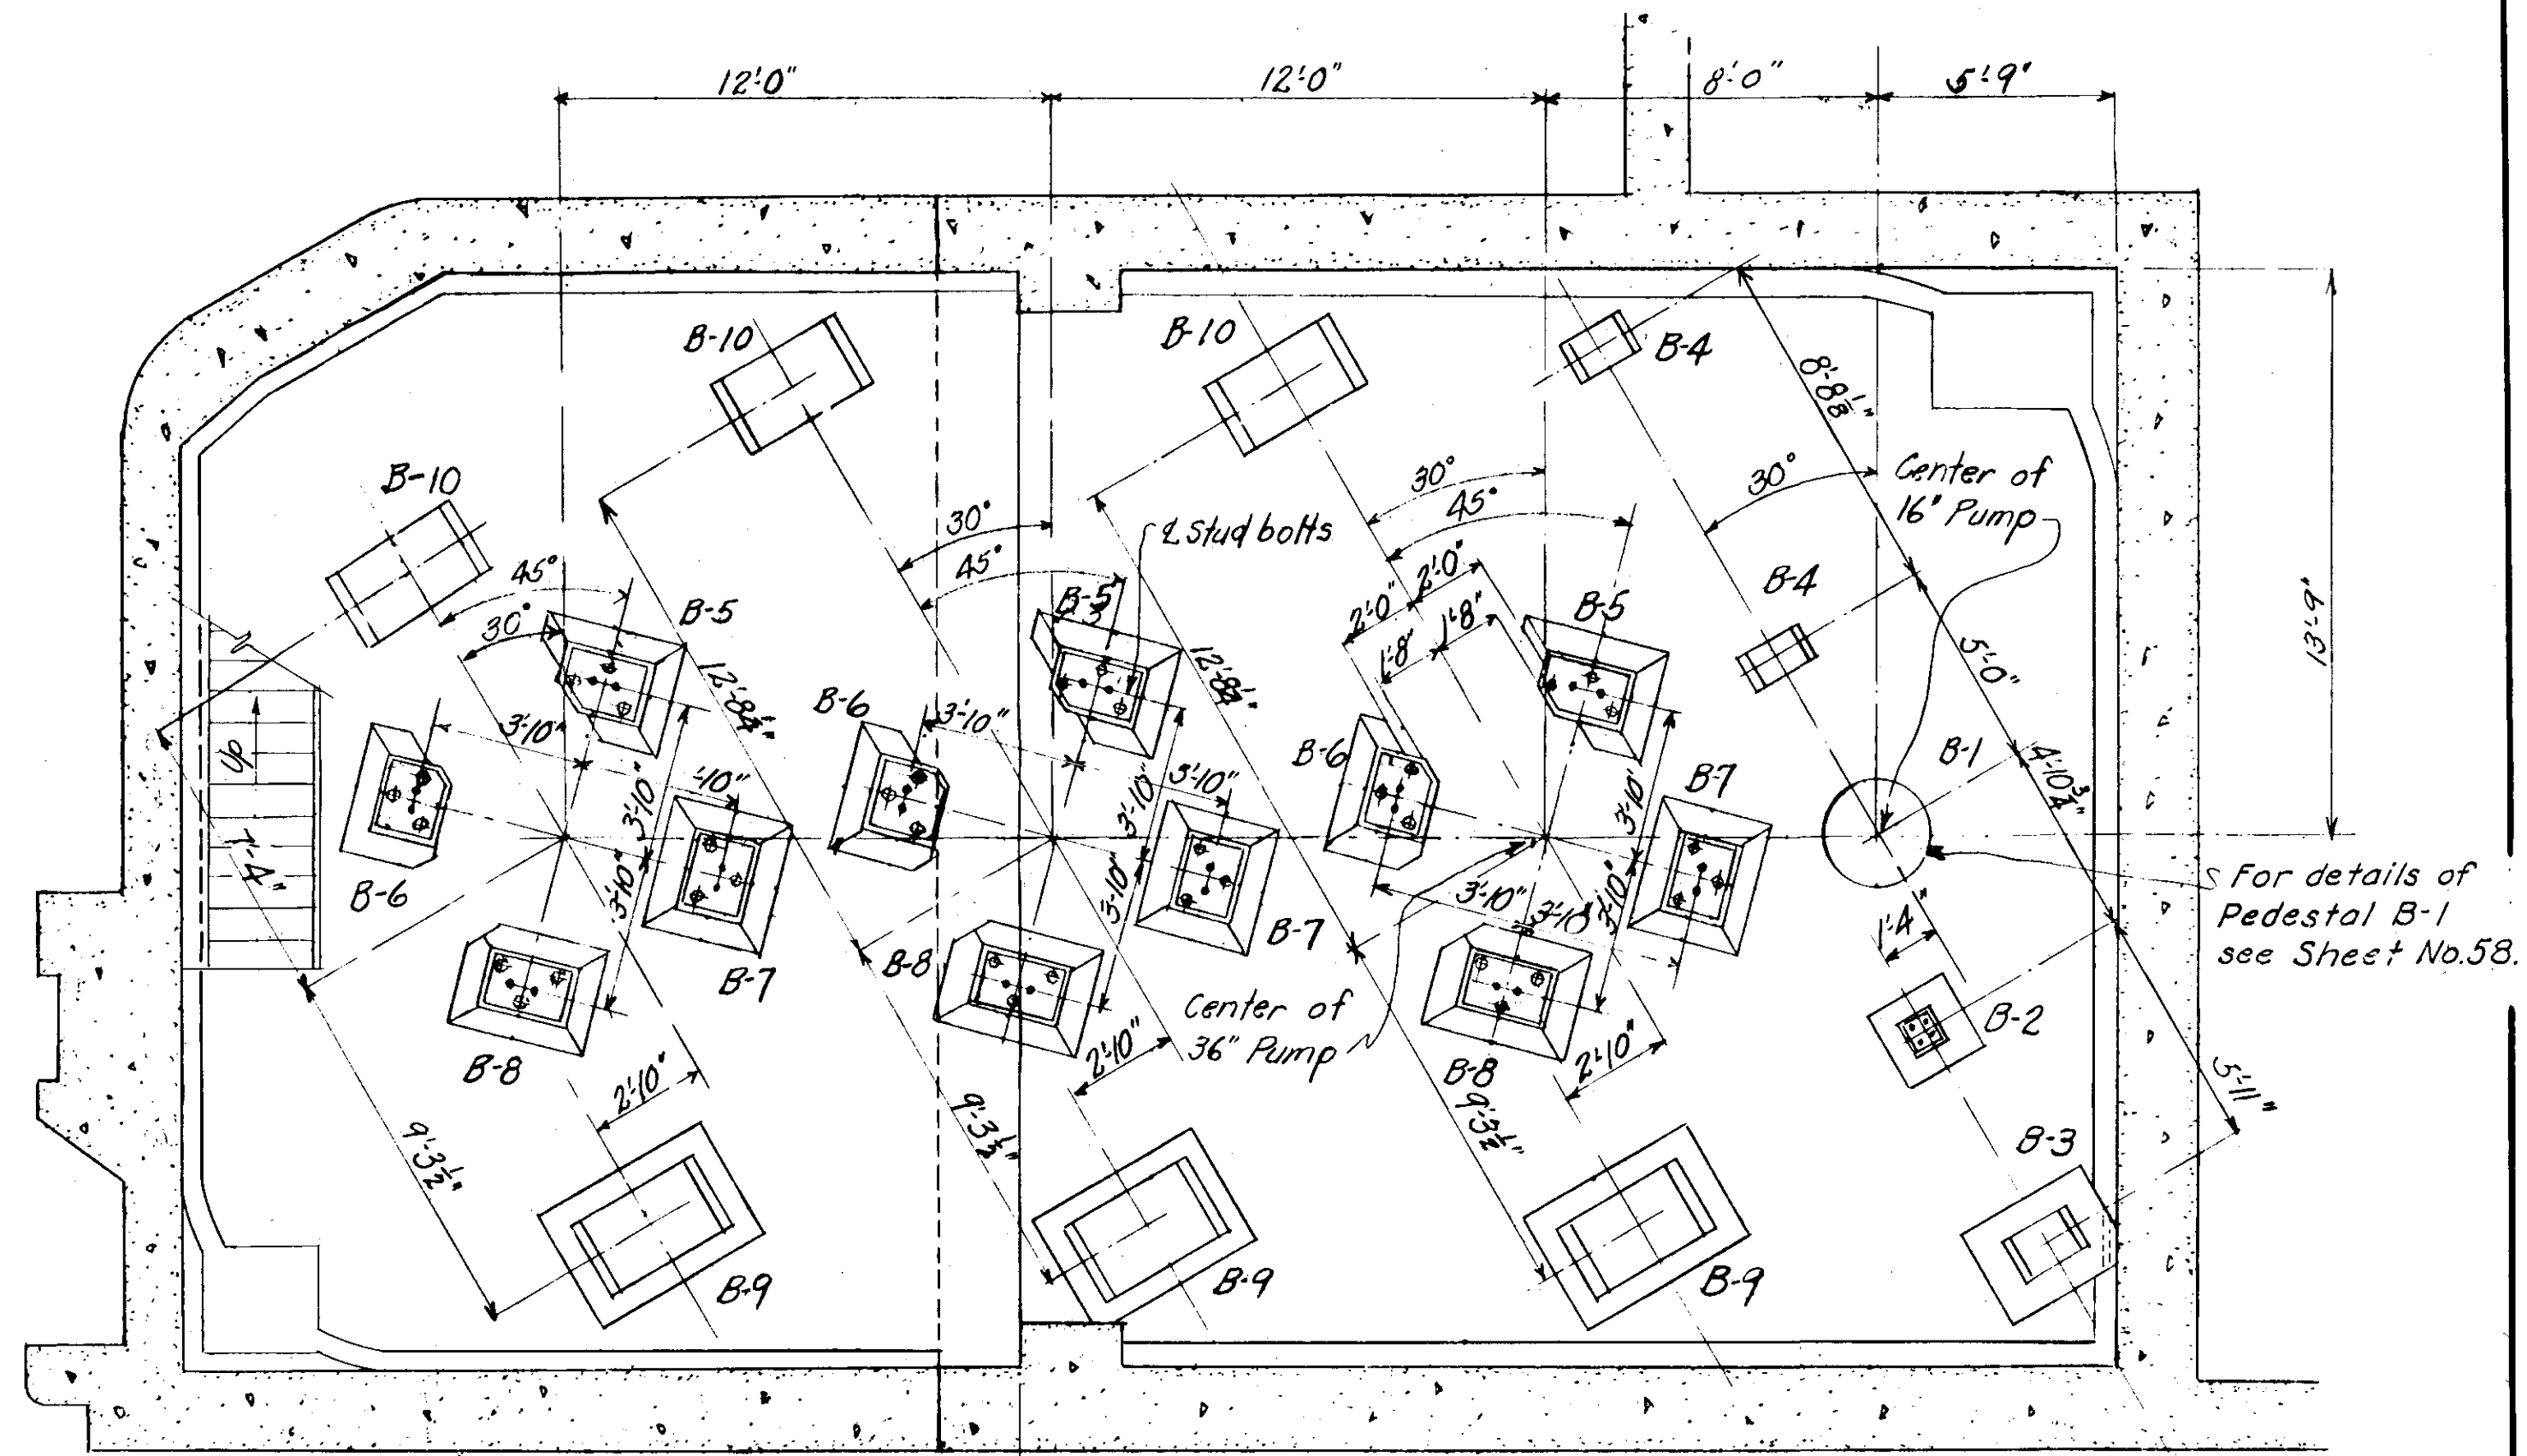

see Sheet No. 58.

New construction	Existing structure

PUMP ROOM PLAN

SCALE: $\frac{1''}{4} = 1' - 0''$

NOTES :

- Payment for furnishing, bending, and placing steel reinforcement was made under Item No. 26.
- Concrete was paid for under Item No. 26.
- Dowels embedded in existing concrete base slab were grouted with Emenco or equal. Payment for drilling existing concrete and for grouting was made under Item No. 26.
- For typical details of anchor bolts see Sheet No. 45.
- Bar splices are equal in length to 40 diameters of the smaller bar.
- The minimum cover for steel is 3".
- Radii of bends for reinforcing steel are 4 times the diameter of the bars.
- For steel reinforcement key see Sheet No. 27.
- Anchor bolts, sleeves, and washers were paid for under Item No. 13.

DES. BY	DR. BY	CK. BY		
	R.S.M.	F.J.H.		
CHIEF DESIGN BRANCH				
PROJECT ENGINEER				
SUBMITTED BY:				
CHIEF FLOOD CONTROL BRANCH				
APPROVED	APPROVED	DATE		
CHIEF ENGINEERING DIVISION	MAJOR, C.E., ASST. TO DIVISION ENGINEER	NOV. 1948		
SCALE AS SHOWN			SPEC. NO.	
DRAWING NUMBER				
GT - 4 - 3950				
SHEET 57 OF 60				