


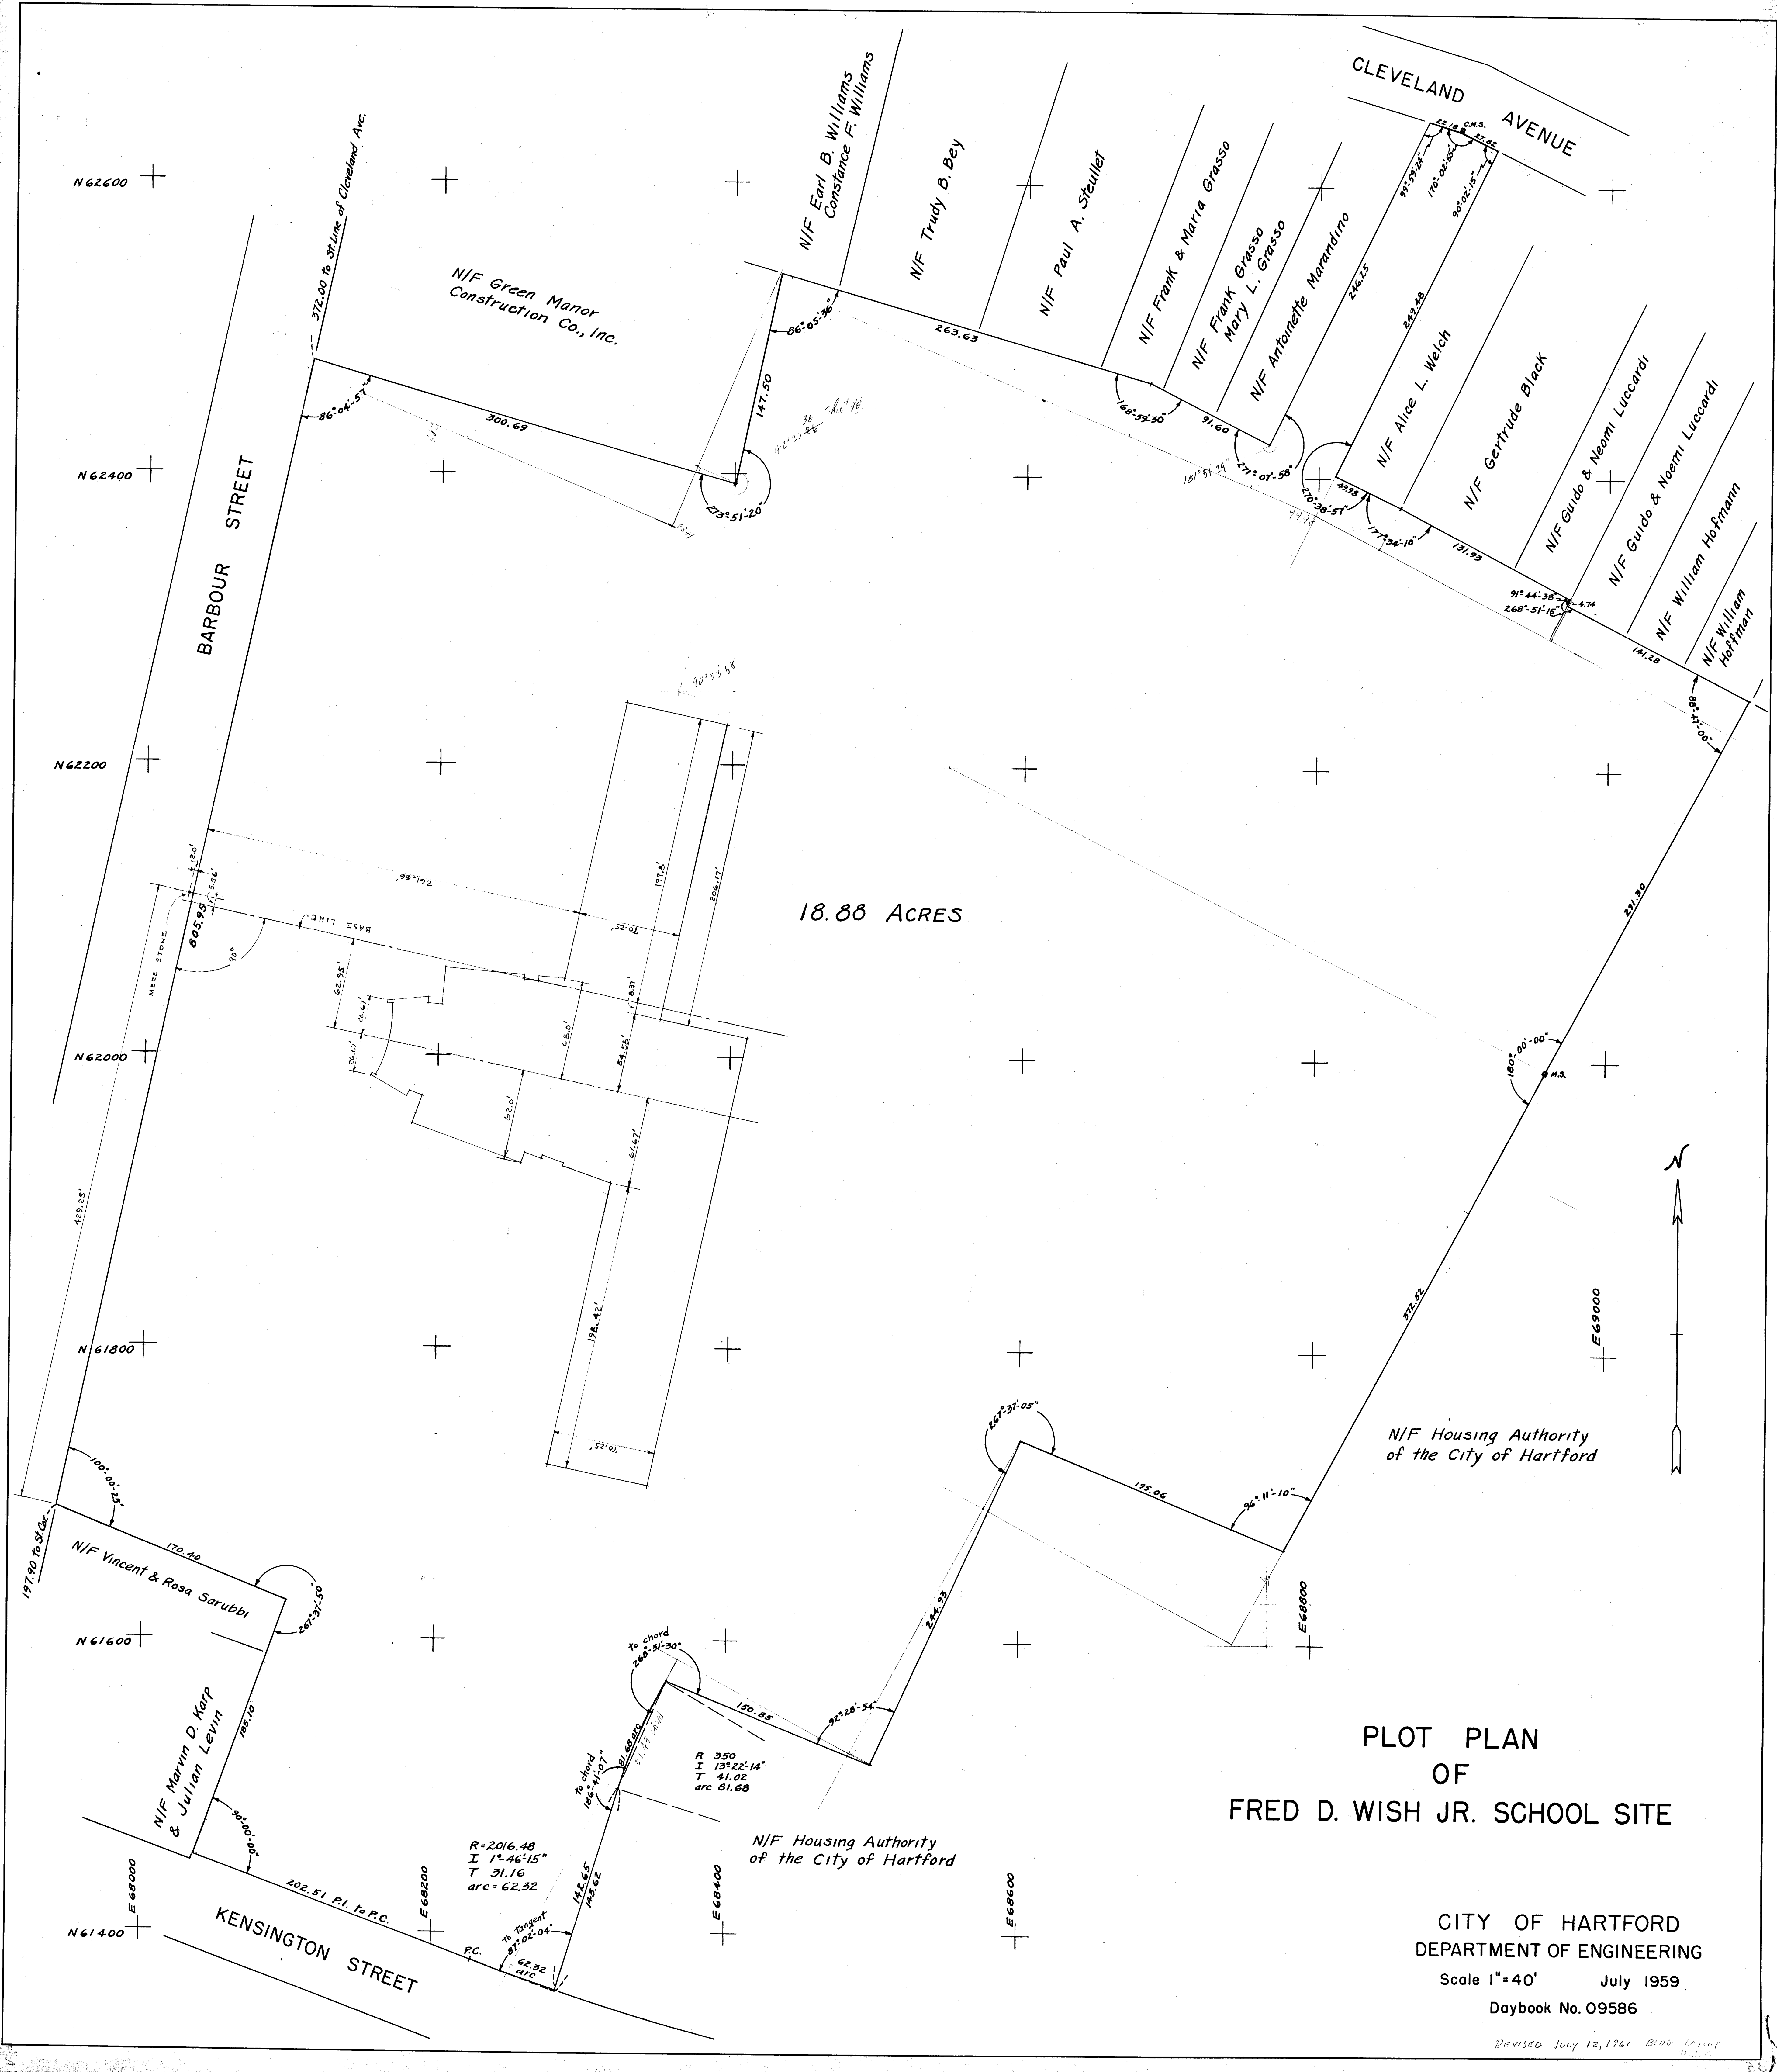

18.88 ACRES

PLOT PLAN
OF
FRED D. WISH JR. SCHOOL SITE

CITY OF HARTFORD
DEPARTMENT OF ENGINEERING
Scale 1"=40' July 1959
Daybook No. 09586

REVISED July 12, 1961 Bldg. Design D. J. P.