


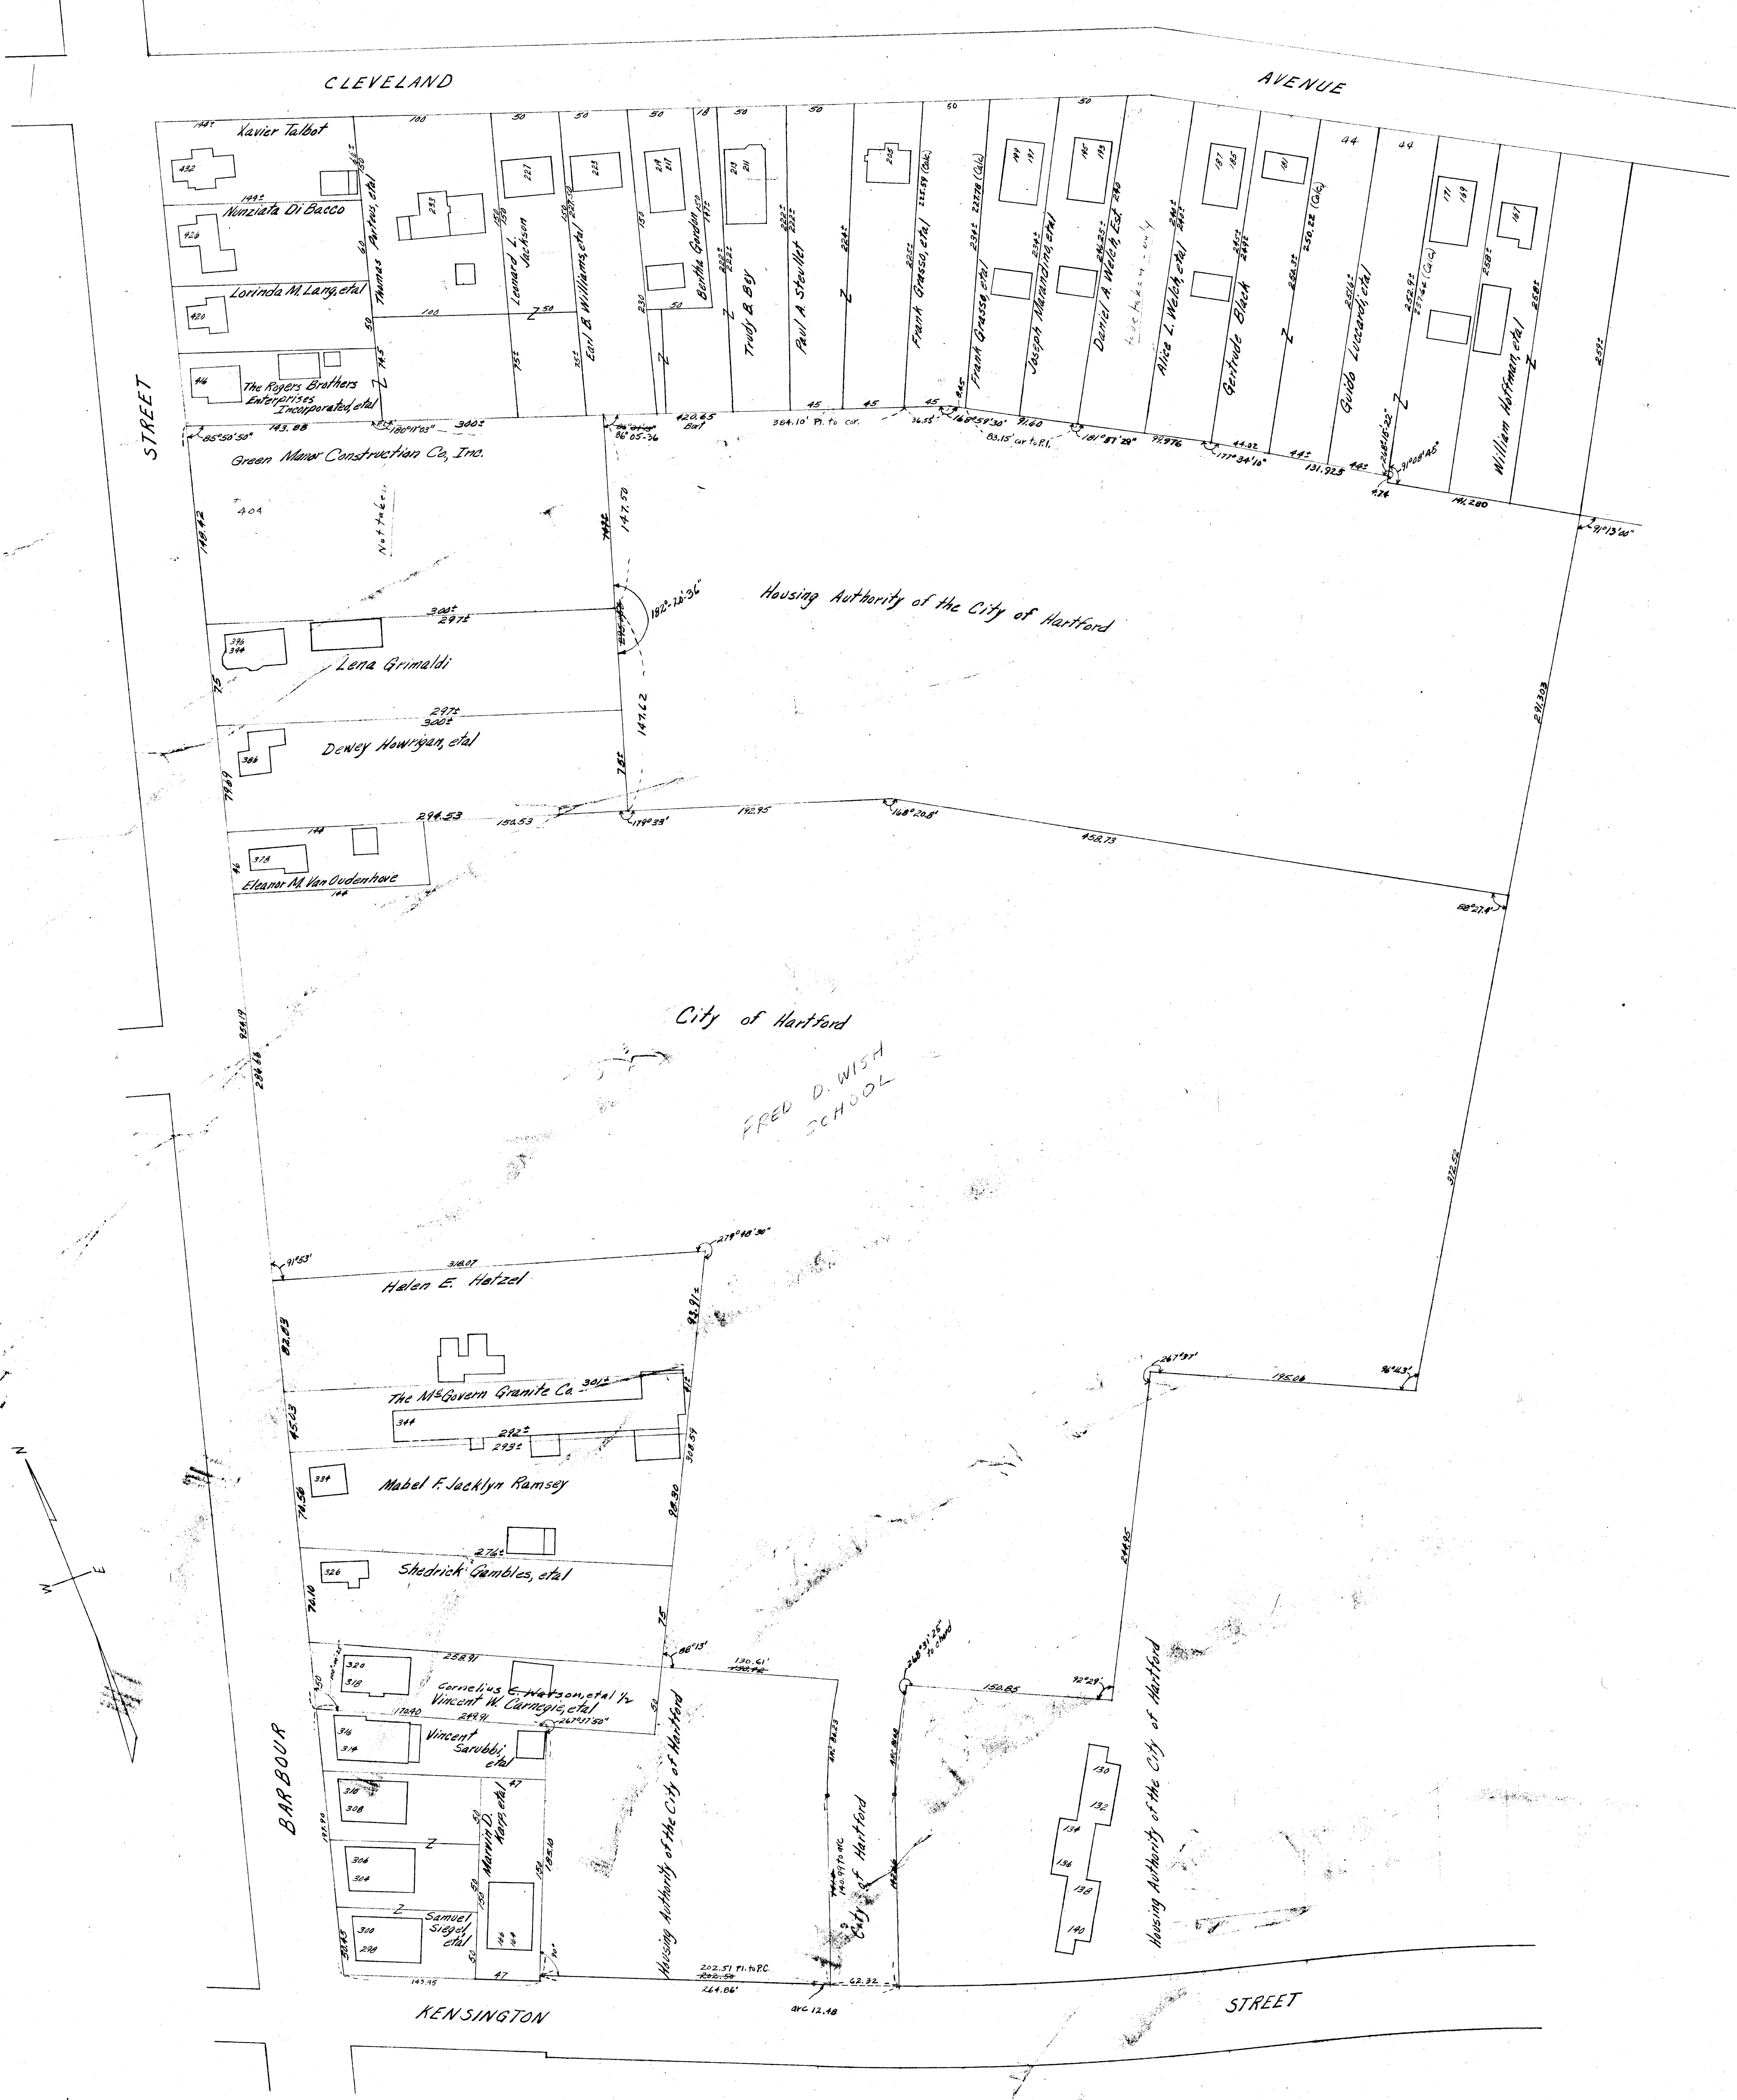

CITY OF HARTFORD
DEPARTMENT OF ENGINEERING
SCALE 1" = 50'
AUGUST 1958

Revised Mar. 1959 - Angles & Distances added
Revised Nov. 1959 - Angles & Distances amended
R. H. H. A. Parcels.