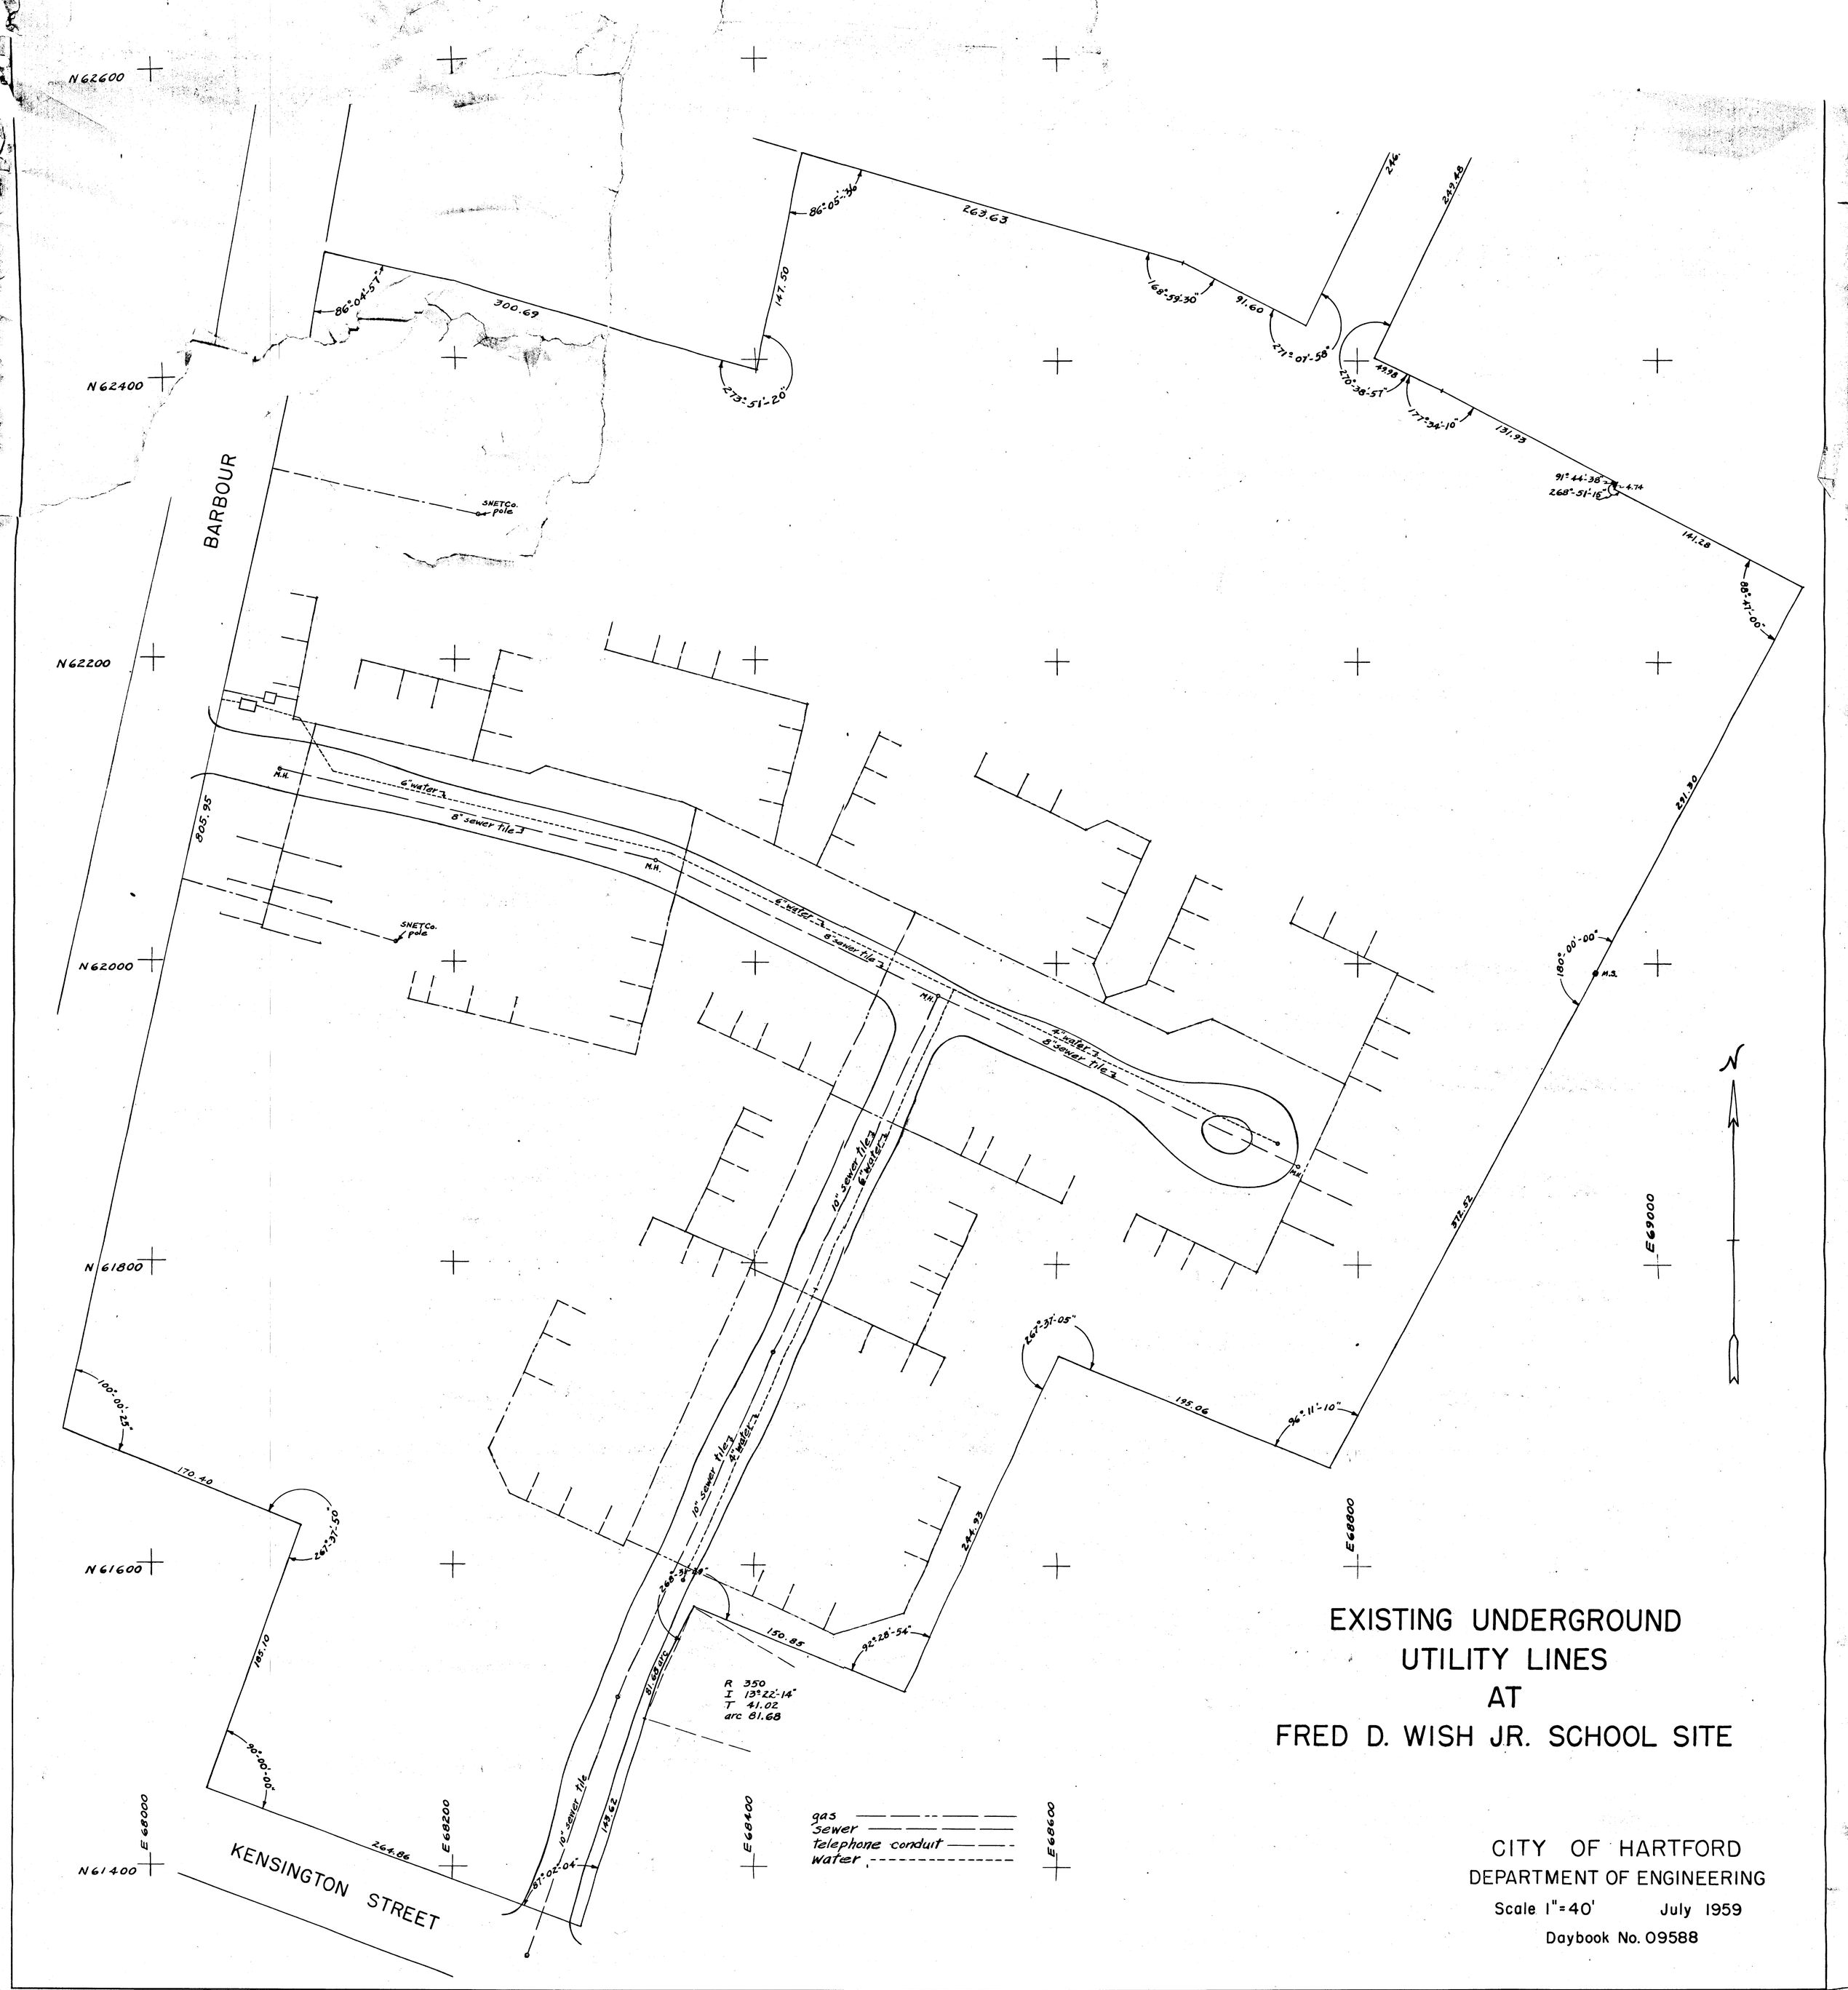

EXISTING UNDERGROUND UTILITY LINES AT FRED D. WISH JR. SCHOOL SITE

CITY OF HARTFORD
DEPARTMENT OF ENGINEERING
Scale 1"=40' July 1959
Daybook No. 09588