


10.0
32.0

10.0
32.0

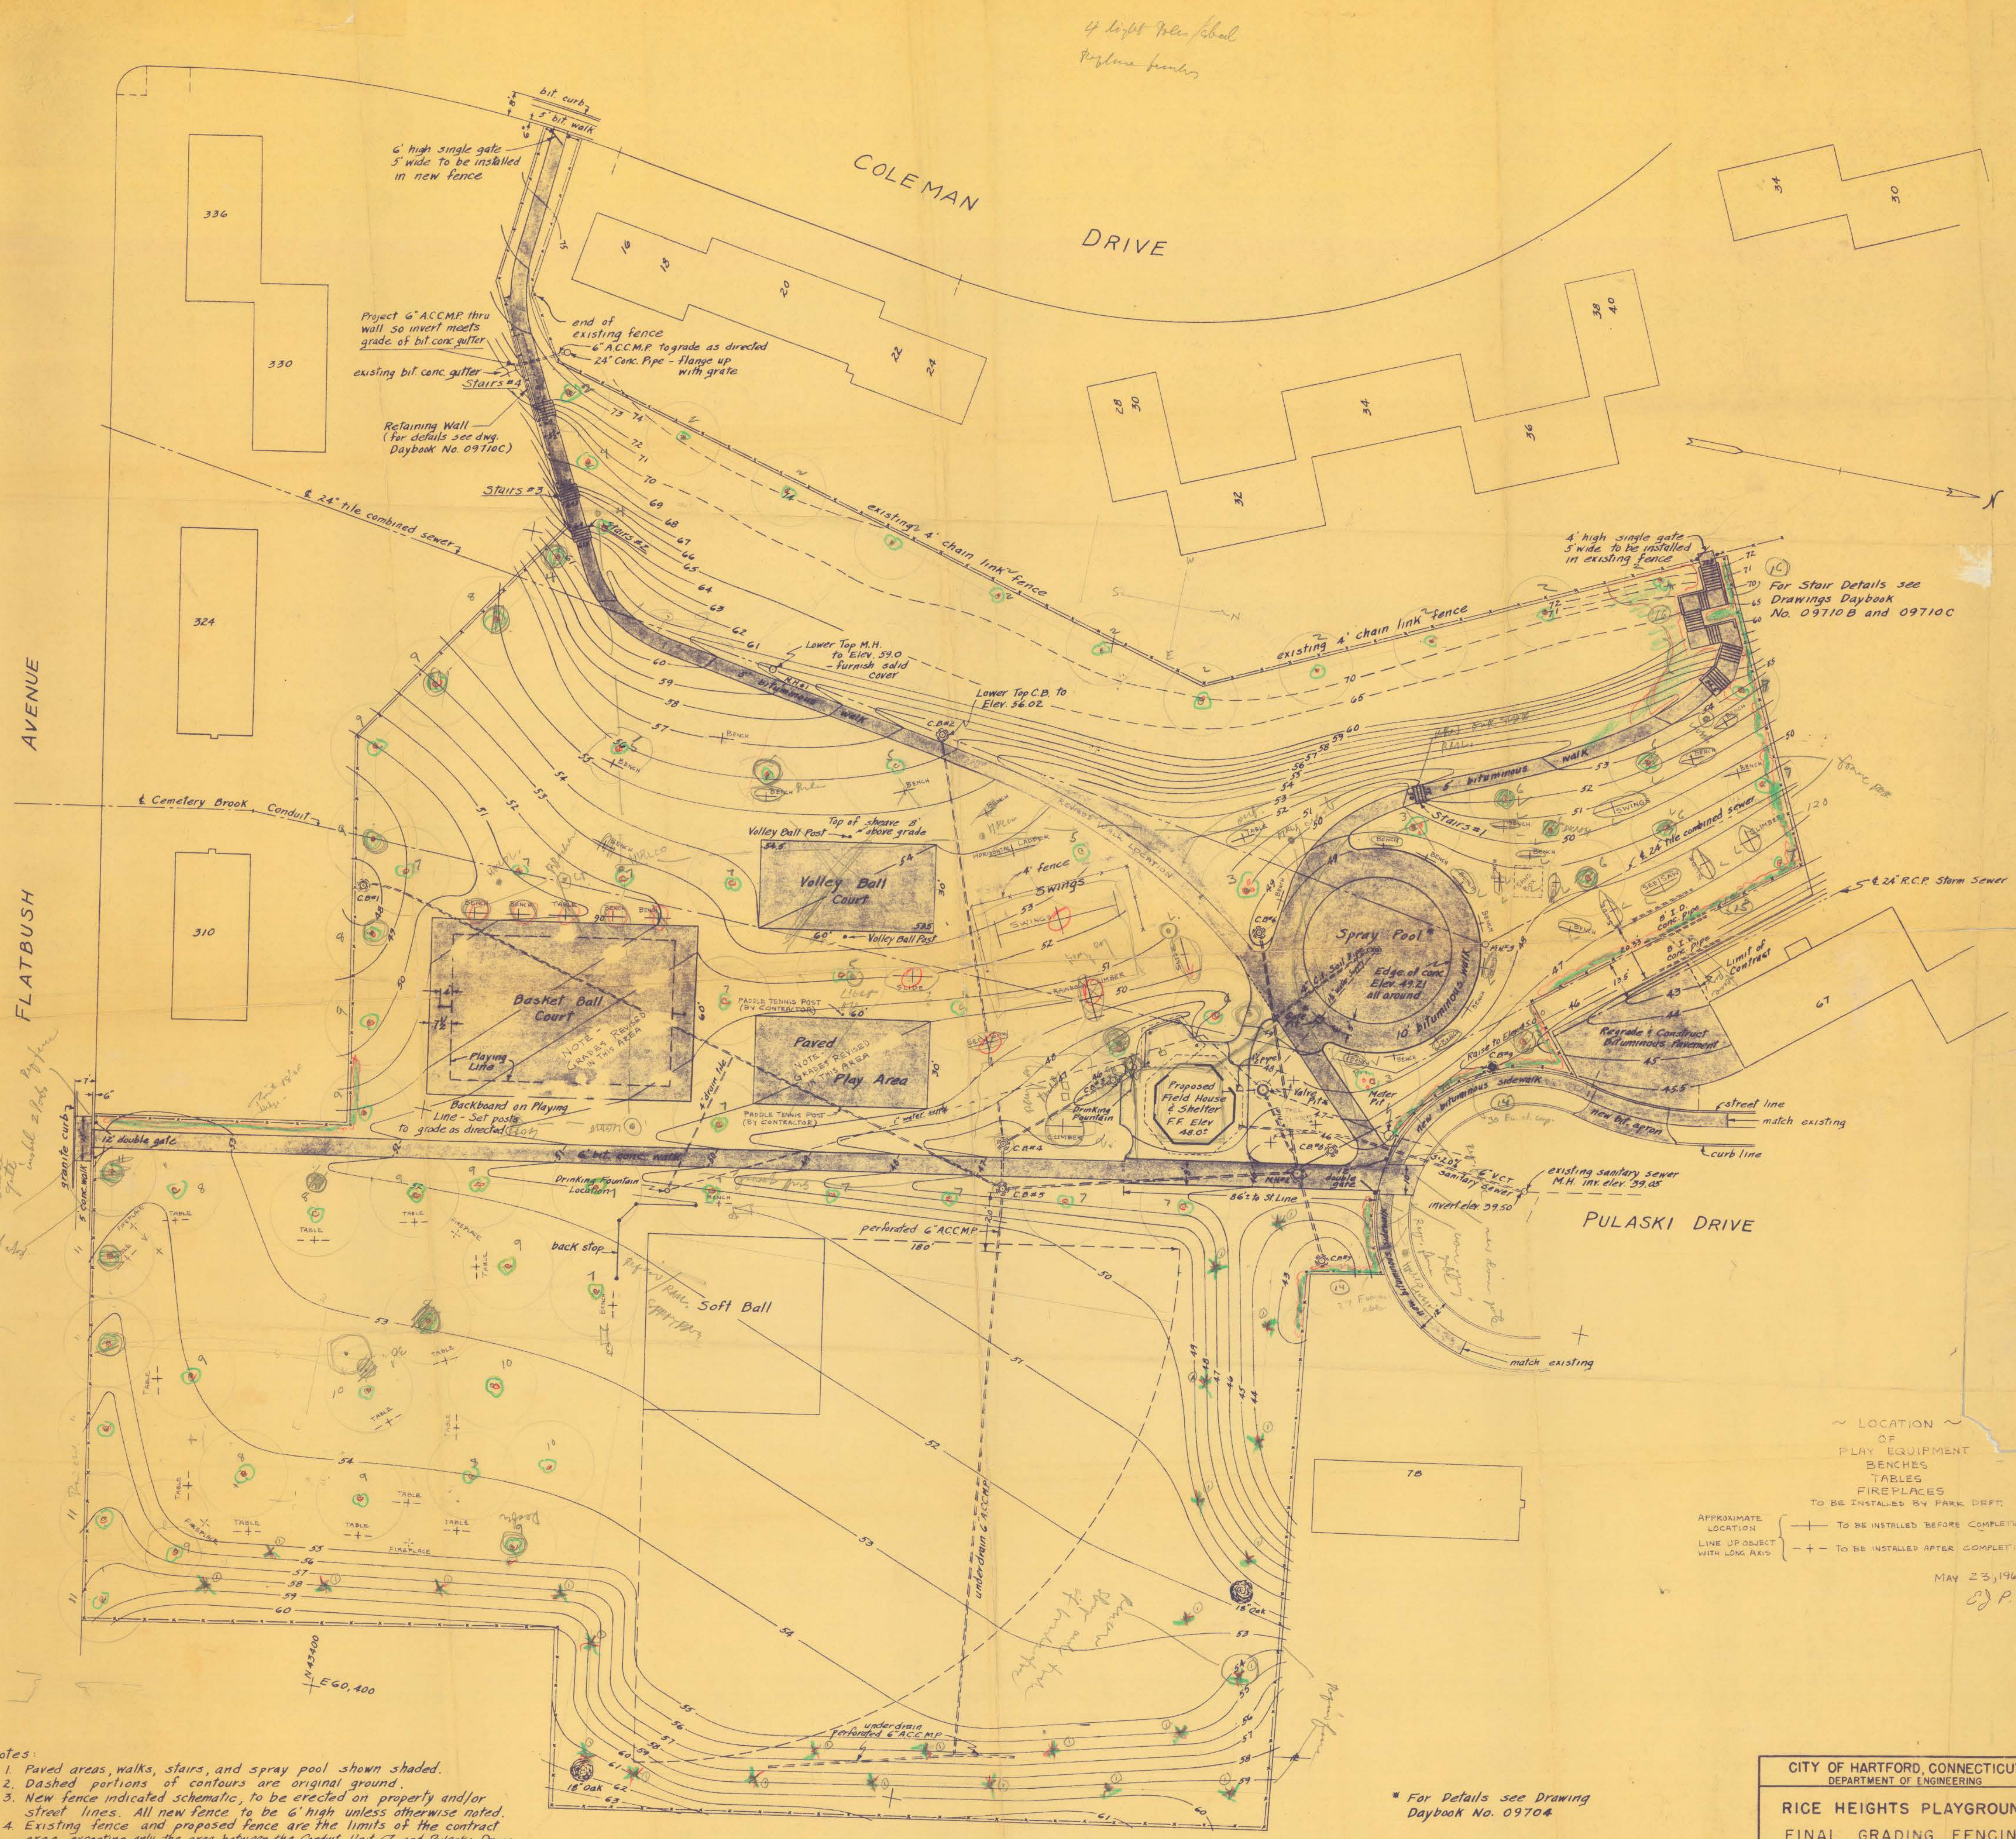

- Notes:
1. Paved areas, walks, stairs, and spray pool shown shaded.
 2. Dashed portions of contours are original ground.
 3. New fence indicated schematic, to be erected on property and/or street lines. All new fence to be 6' high unless otherwise noted.
 4. Existing fence and proposed fence are the limits of the contract area, excepting only the area between the Conduit, Unit 67, and Pulaski Drive.
 5. Trees shown on this plan are to remain.
 6. This Plan reflects changes in original design grades shown on Plan Daybook No 09688B.

* For Details see Drawing
Daybook No. 09704

~ LOCATION ~
OF
PLAY EQUIPMENT
BENCHES
TABLES
FIREPLACES
TO BE INSTALLED BY PARK DEPT.

APPROXIMATE
LOCATION
LINE UP OBJECT
WITH LONG AXIS

—+— TO BE INSTALLED BEFORE COMPLETION
- - - TO BE INSTALLED AFTER COMPLETION

MAY 23, 1963
J.P.

CITY OF HARTFORD, CONNECTICUT DEPARTMENT OF ENGINEERING			
RICE HEIGHTS PLAYGROUND FINAL GRADING, FENCING, AND SITE IMPROVEMENTS			
SUBMITTED George J. Allen DIVISION ENGINEER	RECOMMENDED J.S. CIT. ENG	APPROVED R. B. B. B. B. CITY ENGINEER	
DESIGN J.L.L. DRAWN R.L.L.	DAYBOOK NO. 09710D	SCALE 1" = 20'	
TRACED R.L.L. CHECK J.L.L.	DATE	JUNE 1962	

Revisions	