


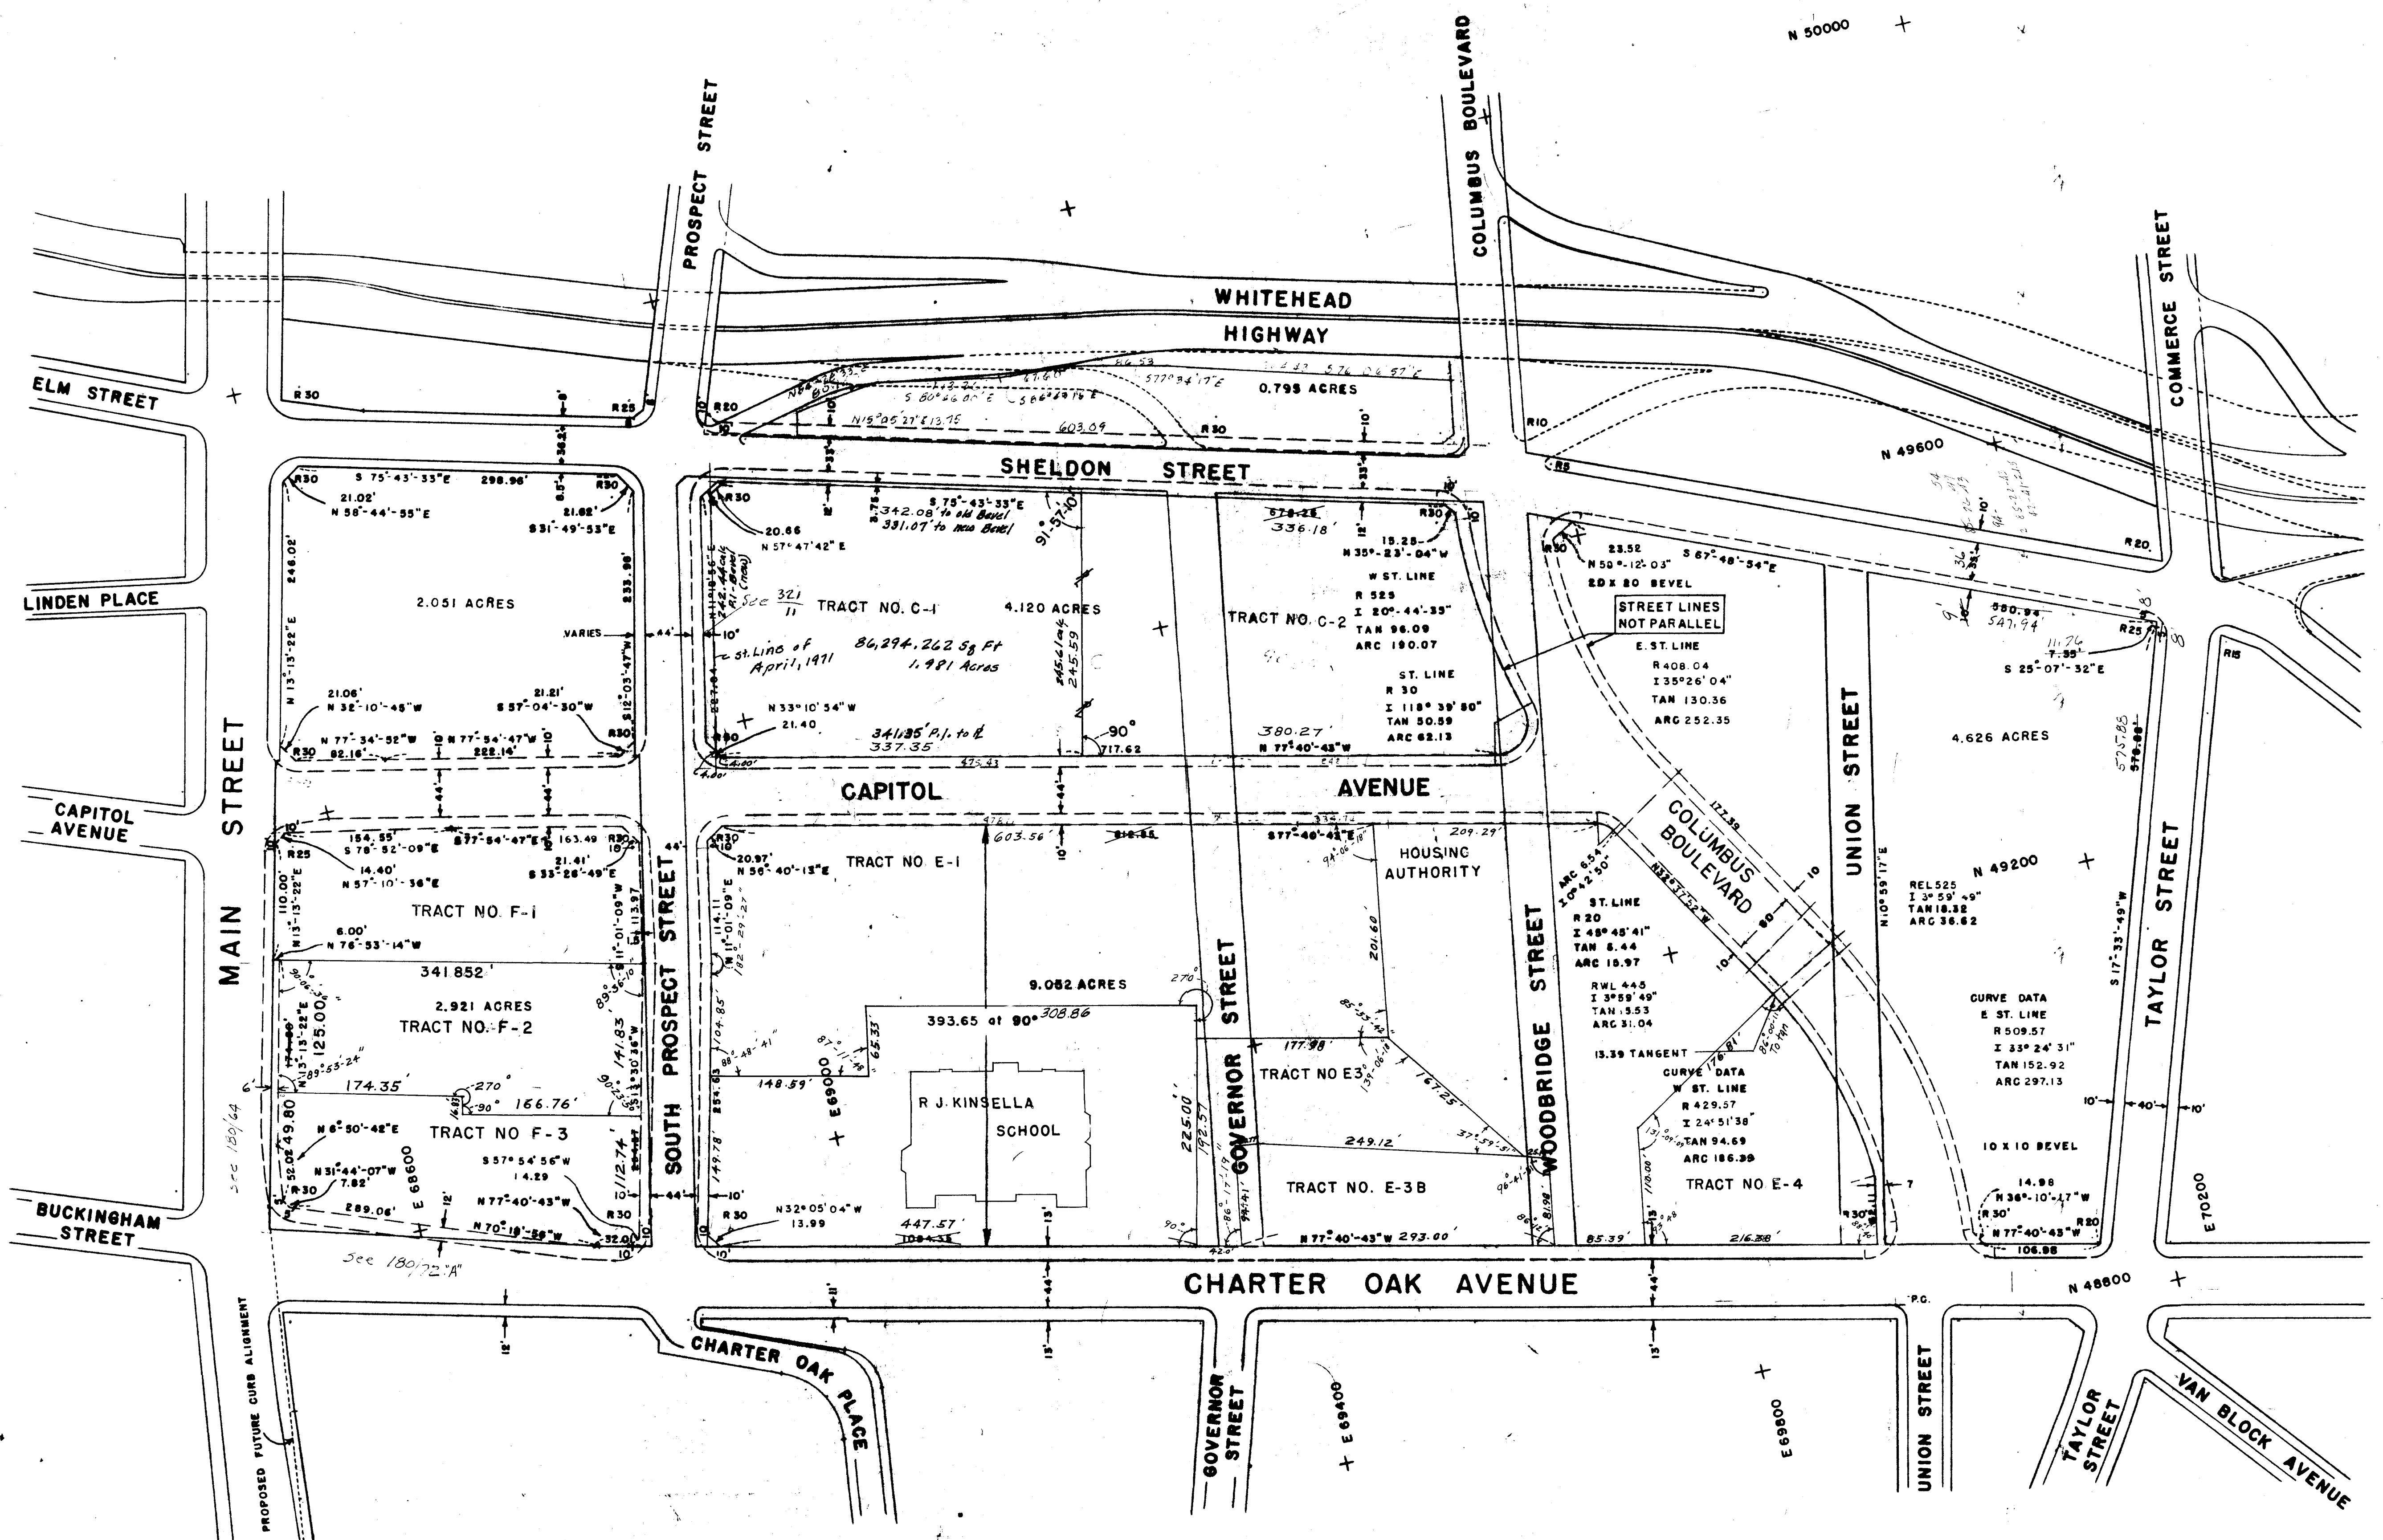

LEGEND

- Existing Curb and Street Lines
- Proposed Curb and Street Lines
- Future Curbs and Existing Street Lines crossed by Existing Access Ramps

Notes:

- All street corner bevels are 15' x 15' unless otherwise noted.
- All bearings and coordinates are based on an extension of those used for the Bushnell Plaza Project - Conn. R-51, and are derived from the Metropolitan District Coordinate System.
- Revised layouts of Columbus Boulevard and South Prospect Street plotted January, 1968.


SHELDON-CHARTER OAK PROJECT: SECTION A

HARTFORD REDEVELOPMENT AGENCY



HARTFORD, CONNECTICUT

MAP NO. 1

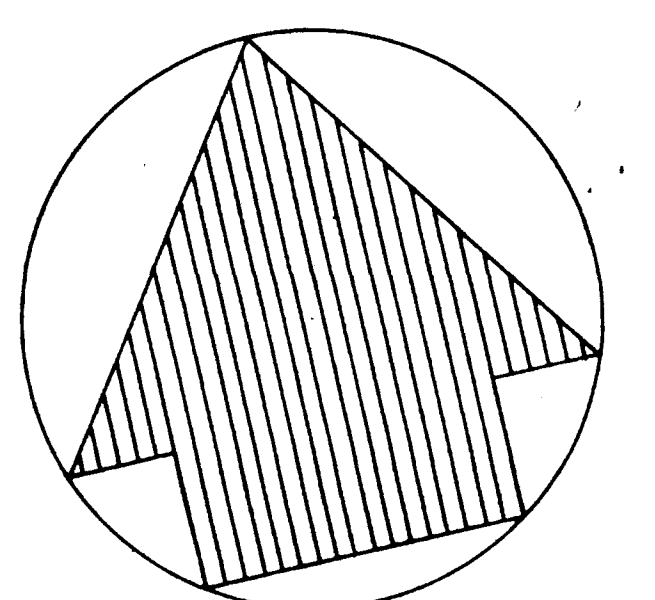

CITY OF HARTFORD, CONNECTICUT DEPARTMENT OF ENGINEERING			
SHELDON-CHARTER OAK PROJECT: SECTION A EXISTING & PROPOSED STREETS			
DESIGN	DRAWN	CHECKED	APPROVED
TRACED	R.L.L.	CHECK	J.L.L.
DAYBOOK NO. 09803			DATE DECEMBER 1963