


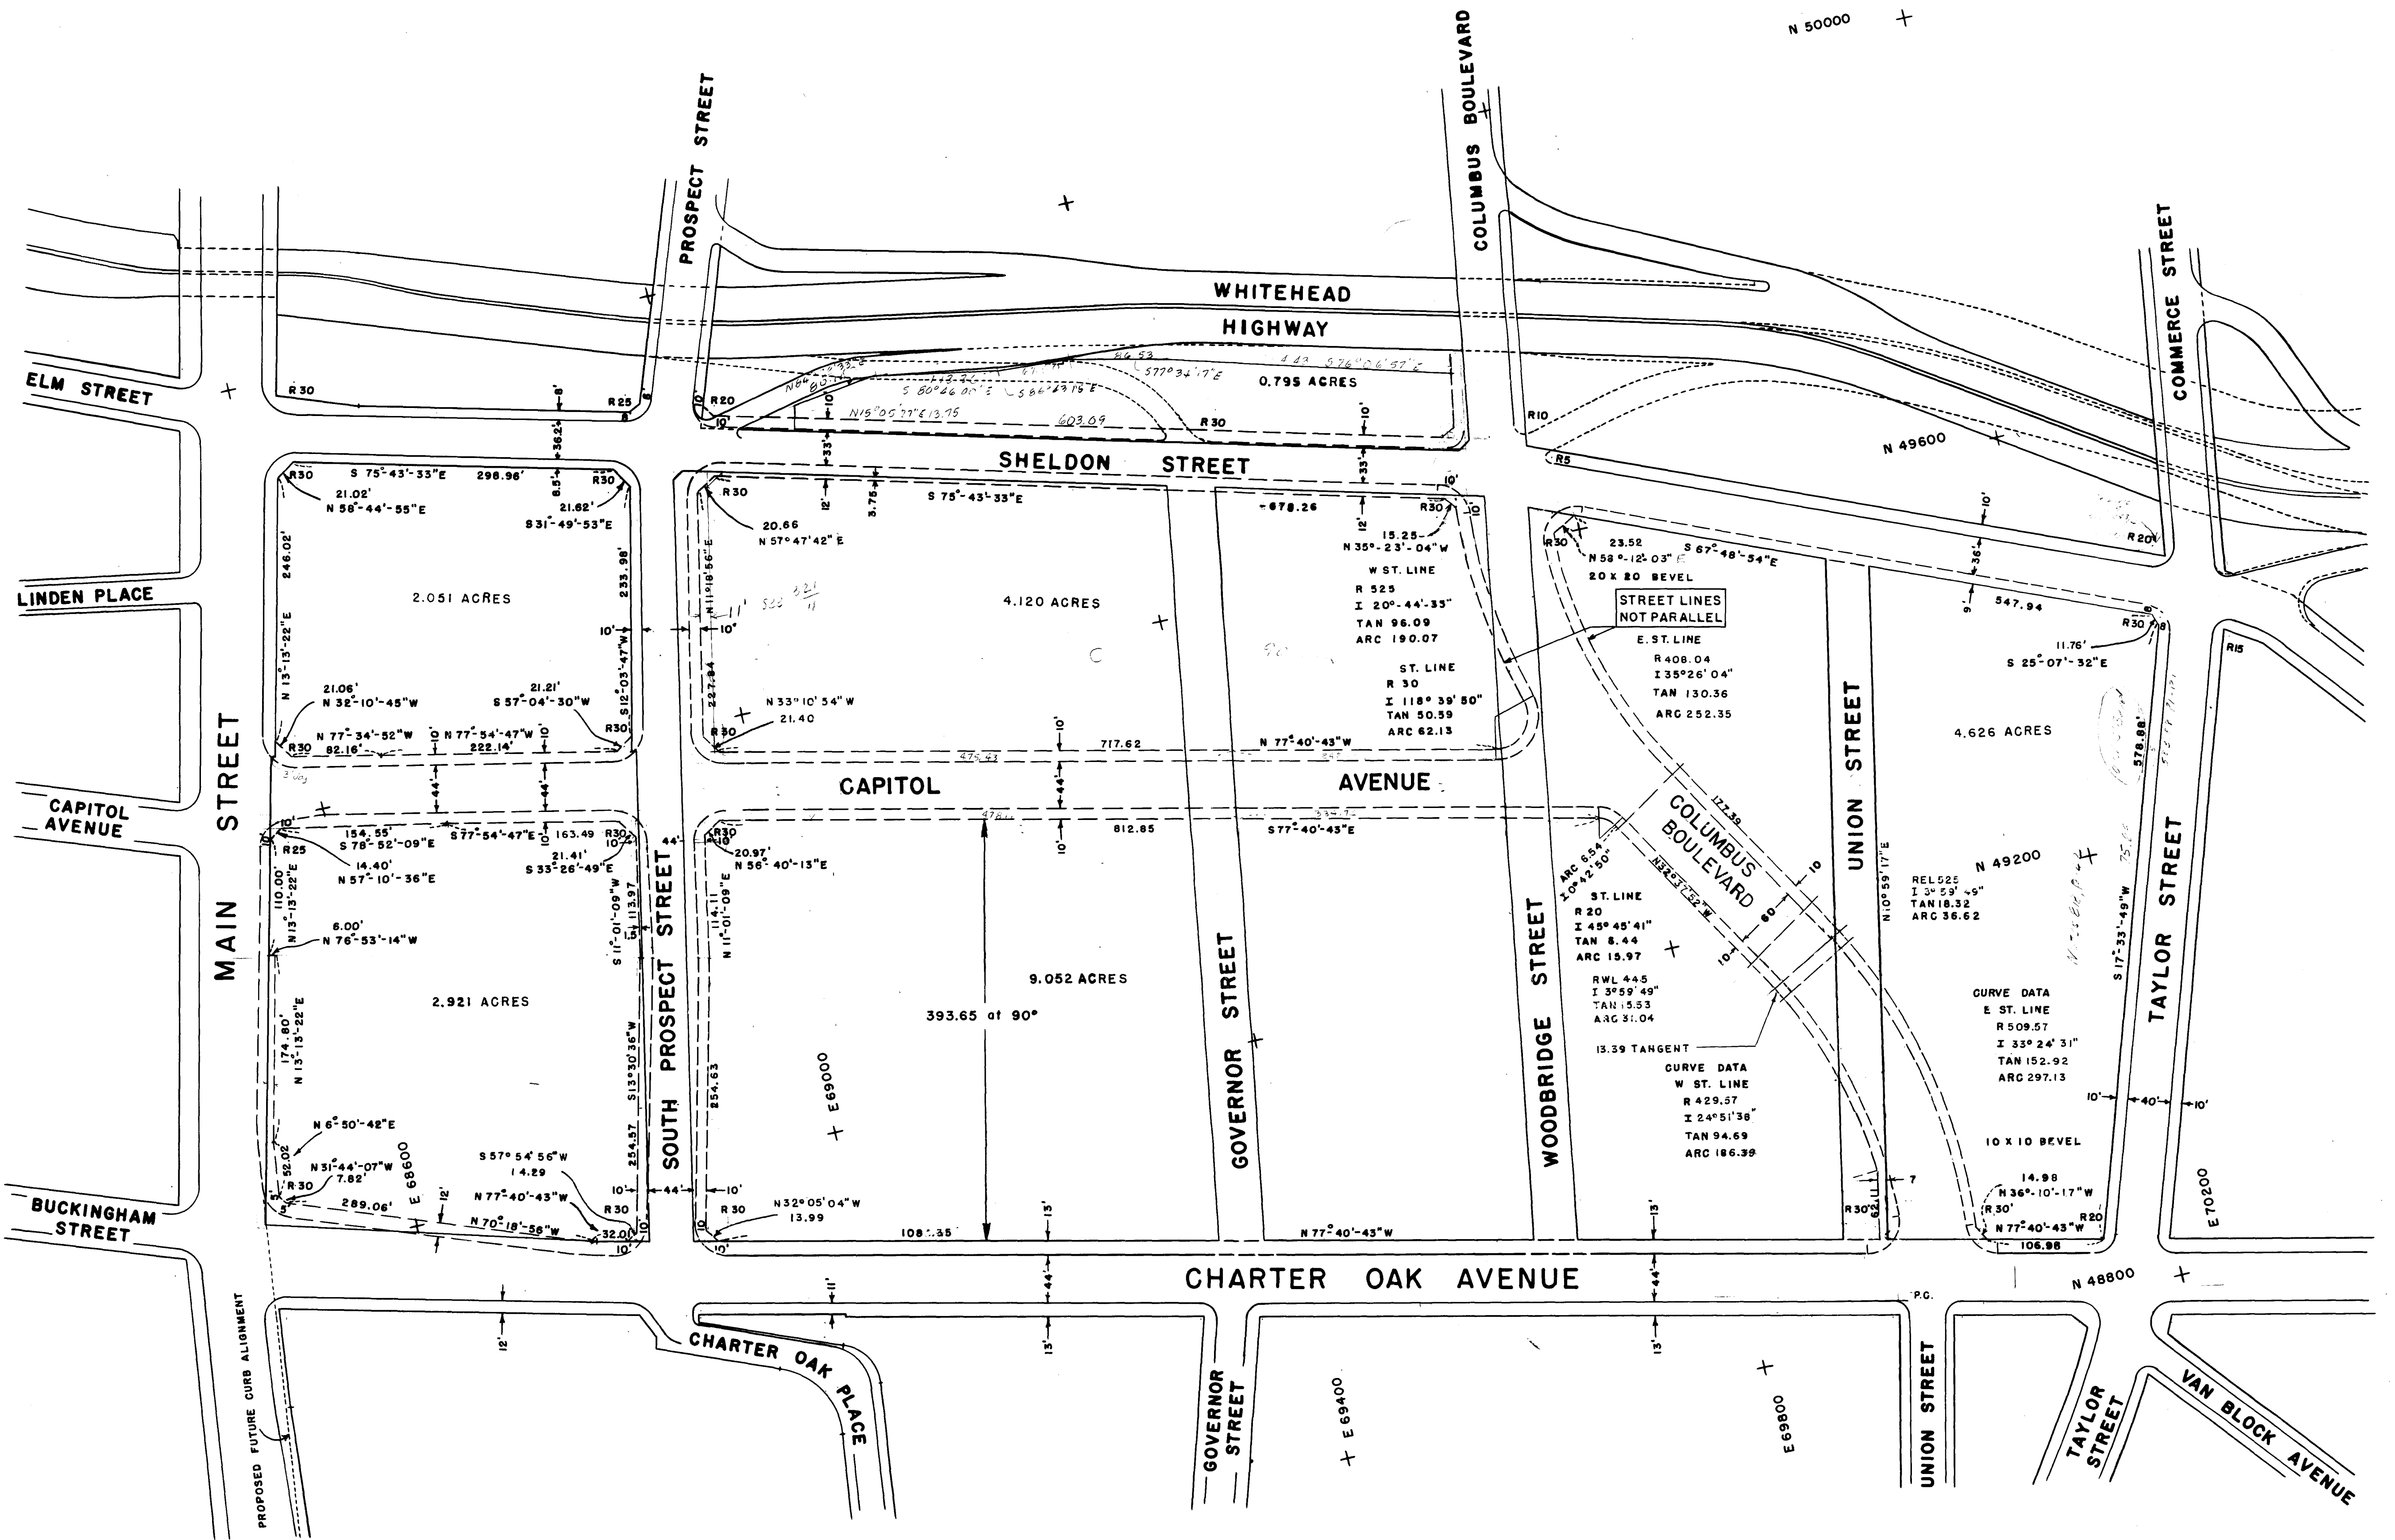


LEGEND

- Existing Curb and Street Lines
- - - Proposed Curb and Street Lines
- Future Curbs and Existing Street Lines crossed by Existing Access Ramps

Notes:

1. All street corner bevels are 15' x 15' unless otherwise noted.
2. All bearings and coordinates are based on an extension of those used for the Bushnell Plaza Project - Conn. R-51, and are derived from the Metropolitan District Coordinate System.
3. Revised layouts of Columbus Boulevard and South Prospect Street plotted January, 1968.

SHELDON-CHARTER OAK PROJECT: SECTION A

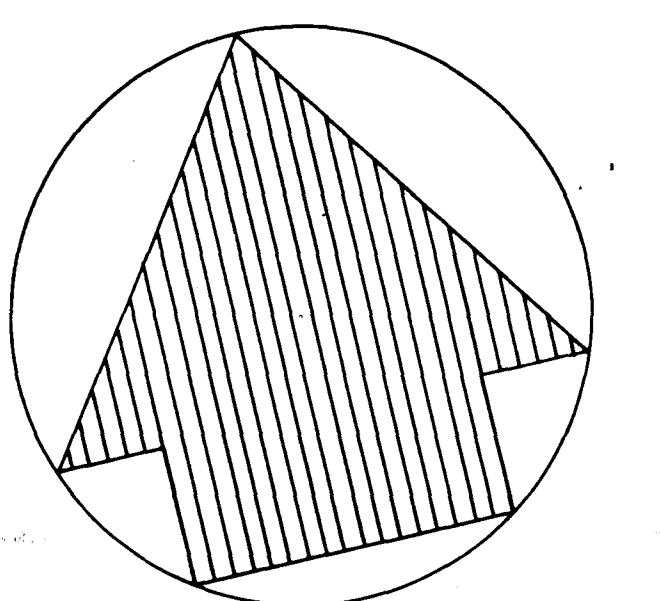

HARTFORD REDEVELOPMENT AGENCY



HARTFORD, CONNECTICUT

MAP NO. 1

SHELDON-CHARTER OAK
PROJECT: SECTION A
EXISTING & PROPOSED STREETS

John L. Simon *George E. Hopper* *Robert A. Parsons*
— R.L.L. 09803
R.L.L. J.L.L. DECEMBER 1963