


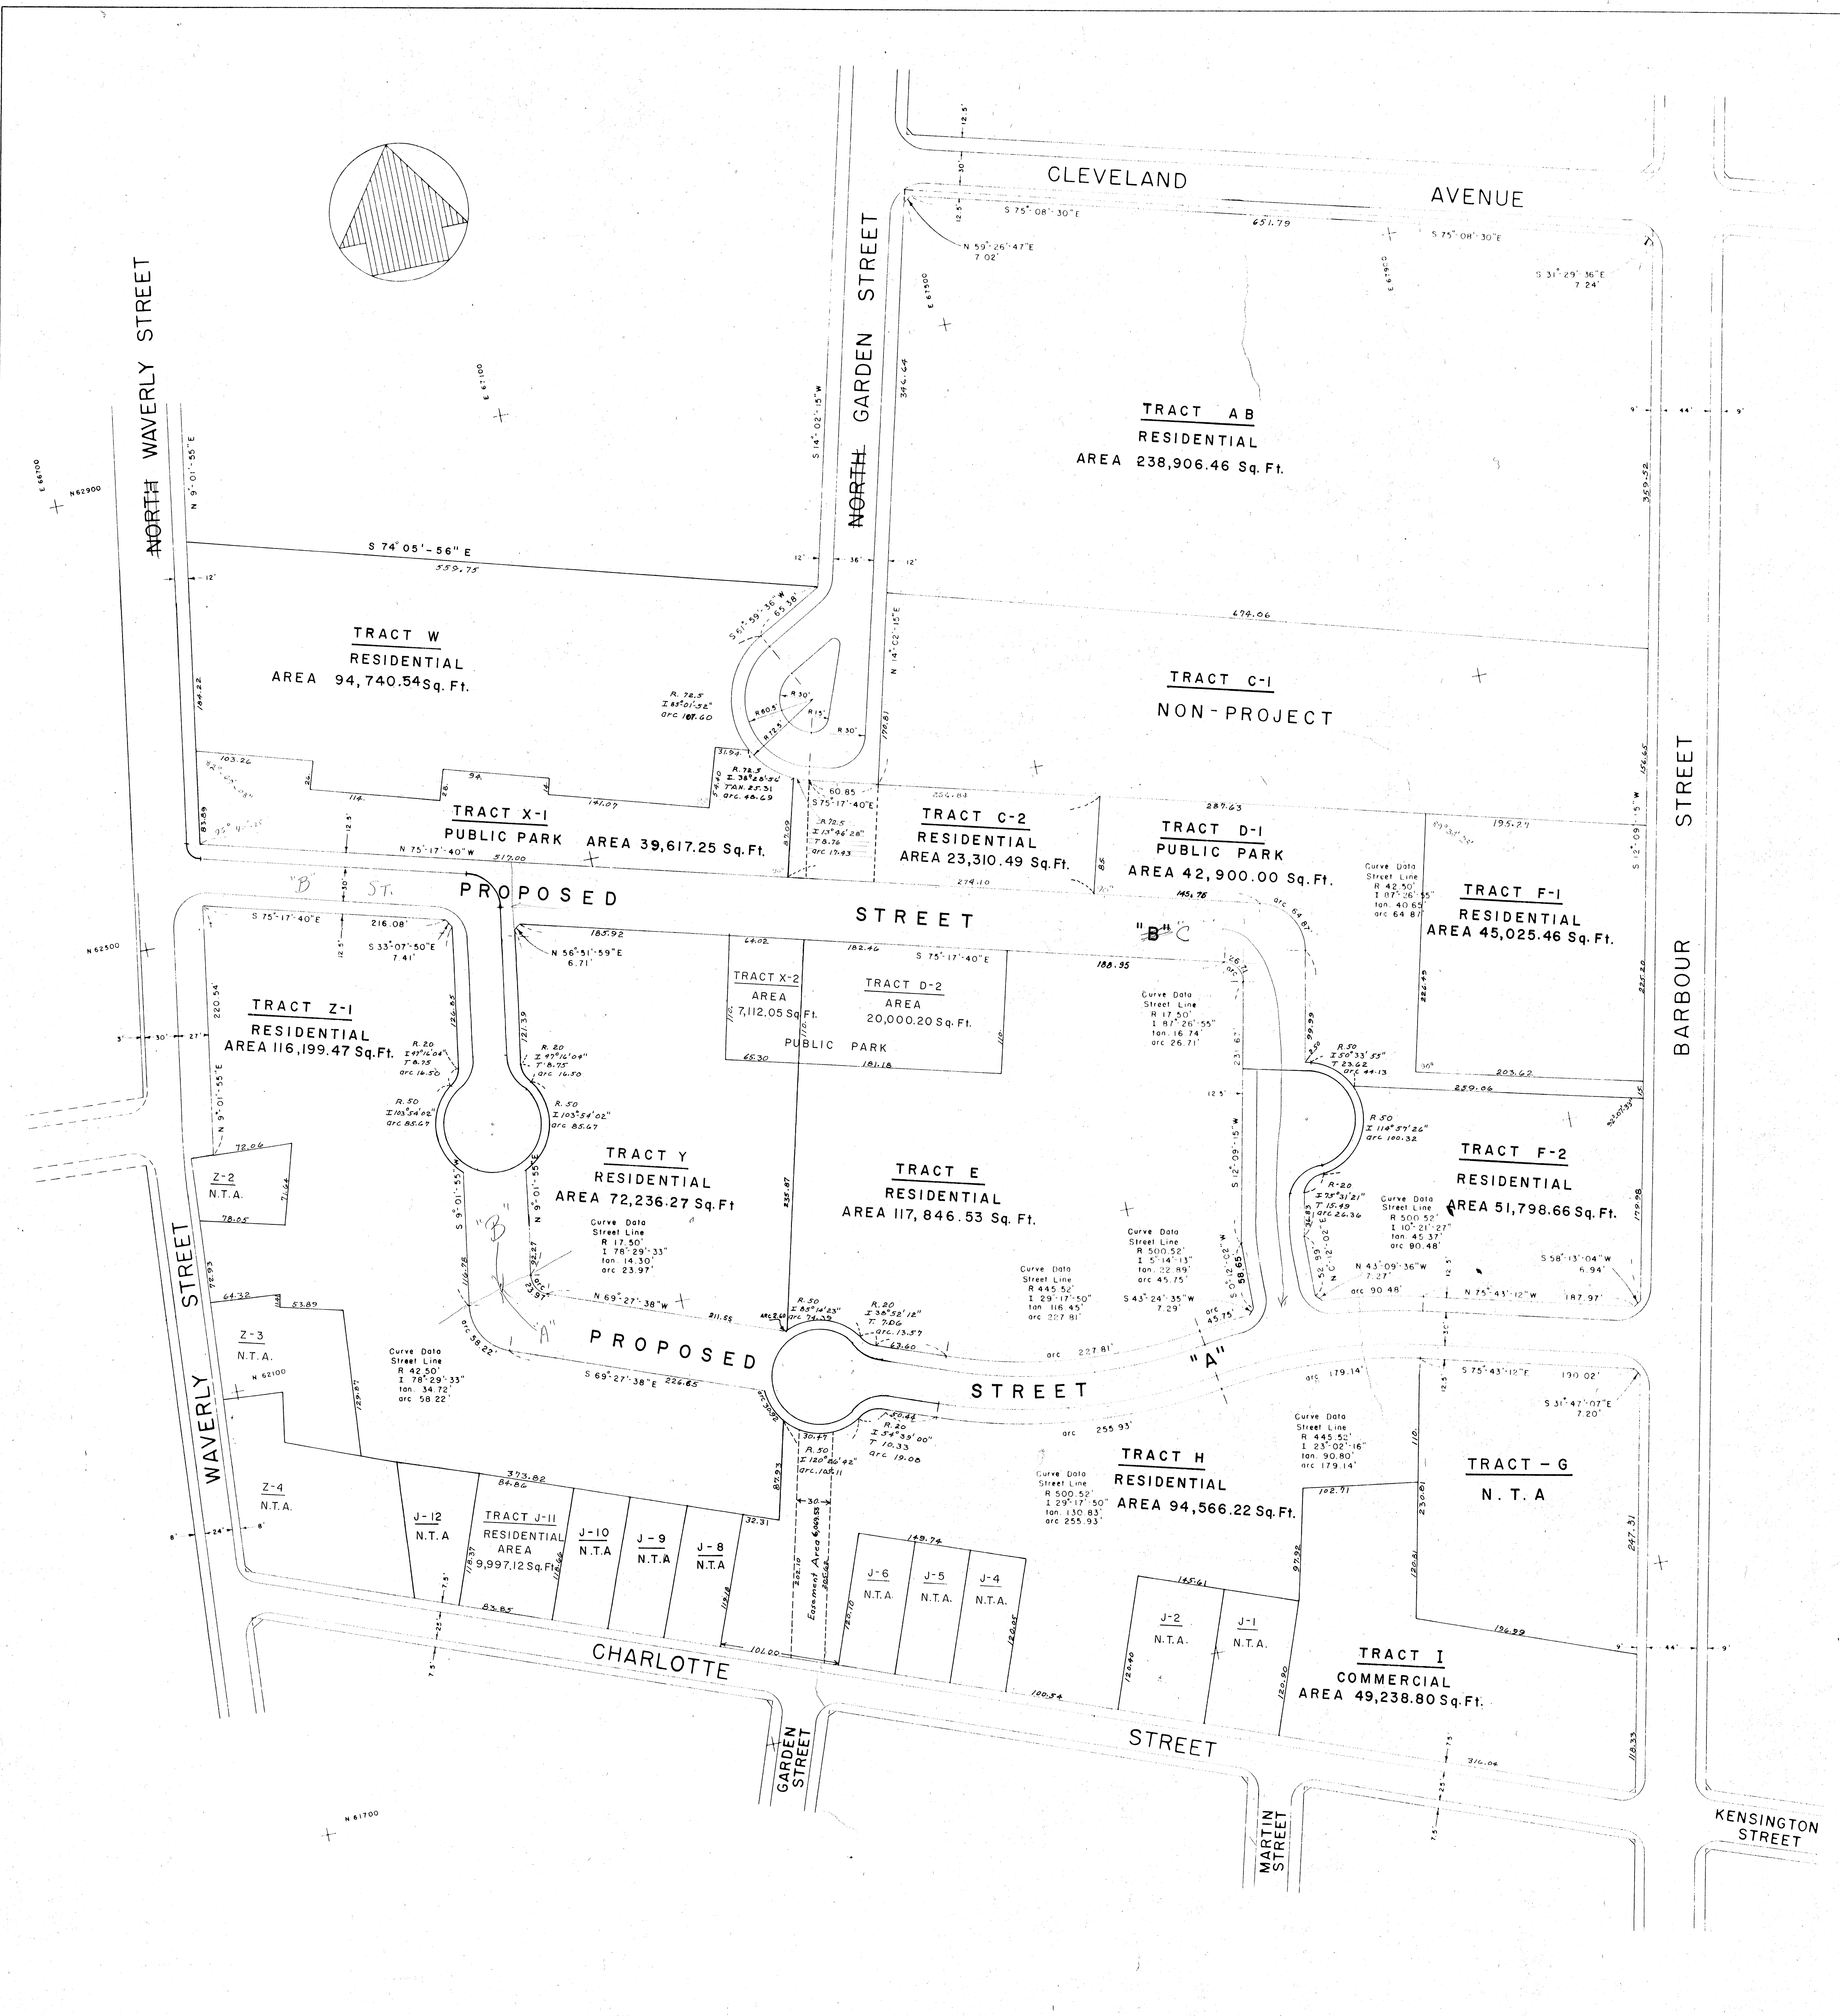

BARBOUR-CHARLOTTE & GARDEN-WAVERLY ST. PROJECTS MAP SHOWING DISPOSITION TRACTS

----- PROPOSED EASEMENT LINES

N.T.A NOT TO ACQUIRE BY AGENCY FOR
CLEARANCE & DISPOSITION