


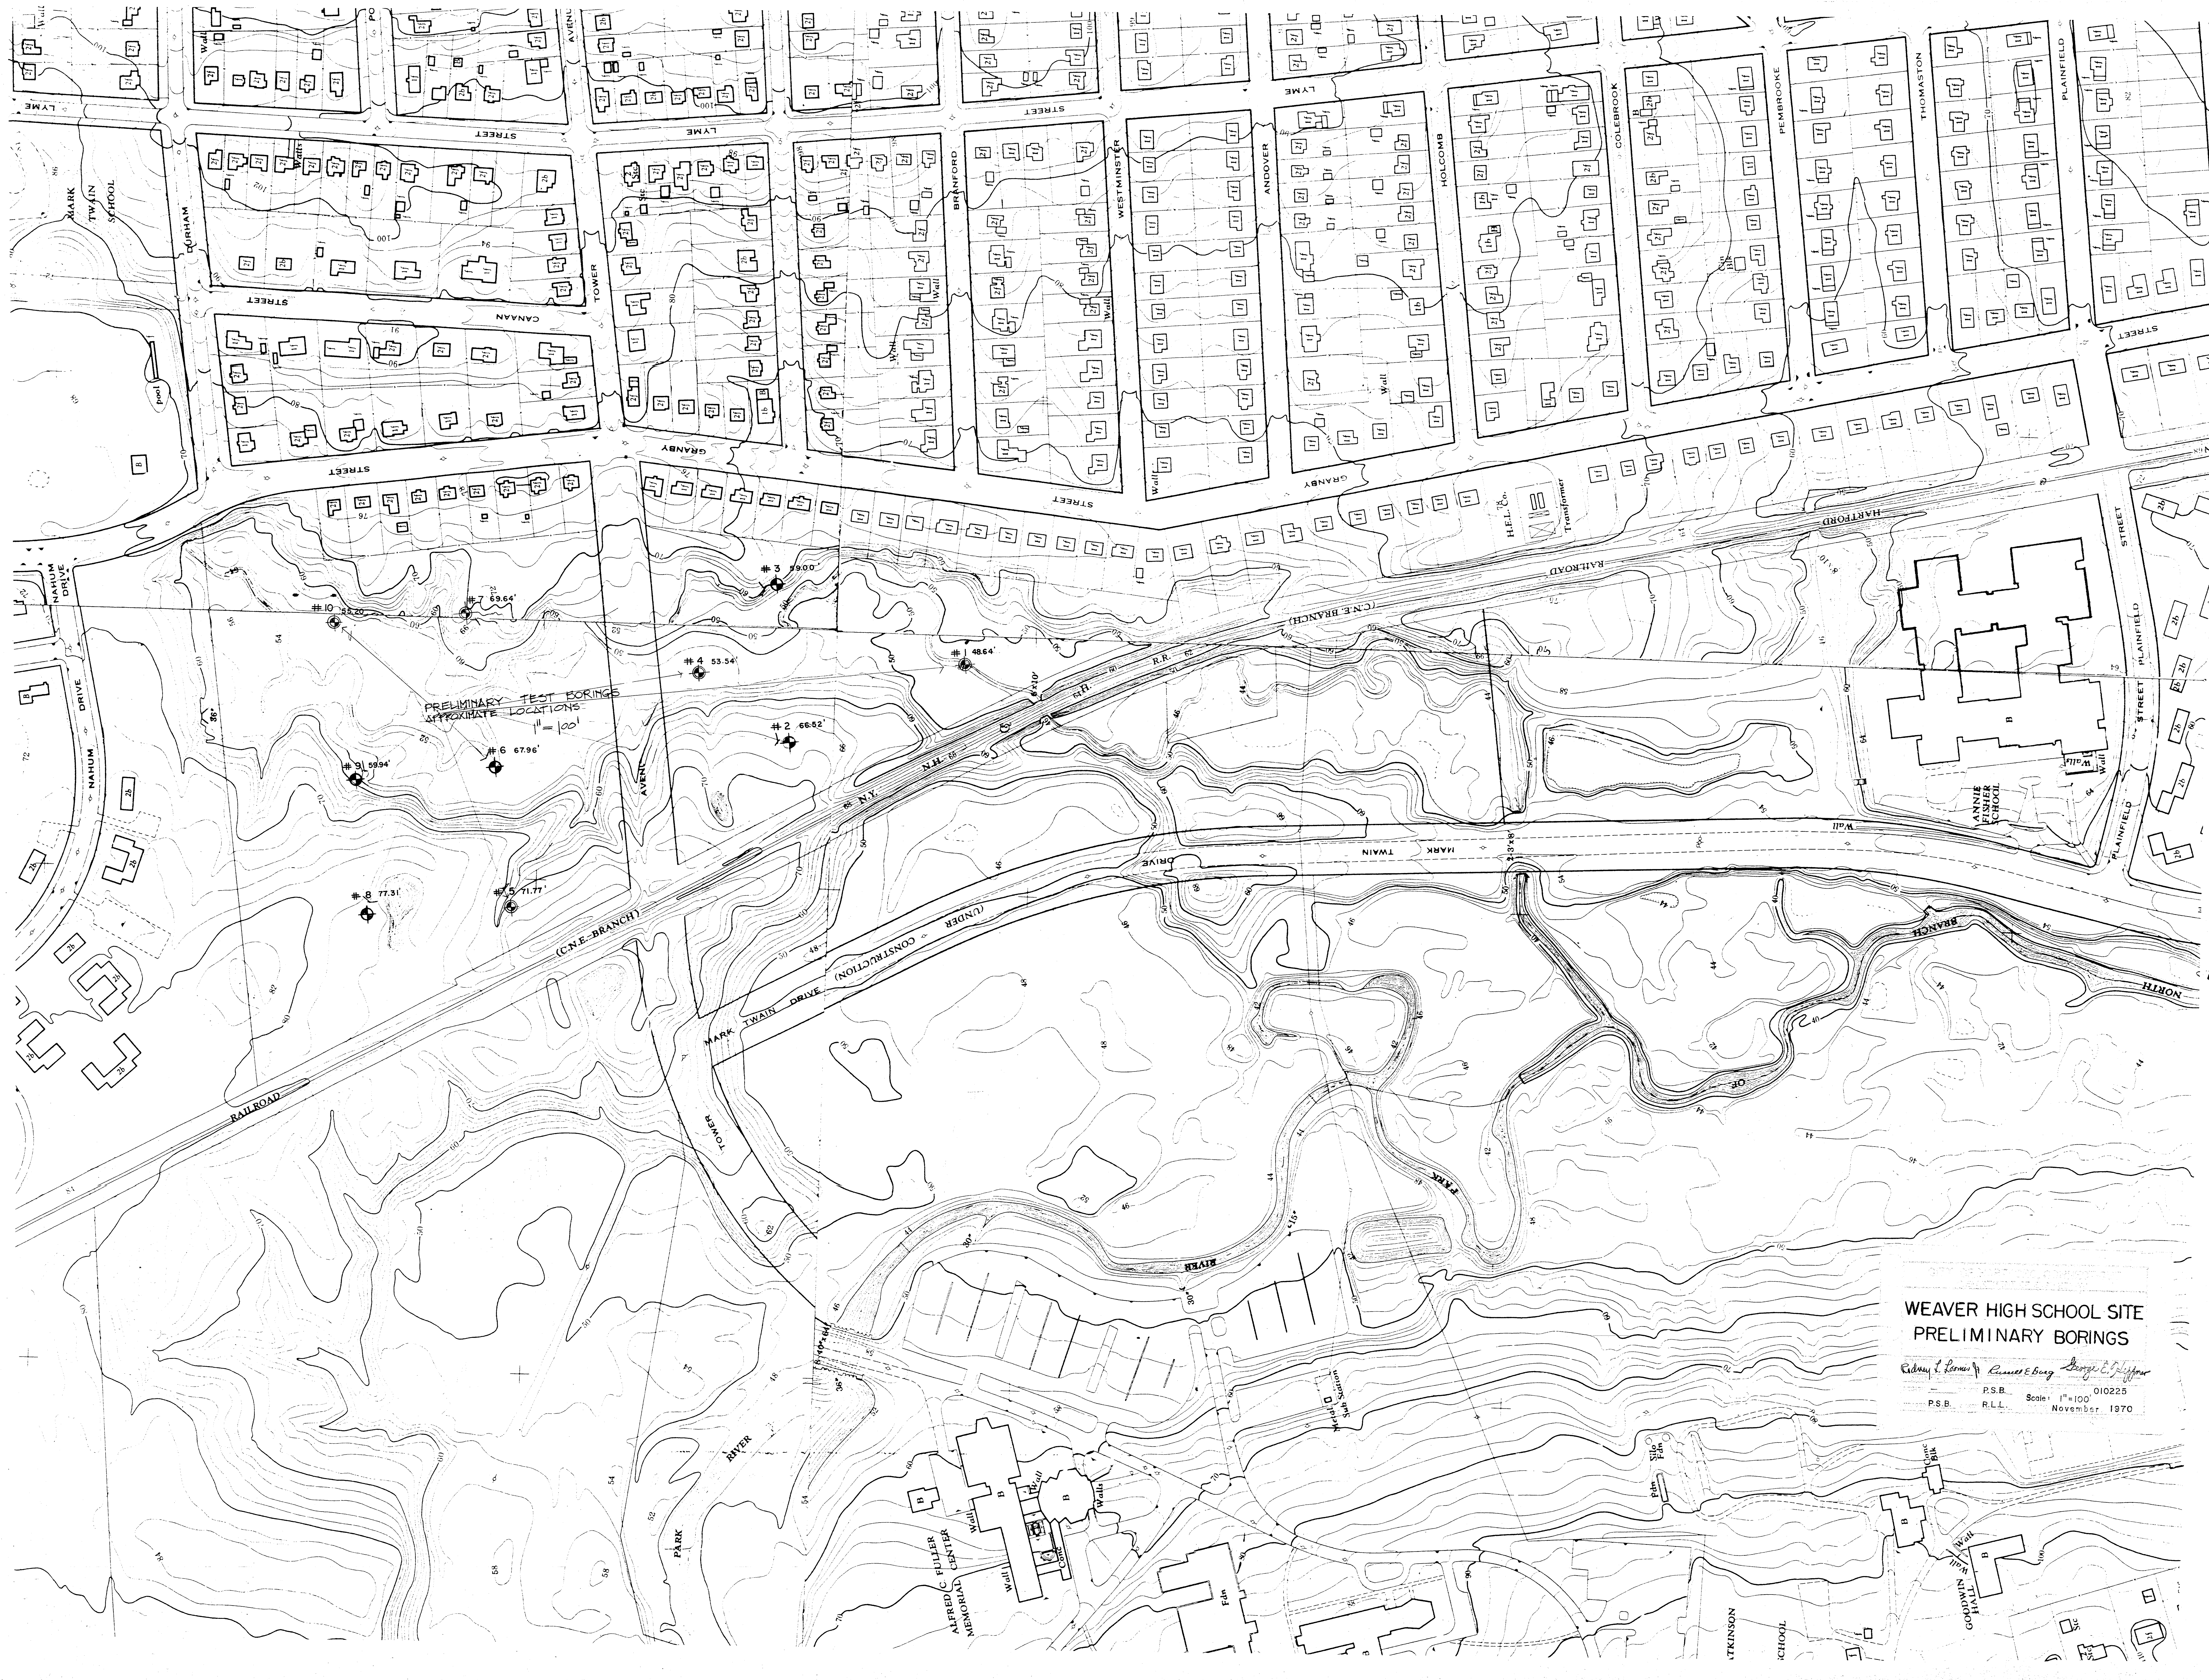

WEAVER HIGH SCHOOL SITE
PRELIMINARY BORINGS

Edwin L. Loomis & Russell E. Berg
P.S.B. 010225
Scale: 1"=100'
November 1970