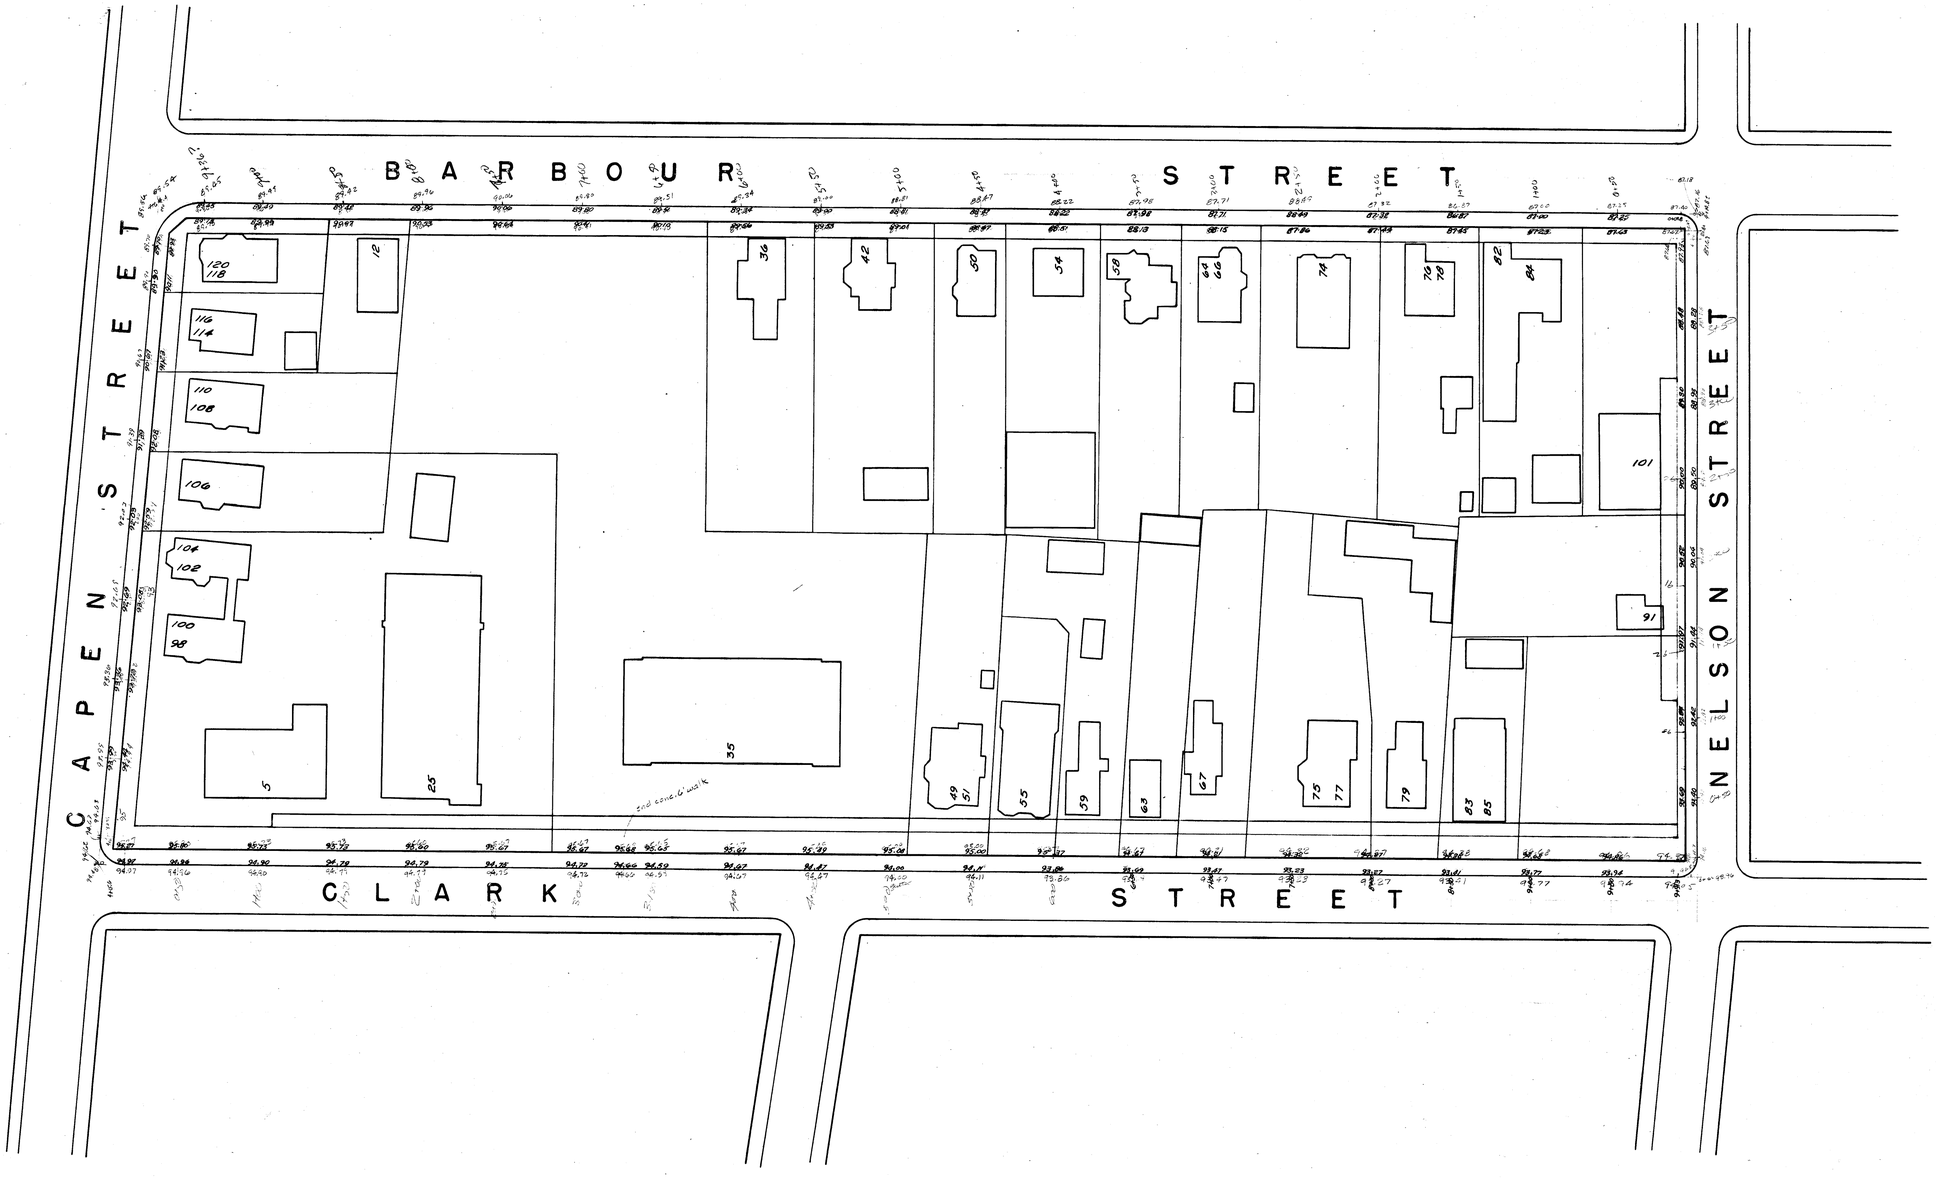

CLARK ST School Elevations
Scale: 1"=40' Date:

Daybook No 09986-F