



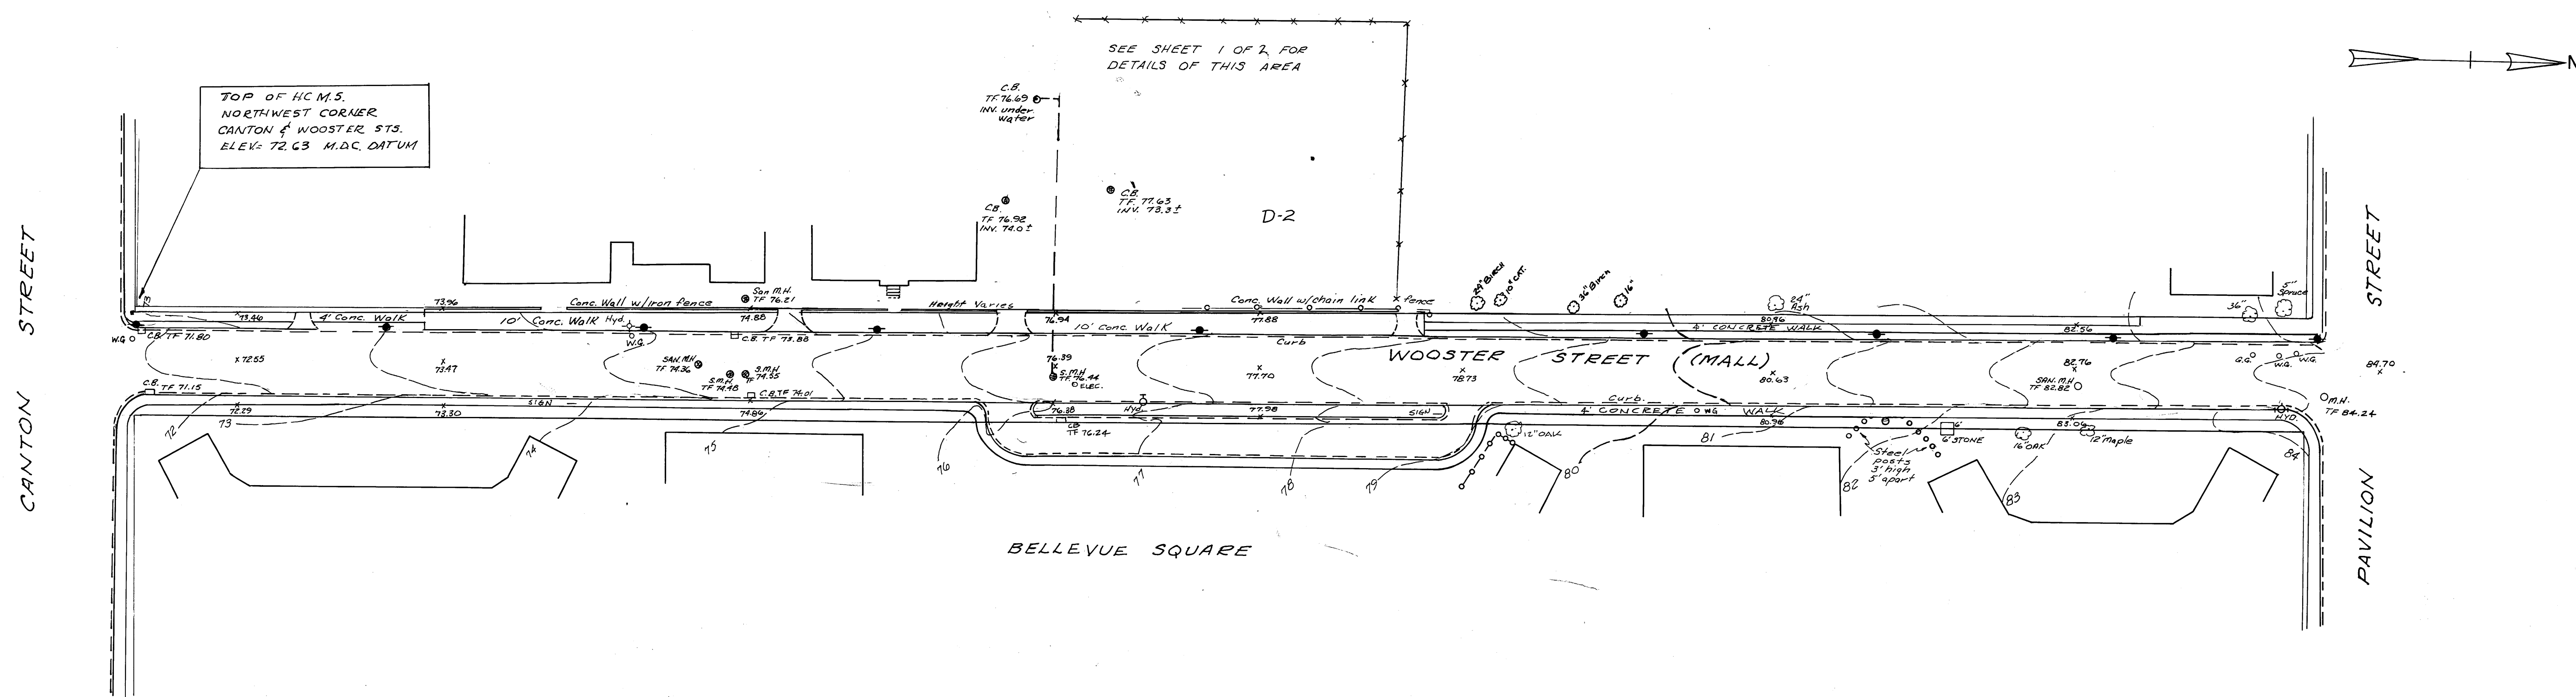

I HEREBY CERTIFY THIS MAP TO
BE SUBSTANTIALLY CORRECT AND IN
ACCORDANCE WITH, CLASS A-2 OF CODE
OF CONN. TECHNICAL COUNCIL, INC.
Morton S. Fine
REGISTERED LAND SURVEYOR

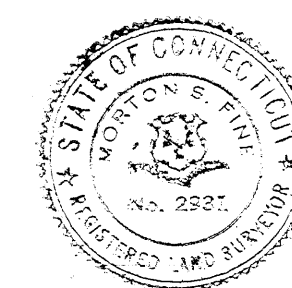

CITY OF HARTFORD, CONNECTICUT
DEPARTMENT OF PUBLIC WORKS
BUREAU OF ENGINEERING SERVICES

PARTIAL TOPOGRAPHY SURVEY
SOUTH ARSENAL REDEVELOPMENT
PROJECT

SUBMITTED	RECOMMENDED	APPROVED
	<i>James E. Day</i>	<i>James E. Day</i>
DIVISION ENGINEER	CHIEF OF ENG. DIV.	CHIEF OF ENG. DIV.
DRAWN: <i>C.D.</i>	SCALE: 1" = 40'	DAYBOOK NO. 010433-B
CHECKED: <i>M.S.</i>		DATE: SEPT. 1974

MORTON S. FINE & ASSOCIATES, INC.
711 Cottage Grove Rd.
Bloomfield, Conn.
Engineers Landscape Architects Surveyors