


City of
Hartford

SOUTH ARSENAL
NEIGHBORHOOD ASSOCIATES
HARTFORD, CONN.

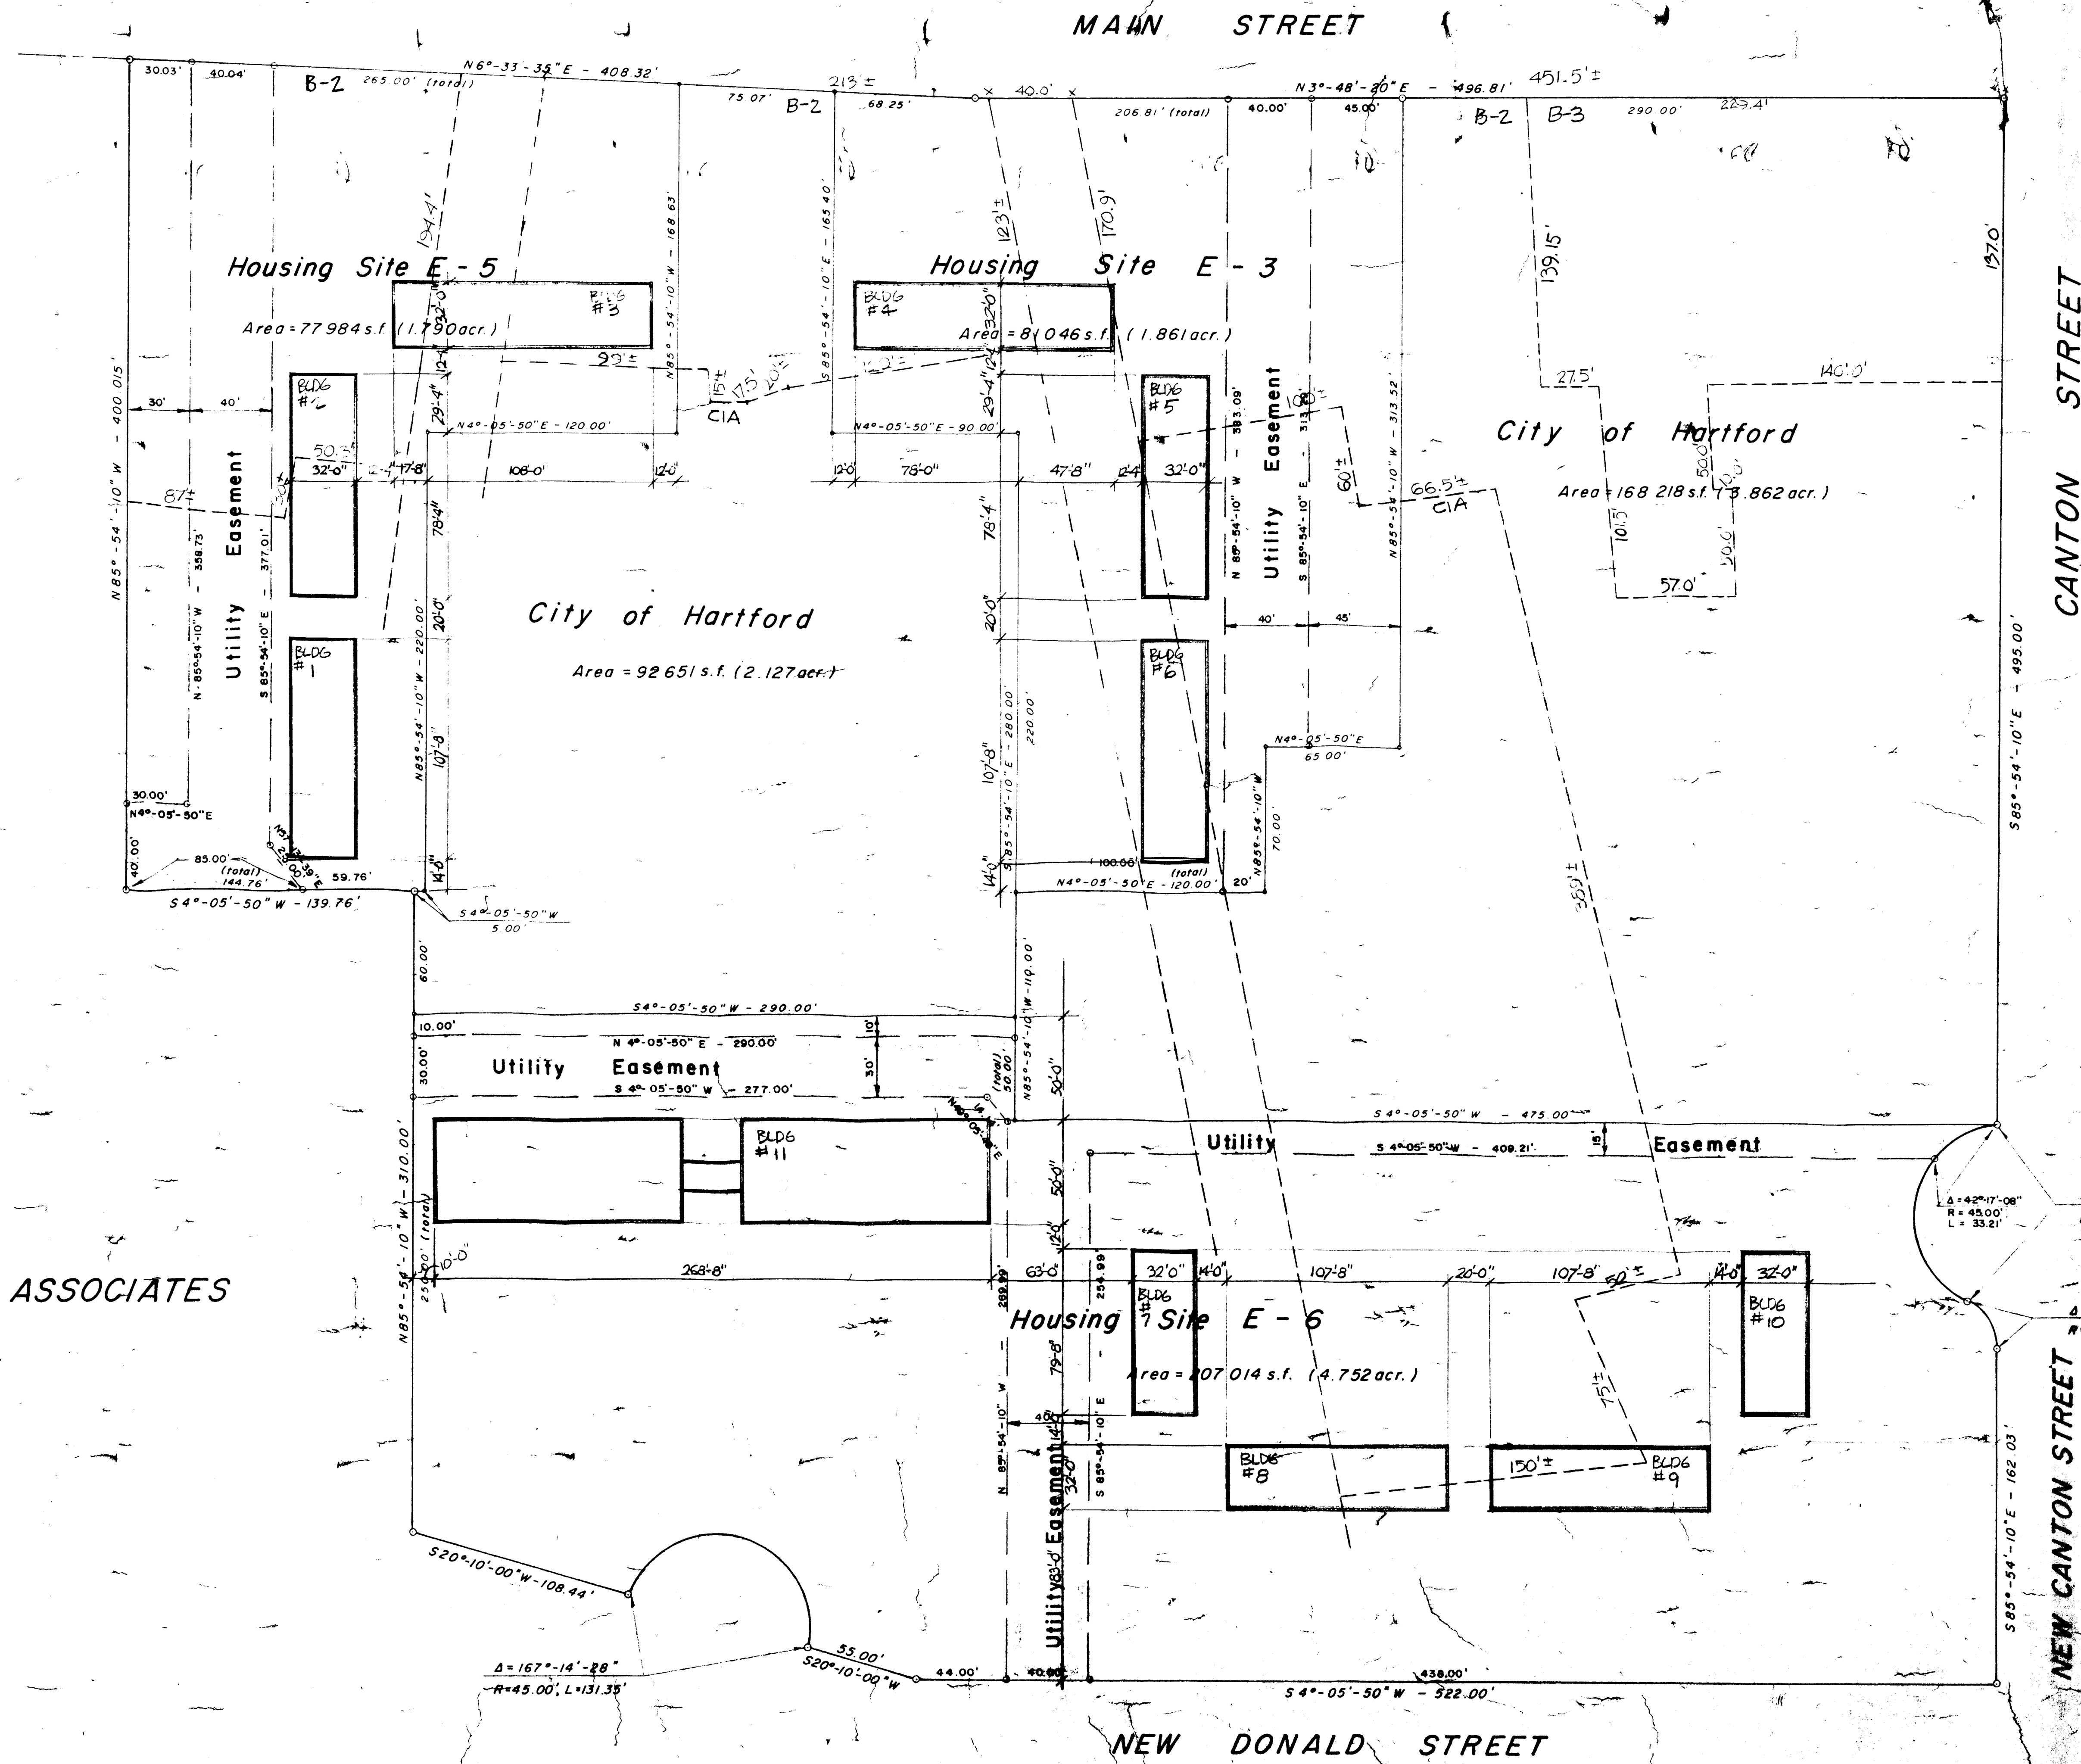


To: Lawyers Title Insurance Corp.
Conn. Housing Finance Authority
Secretary of Housing and Urban Development
South Arsenal Neighborhood Associates




Drawn by No. 010435C

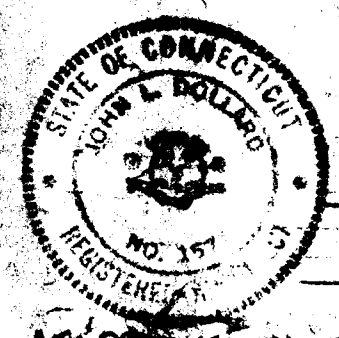

SUPPLEMENTARY
DRAWING NO. 1
BLDG. SITING DIMENSIONS

12-1-73
AS SHOWN ON SEPA PROVIDED BY L. VECHELOV
Adopted 10-12-73

IGOR VECHELOV
PROFESSIONAL ENGINEER & LAND SURVEYOR
31 LORRAINE STREET
HARTFORD, CONNECTICUT

SCALE: 1" = 40'
DATE: 4-1-73
DRAWING NO. 1