PROPERTY
OF

THE BIDWELL HARDWARE COMPANY
AND
THE BIDWELL REALTY COMPANY

MAIN AND ANN STREETS
HARTFORD, CONN.

SCALE: 1 INCH = 10 FEET MAY, 1955 ADDITIONS MAY, 1968

PETERSEN & HOFFMAN, ENG'RS.
SUCCESSORS TO SPENCER & WASHBURN, INC.

WE HEREBY CERTIFY THAT THIS MAP IS SUBSTANTIALLY CORRECT.

Theodore P. Petersen
Edward J. Hoffman
Melvin C. Stead Jr.
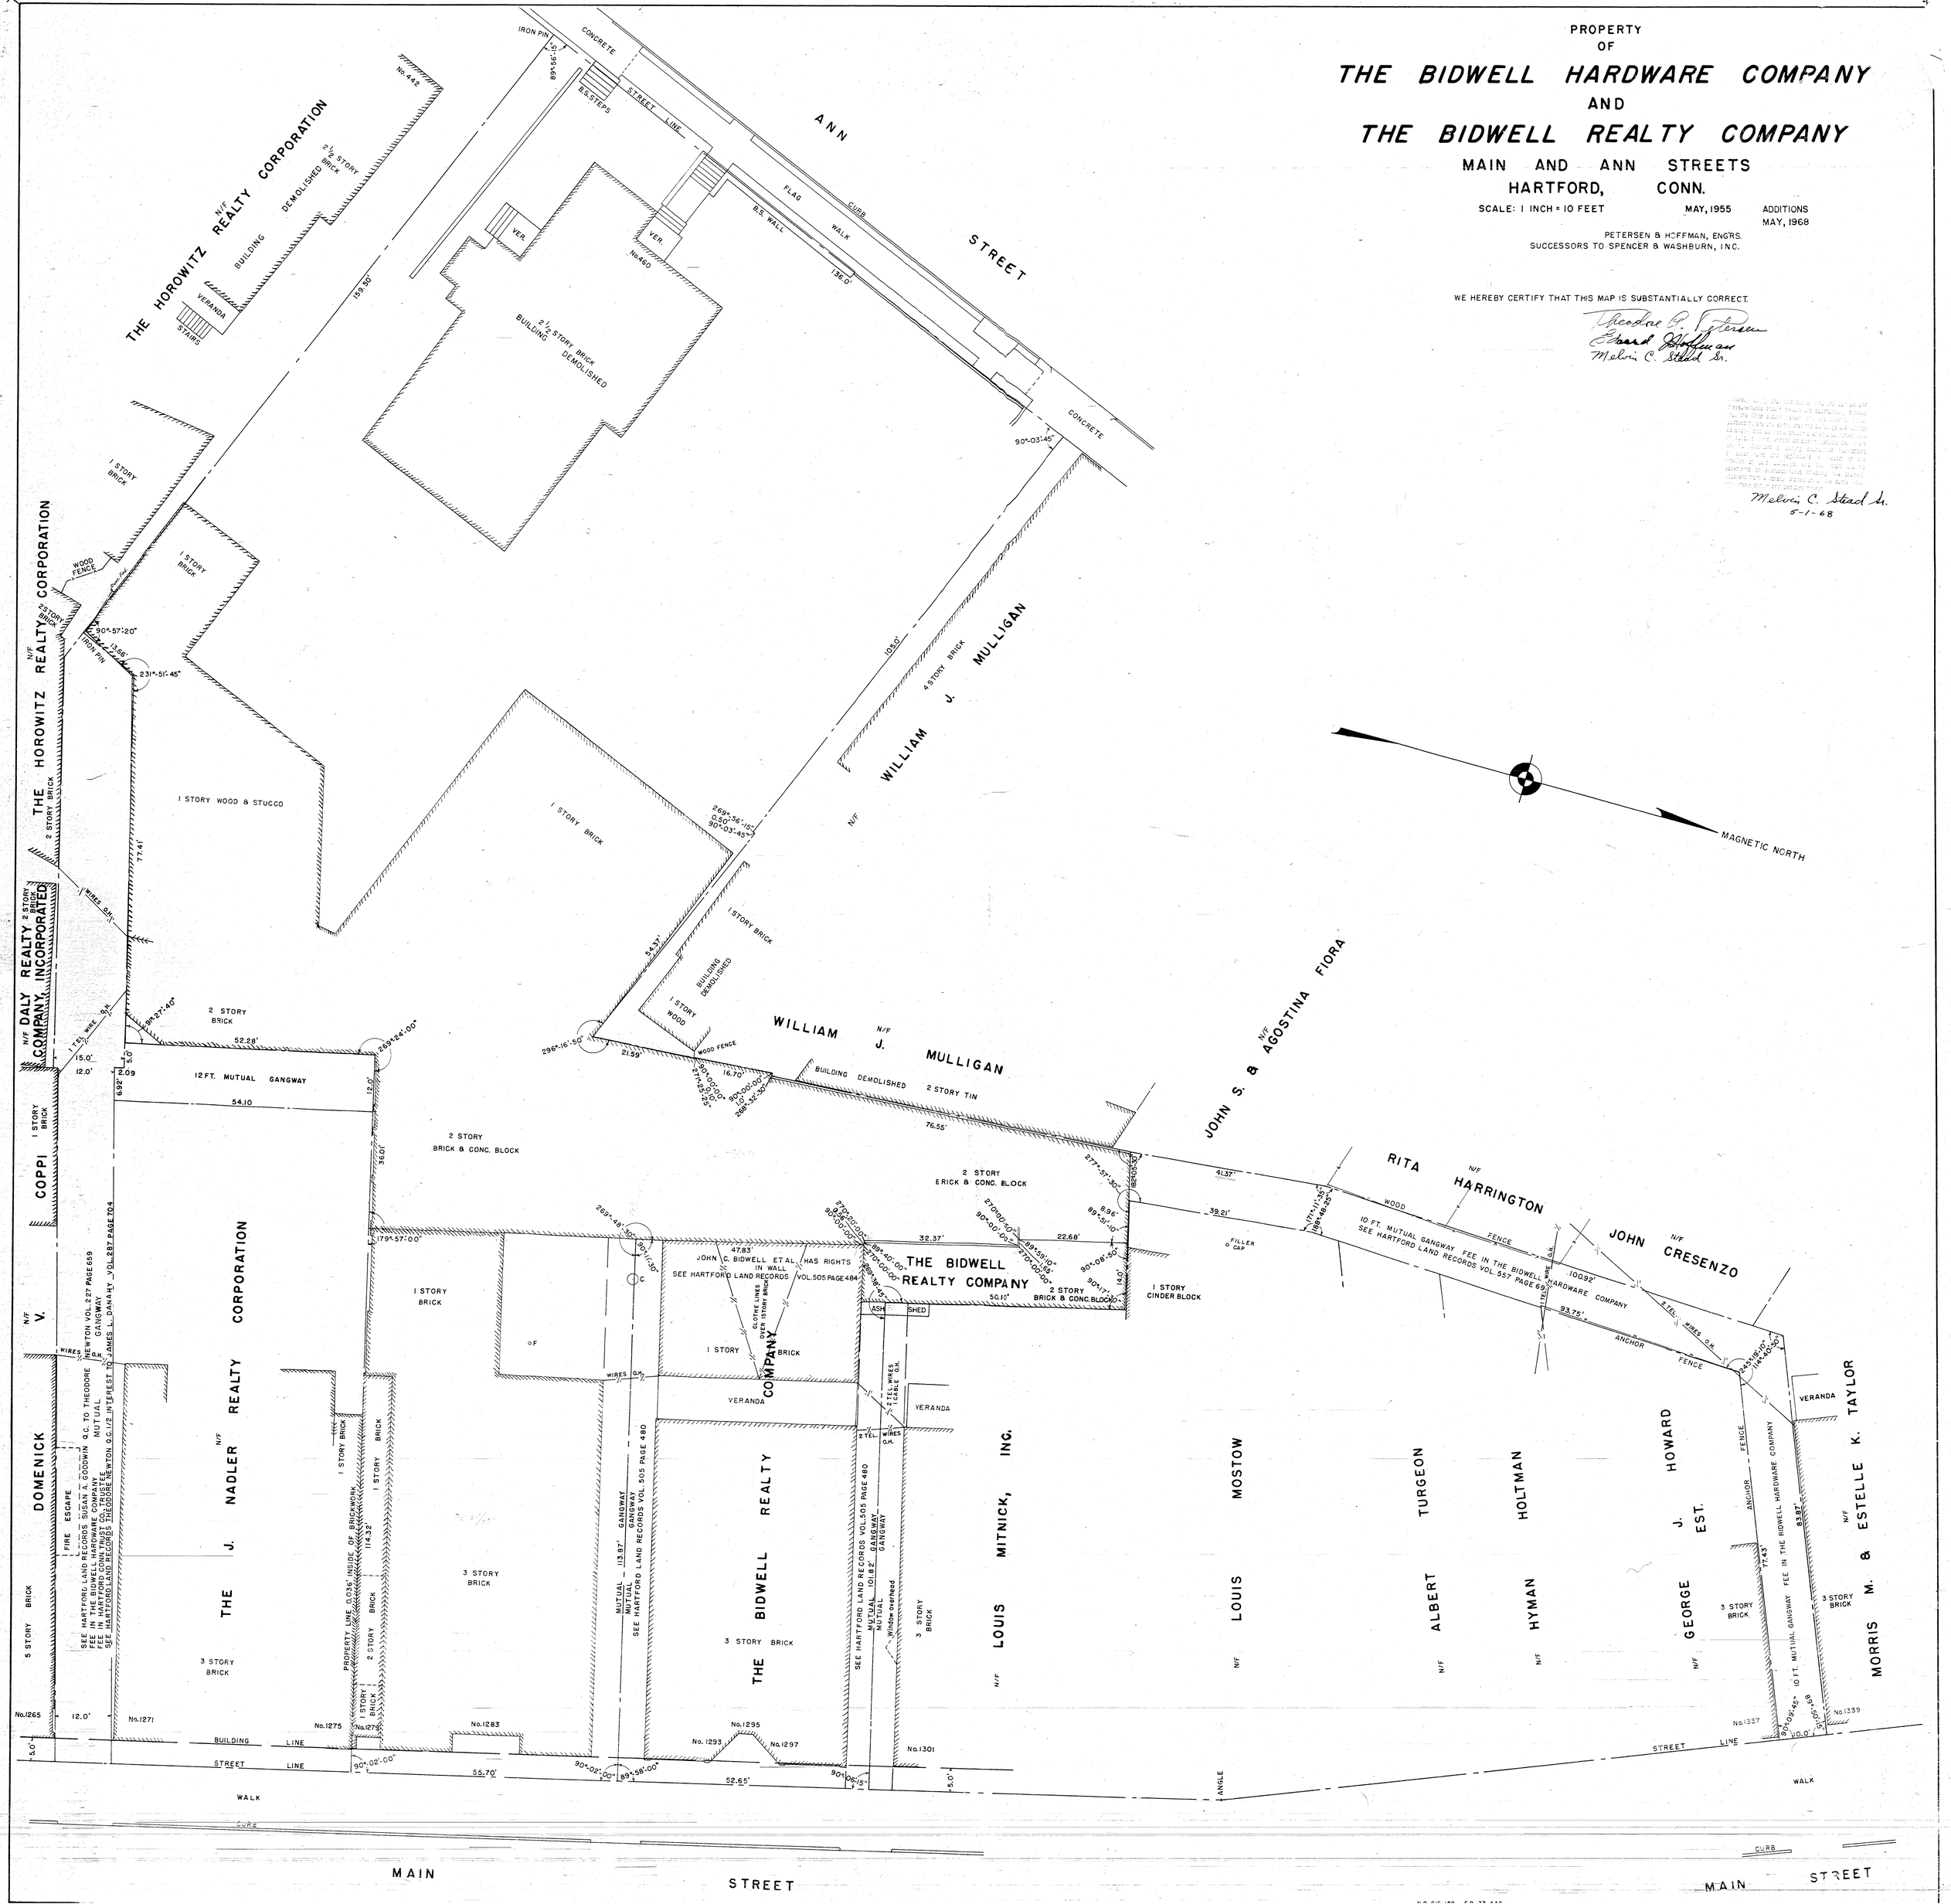
Melvin C. Stead Jr.
5-1-68