


S e e                      S h e e t                      ~~38~~      41

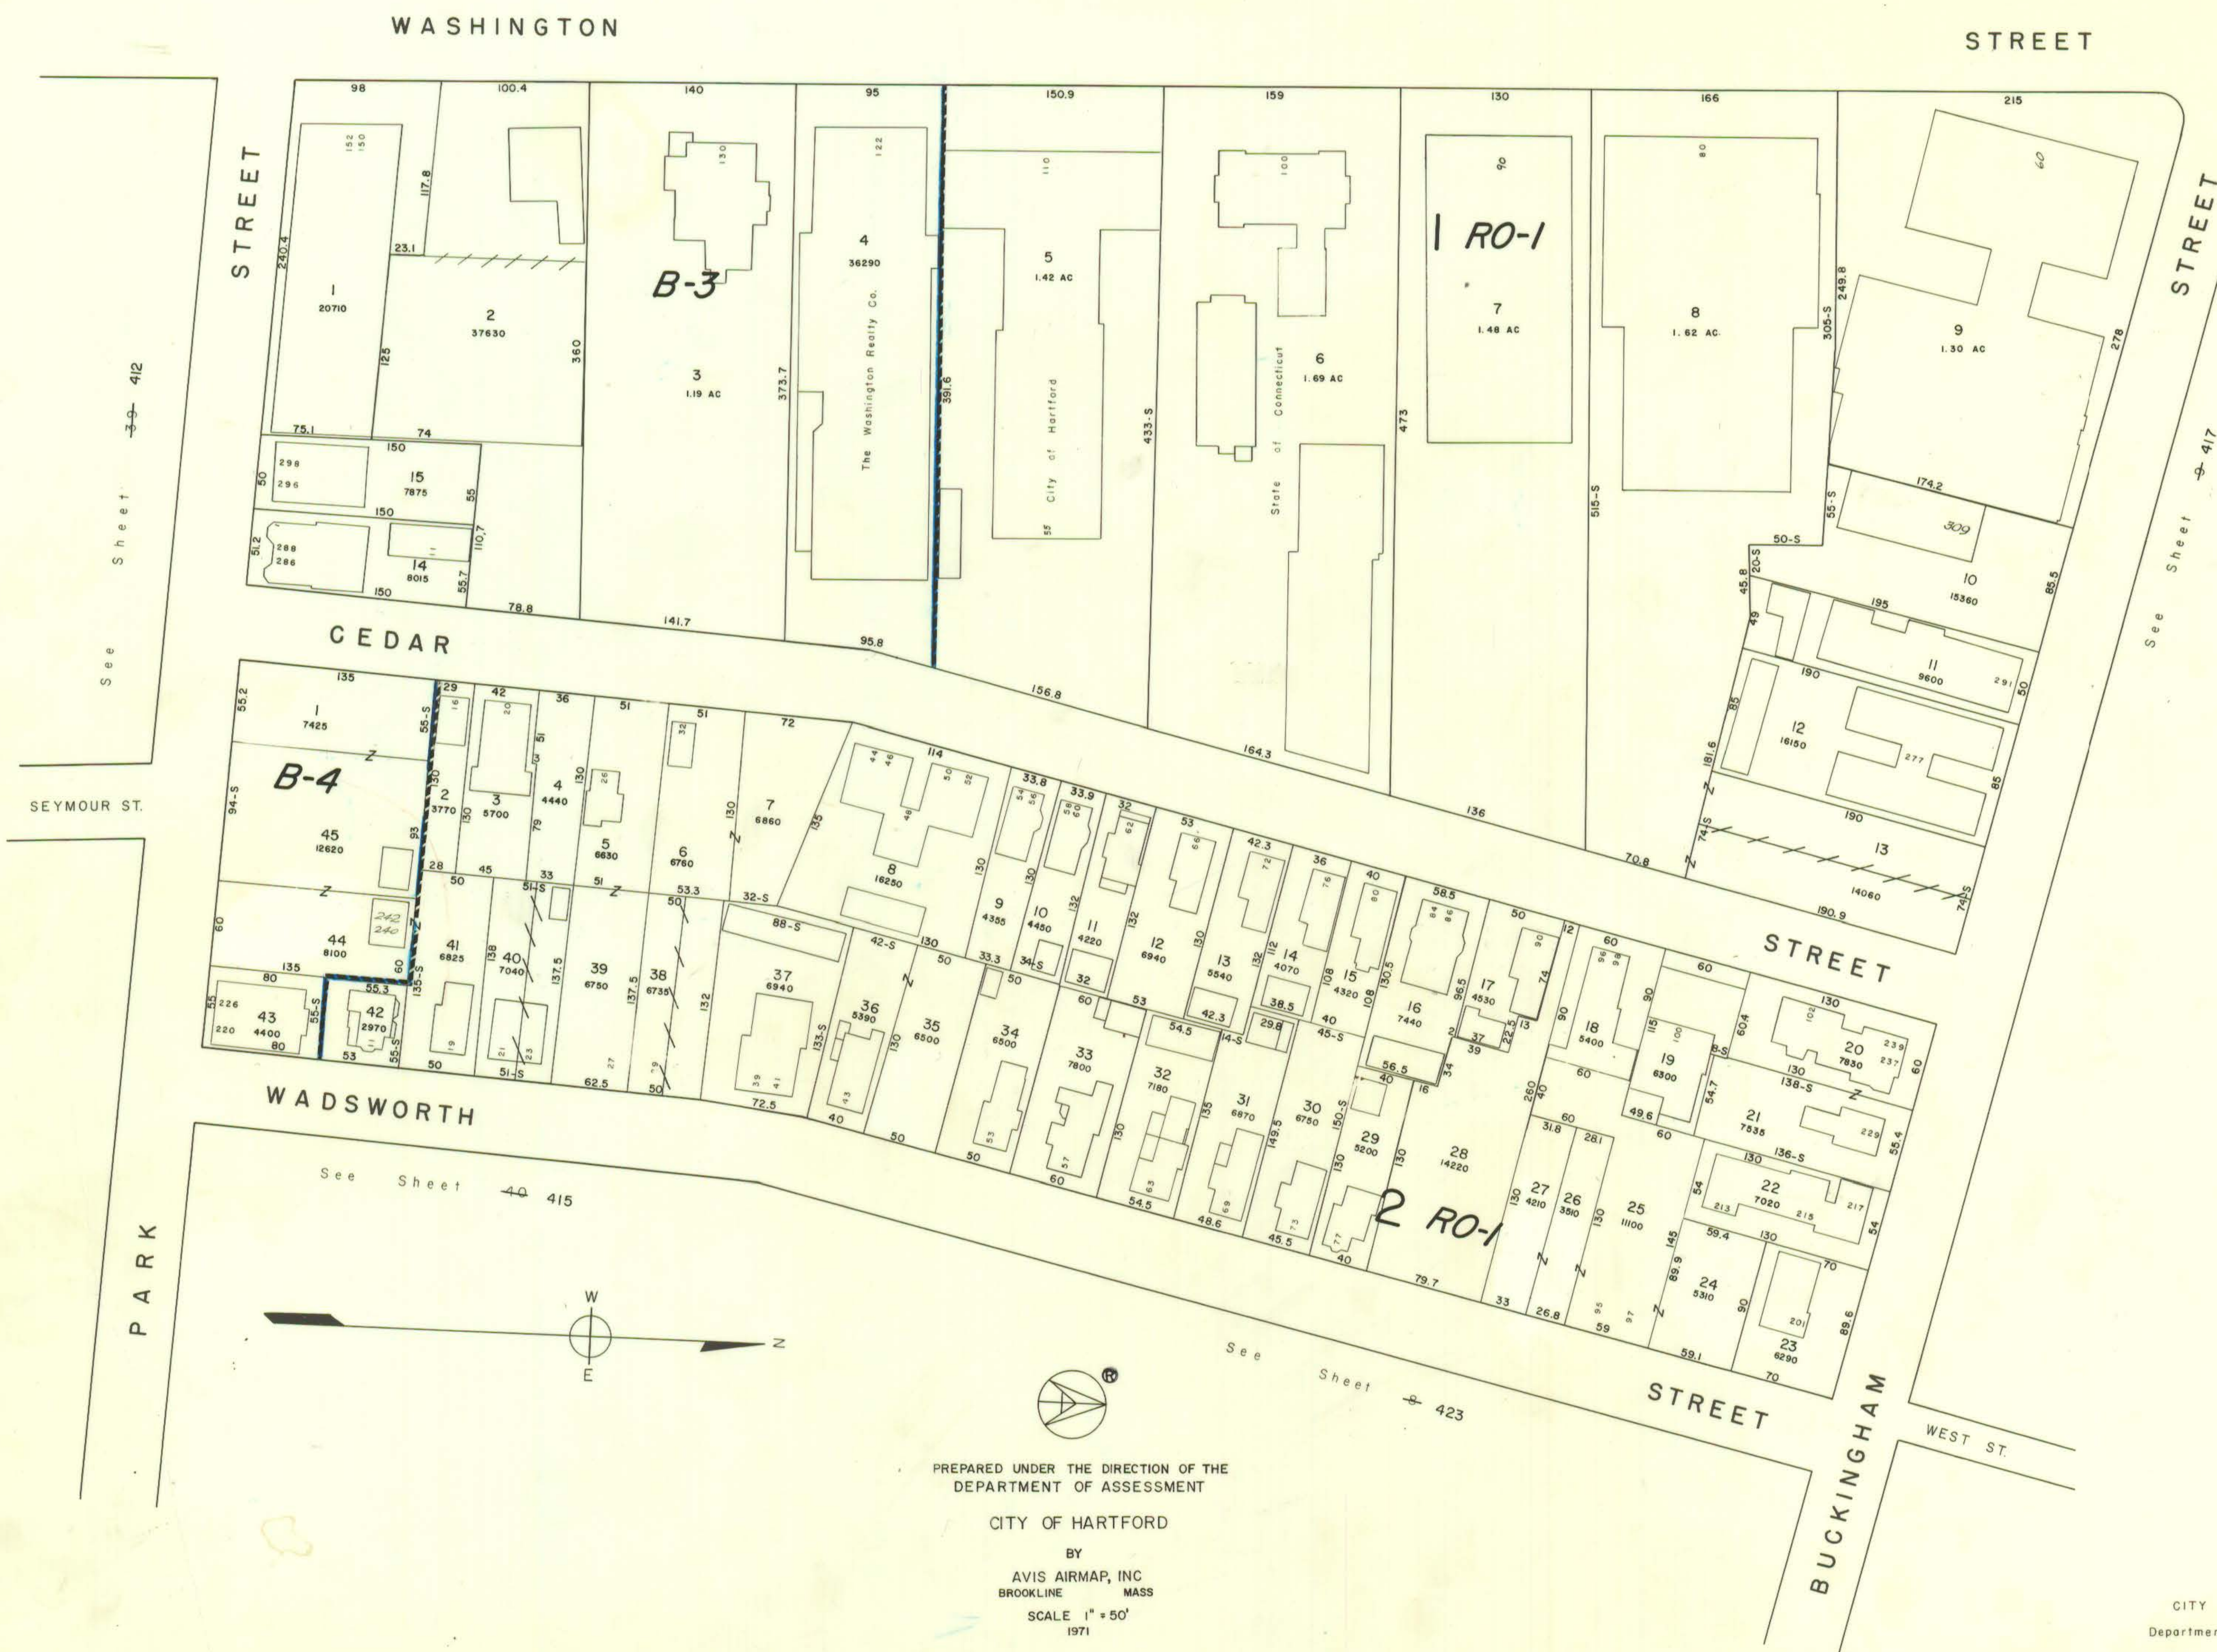

Property lines and building outlines by the City of Hartford Engineering Department  
Block, lot and zone numbers by Avis Airmap  
Area calculations by Avis Airmap

CITY OF HARTFORD  
Department of Engineering