



See Sheet 54 403

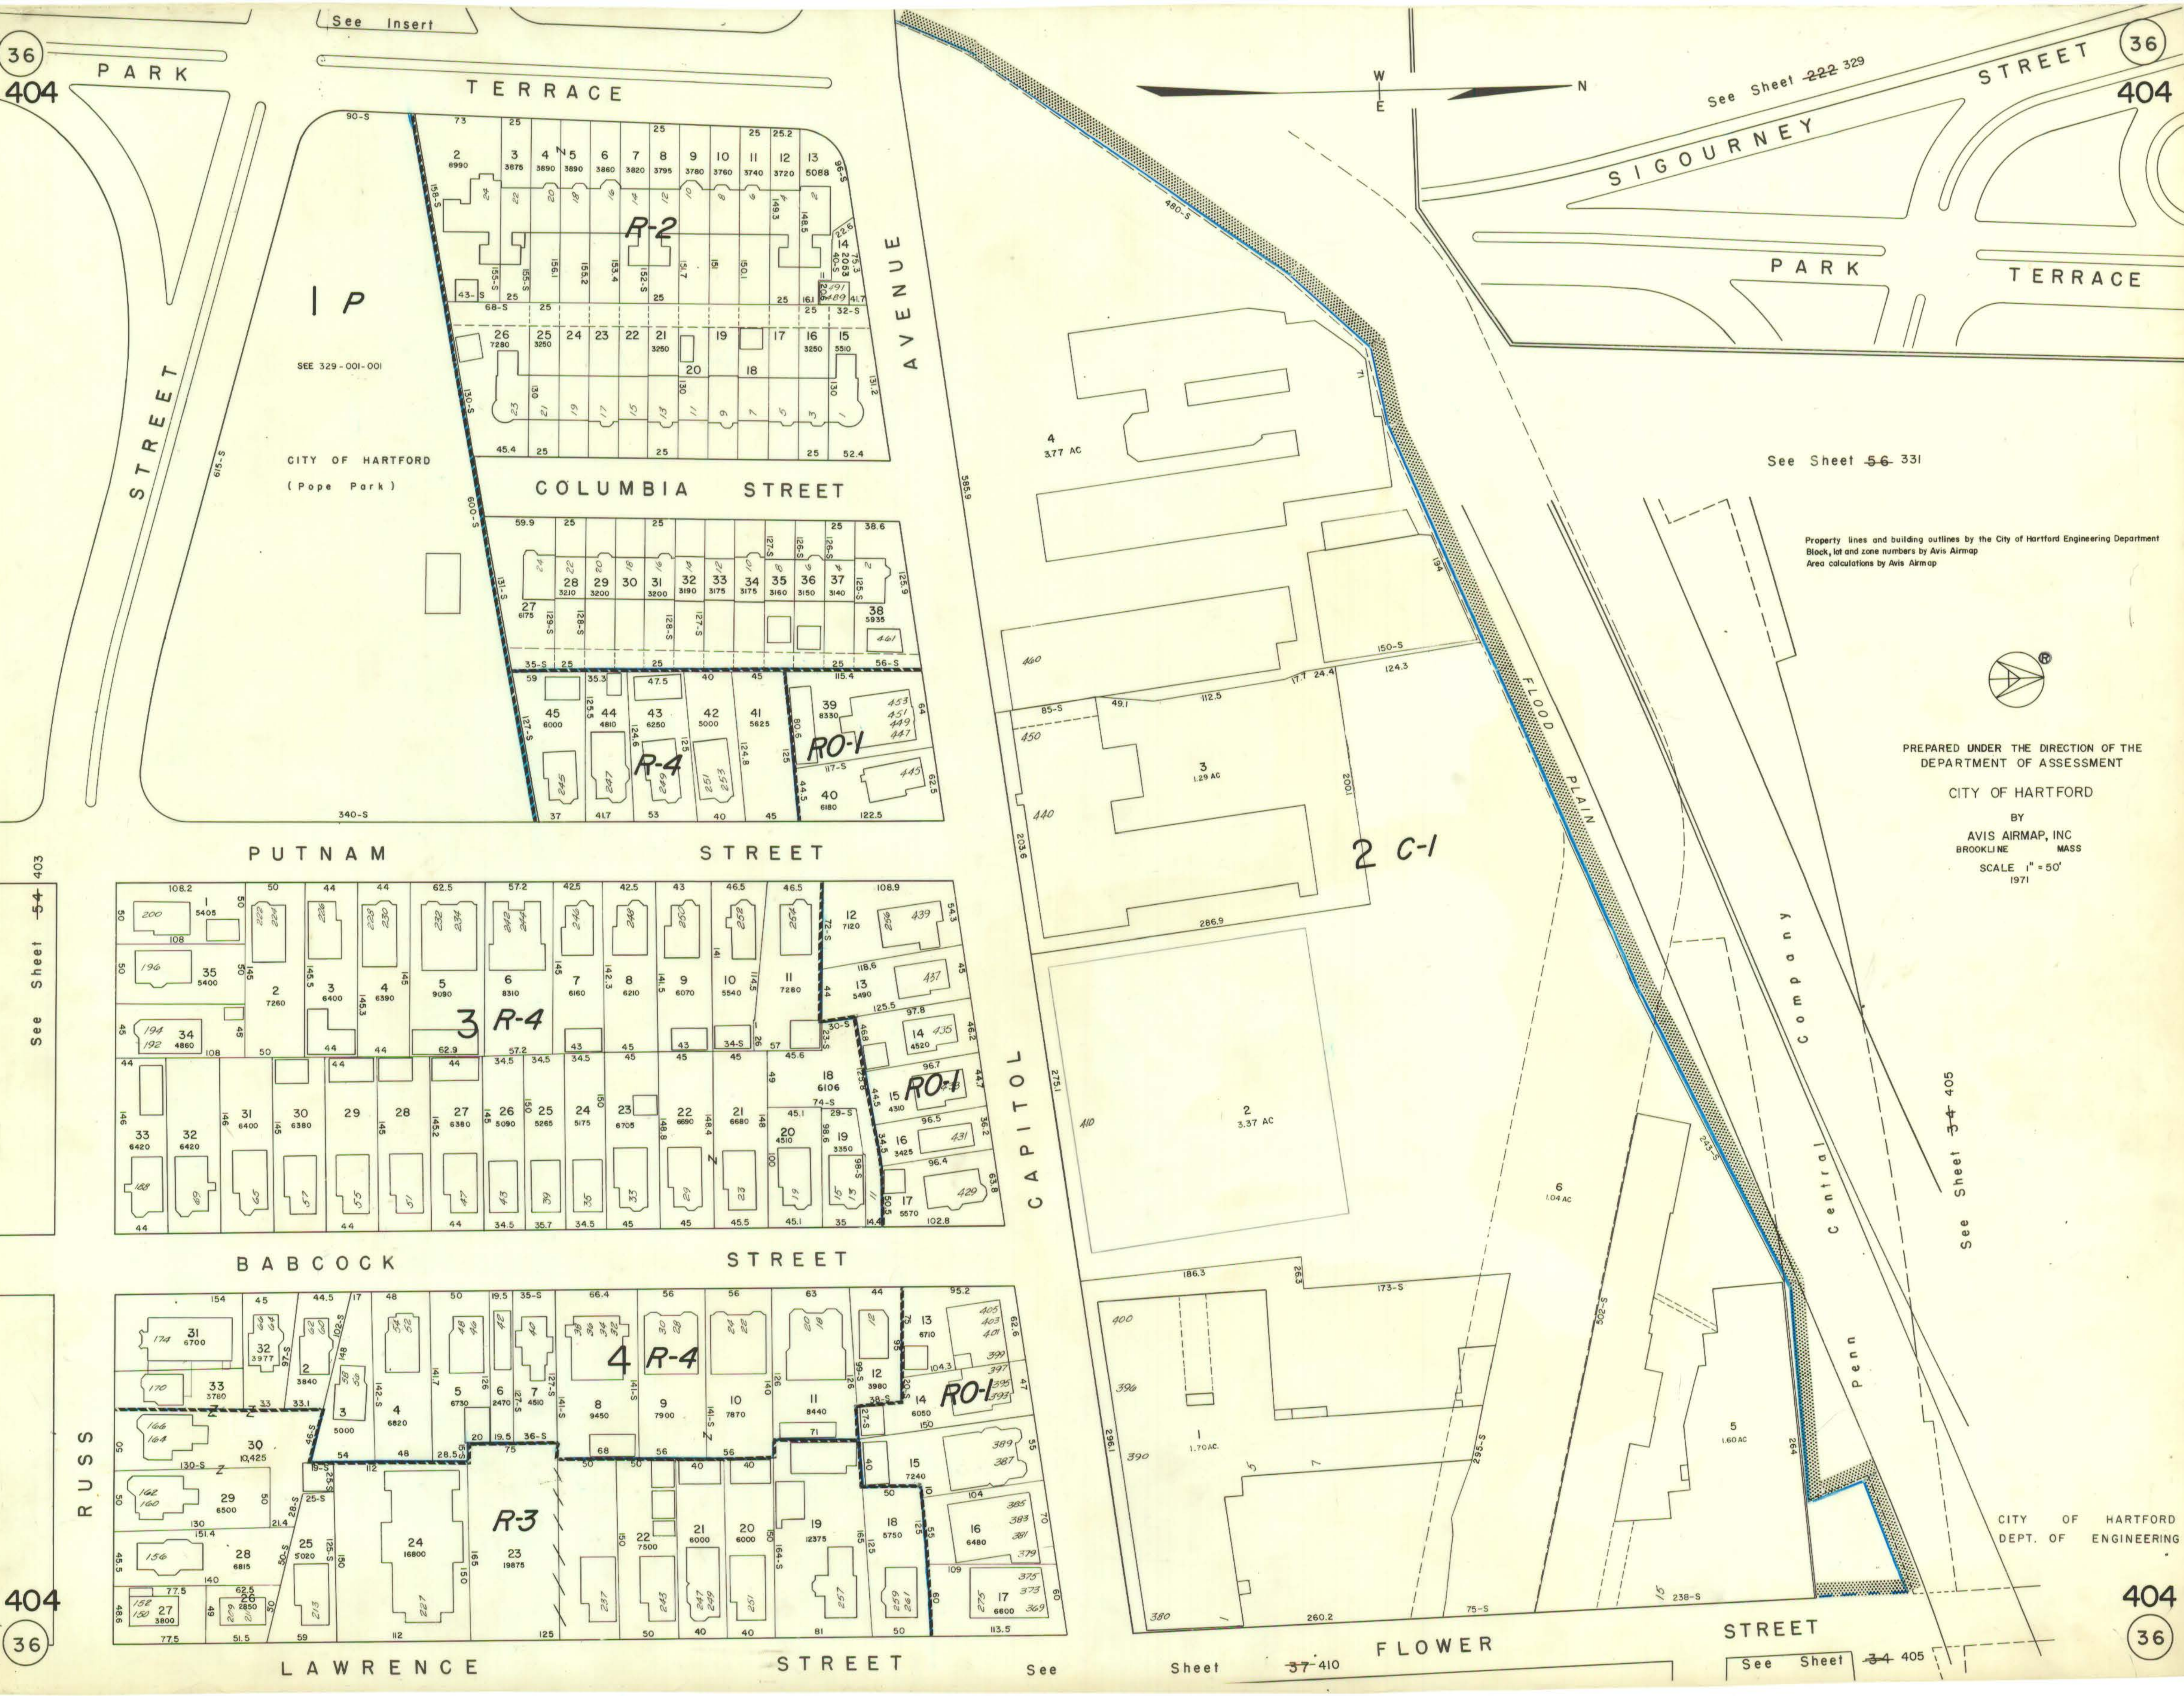

Property lines and building outlines by the City of Hartford Engineering Department
Block, lot and zone numbers by Avis Airmap
Area calculations by Avis Airmap

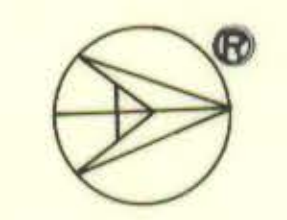

PREPARED UNDER THE DIRECTION OF THE
DEPARTMENT OF ASSESSMENT

CITY OF HARTFORD

BY
AVIS AIRMAP, INC
BROOKLINE MASS
SCALE 1" = 50'
1971

CITY OF HARTFORD
DEPT. OF ENGINEERING