

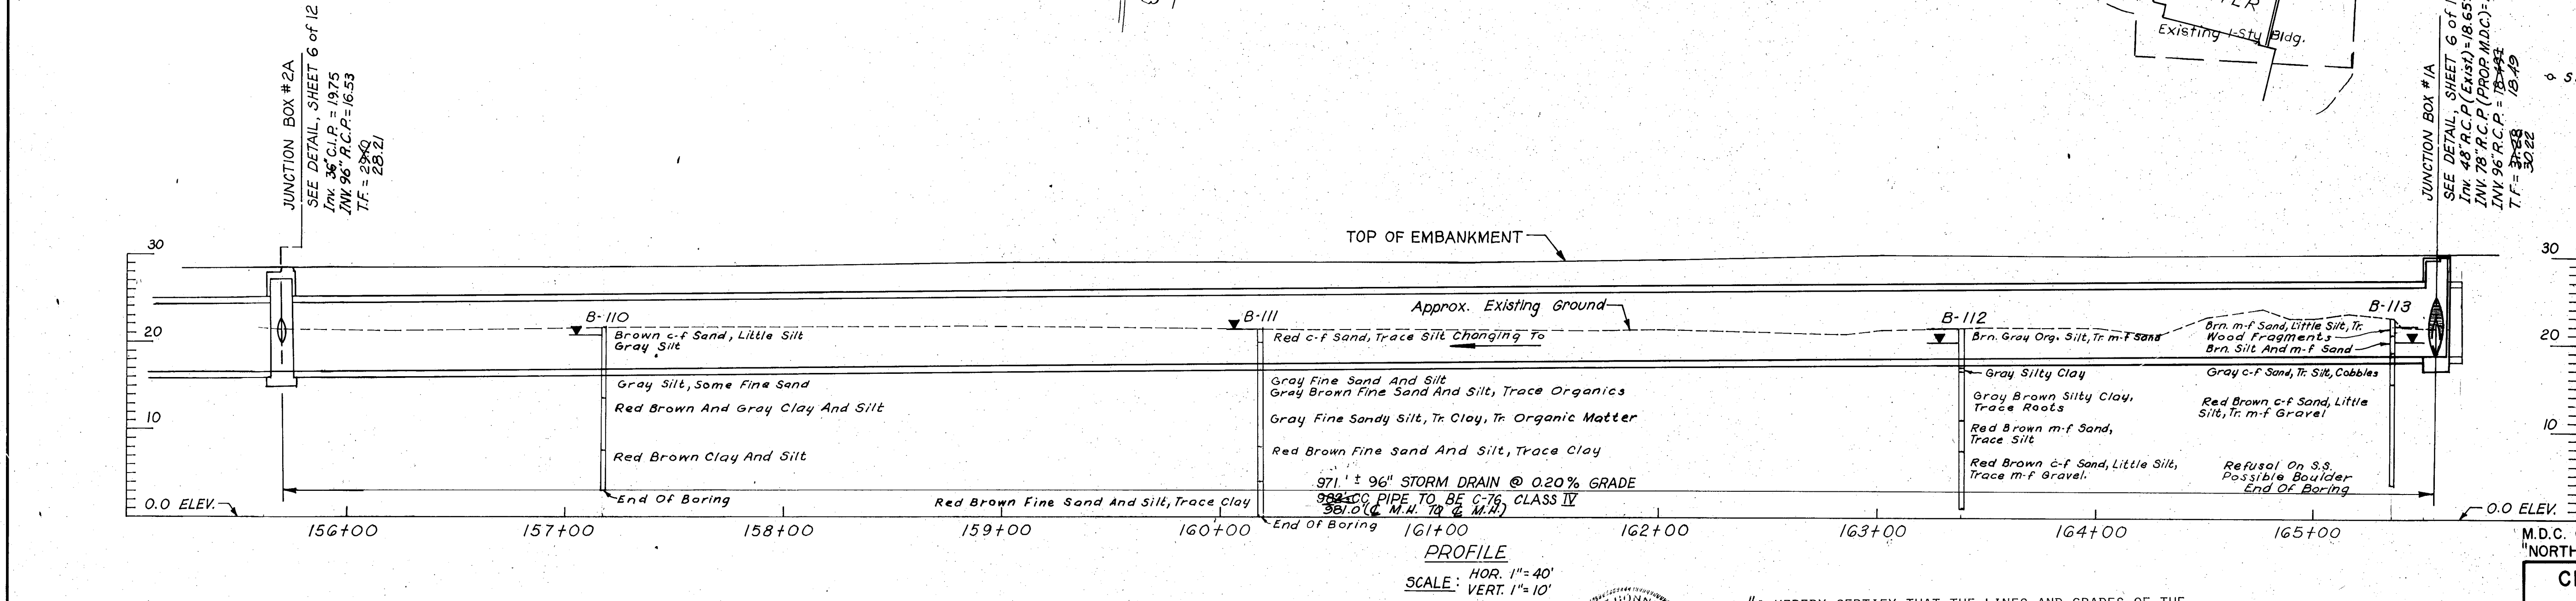
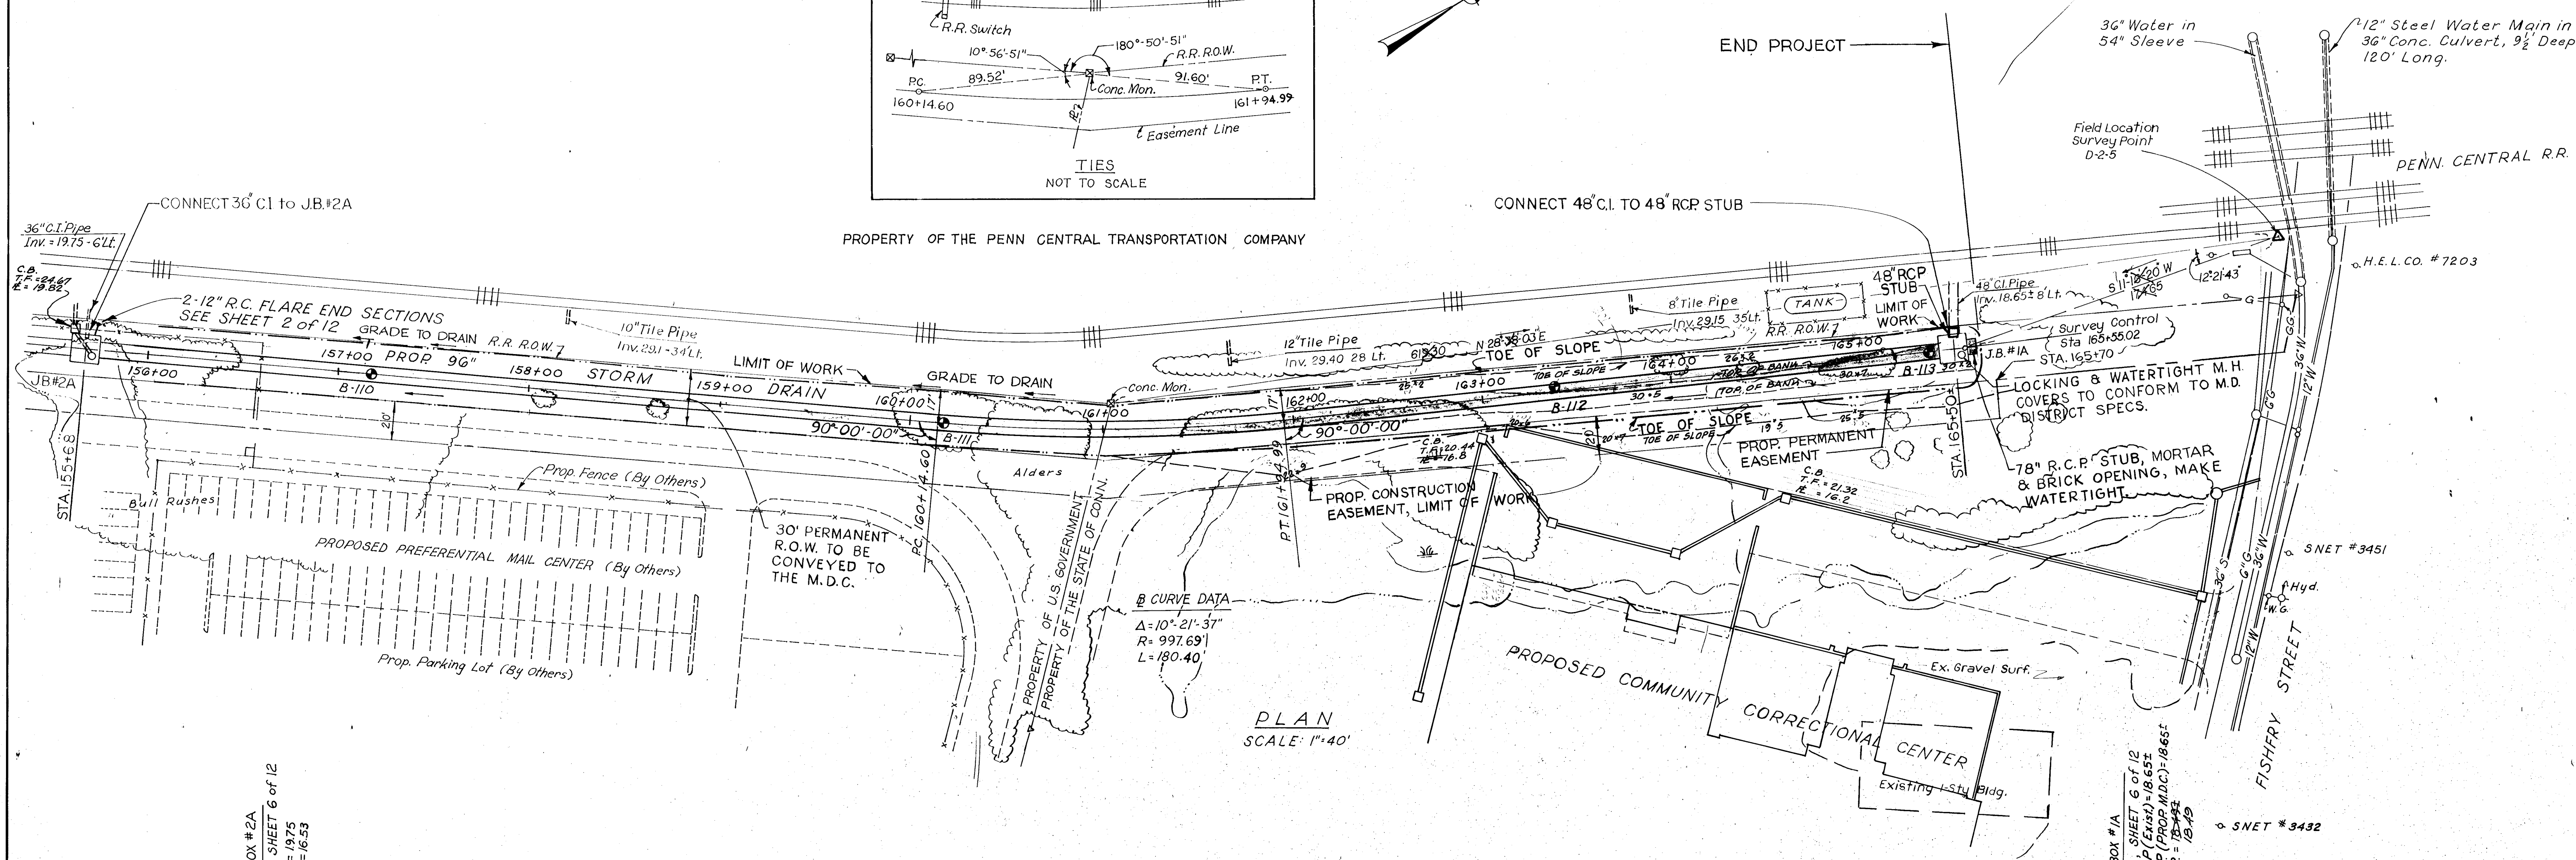
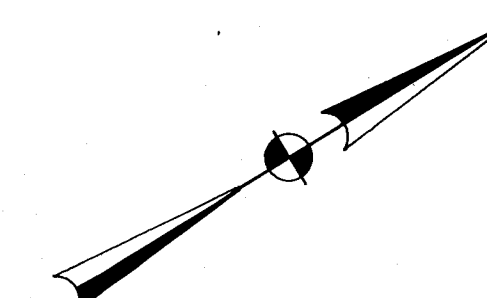


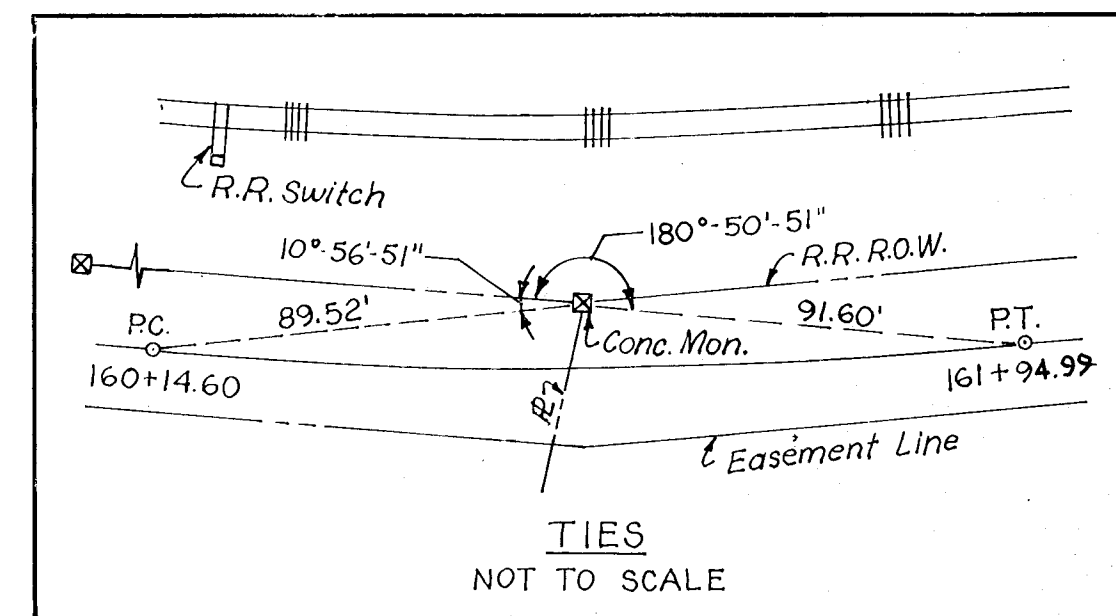


* FILL REQUIRED OVER 36" PIPE BETWEEN STATION 161+00 AND 165+50. NOT PLACED CORRECTLY.

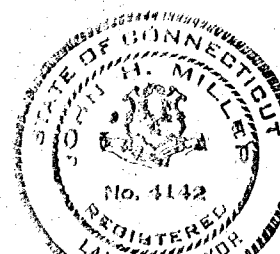

"I HEREBY CERTIFY THAT THE LINES AND GRADES OF THE COMPLETED WORK FOR CONTRACT NO. E/4-24 OF THE STORM DRAINAGE FACILITY ALONG THE PENN CENTRAL RAILROAD, NORTH MEADOWS PROJECT, ARE IN SUBSTANTIAL CONFORMANCE WITH THE REQUIREMENTS OF THE CONSTRUCTION PLANS, EXCEPT AS NOTED."

JOHN H. MILLER, L.S.

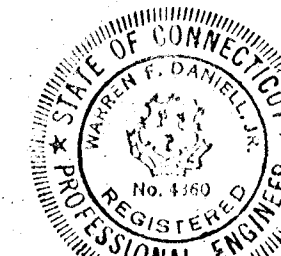

ANDERSON-NICHOLS & CO., INC.
VERNON BOSTON CONCORD

SHEET 4 OF 12 SHEETS		
M.D.C. CODE: 7-14-75 "NORTH MEADOWS REDEVELOPMENT"		
CITY OF HARTFORD, CONNECTICUT DEPARTMENT OF PUBLIC WORKS BUREAU OF ENGINEERING SERVICES		
STORM DRAINAGE FACILITY ALONG RAILROAD NORTH MEADOWS PROJECT		
SUBMITTED	RECOMMENDED	APPROVED
DIVISION ENGINEER	CHIEF OF ENG. SERV.	ACTING DIR. CITY ENG.
DRAWN JED/GR	SCALE AS SHOWN	DAYBOOK NO. 10486E
CHECKED A.A.J.		DATE: FEB. 1974