
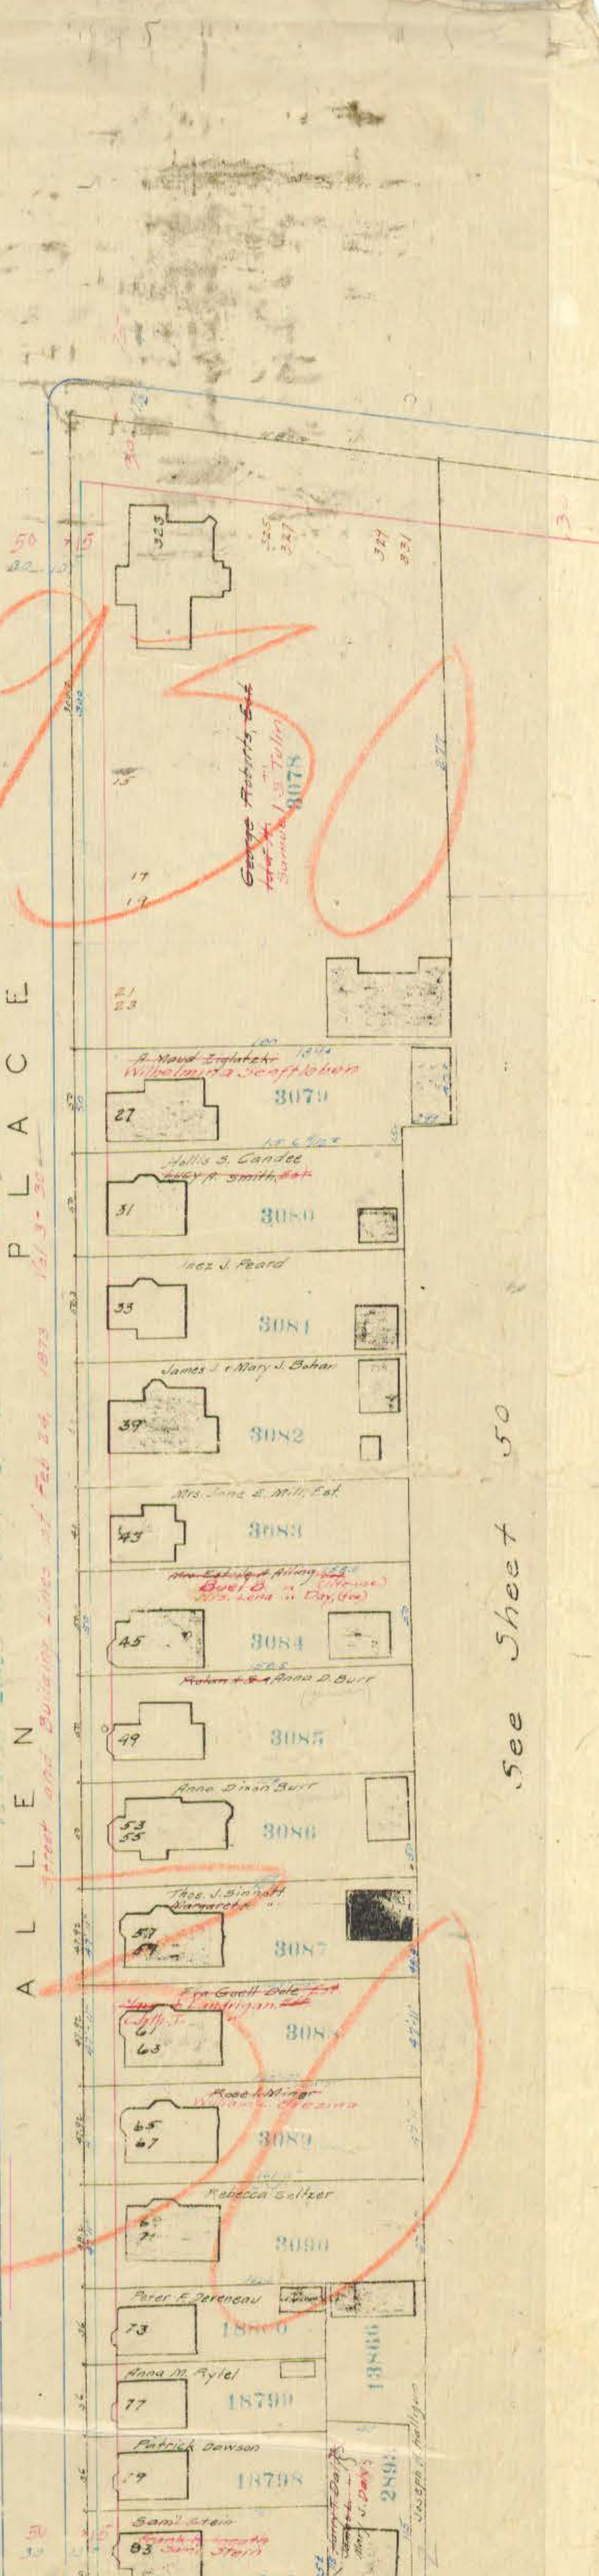
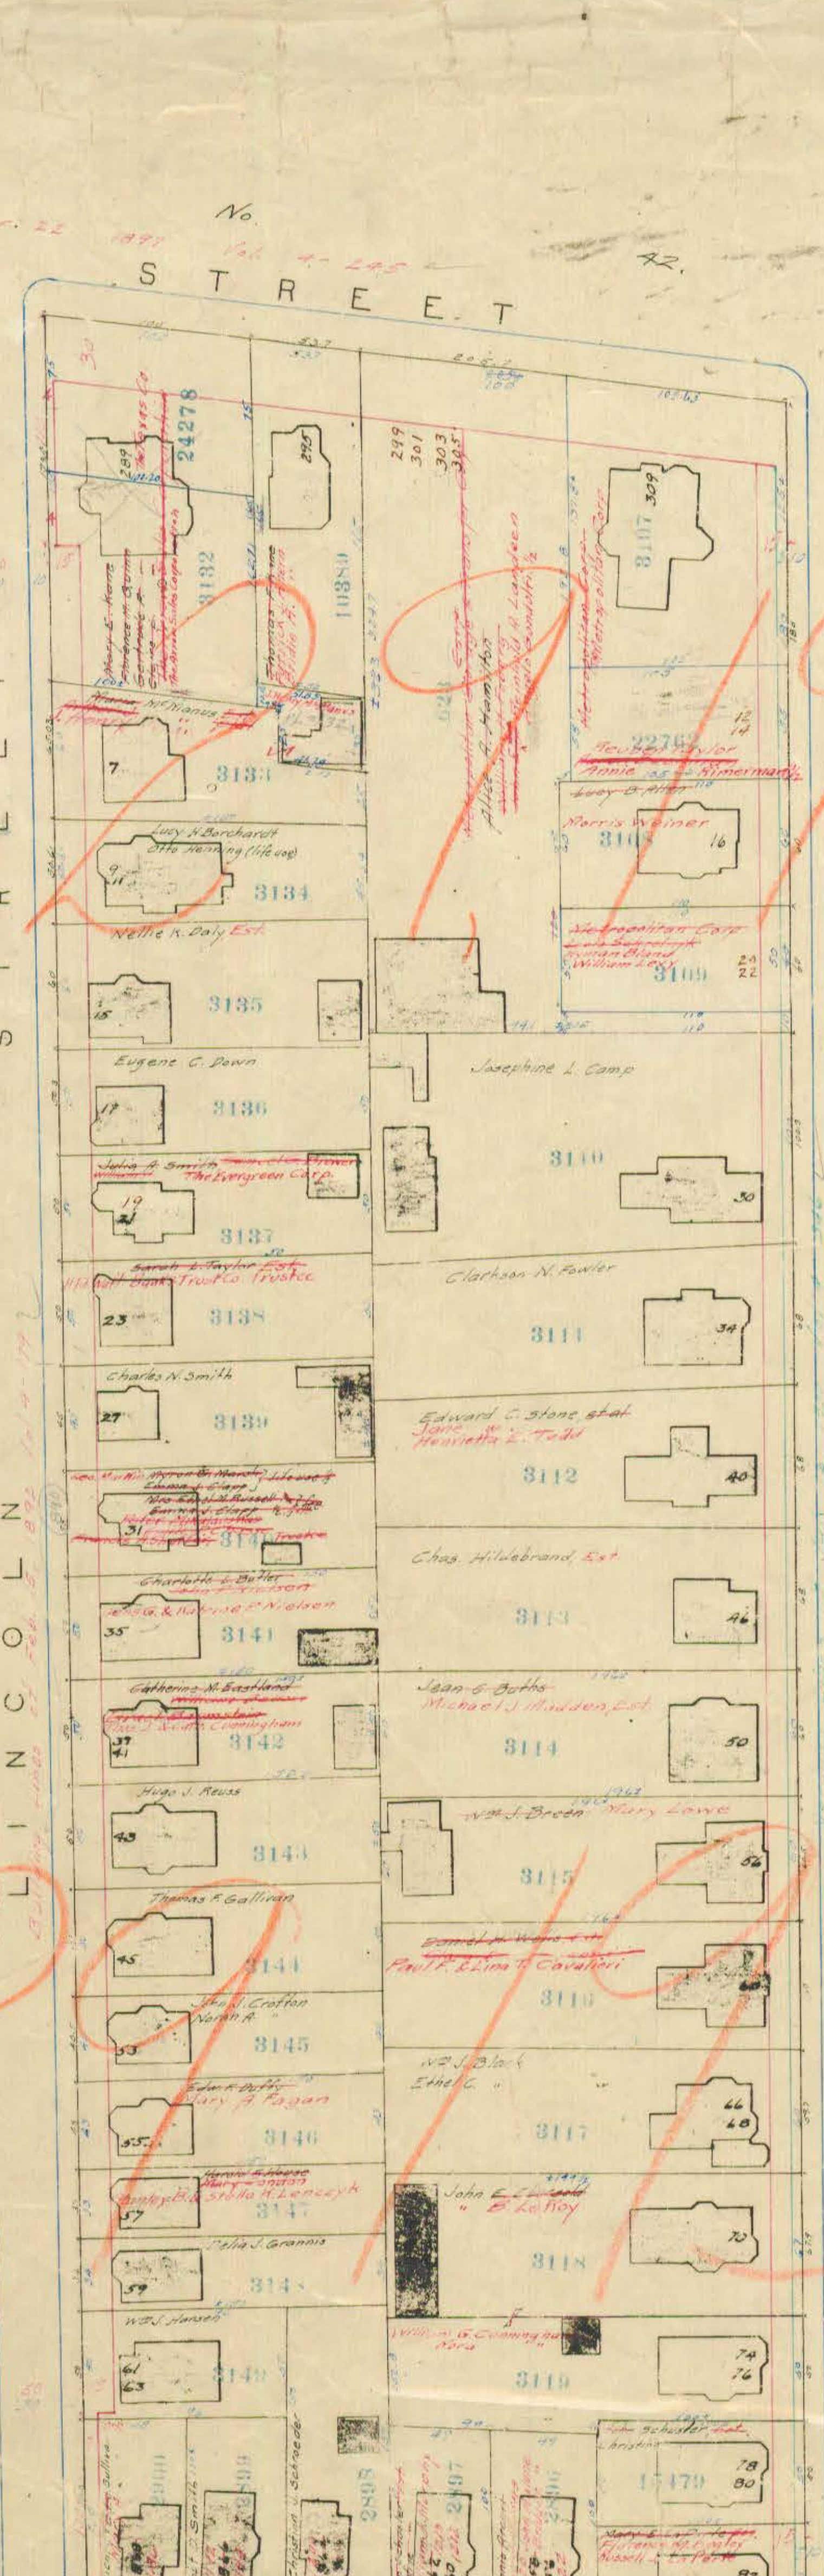
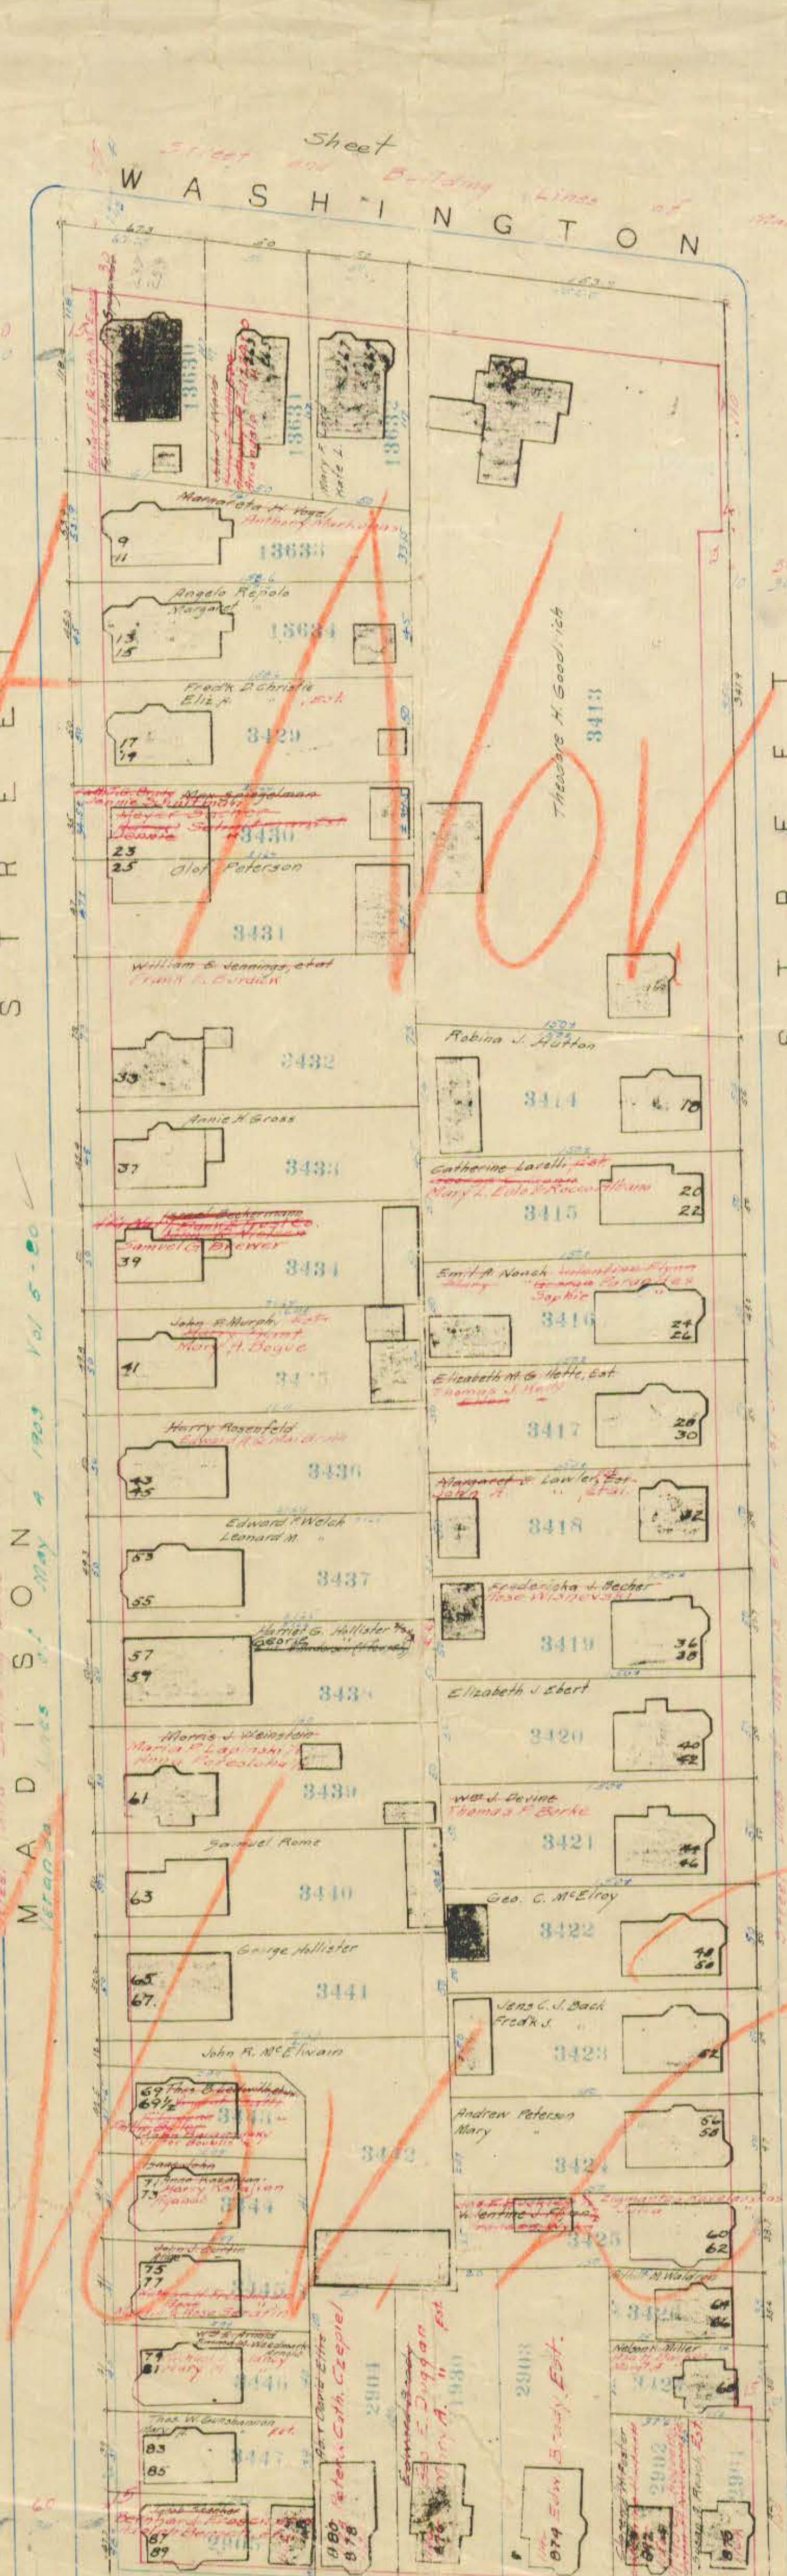
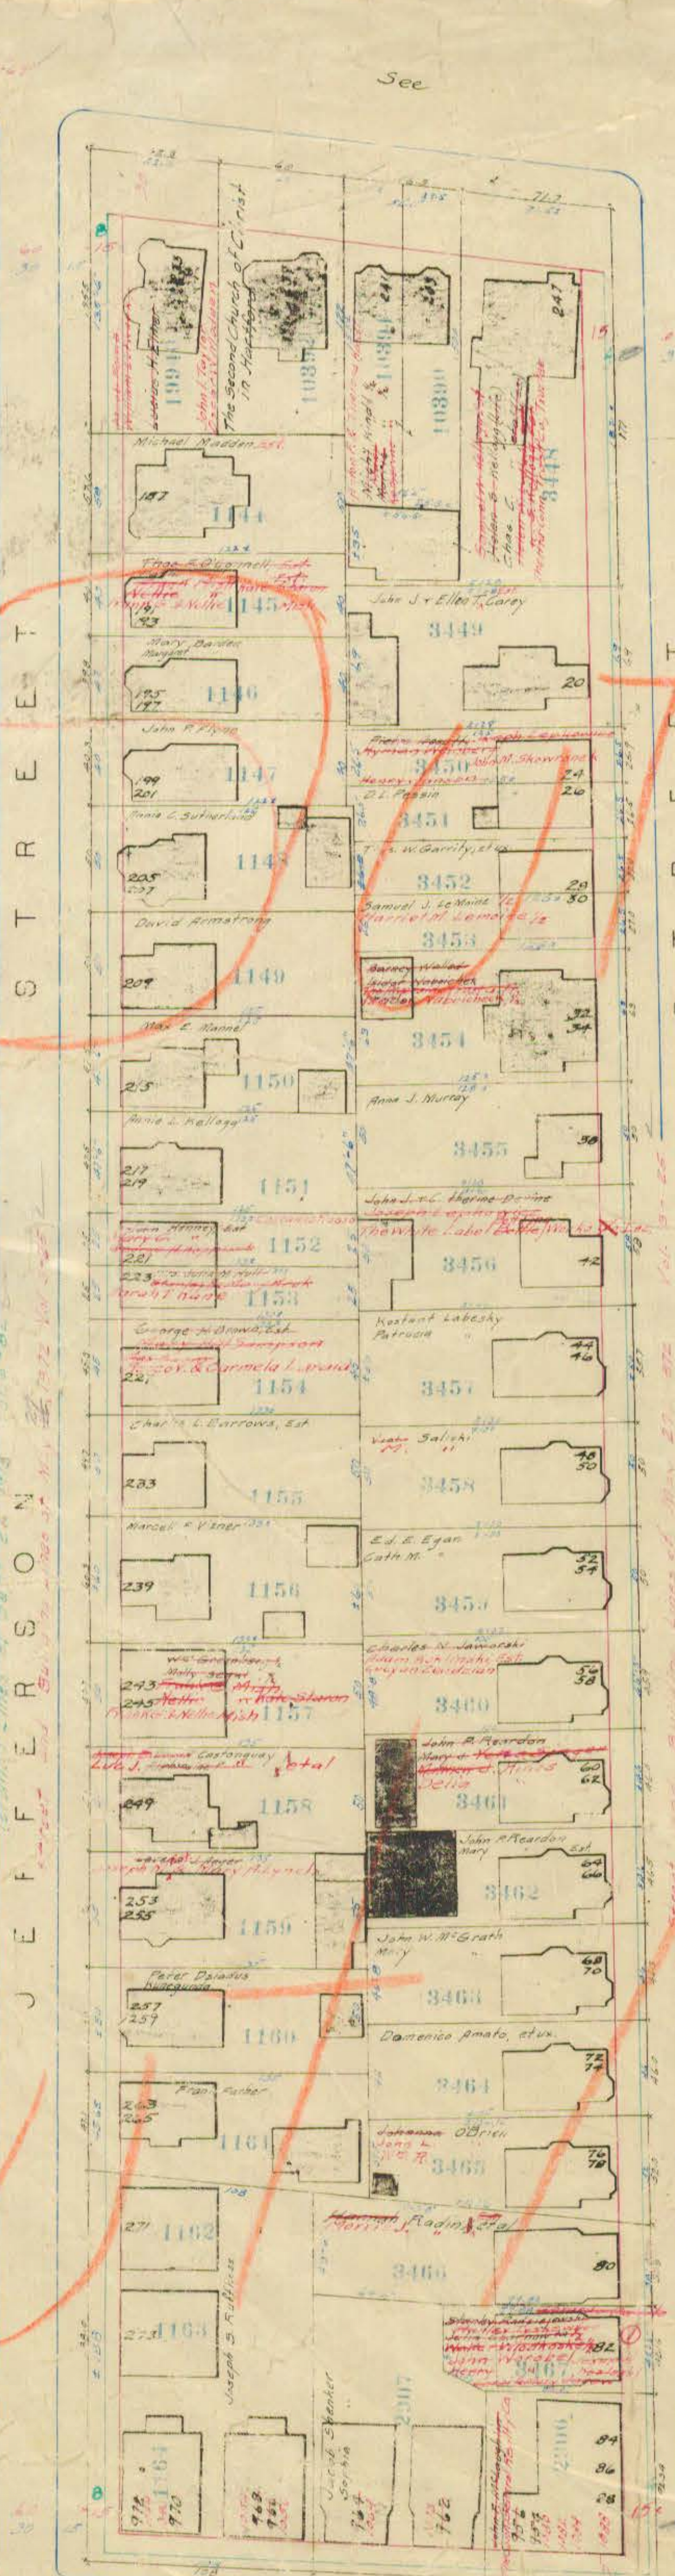


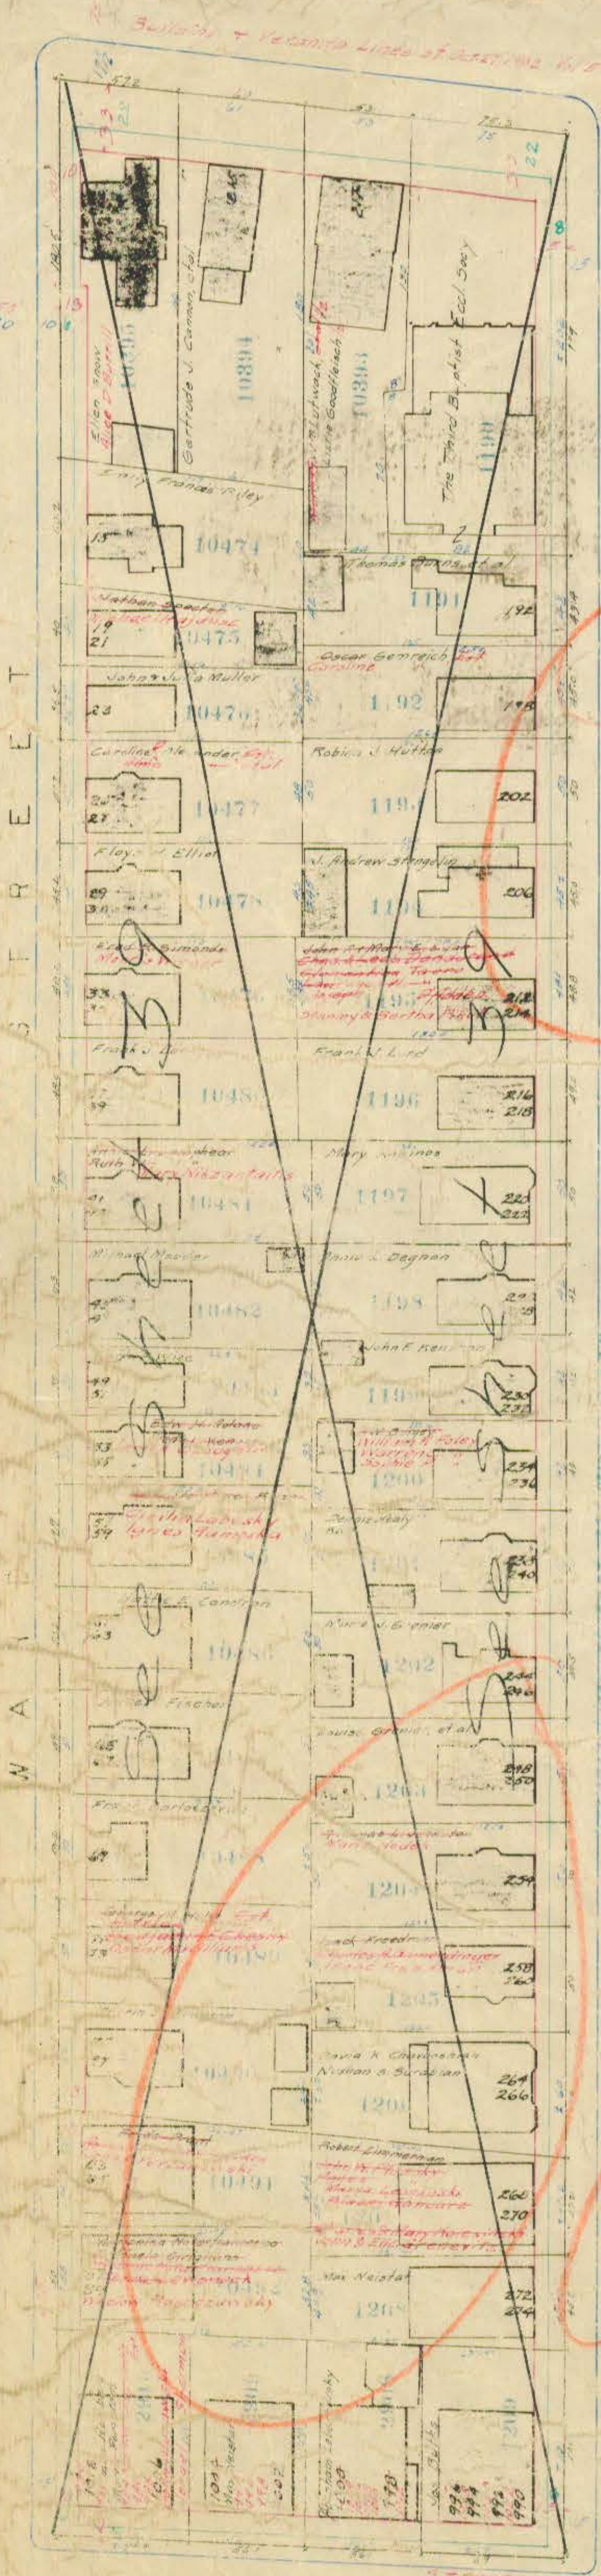

See Sheet 50