


out of service Dec. 3, 1969

City of Hartford
(Cemetery)
10495

The Jewish Cong. Beth Israel

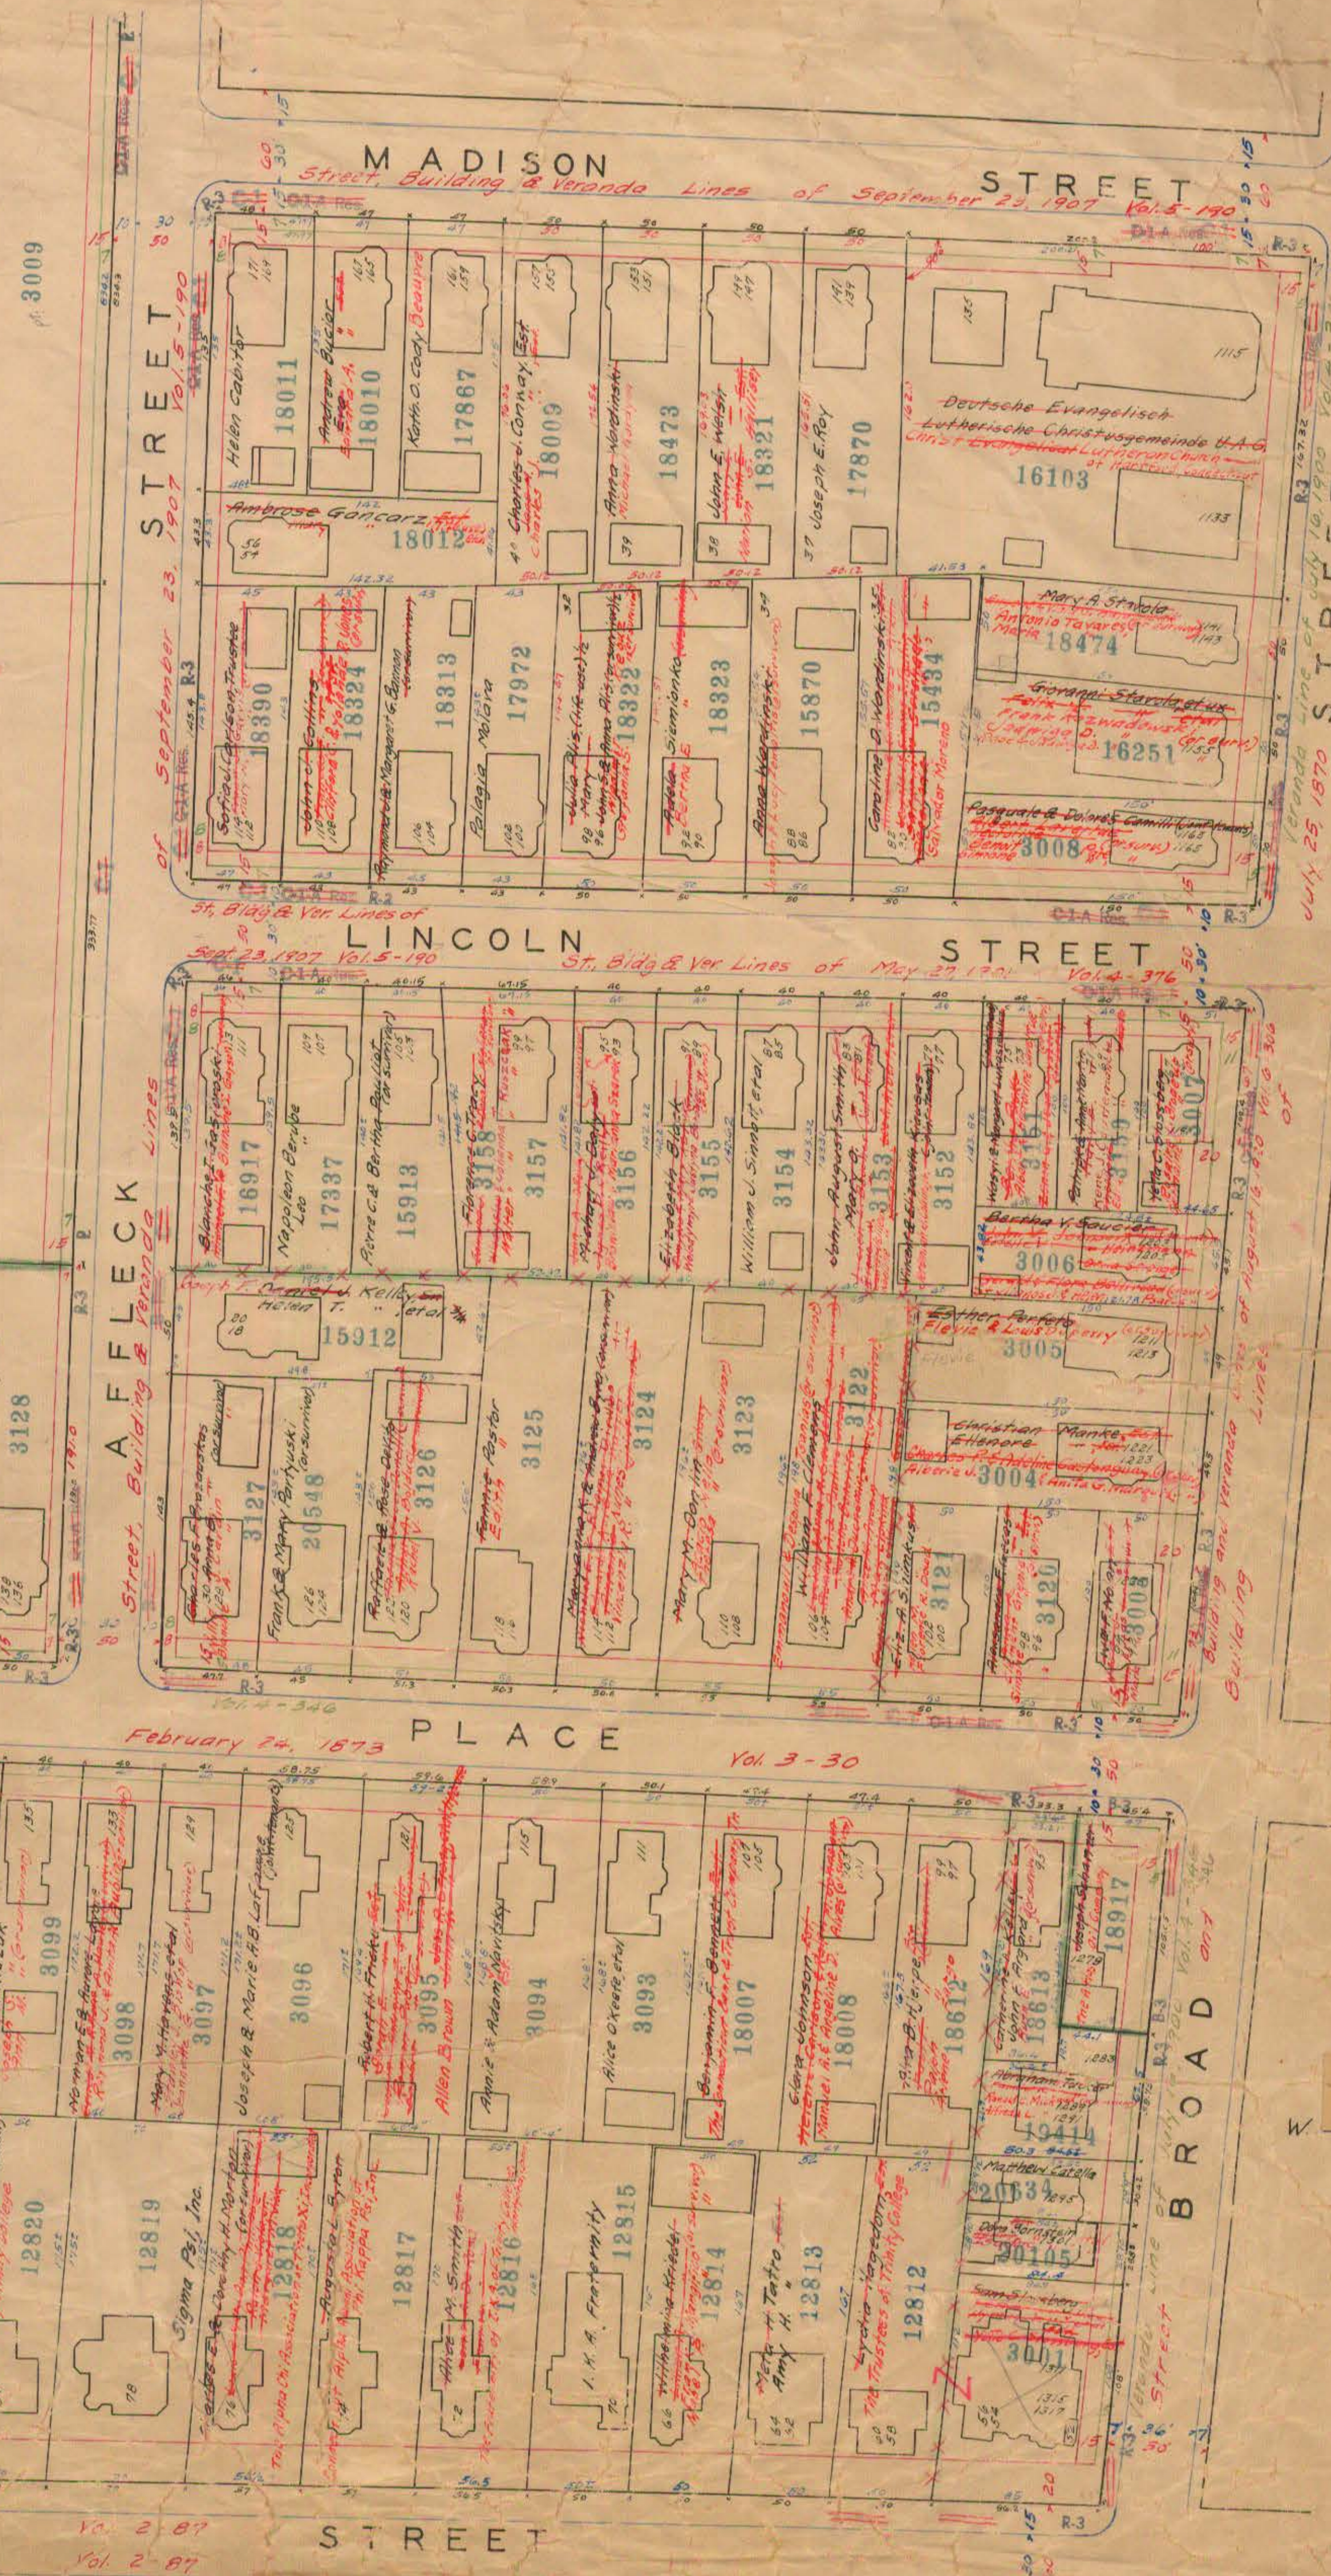

Vol. 5-107

Street

and

Veranda

Summit

Street

Vol. 2-87

Vol. 2-87

Vol. 2-87

See Sheet 51

See Sheet 51

City of Hartford
Department of Engineering
May 1930