


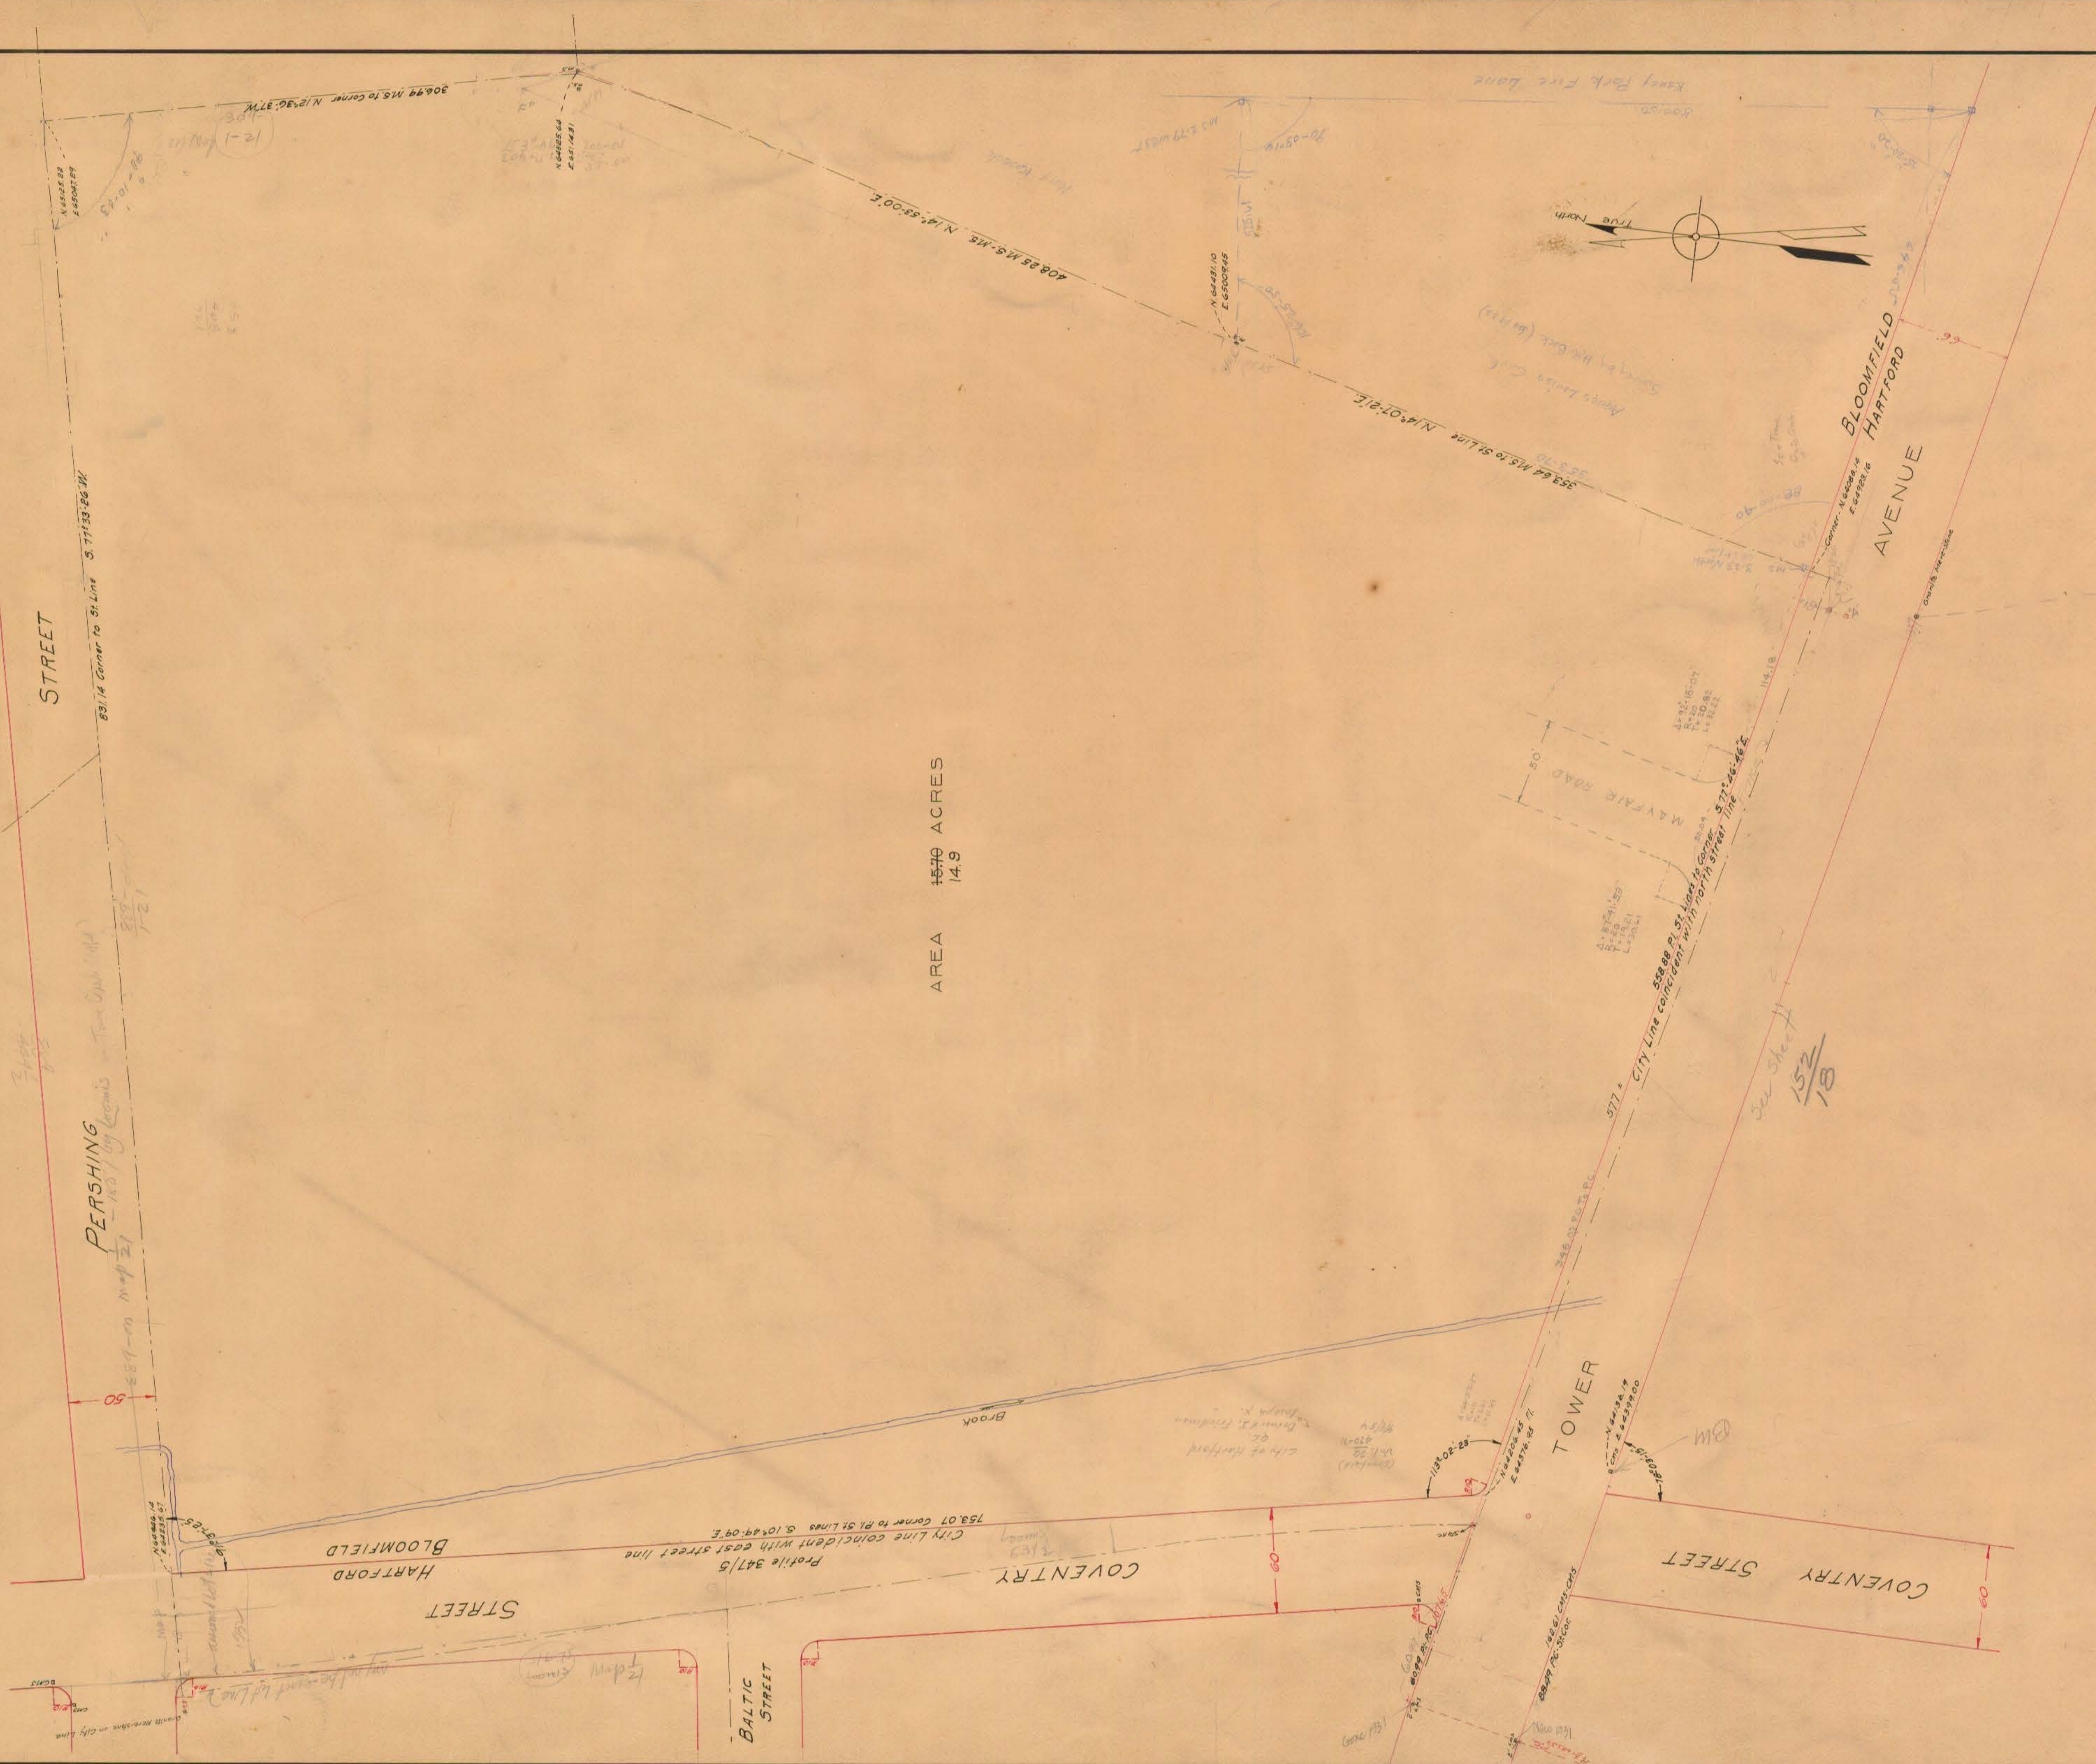

AREA 1570 ACRES
149

ALMS HOUSE PROPERTY
SECTION NORTH OF TOWER AVENUE
FEB 1911

SCALE 1"=40'