

YORK STREET

See Sheet


130

See Sheet

STREET


PARK STREET

PARK STREET

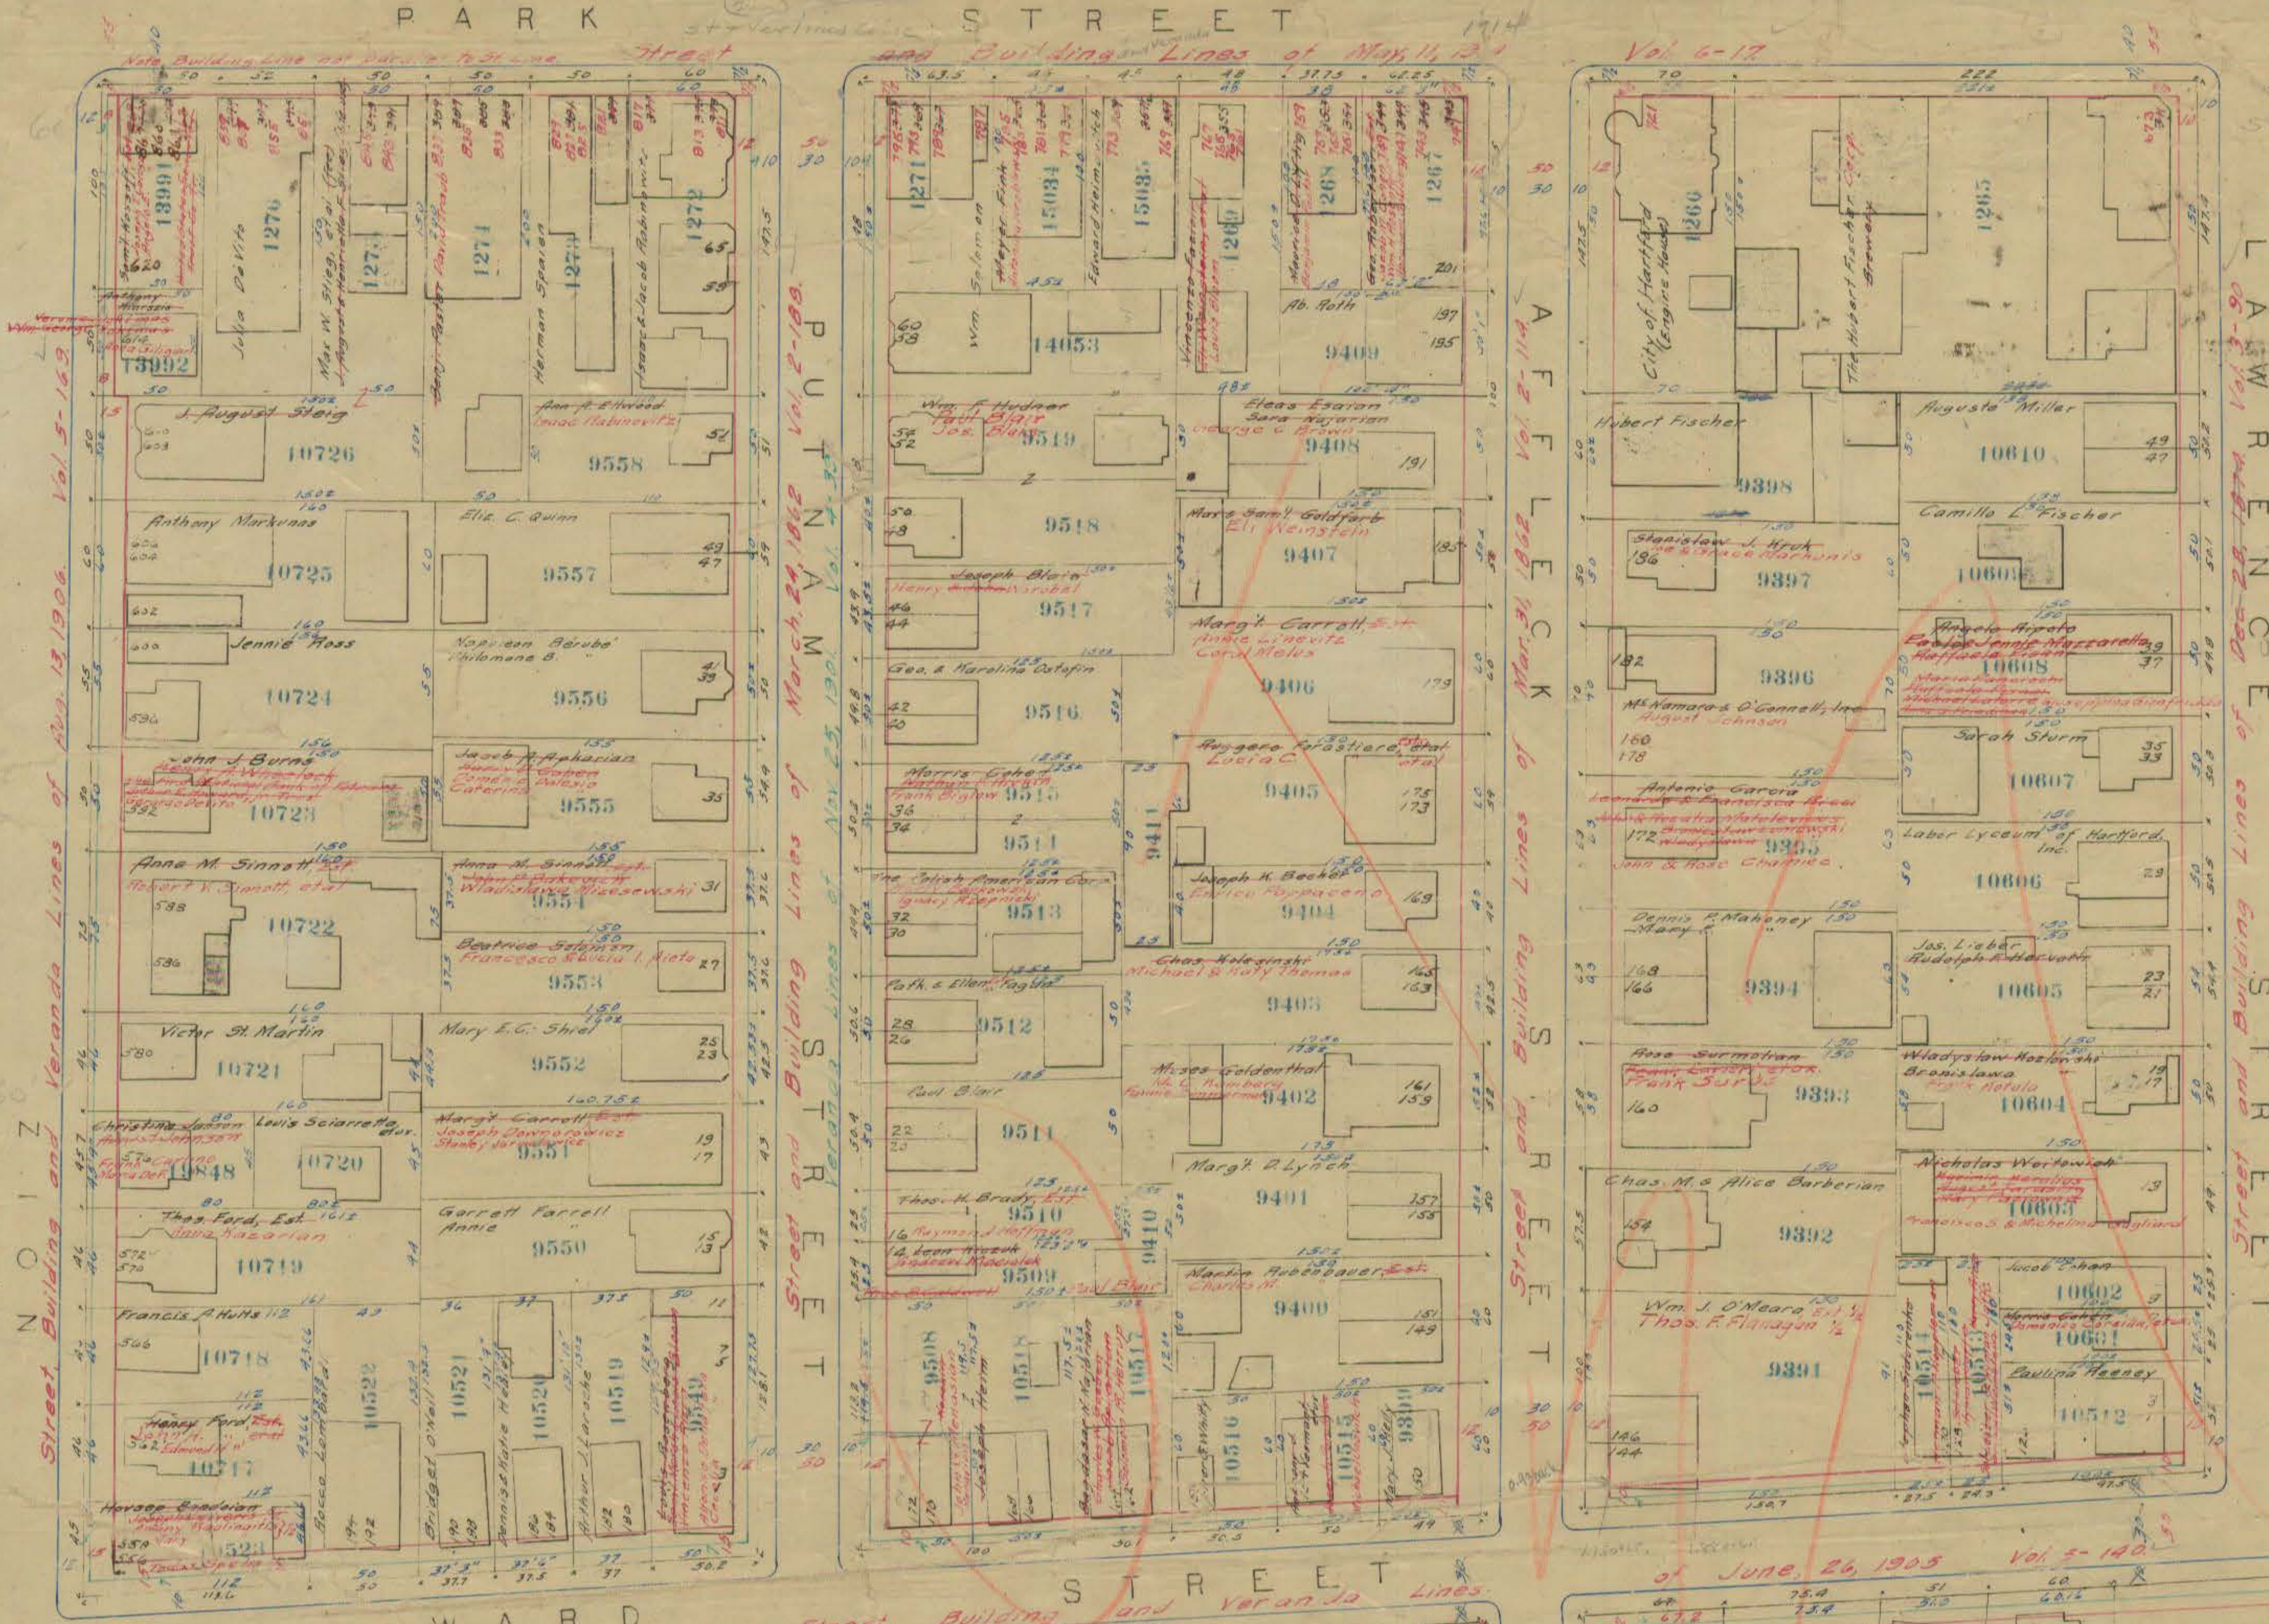


WARD

Street, Building and Veranda Lines

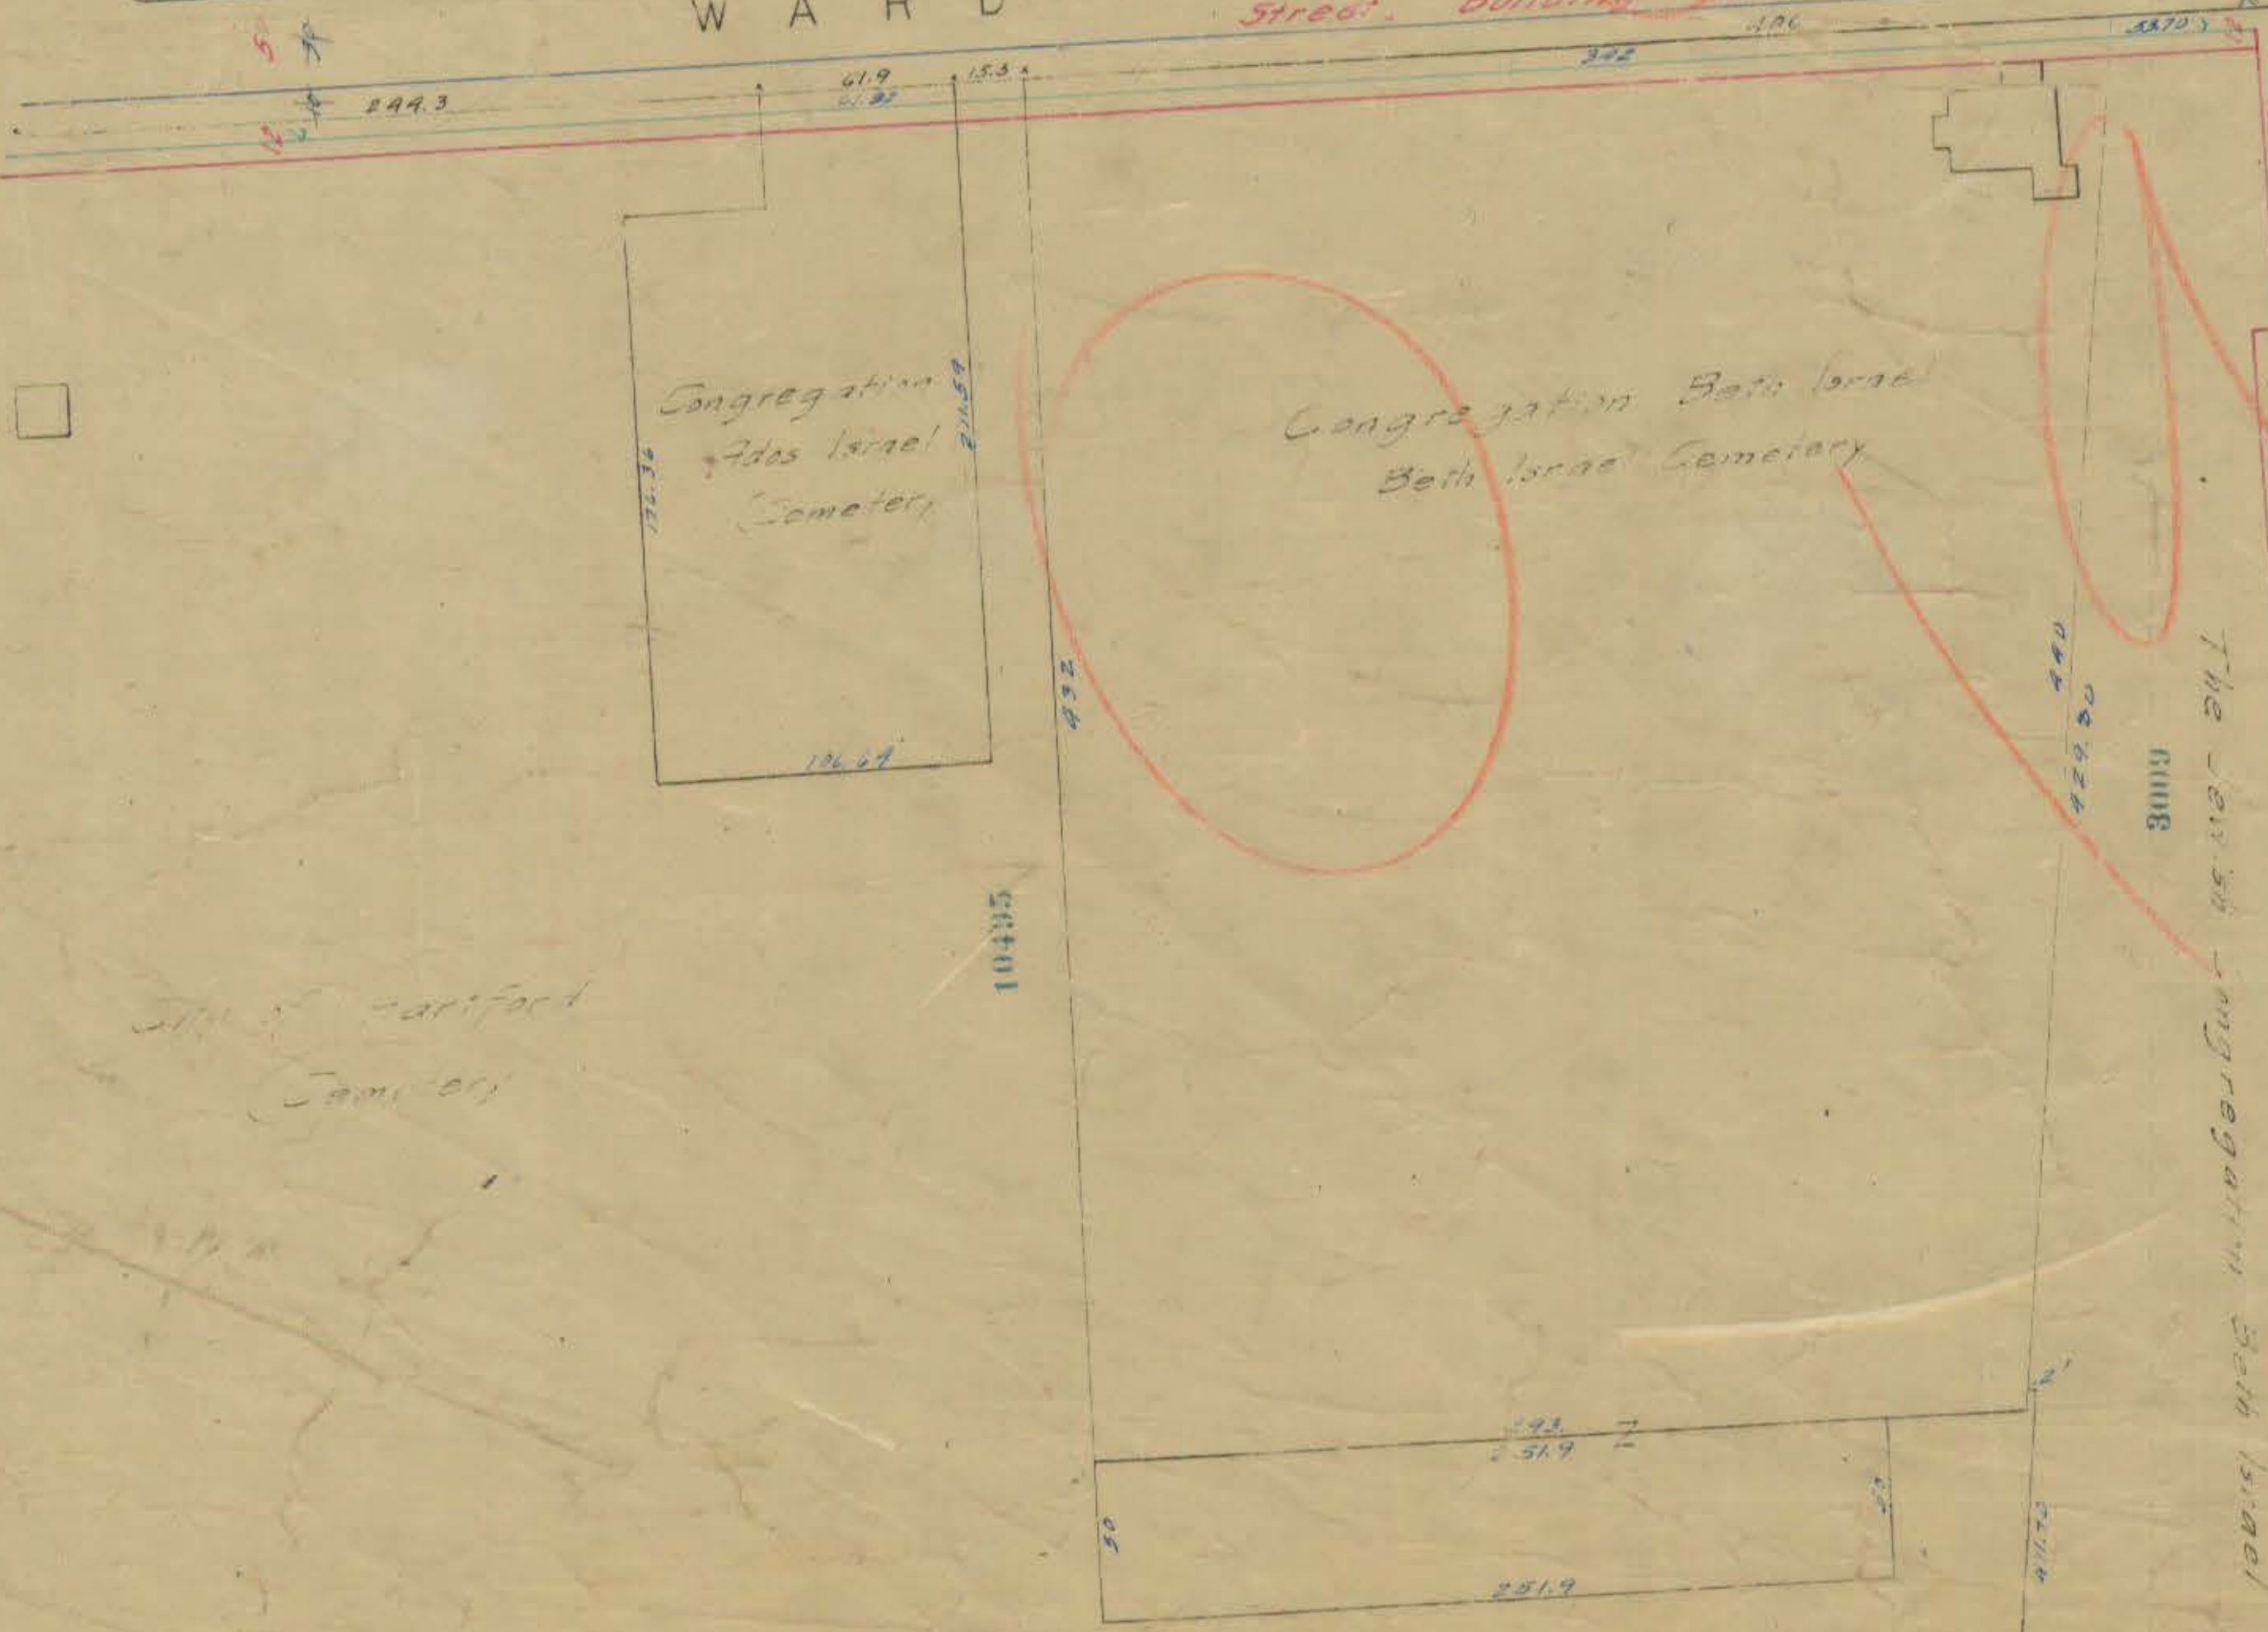

See Sheet 52

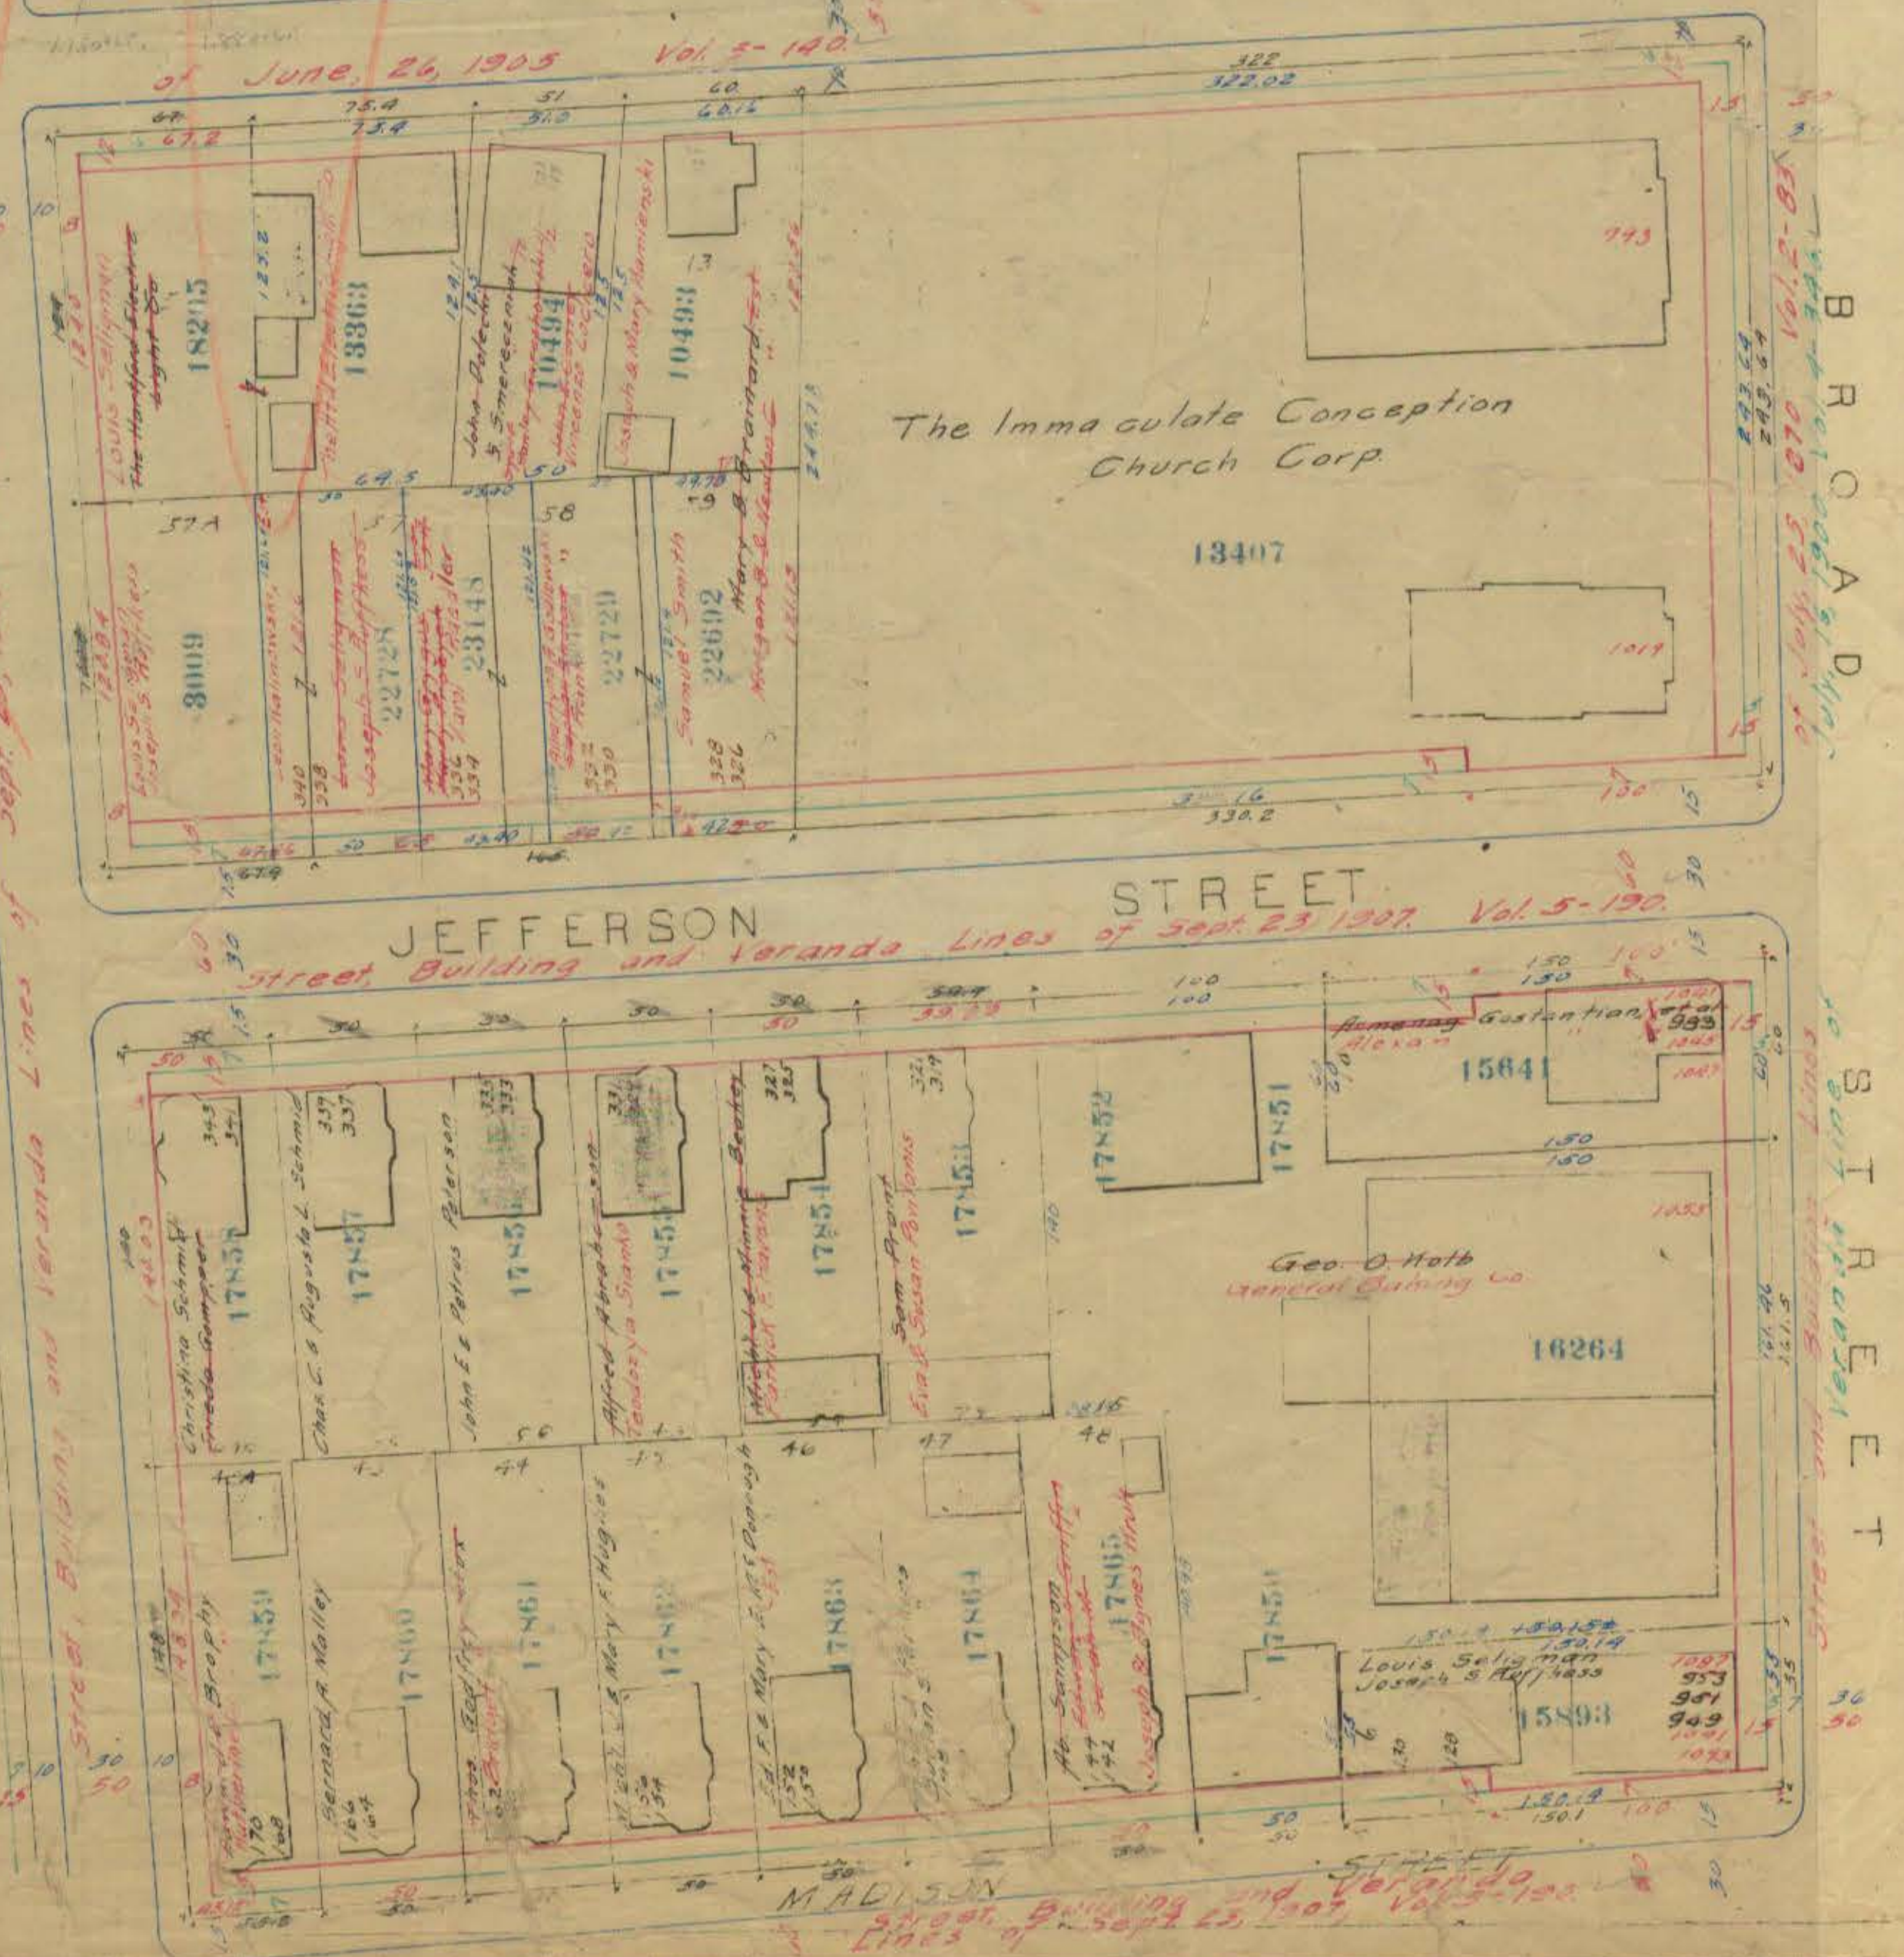

53