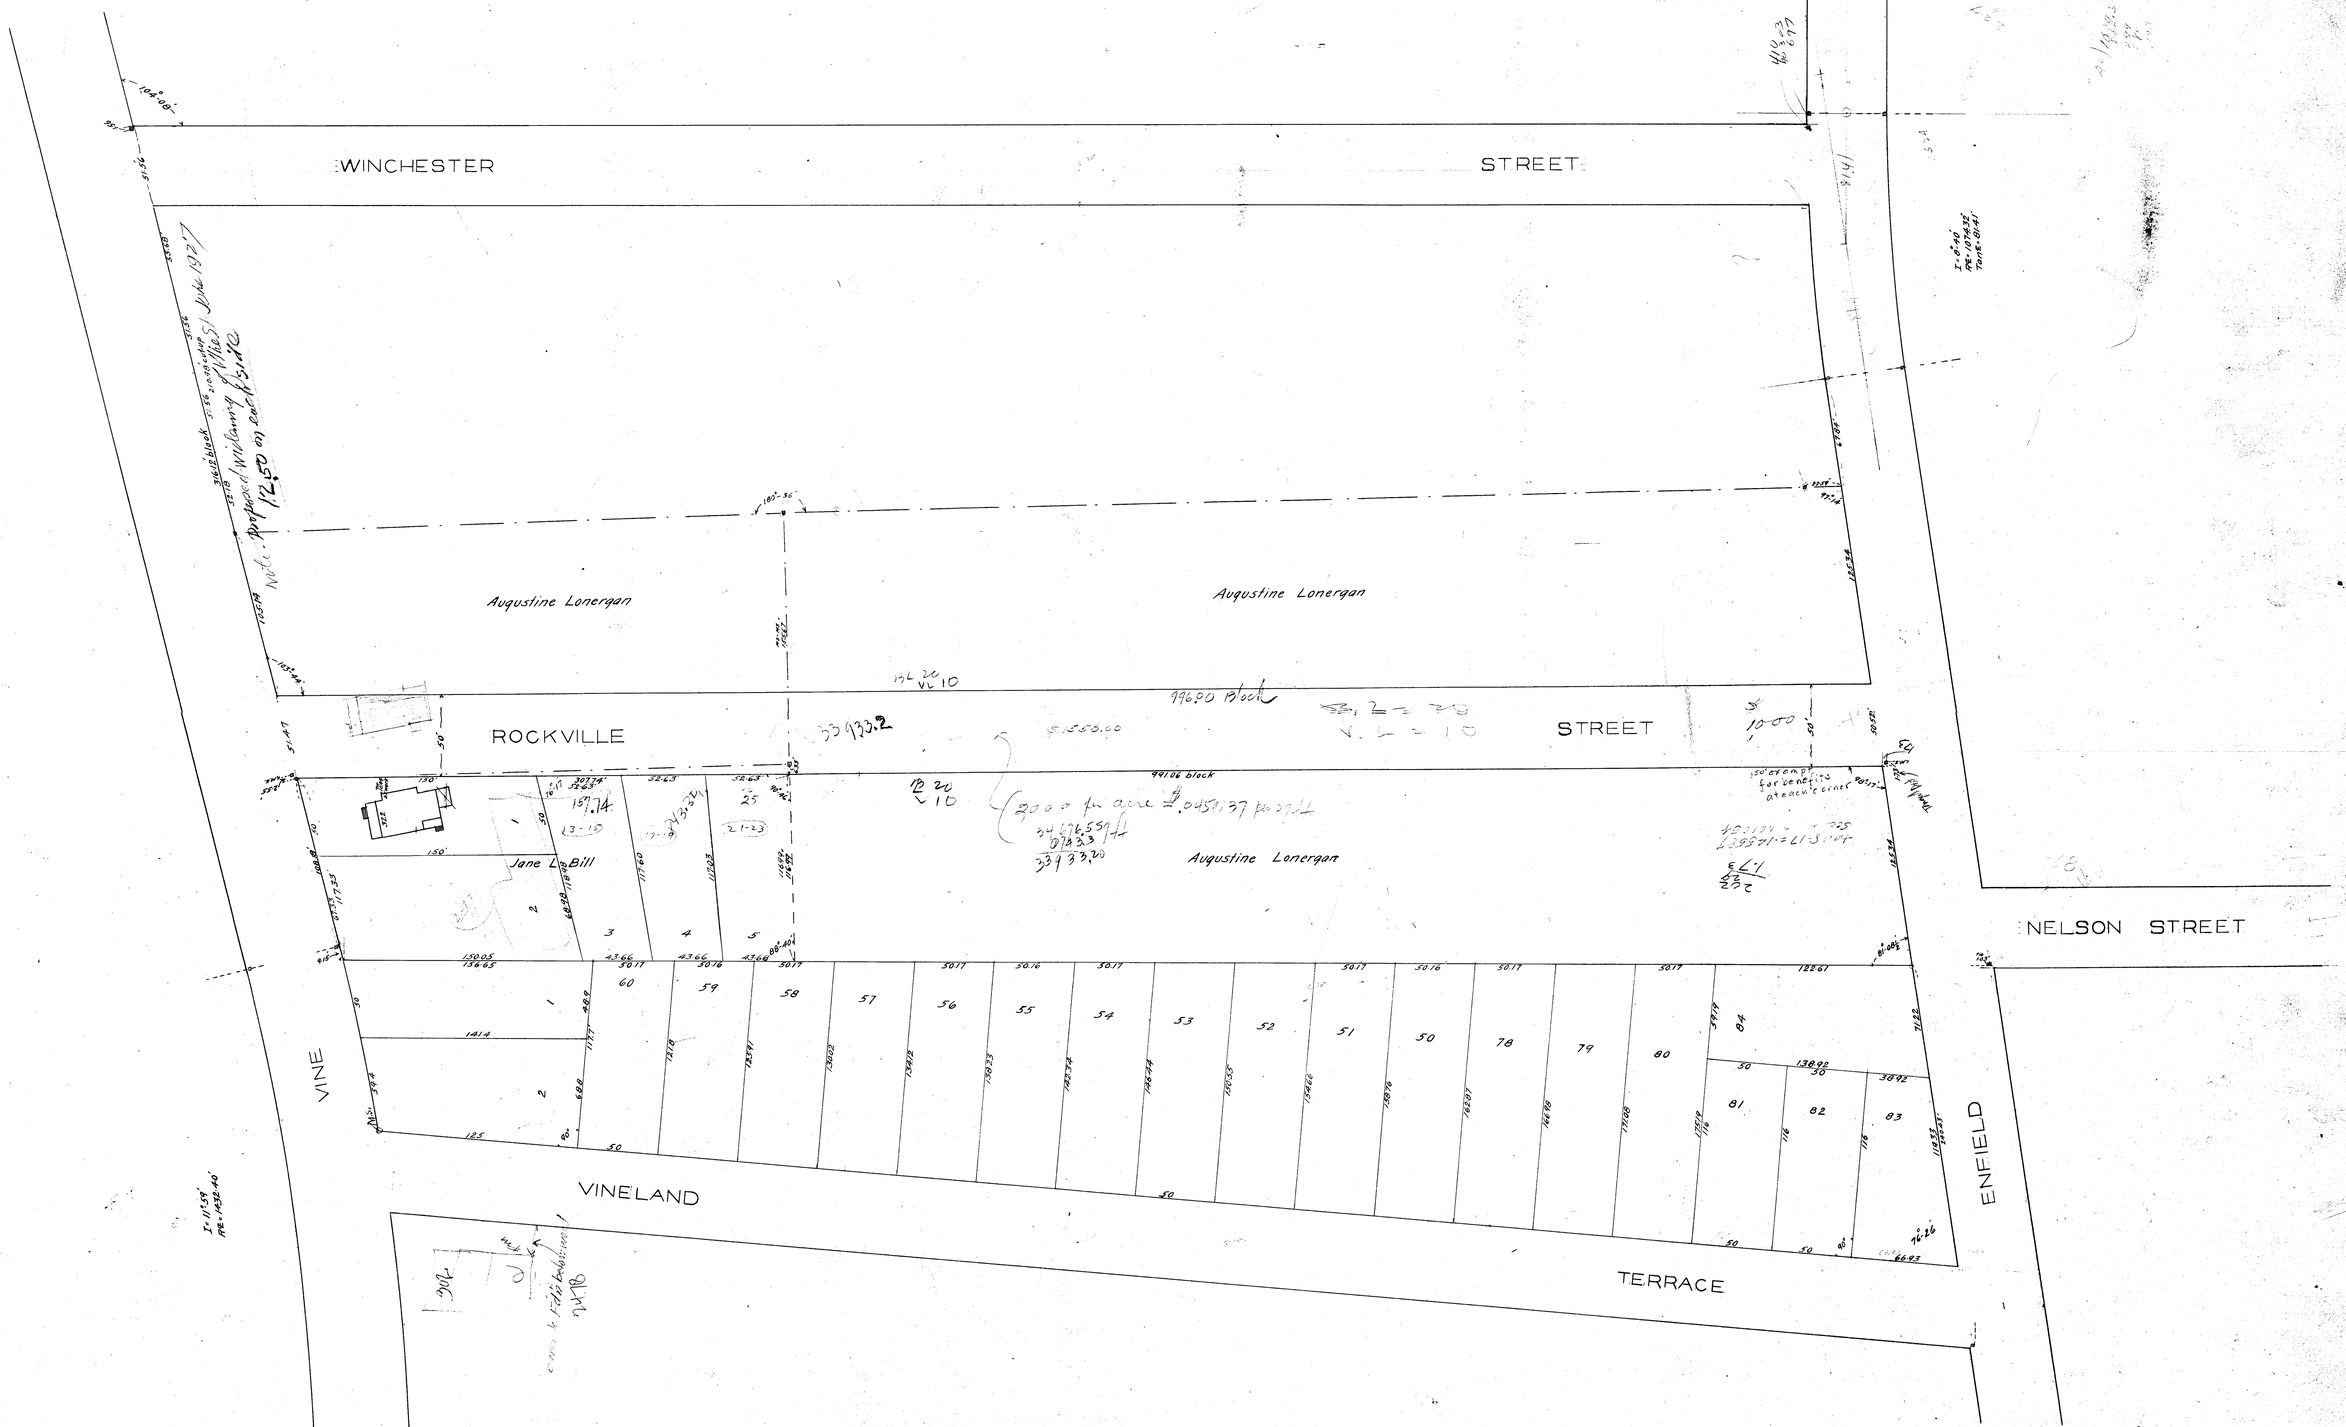

OFFICE OF CITY ENGINEER
HARTFORD, CONN.
Date June 1925 Day Book No. 05211
Notes 509
R.N. Clark City Engineer
Scale 1" = 40'