


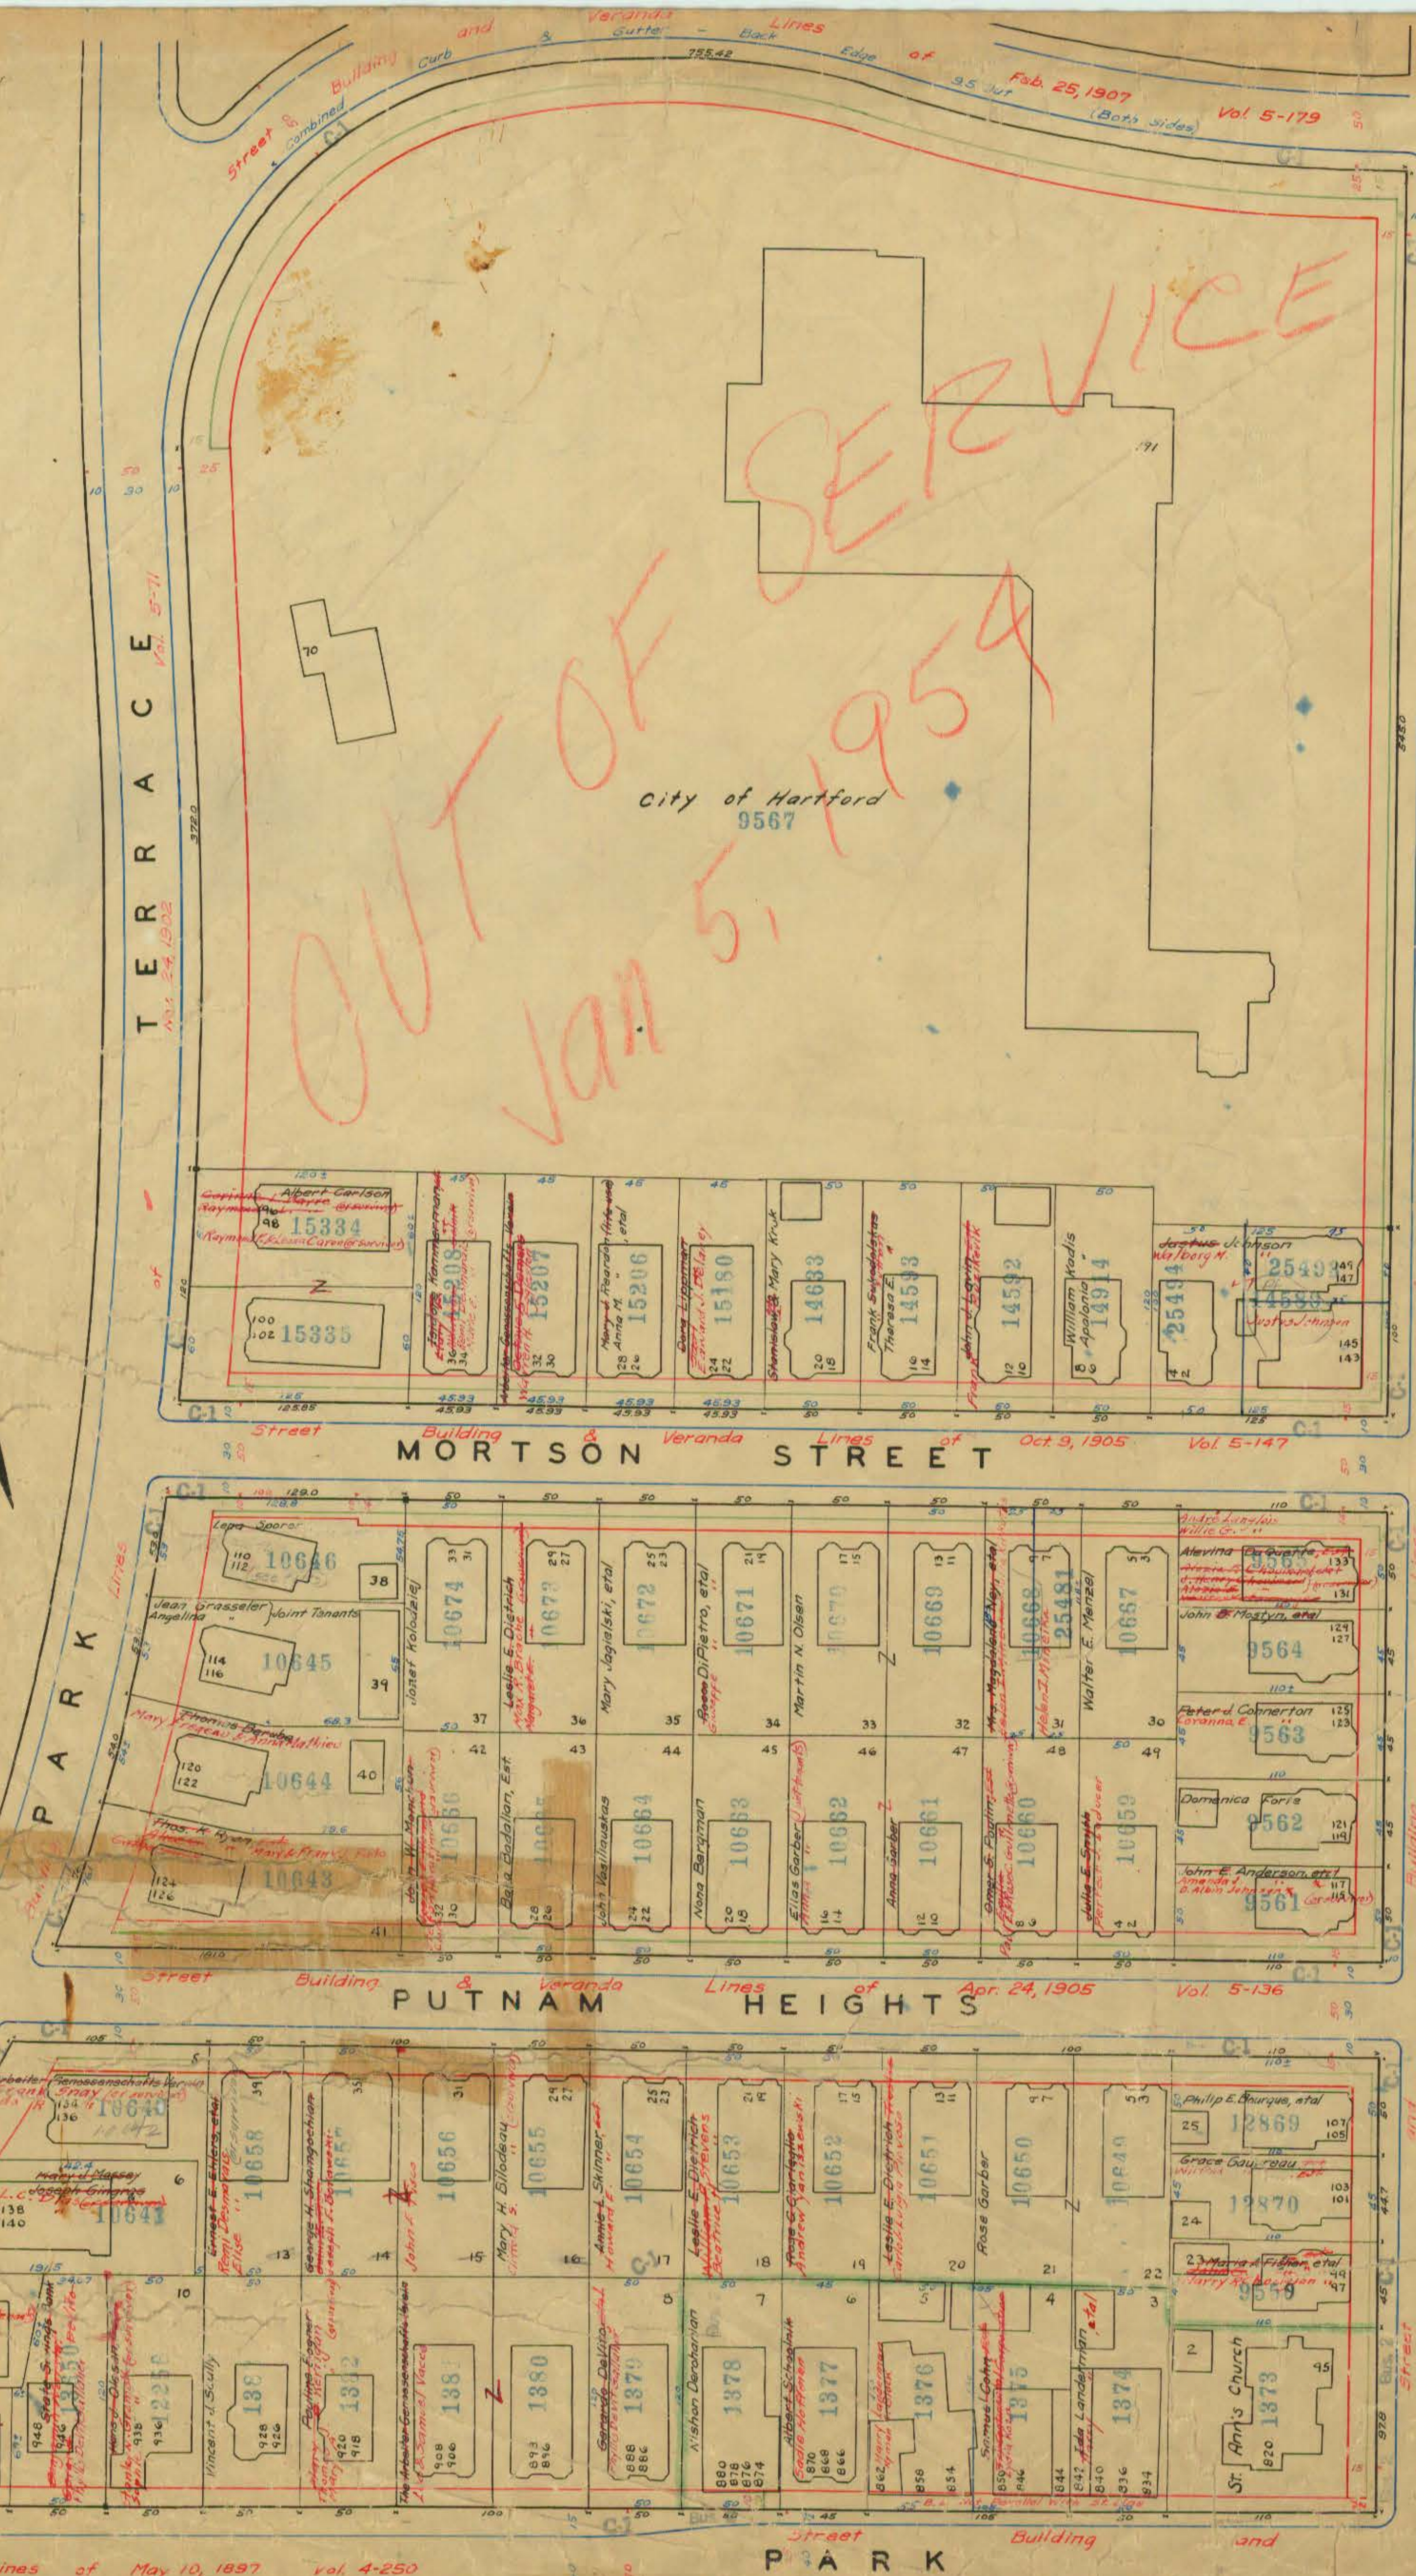

See Sheet 36

