


The Capital City Lumber Co.

PARK RIVER

PARK RIVER

#1 File 3299

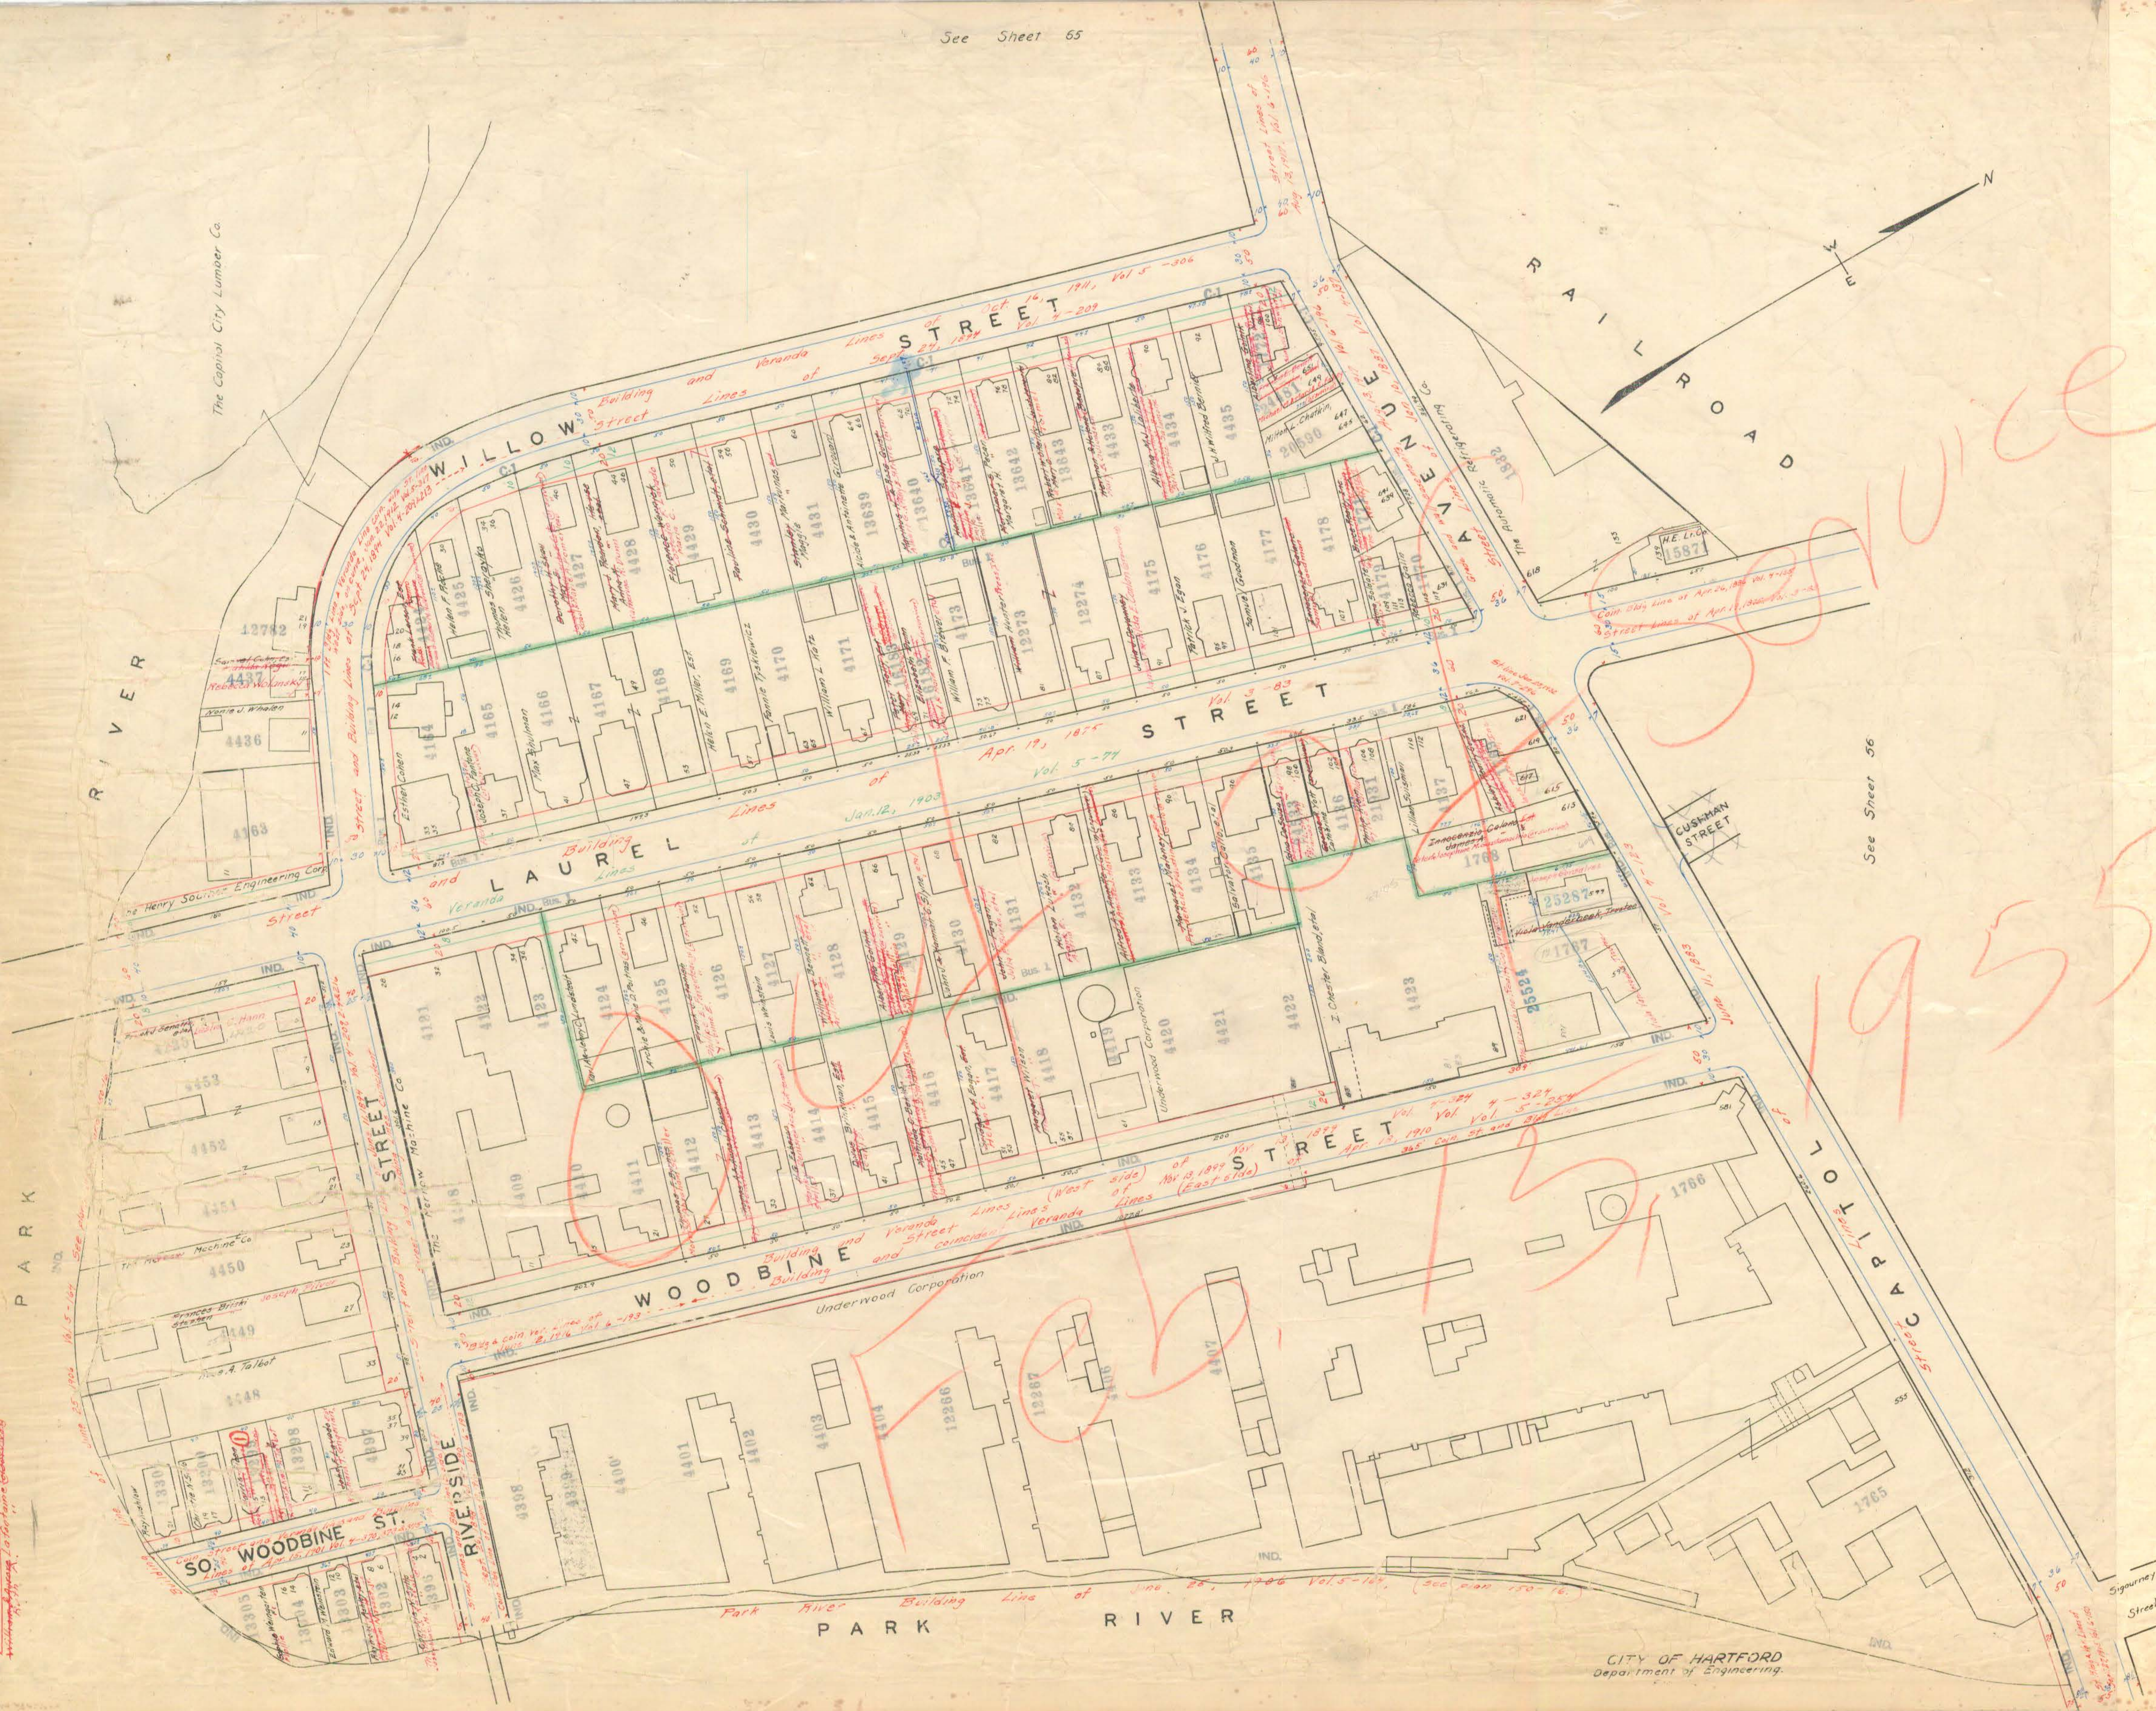

See Sheet 56