


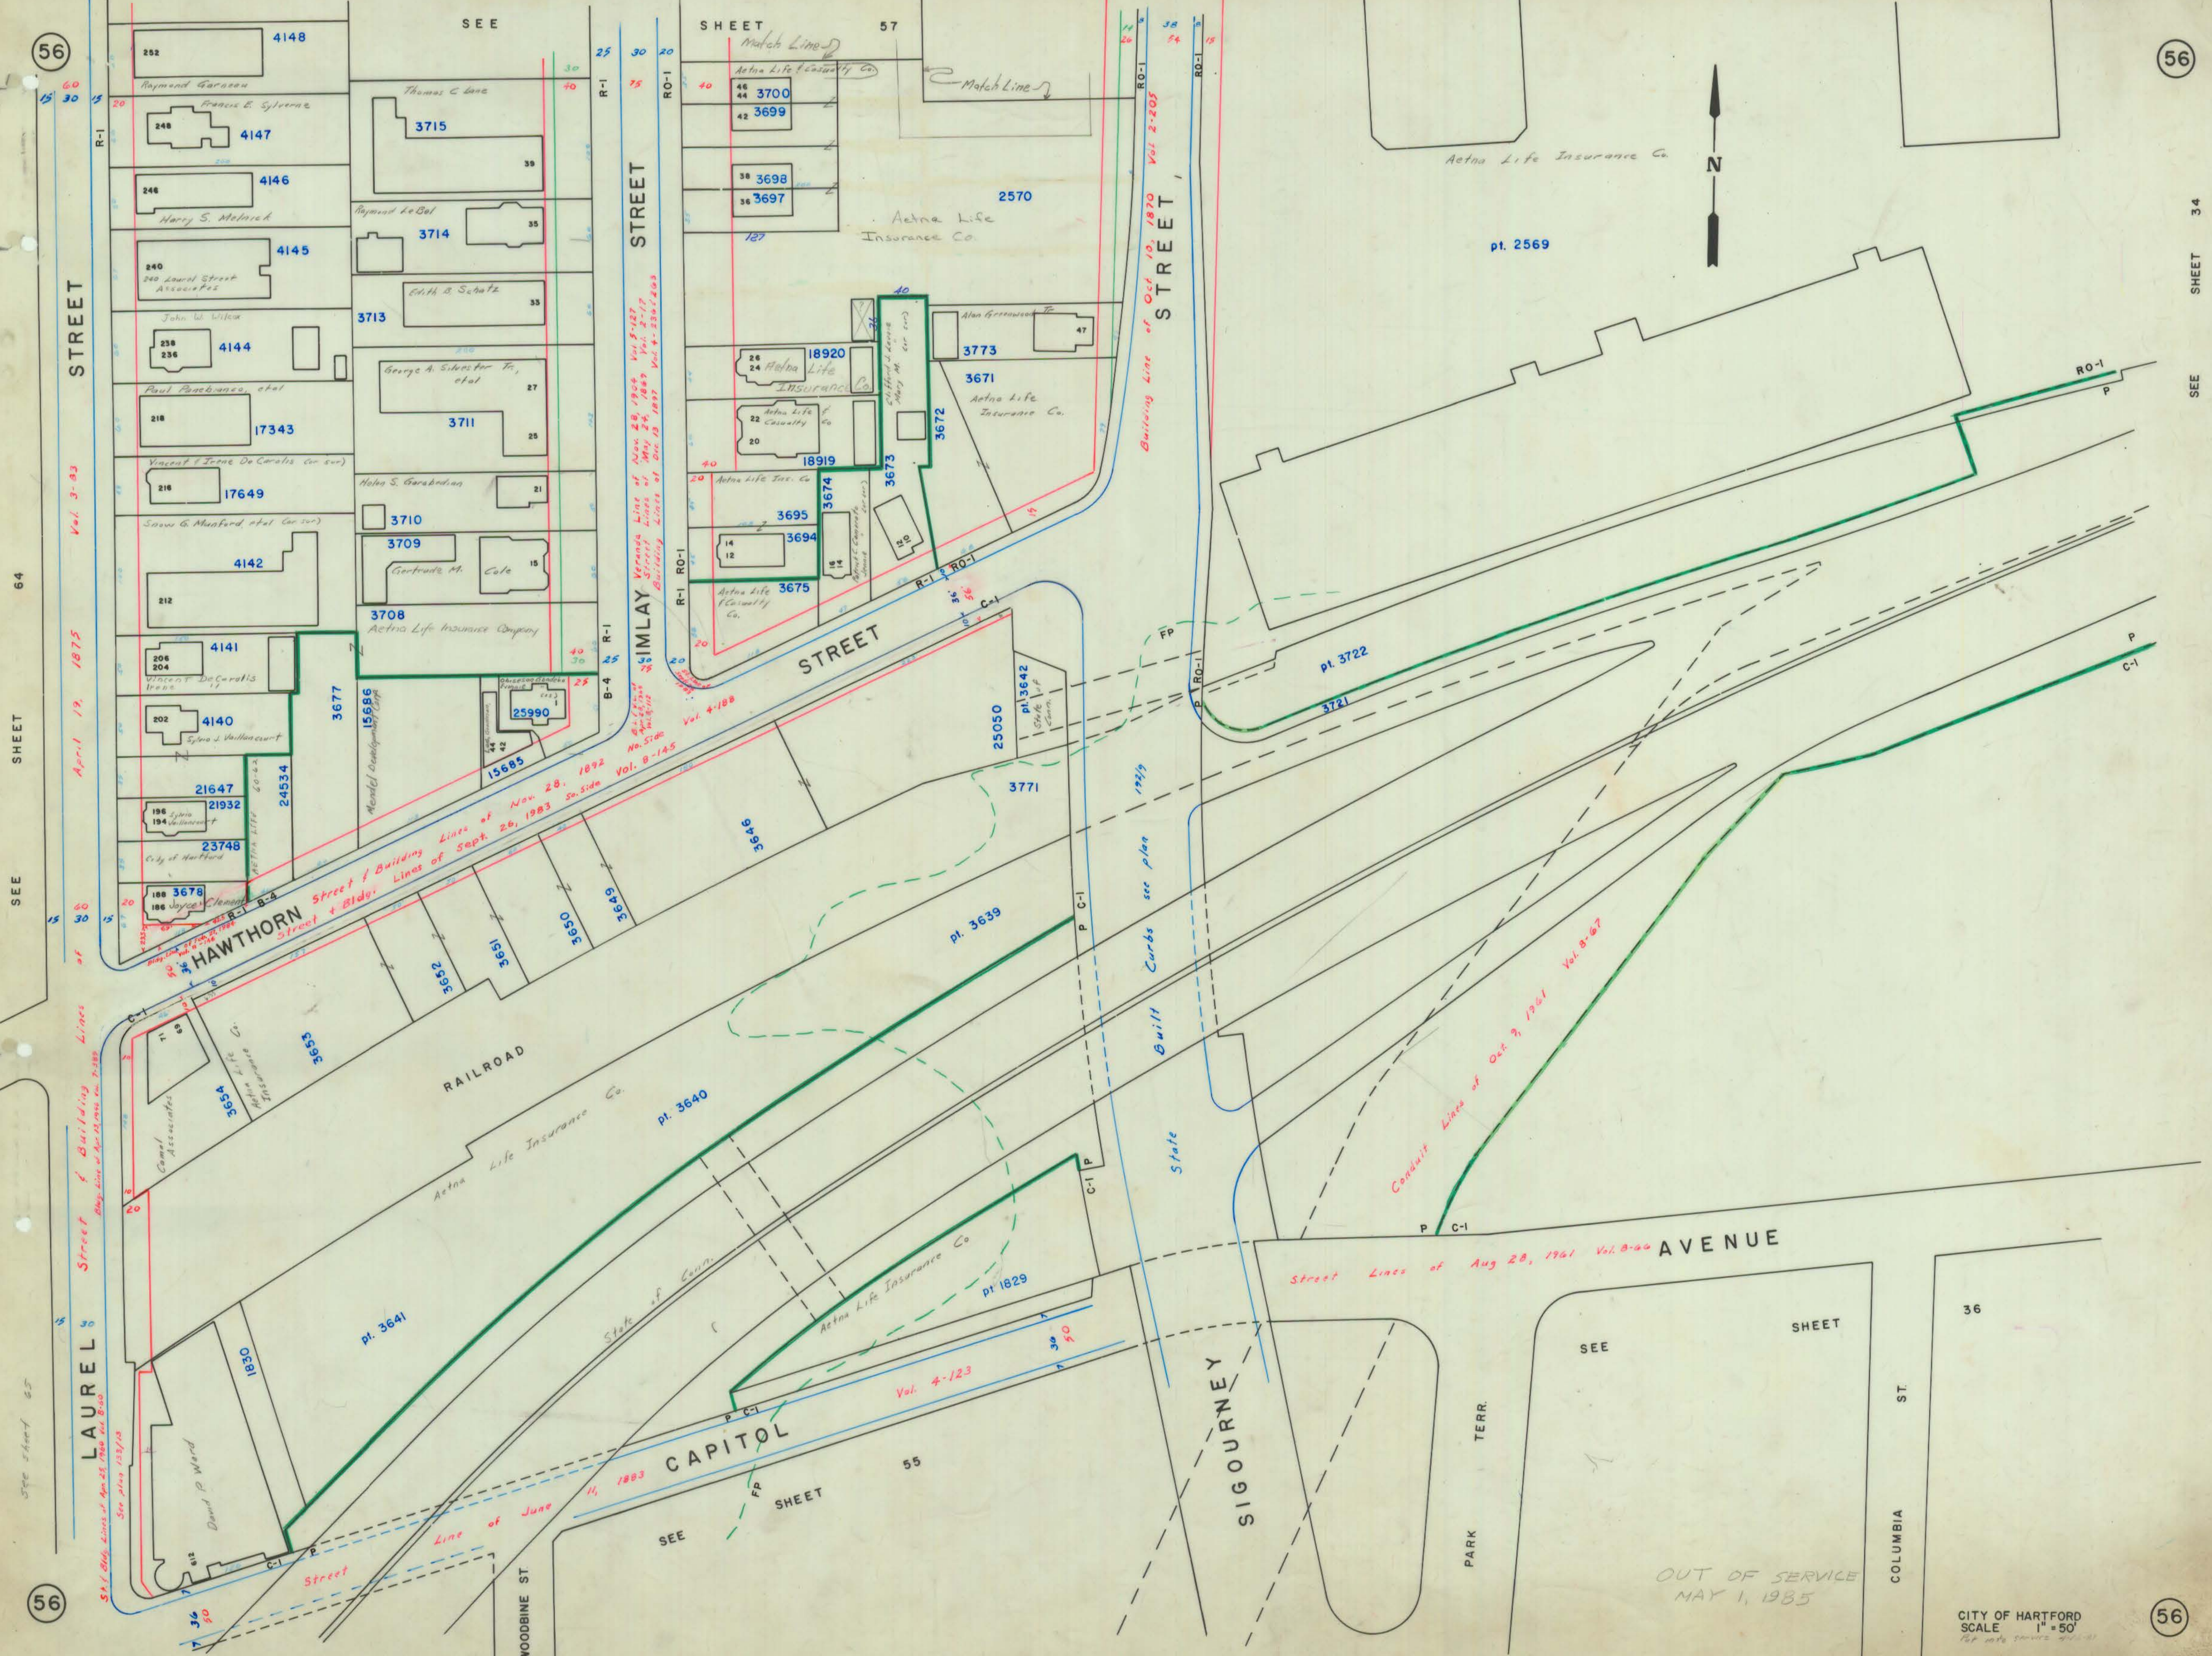

SEE SHEET 64

SEE SHEET 34

OUT OF SERVICE
MAY 1, 1985

CITY OF HARTFORD
SCALE 1" = 50'
For info services 411-1111