


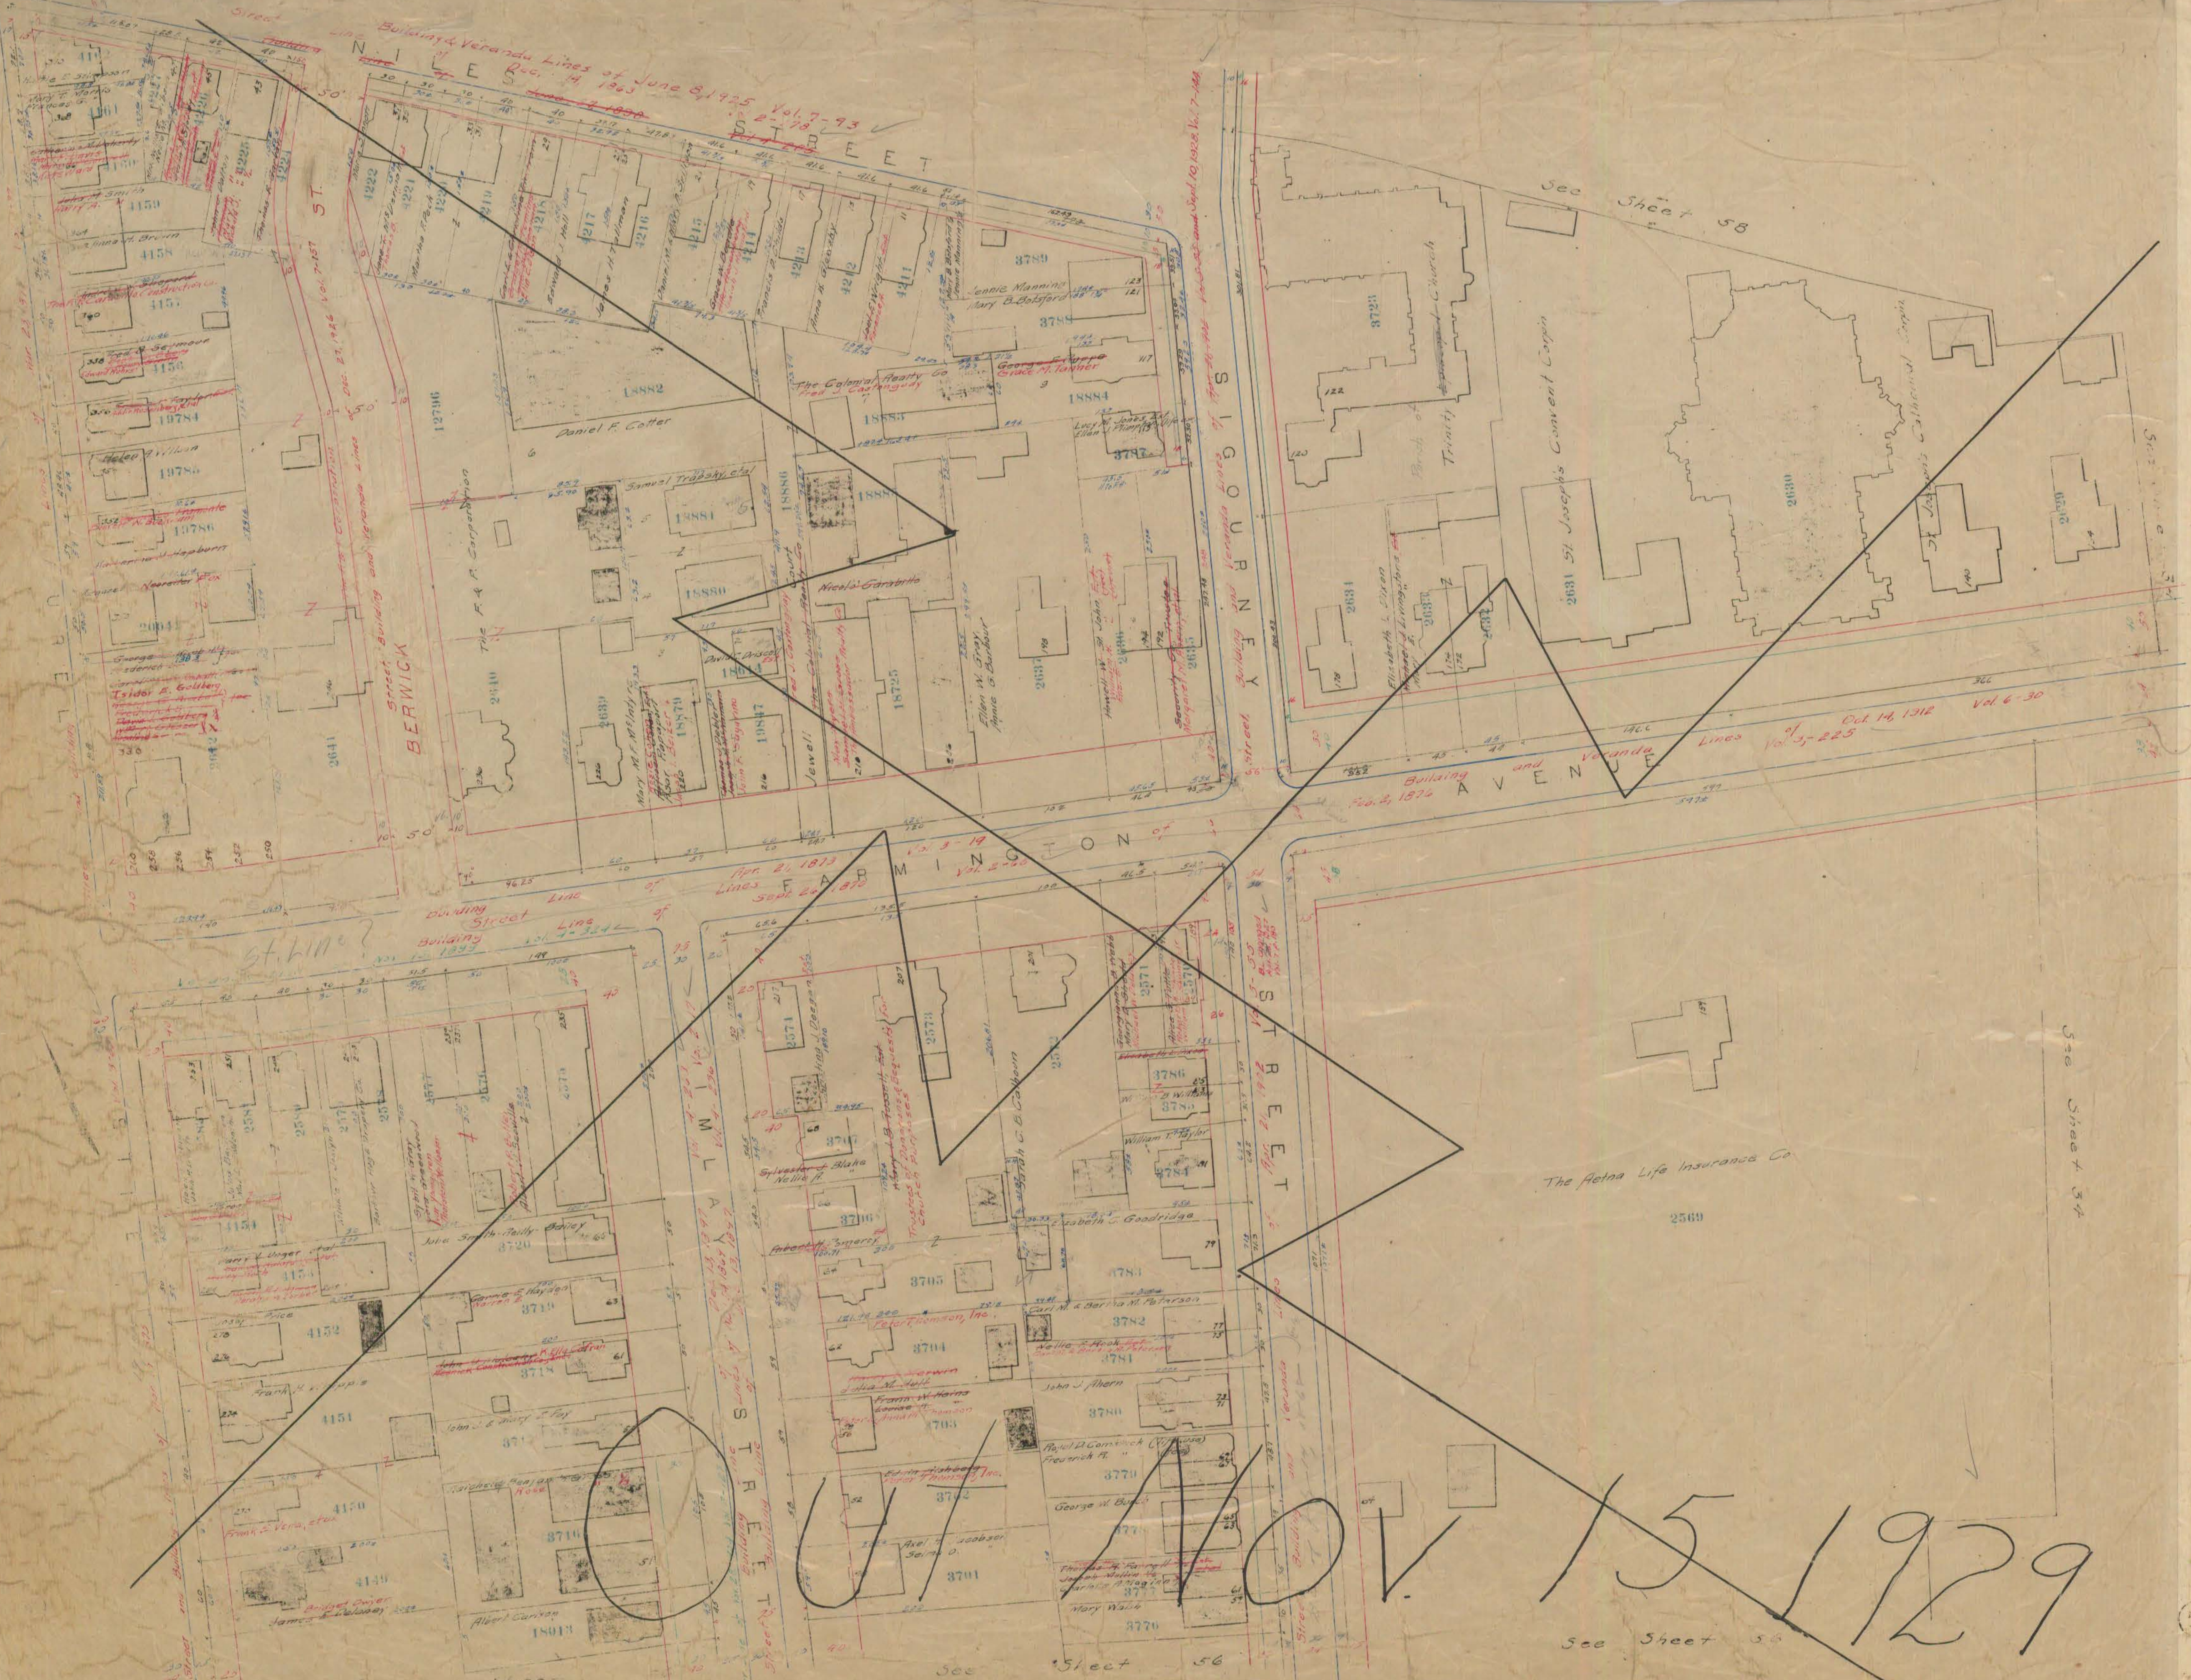

See Sheet 54

See Sheet 54

The Aetna Life Insurance Co.

151929


See Sheet 56

